

CITY OF MIAMISBURG SYCAMORE TRAILS AQUATIC CENTER MIAMISBURG, OHIO



ISSUED FOR CONSTRUCTION - JANURARY 17th, 2025 ADDENDUM #01 - FEBRUARY 3rd, 2025



10 South Patterson Blvd. Dayton, OH 45402 Tel: 937.224.4474 CIVIL ENGINEER / LANDSCAPE ARCHITECTURE



6219 Centre Park Drive West Chester, OH 45069 Tel: 513.779.7851 STRUCTURAL ENGINEER



537 East Pete Rose Way, Ste. 400 Cincinnati, OH 45202 Tel: 513.542.3300 MEP ENGINEER





VICINITY MAP



KEYMAP

 
AQUATIC DESIGNER




12851 Manchester Road, Suite 120 St. Louis, MO 63131 Tel: 314.894.1245


Counsilman - Hunsaker

AQUATICS FOR LIFE



SHEET			Current	Current	SHEET			Current	Current
NUMBER	SHEET NAME	Sheet Issue Date	Revision	Revision Date	NUMBER	SHEET NAME	Sheet Issue Date	Revision	Revision Da
ENERAL	COVER SHEET	01/17/25	1	01/31/25	MECHANICAL M-001	LEGEND AND INDEX	01/17/25		
i-002 S-101	SHEET INDEX PROJECT CODE SUMMARY & LIFE SAFETY	01/17/25 01/17/25	1	01/31/25	MD-101 M-101	MECHANICAL FLOOR PLANS - DEMOLITION MECHANICAL FLOOR PLANS	01/17/25 01/17/25		
	PLANS				M-501 M-601	MECHANICAL DETAILS & SCHEDULES MECHANICAL SCHEDULES	01/17/25	1	01/31/2
CIVIL C100	GENERAL NOTES & DETAILS	01/17/25			L		01/17/25	I	01/31/23
C101	DETAILS	01/17/25			ELECTRICAL E-001	LEGEND AND INDEX	01/17/25		
C102 C110	CITY OF MIAMISBURG STANDARD NOTES SURVEY BASEMAP	01/17/25 01/17/25			E-002 ED-101	LEGEND AND GENERAL NOTES ELECTRICAL SITE PLAN - DEMOLITION	01/17/25 01/17/25		
C111 C120	SURVEY BASEMAP DEMOLITION PLAN	01/17/25 01/17/25			ED-102 ED-103	ELECTRICAL SITE PLAN - DEMOLITION PARKING ELECTRICAL FLOOR PLANS - DEMOLITION	01/17/25 01/17/25		
C121 C130	DEMOLITION PLAN LOCATION PLAN	01/17/25 01/17/25			E-101	ELECTRICAL SITE PLAN - PARKING	01/17/25		
C131	LOCATION PLAN	01/17/25			E-102 E-103	ELECTRICAL SITE PLAN - LIGHTING ELECTRICAL SITE PLAN - POWER	01/17/25 01/17/25		
C140 C141	UTILITY PLAN UTILITY PLAN	01/17/25 01/17/25	1	01/31/25	E-104 E-105	ELECTRICAL SITE PLAN - POOL LIGHTING ELECTRICAL SITE PLAN - POOL GROUNDING	01/17/25 01/17/25		
C142 C143	UTILITY PROFILES UTILITY PROFILES	01/17/25 01/17/25			E-201 E-301	NEW WORK - FLOOR PLAN - LIGHTING NEW WORK FLOOR PLAN - POWER	01/17/25 01/17/25	1	01/31/25
C150 C151	GRADING PLAN GRADING PLAN	01/17/25 01/17/25			E-302 E-401	NEW WORK FLOOR PLAN - POOL POWER ENLARGED CONCESSIONS PLAN	01/17/25		
C160	EROSION CONTROL NOTES	01/17/25			E-501	ELECTRICAL DETAILS	01/17/25		
C161	EROSION CONTROL NOTES & DETAILS	01/17/25			E-502 E-503	ELECTRICAL DETAILS LIGHTING CONTROLS AND DETAILS	01/17/25 01/17/25		
_ANDSCAPE _100	LAYOUT PLAN	01/17/25			E-601 E-602	MOTOR AND LIGHTING SCHEDULES ELECTRICAL PANEL SCHEDULES	01/17/25 01/17/25		
_101 _102	LAYOUT ENLARGEMENT PLAN JOINTING PLAN	01/17/25 01/17/25			E-603 E-701	ELECTRICAL PANEL SCHEDULES ELECTRICAL SINGLE LINE	01/17/25		
_200	LANDSCAPE PLAN LANDSCAPE ENLARGEMENT PLAN	01/17/25 01/17/25			L		01/17/23		
_202	LANDSCAPE SCHEDULE AND DETAILS	01/17/25			AQUATICS AQ0.0	POOL REFERENCE PLAN	01/17/25		
L300 L301	SITE LANDSCAPE DETAILS SITE LANDSCAPE DETAILS	01/17/25 01/17/25			AQ1.0 AQ1.1	LAP POOL STRUCTURAL PLAN WASING POOL STRCUTURAL PLAN	01/17/25 01/17/25		
_302 _303	SITE LANDSCAPE DETAILS SITE LANDSCAPE DETAILS	01/17/25 01/17/25			AQ1.2 AQ1.3	POOL NOTES & TYPICAL DETAILS TYPICAL DETAILS	01/17/25		
_304 100	SITE LANDSCAPE DETAILS IRRIGATION PLAN	01/17/25			AQ1.4	POOL STRUCTURAL SECTIONS	01/17/25		
101	IRRIGATION NOTES & DETAILS	01/17/25			AQ1.5 AQ2.0	POOL STRUCTURAL SECTIONS LAP POOL PLAN	01/17/25 01/17/25		
102	IRRIGATION DETAILS	01/17/25			AQ2.1 AQ2.2	LAP POOL SECTIONS LAP POOL SECTIONS & STAIR PLAN	01/17/25 01/17/25		
STRUCTURAL S001	L GENERAL NOTES	01/17/25			AQ2.3 AQ2.4	LAP POOL DETAILS LAP POOL DETAILS	01/17/25		
S002	GENERAL NOTES, LEGEND & ABBREVIATIONS	01/17/25			AQ2.5	LAP POOL DETAILS	01/17/25		
S003 S005	SPECIAL INSPECTIONS SNOW DRIFT LOADING PLANS	01/17/25 01/17/25			AQ3.0 AQ3.1	TEACHING / EXERCISE POOL PLAN & SECTIONS TEACHING / EXERCISE POOL DETAILS	01/17/25 01/17/25		
S101 S102	FOUNDATION PLAN FOUNDATION PLAN, LOW STEEL, & ROOF	01/17/25 01/17/25			AQ3.2 AQ4.0	TEACHING / EXERCISE POOL DETAILS WADING POOL PLAN & SECTIONS	01/17/25 01/17/25		
S103	FRAMING PLAN - PUMP HOUSE	01/17/25			AQ4.1	WADING POOL DETAILS	01/17/25		
S201	TYPICAL FOUNDATION DETAILS & SECTIONS	01/17/25			AQ4.2 AQ5.0	WADING POOL DETAILS LEISURE POOL PLAN	01/17/25 01/17/25		
S211 S301	FOUNDATION DETAILS & SECTIONS TYPICAL STEEL FRAMING DETAILS	01/17/25 01/17/25			AQ5.1 AQ5.2	LEISURE POOL SECTIONS LEISURE POOL DETAILS	01/17/25 01/17/25		
S311 S312	CANOPY FRAMING DETAILS & SECTIONS ROOF FRAMING DETAILS & SECTIONS	01/17/25 01/17/25			AQ5.3 AQ5.4	LEISURE POOL DETAILS LEISURE POOL DETAILS	01/17/25 01/17/25		
S313 S400	ROOF FRAMING DETAILS & SECTIONS TYPICAL MASONRY DETAILS & SECTIONS &	01/17/25 01/17/25			AQ5.5	LEISURE POOL DETAILS	01/17/25		
S500	SCHEDULES SCHEDULES	01/17/25			AQ5.6 AQ6.0	WATERSLIDE PLAN, ELEVATION & DETAILS POOL STAKING PLAN	01/17/25 01/17/25		
		01/17/23			AQ7.0 AQ7.1	POOL PIPING NOTES & SCHEDULES POOL SUCTION PIPING PLAN	01/17/25 01/17/25		
ARCHITECTU AD-101	DEMOLITION - FLOOR PLANS	01/17/25			AQ7.2 AQ7.3	POOL RETURN PIPING PLAN POOL FEATURE RETURN PIPING PLAN	01/17/25 01/17/25		
AD-102 AD-103	DEMOLITION - ROOF PLANS DEMOLITION - CEILING PLANS	01/17/25 01/17/25			AQ8.0	POOL MECHANICAL NOTES & SCHEDULES	01/17/25		
AD-201 AD-202	DEMOLITION - EXTERIOR ELEVATIONS DEMOLITION - EXTERIOR ELEVATIONS	01/17/25 01/17/25			AQ8.1 AQ8.2	POOL MECHANICAL ROOM PLANS POOL MECHANICAL ROOM SECTIONS	01/17/25 01/17/25		
A-002	PARTITION TYPES	01/17/25			AQ8.3 AQ8.4	POOL MECHANICAL PIPING ISOMETRICS LAP POOL SURGE TANK PLAN & SECTIONS	01/17/25 01/17/25		
A-101 A-121	NEW WORK - FLOOR PLANS REFLECTED CEILING PLANS - NEW WORK	01/17/25 01/17/25			AQ8.5	TEACHING / EXERCISE POOL SURGE TANK PLAN & SECTIONS	01/17/25		
A-131 A-201	ROOF PLANS - NEW WORK EXTERIOR ELEVATIONS	01/17/25 01/17/25	1	01/31/25	AQ8.6	WADING POOL SURGE TANK PLAN & SECTIONS	01/17/25		
A-202	EXTERIOR ELEVATIONS	01/17/25			AQ8.7 AQ8.8	SPRAYGROUND BALANCE TANK PLAN &	01/17/25 01/17/25		
A-301 A-302	BUILDING SECTIONS BUILDING SECTIONS	01/17/25			AQ8.9	SECTIONS POOL MECHANICAL DETAILS	01/17/25		
A-310 A-311	WALL SECTIONS WALL SECTIONS	01/17/25 01/17/25			AQ8.10 AQ8.11	POOL MECHANICAL DETAILS POOL MECHANICAL DETAILS	01/17/25 01/17/25		
A-400	ENLARGED RESTROOM DETAILS AND EQUIPMENT LEGEND	01/17/25	1	01/31/25	AQ8.12 AQ8.13	POOL MECHANICAL DETAILS POOL MECHANICAL DETAILS	01/17/25		
A-401 A-402	ENLARGED PLANS ENLARGED PLANS	01/17/25 01/17/25			AQ8.14	POOL MECHANICAL DETAILS	01/17/25		
A-403	ENLARGED PLANS	01/17/25			AQ9.0 AQ9.1	LAP POOL SYSTEMS SCHEMATIC TEACHING / EXERCISE POOL SYSTEMS	01/17/25 01/17/25		
A-404 A-405	ENLARGED PLANS ENLARGED PLANS	01/17/25 01/17/25	1	01/31/25	AQ9.2	SCHEMATIC WADING POOL SYSTEMS SCHEMATIC	01/17/25		
A-420 A-421	INTERIOR ELEVATIONS INTERIOR ELEVATIONS	01/17/25 01/17/25	1	01/31/25 01/31/25	AQ9.3 AQ9.4	LEISURE POOL SYSTEMS SCHEMATIC SPRAYGROUND SYSTEMS SCHEMATIC	01/17/25 01/17/25		
A-422 A-423	INTERIOR ELEVATIONS INTERIOR ELEVATIONS	01/17/25 01/17/25	1	01/31/25	PRESENTATIO				1
A-520	ROOF DETAILS	01/17/25	1	51,01/20	PT101	3D AXON IMAGES	01/17/25		
A-521 A-530	ROOF DETAILS SECTION DETAILS	01/17/25 01/17/25			PT102 PT103	3D AXON IMAGES FINISH ELEVATIONS & ISOMETRICS	01/17/25 01/17/25		
A-534 A-535	MISC. DETAILS MISC. DETAILS	01/17/25 01/17/25							
A-540 A-541	CASEWORK SECTIONS AND DETAILS CASEWORK SECTIONS AND DETAILS	01/17/25	1	01/31/25 01/31/25					
A-541 A-601	DOOR SCHEDULE, FRAMES, TYPES, AND	01/17/25	1	01/01/20					
4-602	HARDWARE DOOR & WINDOW DETAILS	01/17/25							
A-610 A-611	WINDOW ELEVATIONS WINDOW ELEVATIONS	01/17/25 01/17/25							
A-900 A-901	FINISH SCHEDULE AND LEGEND OVERALL FINISH PLAN	01/17/25	1	01/31/25 01/31/25					
		01111/2J	1	51/01/20					
PLUMBING P-001	LEGENDS AND SCHEDULES	01/17/25							
P-300 P-701	MAIN PUMP HOUSE FOUNDATION PLAN SANITARY DIAGRAMS	01/17/25 01/17/25							
P-101 P-201	PLUMBING SITE UTILITY PLAN PLUMBING NEW WORK FLOOR PLANS	01/17/25	1	01/31/25					
P-301	PLUMBING NEW WORK FLOOR PLANS	01/17/25	1	01/31/23					
P-401 P-501	ENLARGED CONCESSIONS PLANS DETAILS AND NOTES	01/17/25 01/17/25							
P-601	SCHEDULES AND NOTES	01/17/25		+					

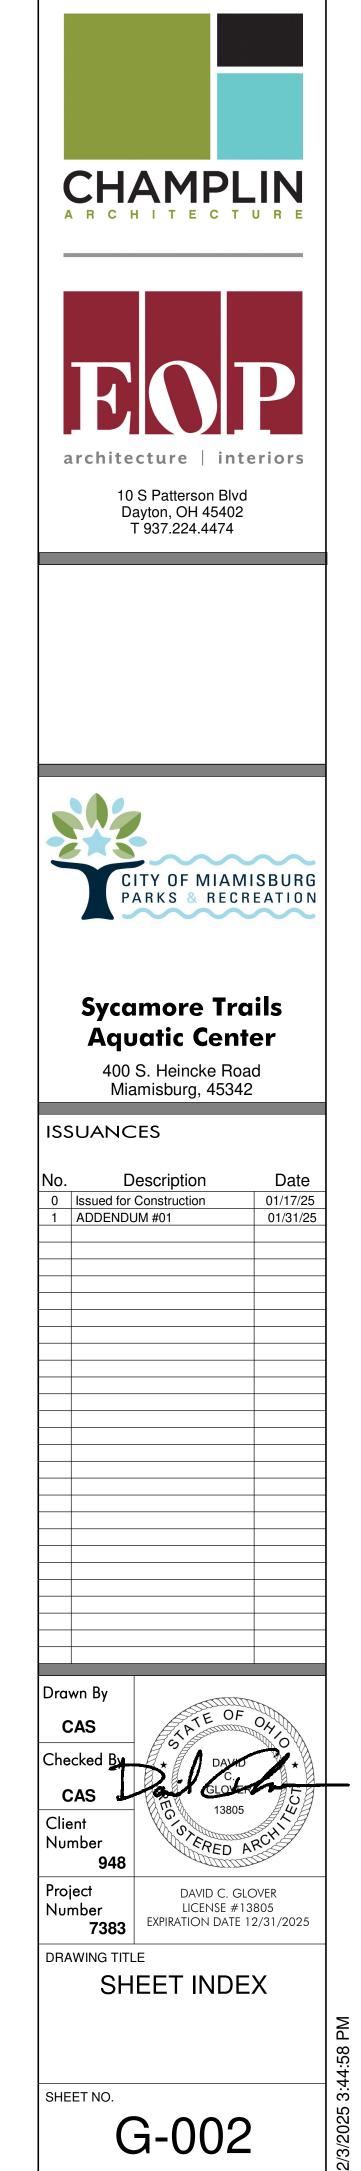

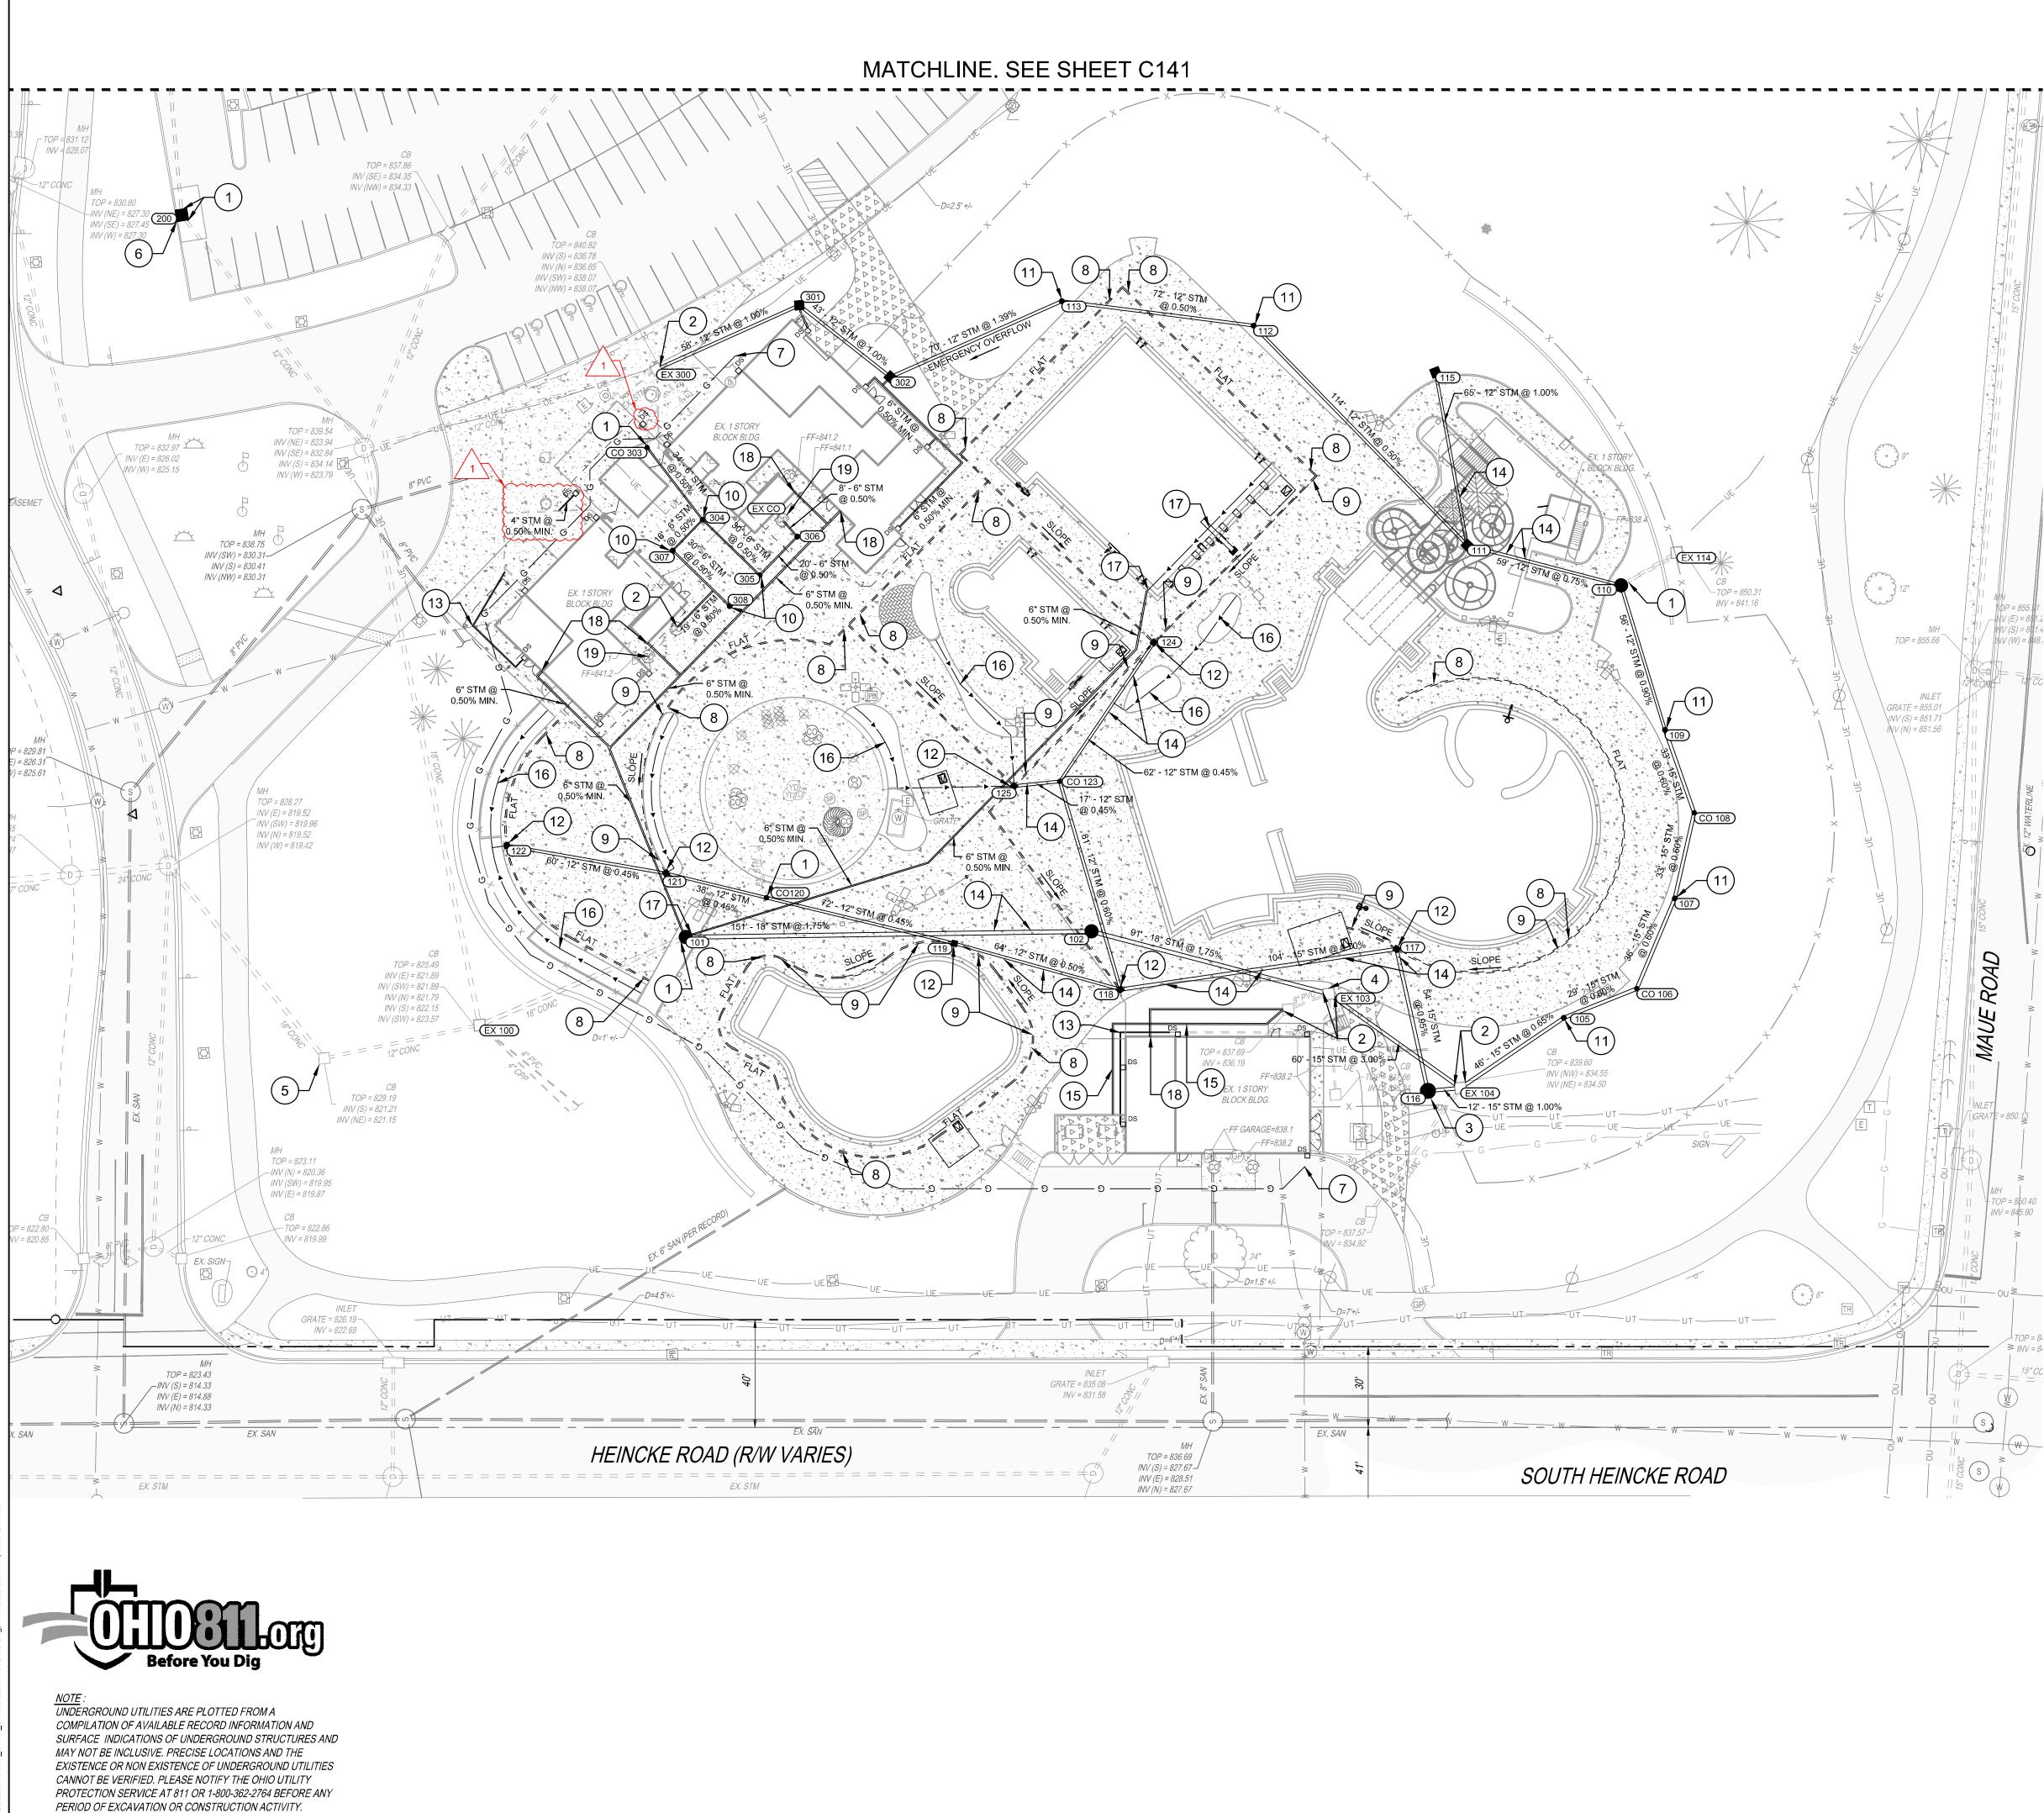

PROPOSED LEGEND

 \square LIGHT POLE. SEE ELECTRIC PLANS FOR DETAILS.

STORM SEWER PIPE

= = = = TRENCH DRAIN. SEE KEYNOTES 8 & 9 THIS SHEET PERFORATED UNDER DRAIN. SEE KEYNOTES 16 & ____**>** -**17 THIS SHEET**


- CATCH BASIN
- CURB INLET
- 100 YARD DRAIN. SEE KEYNOTES 10, 11, & 12 THIS SHEET
- MANHOLE
- STORM SEWER CLEANOUT
- DOWNSPOUT. INSTALL WITH BOOT PER ARCHITECTURAL PLANS. COORDINATE DOWNSPOUT LOCATIONS WITH ARCHITECTURAL PLANS. CONTRACTOR IS RESPONSIBLE FOR CONNECTING ALL NEW AND REPLACED DOWNSPOUTS TO EXISTING OR PROPOSED COLLECTOR PIPES. EXISTING DOWNSPOUT COLLECTORS SHOWN FROM RECORDS. CONTRACTOR TO FIELD VERIFY LOCATION.


UTLITY PLAN KEY NOTES


- CONNECT EXISTING STORM PIPE TO PROPOSED STORM STRUCTURE
- 2 CONNECT PROPOSED STORM PIPE TO EXISTING STORM STRCUTURE
- (3) CONTECH CS-5 HYDRODYNAMIC SEPARATOR WITH SOLID LID FOR WATER QUALITY TREATMENT
- (4) RAISE GRATE TO PROPOSED GRADE
- (5) REMOVE EXISTING GRATE AND ADD RISER WITH WINDOW PER DETAIL 11/C100
- 6 CONTECH CS-6 HYDRODYNAMIC SEPARATOR WITH GRATE FOR WATER QUALITY TREATMENT
- 7 PROPOSED GAS. SEE PLUMBING PLANS FOR CONTINUATION.
- 8 6", FLAT BOTTOM TRENCH DRAIN WITH PLASTIC, ADA COMPLIANT AND HEEL-PROOF GRATE. DURACAST PRECAST TRENCH DRAIN OR APPROVED EQUAL INSTALLED PER MANUFACTURERS SPECIFICATIONS.
- 6", SLOPED BOTTOM DRAIN WITH PLASTIC, ADA COMPLIANT AND HEEL-PROOF GRATE. SLOPE AS INDICATED BY ARROWS ON PLAN. DURACAST PRECAST TRENCH DRAIN OR APPROVED EQUAL INSTALLED PER MANUFACTURERS SPECIFICATIONS.
- (10) 6" ROUND, PLASTIC, ADA COMPLIANT AND HEEL-PROOF GRATE
- (11) 15" DUCTILE OR CAST IRON DOMED GRATE
- 12" SQUARE, PLASTIC, ADA COMPLIANT AND HEEL-PROOF GRATE
- (13) REROUTE 4" DOWNSPOUT COLLECTOR AROUND PROPOSED BUILDING ADDITION AS SHOWN. EXISTING DOWNSPOUT COLLECTOR SHOWN FROM RECORD DRAWINGS, CONTRACTOR TO FIELD VERIFY LOCATION.
- 14 LOCATION OF ANTICIPATED CROSSING WITH POOL PLUMBING. REFER TO POOL PLANS FOR PIPE LOCATIONS AND DEPTHS. MAINTAIN 18" MIN. VERTICAL CLEARANCE BETWEEN STORM AND POOL PLUMBING.
- (15) 6" FRENCH DRAIN PER DETAIL 4/C101
- (16) 4" PERFORATED UNDER DRAIN. SEE LANDSCAPE PLANS FOR DETAILS.
- (17) 6" PERFORATED DUAL WALL HDPE UNDER DRAIN. BACKFILL PER THE DRAINAGE COURSE PER EARTH MOVING SPECIFICATION. SEE POOL STRUCTURAL PLANS FOR ADDITIONAL INFORMATION. CONNECT TO PROPOSED STORM STRUCTURE 101 AT 0.5% MIN. SLOPE
- CONNECT FOUNDATION DRAIN TO PROPOSED STORM. SEE
 ARCHITECTURAL PLANS FOR FOUNDATION FOUNDATION FOR FOUNDATION FOR FOUNDATION FOR FOUNDATION FOR FOUNDATION FO ARCHITECTURAL PLANS FOR FOUNDATION DRAIN DETAILS.
- (19) CONNECT 3" STORM LINE FROM BUILDING TO EXISTING CLEANOUT. SEE PLUMBING PLANS FOR CONTINUATION

UTILITY PLAN GENERAL NOTES

- A. ALL STORM STRUCTURES SET IN PAVEMENT TO BE INSTALLED WITH FINGER DRAINS PER DETAIL 7/C100
- B. ALL CLEANOUTS TO BE INSTALLED PER DETAIL 8/C100 C. CONTRACTOR SHALL SCHEDULE UNDERGROUND UTILITY COORDINATION MEETING PRIOR TO INSTALLATION OF SITE UTILITIES

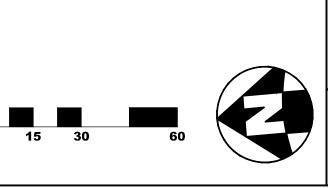

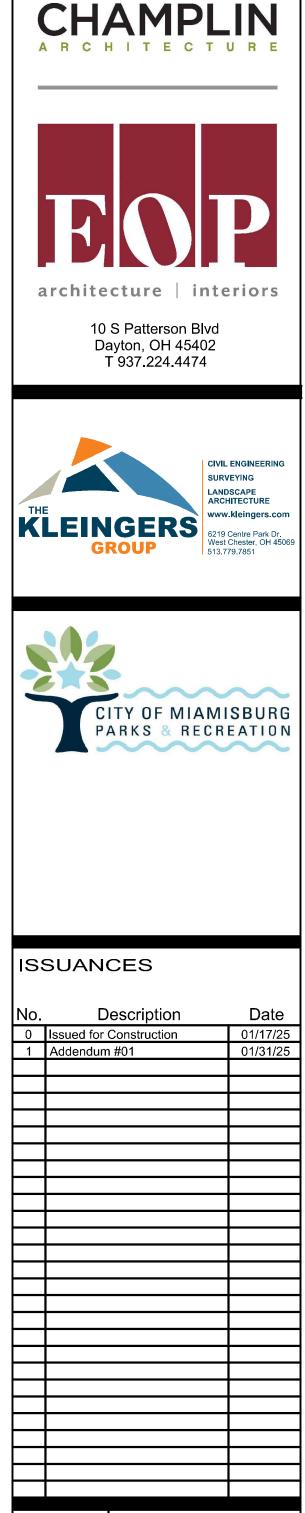

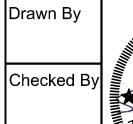




Project Number

SHEET NO.

Client Number


DRAWING TITLE UTILITY PLAN


C140

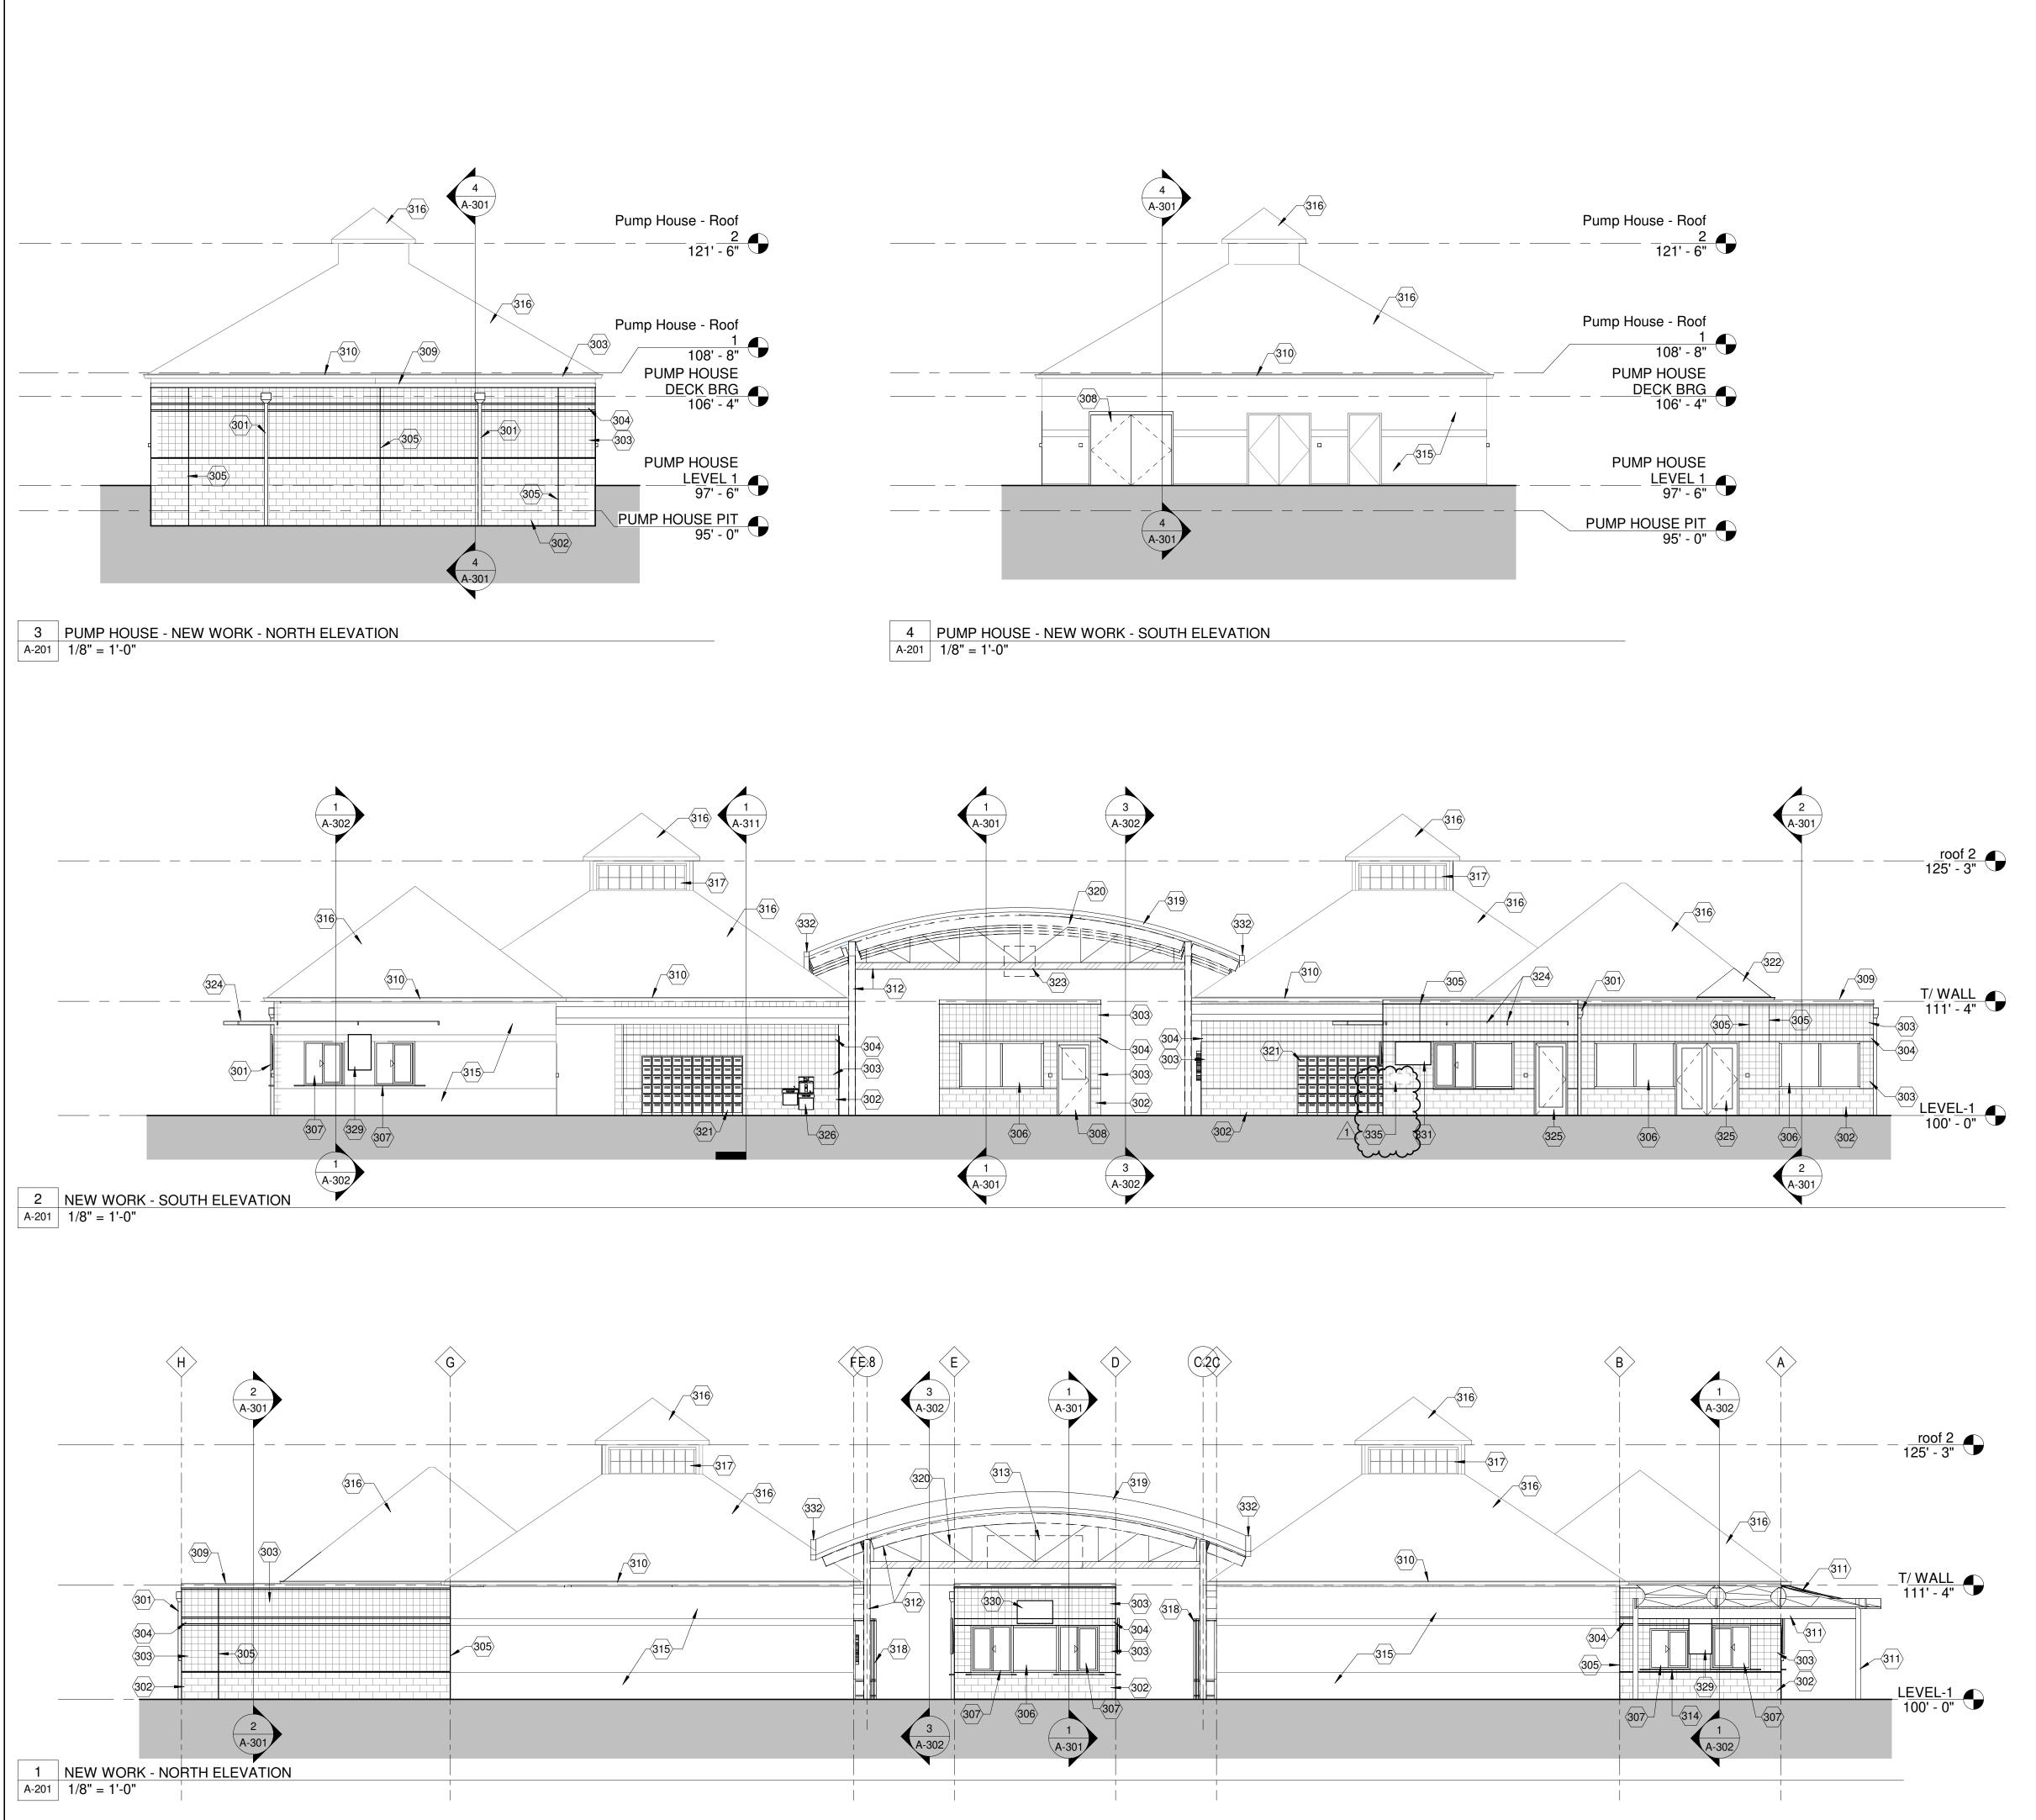



	$\langle _$	DRAWING	
301	COLLI	ECTOR BOX AND 6"x6" PRE-FINISH	PPER TO PRE-FINISHED METAL OVERFLOW IED METAL DOWNSPOUT, CONNECT TO
302	DECO	RGROUND STORM SYSTEM, COLO RATIVE "GREY" 8"x16" CMU BLOCI	<, TO MATCH EXISTING.
303 304		RATIVE "WHITE" 8"x8" CMU BLOCK RATIVE "GREY" 8"x16" CMU BLOCI	
305			DINT WITH BACKER ROD AND SEALANT. W JAMB, JOG TO END OF THE STEEL LINTEI
306		INISHED CUSTOM COLOR INSULA	TED ALUMINUM STOREFRONT WINDOWS COLOR FROM OWNER BRANDING
307	STAN	DARDS.	TED ALUMINUM STOREFRONT PASS-THRU
308		·	OR FROM OWNER BRANDING STANDARDS. FRAME, PAINT COLOR PER EXTERIOR
309		I LEGEND. INISHED METAL COPING CAP, CO	LOR PER EXTERIOR FINISH LEGEND.
310		PRE-FINISHED METAL GUTTER AN ING ROOF, REFER TO EXTERIOR I	D FASCIA TO MATCH NEW COLOR OF FINISH LEGEND.
311	TENS	LE FABRIC SHADE CANOPY, PROI	HADE CANOPY FRAMING WITH COLORED DUCT TO BE SELECTED BY
312	EXPO		RS, EPOXY PAINT, REFER TO EXTERIOR
313	PROP		TION, PROVIDE POWER AND DATA, REFER T
314	PRE-F		OUNTER CONNECTED TO CMU WALL, "MATT
315	POWE		'S. TCH / REPAIR ANY EXISTING CONTROL JOIN
316		ING STANDING SEAM METAL ROC	FING, PAINT PER EXTERIOR FINSIH LEGENE
317 318	PAINT MOVE	FRAME PER EXTERIOR FINISH LE ABLE SEGMENTED ROLLING SEC	D GLAZING CLERESTORY VISION UNITS, EGEND. URITY FENCE / GATE, MOUNT TO EXTERIOR
319	CURV	REFER TO DETAILS. ED ENTRY CANOPY WITH SINGLE	
320	PAINT	INSIHED END FASCIA PANELS, RE ED BAR STOCK FAUX TRUSS MEN	IBERS, REFER TO SECTIONS.
321 322	INFILL		ND PRE-FINISHED METAL STANDING SEAM
323		PANELS TO MATCH EXISTING PR FION OF PROPOSED CLOCK AREA	OFILES. A, PROVIDE POWER AND DATA, REFER TO
324		RICAL DRAWINGS. MOUNTED PRE-FINSIHED METAL	ROD AND COLORED TENSILE FABRIC SHAD
325		PY, PRODUCT TO BE SELECTED E INSIHED INSULATED ALUMINUM S	BY OWNER/ARCHITECT. STOREFRONT DOOR, COLOR PER EXTERIOF
326		i legend. Fion of hi-low drinking fount	TAIN WITH WATER BOTTLE FILLER, REFER T
329	WALL		ENT, BOTTOM OF UNIT AT 60" A.F.F., REFER
330		ECTRICAL DRAWINGS FOR POWE MOUNTED TV HORIZONTAL PLAC	R/DATA REQUIREMENTS. EMENT, BOTTOM OF UNIT AT 90" A.F.F.,
331		R TO ELECTRICAL DRAWINGS FOR MOUNTED TV HORIZONTAL PLAC	R POWER/DATA REQUIREMENTS. EMENT, BOTTOM OF UNIT AT 60" A.F.F.,
332		R TO ELECTRICAL DRAWINGS FOR (GUTTER, COLOR TO MATCH ROO	R POWER/DATA REQUIREMENTS. OFING MEMBRANE, DRAIN ONTO EXISTING
335	LOCA ALARI		Y STOP DEVICES, DEVICES NEED TO BE IN TH SIGNAGE ABOVE THEM OF WHAT THEY
CMU BAS	E WA	DR FINISH LEGI <u>NSCOT:</u> (WAINSCOT OF BUI COUNTY MATERIALS 8"X16" "GALAXY" (63-239C)	LDING)
CMU BAS MFG: COLOR: CMU FIEL MFG:	EWA	<u>NSCOT:</u> (WAINSCOT OF BUI COUNTY MATERIALS 8"X16" "GALAXY" (63-239C)	LDING) TYPE: ULTRA BURNISHED SUPPLIER: READING ROCK
CMU BAS MFG: COLOR: COLOR: MFG: COLOR:	<u>e wa</u>	<u>NSCOT:</u> (WAINSCOT OF BUI COUNTY MATERIALS 8"X16" "GALAXY" (63-239C) (MAIN FIELD COLOR) COUNTY MATERIALS 8"X8" "SOLSTICE" (63-219C)	ILDING) TYPE: ULTRA BURNISHED SUPPLIER: READING ROCK TYPE: ULTRA BURNISHED SUPPLIER: READING ROCK
CMU BAS MFG: COLOR: MFG: COLOR: COLOR: MFG: COLOR: MFG: COLOR:	<u>E WA</u>	NSCOT: (WAINSCOT OF BUI COUNTY MATERIALS 8"X16" "GALAXY" (63-239C) (MAIN FIELD COLOR) COUNTY MATERIALS 8"X8" "SOLSTICE" (63-219C) (ACCENT BANDING) COUNTY MATERIALS 8"X16" "GALAXY" (63-239C) (EXISTING ROOF, NEW GUT	ILDING) TYPE: ULTRA BURNISHED SUPPLIER: READING ROCK TYPE: ULTRA BURNISHED SUPPLIER: READING ROCK TYPE: ULTRA BURNISHED SUPPLIER: READING ROCK
CMU BAS MFG: COLOR: MFG: COLOR: COLOR: MFG: COLOR: MFG: COLOR: MFG: COLOR:	<u>E WA</u>	NSCOT: (WAINSCOT OF BUI COUNTY MATERIALS 8"X16" "GALAXY" (63-239C) (MAIN FIELD COLOR) COUNTY MATERIALS 8"X8" "SOLSTICE" (63-219C) (ACCENT BANDING) COUNTY MATERIALS 8"X16" "GALAXY" (63-239C) (EXISTING ROOF, NEW GUT SHERWIN WILLIAMS SW6966 " BLUEBLOOD"	ULDING) TYPE: ULTRA BURNISHED SUPPLIER: READING ROCK TYPE: ULTRA BURNISHED SUPPLIER: READING ROCK TYPE: ULTRA BURNISHED SUPPLIER: READING ROCK TERS, AND DOWNSPOUTS) TYPE: SEE SPECIFICATIONS
CMU BAS MFG: COLOR: MFG: COLOR: MFG: COLOR: MFG: COLOR: MFG: COLOR: MFG: COLOR: MFG: COLOR:	<u>E WA</u>	NSCOT: (WAINSCOT OF BUI COUNTY MATERIALS 8"X16" "GALAXY" (63-239C) (MAIN FIELD COLOR) COUNTY MATERIALS 8"X8" "SOLSTICE" (63-219C) (ACCENT BANDING) COUNTY MATERIALS 8"X16" "GALAXY" (63-239C) (EXISTING ROOF, NEW GUT SHERWIN WILLIAMS SW6966 " BLUEBLOOD" (ALUMINUM DOORS AND ST YKK YES 45 TU TYPI MATCH OWNER PANTONE "	<i>LDING)</i> TYPE: ULTRA BURNISHED SUPPLIER: READING ROCK TYPE: ULTRA BURNISHED SUPPLIER: READING ROCK TYPE: ULTRA BURNISHED SUPPLIER: READING ROCK <i>TERS, AND DOWNSPOUTS)</i> TYPE: SEE SPECIFICATIONS <i>TYPE: SEE SPECIFICATIONS</i>
CMU BAS MFG: COLOR: MFG: COLOR: MFG: COLOR: MFG: COLOR: MFG: COLOR: MFG: COLOR: MFG: COLOR: MFG: COLOR:	E WA	NSCOT: (WAINSCOT OF BUI COUNTY MATERIALS 8"X16" "GALAXY" (63-239C) (MAIN FIELD COLOR) COUNTY MATERIALS 8"X8" "SOLSTICE" (63-219C) (ACCENT BANDING) COUNTY MATERIALS 8"X16" "GALAXY" (63-239C) (EXISTING ROOF, NEW GUT SHERWIN WILLIAMS SW6966 " BLUEBLOOD" (ALUMINUM DOORS AND ST YKK YES 45 TU TYPI MATCH OWNER PANTONE " (NEW BUILDING ROOFING E EXCEPTIONAL METALS TUNDRA	 ILDING) TYPE: ULTRA BURNISHED SUPPLIER: READING ROCK TYPE: ULTRA BURNISHED SUPPLIER: READING ROCK TYPE: ULTRA BURNISHED SUPPLIER: READING ROCK TYPE: ULTRA BURNISHED SUPPLIER: READING ROCK TYPE: SEE SPECIFICATIONS TOREFRONTS) E: CUSTOM KYNAR FINISH TEAL" COLOR EDGE) TYPE: WALL COPING
CMU BAS MFG: COLOR: MFG: COLOR: MFG: COLOR: MFG: COLOR: MFG: COLOR: MFG: COLOR: MFG: COLOR: MFG: COLOR: MFG: COLOR: MFG: COLOR: MFG: COLOR:	<u>E WA</u>	NSCOT: (WAINSCOT OF BUI COUNTY MATERIALS 8"X16" "GALAXY" (63-239C) (MAIN FIELD COLOR) COUNTY MATERIALS 8"X8" "SOLSTICE" (63-219C) (ACCENT BANDING) COUNTY MATERIALS 8"X16" "GALAXY" (63-239C) (EXISTING ROOF, NEW GUT SHERWIN WILLIAMS SW6966 " BLUEBLOOD" (ALUMINUM DOORS AND ST YKK YES 45 TU TYPI MATCH OWNER PANTONE " (NEW BUILDING ROOFING E EXCEPTIONAL METALS TUNDRA (ENTRY CANOPY ROOFING EXCEPTIONAL METALS HARBOR BLUE	 <i>ILDING</i>) TYPE: ULTRA BURNISHED SUPPLIER: READING ROCK TYPE: ULTRA BURNISHED SUPPLIER: READING ROCK TYPE: ULTRA BURNISHED SUPPLIER: READING ROCK <i>TERS, AND DOWNSPOUTS</i>) TYPE: SEE SPECIFICATIONS <i>FOREFRONTS</i>) E: CUSTOM KYNAR FINISH <i>TEAL</i> " COLOR <i>EDGE</i>) TYPE: WALL COPING
CMU BAS MFG: COLOR: MFG: COLOR: MFG: COLOR: MFG: COLOR: MFG: COLOR: MFG: COLOR: MFG: COLOR: MFG: COLOR: MFG: COLOR: MFG: COLOR: MFG: COLOR: MFG: COLOR: MFG: COLOR: MFG: COLOR:	E WA	NSCOT: (WAINSCOT OF BUI COUNTY MATERIALS 8"X16" "GALAXY" (63-239C) (MAIN FIELD COLOR) COUNTY MATERIALS 8"X8" "SOLSTICE" (63-219C) (ACCENT BANDING) COUNTY MATERIALS 8"X16" "GALAXY" (63-239C) (EXISTING ROOF, NEW GUT SHERWIN WILLIAMS SW6966 " BLUEBLOOD" (ALUMINUM DOORS AND ST YKK YES 45 TU TYPI MATCH OWNER PANTONE " (NEW BUILDING ROOFING E EXCEPTIONAL METALS TUNDRA (ENTRY CANOPY ROOFING EXCEPTIONAL METALS HARBOR BLUE	 ILDING) TYPE: ULTRA BURNISHED SUPPLIER: READING ROCK TYPE: ULTRA BURNISHED SUPPLIER: READING ROCK TYPE: ULTRA BURNISHED SUPPLIER: READING ROCK TYPE: ULTRA BURNISHED SUPPLIER: READING ROCK TYPE: SEE SPECIFICATIONS TOREFRONTS) E: CUSTOM KYNAR FINISH TEAL" COLOR EDGE) TYPE: WALL COPING
CMU BAS MFG: COLOR: MFG: COLOR: MFG: COLOR: MFG: COLOR: MFG: COLOR: MFG: COLOR: MFG: COLOR: MFG: COLOR: MFG: COLOR: MFG: COLOR: MFG: COLOR: MFG: COLOR: MFG: COLOR: MFG: COLOR: MFG: COLOR: MFG: COLOR: MFG: COLOR:		NSCOT: (WAINSCOT OF BUI COUNTY MATERIALS 8"X16" "GALAXY" (63-239C) (MAIN FIELD COLOR) COUNTY MATERIALS 8"X8" "SOLSTICE" (63-219C) (ACCENT BANDING) COUNTY MATERIALS 8"X16" "GALAXY" (63-239C) (EXISTING ROOF, NEW GUT SHERWIN WILLIAMS SW6966 " BLUEBLOOD" (ALUMINUM DOORS AND ST YKK YES 45 TU TYPI MATCH OWNER PANTONE " (NEW BUILDING ROOFING E EXCEPTIONAL METALS TUNDRA (ENTRY CANOPY ROOFING EXCEPTIONAL METALS HARBOR BLUE (DOOR METAL FRAMES UN SHERWIN WILLIAMS SW 6767 "AQUARIUM" AL DECK 1: (BREEZEWA	 LDING) TYPE: ULTRA BURNISHED SUPPLIER: READING ROCK TYPE: ULTRA BURNISHED SUPPLIER: READING ROCK TYPE: ULTRA BURNISHED SUPPLIER: READING ROCK TERS, AND DOWNSPOUTS) TYPE: SEE SPECIFICATIONS TOREFRONTS) E: CUSTOM KYNAR FINISH TEAL" COLOR EDGE) TYPE: WALL COPING EDGE) TYPE: VINYL COATED DRIP EDGE UESS NOTED OTHERWISE) TYPE: SEE SPECIFICATIONS AV METAL DECK & SUPPORT STEEL) TYPE: SEE SPECIFICATIONS
CMU BAS MFG: COLOR: MFG: COLOR: MFG: COLOR: MFG: COLOR: MFG: COLOR: MFG: COLOR: MFG: COLOR: MFG: COLOR: MFG: COLOR: MFG: COLOR: MFG: COLOR: MFG: COLOR: MFG: COLOR: MFG: COLOR: MFG: COLOR: MFG: COLOR:		NSCOT: (WAINSCOT OF BUI COUNTY MATERIALS 8"X16" "GALAXY" (63-239C) (MAIN FIELD COLOR) COUNTY MATERIALS 8"X8" "SOLSTICE" (63-219C) (ACCENT BANDING) COUNTY MATERIALS 8"X16" "GALAXY" (63-239C) (EXISTING ROOF, NEW GUT SHERWIN WILLIAMS SW6966 " BLUEBLOOD" (ALUMINUM DOORS AND ST YKK YES 45 TU TYPI MATCH OWNER PANTONE " (NEW BUILDING ROOFING E EXCEPTIONAL METALS TUNDRA (ENTRY CANOPY ROOFING EXCEPTIONAL METALS HARBOR BLUE (DOOR METAL FRAMES UN SHERWIN WILLIAMS SW 6767 "AQUARIUM" AL DECK 1: (BREEZEWA SHERWIN WILLIAMS SW 7757 HIGH REFLECTIVE AL DECK 2: (EXIST. BLD	 <i>LDING</i>) TYPE: ULTRA BURNISHED SUPPLIER: READING ROCK TYPE: ULTRA BURNISHED SUPPLIER: READING ROCK TYPE: ULTRA BURNISHED SUPPLIER: READING ROCK <i>TERS, AND DOWNSPOUTS</i>) TYPE: SEE SPECIFICATIONS <i>TOREFRONTS</i>) E: CUSTOM KYNAR FINISH TEAL" COLOR <i>EDGE</i>) TYPE: WALL COPING <i>EDGE</i>) TYPE: VINYL COATED DRIP EDGE <i>LESS NOTED OTHERWISE</i>) TYPE: SEE SPECIFICATIONS <i>NY METAL DECK & SUPPORT STEEL</i>) TYPE: SEE SPECIFICATIONS <i>NY METAL DECK & SUPPORT STEEL</i>) TYPE: SEE SPECIFICATIONS <i>NY METAL DECK & SUPPORT STEEL</i>) TYPE: SEE SPECIFICATIONS
CMU BAS MFG: COLOR: MFG: COLOR: MFG: COLOR: MFG: COLOR: MFG: COLOR: MFG: COLOR: MFG: COLOR: MFG: COLOR: MFG: COLOR: MFG: COLOR: MFG: COLOR: MFG: COLOR: MFG: COLOR: MFG: COLOR: MFG: COLOR: MFG: COLOR:		NSCOT: (WAINSCOT OF BUI COUNTY MATERIALS 8"X16" "GALAXY" (63-239C) (MAIN FIELD COLOR) COUNTY MATERIALS 8"X8" "SOLSTICE" (63-219C) (ACCENT BANDING) COUNTY MATERIALS 8"X16" "GALAXY" (63-239C) (EXISTING ROOF, NEW GUT SHERWIN WILLIAMS SW6966 " BLUEBLOOD" (ALUMINUM DOORS AND ST YKK YES 45 TU TYPI MATCH OWNER PANTONE " (NEW BUILDING ROOFING E EXCEPTIONAL METALS TUNDRA (ENTRY CANOPY ROOFING EXCEPTIONAL METALS HARBOR BLUE (DOOR METAL FRAMES UN SHERWIN WILLIAMS SW 6767 "AQUARIUM" AL DECK 1: (BREEZEWA SHERWIN WILLIAMS SW 7757 HIGH REFLECTIVE AL DECK 2: (EXIST. BLD SHERWIN WILLIAMS MATCH OWNER PANTONE "	LUDING) TYPE: ULTRA BURNISHED SUPPLIER: READING ROCK TYPE: ULTRA BURNISHED SUPPLIER: READING ROCK TYPE: ULTRA BURNISHED SUPPLIER: READING ROCK TERS, AND DOWNSPOUTS) TYPE: SEE SPECIFICATIONS TYPE: SEE SPECIFICATIONS FOREFRONTS) E: CUSTOM KYNAR FINISH TEAL" COLOR EDGE) TYPE: WALL COPING EDGE) TYPE: VINYL COATED DRIP EDGE LESS NOTED OTHERWISE) TYPE: SEE SPECIFICATIONS NY METAL DECK & SUPPORT STEEL) TYPE: SEE SPECIFICATIONS WHITE G ROOF SOFFITS AND FASCIA) TYPE: SEE SPECIFICATIONS BLUE" COLOR
CMU BAS MFG: COLOR: MFG: COLOR: COLOR: MFG: COLOR:		NSCOT: (WAINSCOT OF BUI COUNTY MATERIALS 8"X16" "GALAXY" (63-239C) (MAIN FIELD COLOR) COUNTY MATERIALS 8"X8" "SOLSTICE" (63-219C) (ACCENT BANDING) COUNTY MATERIALS 8"X16" "GALAXY" (63-239C) (EXISTING ROOF, NEW GUT SHERWIN WILLIAMS SW6966 " BLUEBLOOD" (ALUMINUM DOORS AND ST YKK YES 45 TU TYPI MATCH OWNER PANTONE " (NEW BUILDING ROOFING E EXCEPTIONAL METALS TUNDRA (ENTRY CANOPY ROOFING EXCEPTIONAL METALS TUNDRA (ENTRY CANOPY ROOFING EXCEPTIONAL METALS TUNDRA (ENTRY CANOPY ROOFING EXCEPTIONAL METALS HARBOR BLUE (DOOR METAL FRAMES UN SHERWIN WILLIAMS SW 6767 "AQUARIUM" AL DECK 1: (BREEZEWA SHERWIN WILLIAMS SW 7757 HIGH REFLECTIVE AL DECK 2: (EXIST. BLD SHERWIN WILLIAMS MATCH OWNER PANTONE " S: (BUILDING SUPPOR SHERWIN WILLIAMS BLACK S: (FRONT BUILDING S SHERWIN WILLIAMS BLACK	 <i>ILDING</i>) TYPE: ULTRA BURNISHED SUPPLIER: READING ROCK TYPE: ULTRA BURNISHED SUPPLIER: READING ROCK TYPE: ULTRA BURNISHED SUPPLIER: READING ROCK <i>TERS, AND DOWNSPOUTS</i>) TYPE: SEE SPECIFICATIONS <i>FOREFRONTS</i>) E: CUSTOM KYNAR FINISH TEAL" COLOR <i>EDGE</i>) TYPE: WALL COPING <i>EDGE</i>) TYPE: VINYL COATED DRIP EDGE <i>ILESS NOTED OTHERWISE</i>) TYPE: SEE SPECIFICATIONS <i>NY METAL DECK & SUPPORT STEEL</i>) TYPE: SEE SPECIFICATIONS <i>NY METAL DECK & SUPPORT STEEL</i>) TYPE: SEE SPECIFICATIONS <i>NHITE</i> <i>G ROOF SOFFITS AND FASCIA</i>) TYPE: SEE SPECIFICATIONS <i>BLUE</i>" COLOR <i>TFRAMING</i>) TYPE: KYNAR FINISH
CMU BAS MFG: COLOR: MFG: COLOR: COLOR: MFG: COLOR:		NSCOT: (WAINSCOT OF BUI COUNTY MATERIALS 8"X16" "GALAXY" (63-239C) (MAIN FIELD COLOR) COUNTY MATERIALS 8"X8" "SOLSTICE" (63-219C) (ACCENT BANDING) COUNTY MATERIALS 8"X16" "GALAXY" (63-239C) (EXISTING ROOF, NEW GUT SHERWIN WILLIAMS SW6966 " BLUEBLOOD" (ALUMINUM DOORS AND ST YKK YES 45 TU TYPI MATCH OWNER PANTONE " (NEW BUILDING ROOFING E EXCEPTIONAL METALS TUNDRA (ENTRY CANOPY ROOFING E EXCEPTIONAL METALS TUNDRA (ENTRY CANOPY ROOFING EXCEPTIONAL METALS HARBOR BLUE (DOOR METAL FRAMES UN SHERWIN WILLIAMS SW 6767 "AQUARIUM" AL DECK 1: (BREEZEWA SHERWIN WILLIAMS SW 7757 HIGH REFLECTIVE AL DECK 2: (EXIST. BLD SHERWIN WILLIAMS SW 7757 HIGH REFLECTIVE SHERWIN WILLIAMS SM 7757 HIGH REFLECTIVE SHERWIN WILLIAMS SM 7757 HIGH REFLECTIVE SHERWIN WILLIAMS SM 7757 HIGH REFLECTIVE SHERWIN WILLIAMS SM 7757 HIGH REFLECTIVE SHERWIN WILLIAMS SMATCH OWNER PANTONE " SHERWIN WILLIAMS BLACK SHERWIN WILLIAMS BLACK	<pre>ILDING) TYPE: ULTRA BURNISHED SUPPLIER: READING ROCK TYPE: ULTRA BURNISHED SUPPLIER: READING ROCK TYPE: ULTRA BURNISHED SUPPLIER: READING ROCK TERS, AND DOWNSPOUTS) TYPE: SEE SPECIFICATIONS TYPE: SEE SPECIFICATIONS ICOREFRONTS) E: CUSTOM KYNAR FINISH TEAL" COLOR EDGE) TYPE: WALL COPING EDGE) TYPE: VINYL COATED DRIP EDGE ILESS NOTED OTHERWISE) TYPE: SEE SPECIFICATIONS IN METAL DECK & SUPPORT STEEL) TYPE: SEE SPECIFICATIONS WHITE G ROOF SOFFITS AND FASCIA) TYPE: SEE SPECIFICATIONS BLUE" COLOR T FRAMING) TYPE: KYNAR FINISH SUPPORT FRAMING) TYPE: KYNAR FINISH TYPE: TENSILE</pre>




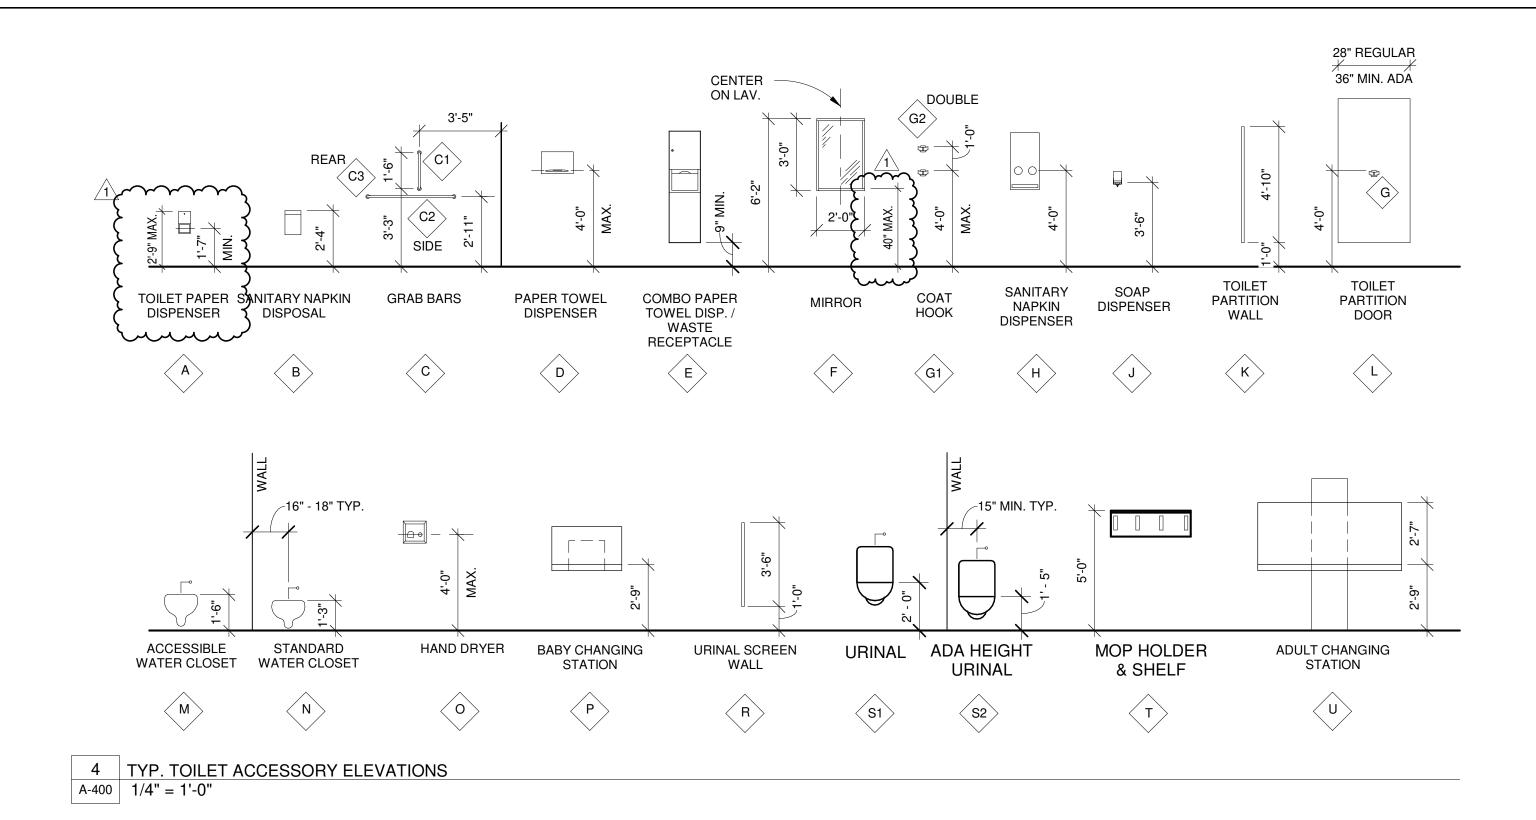


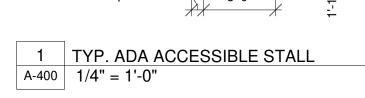

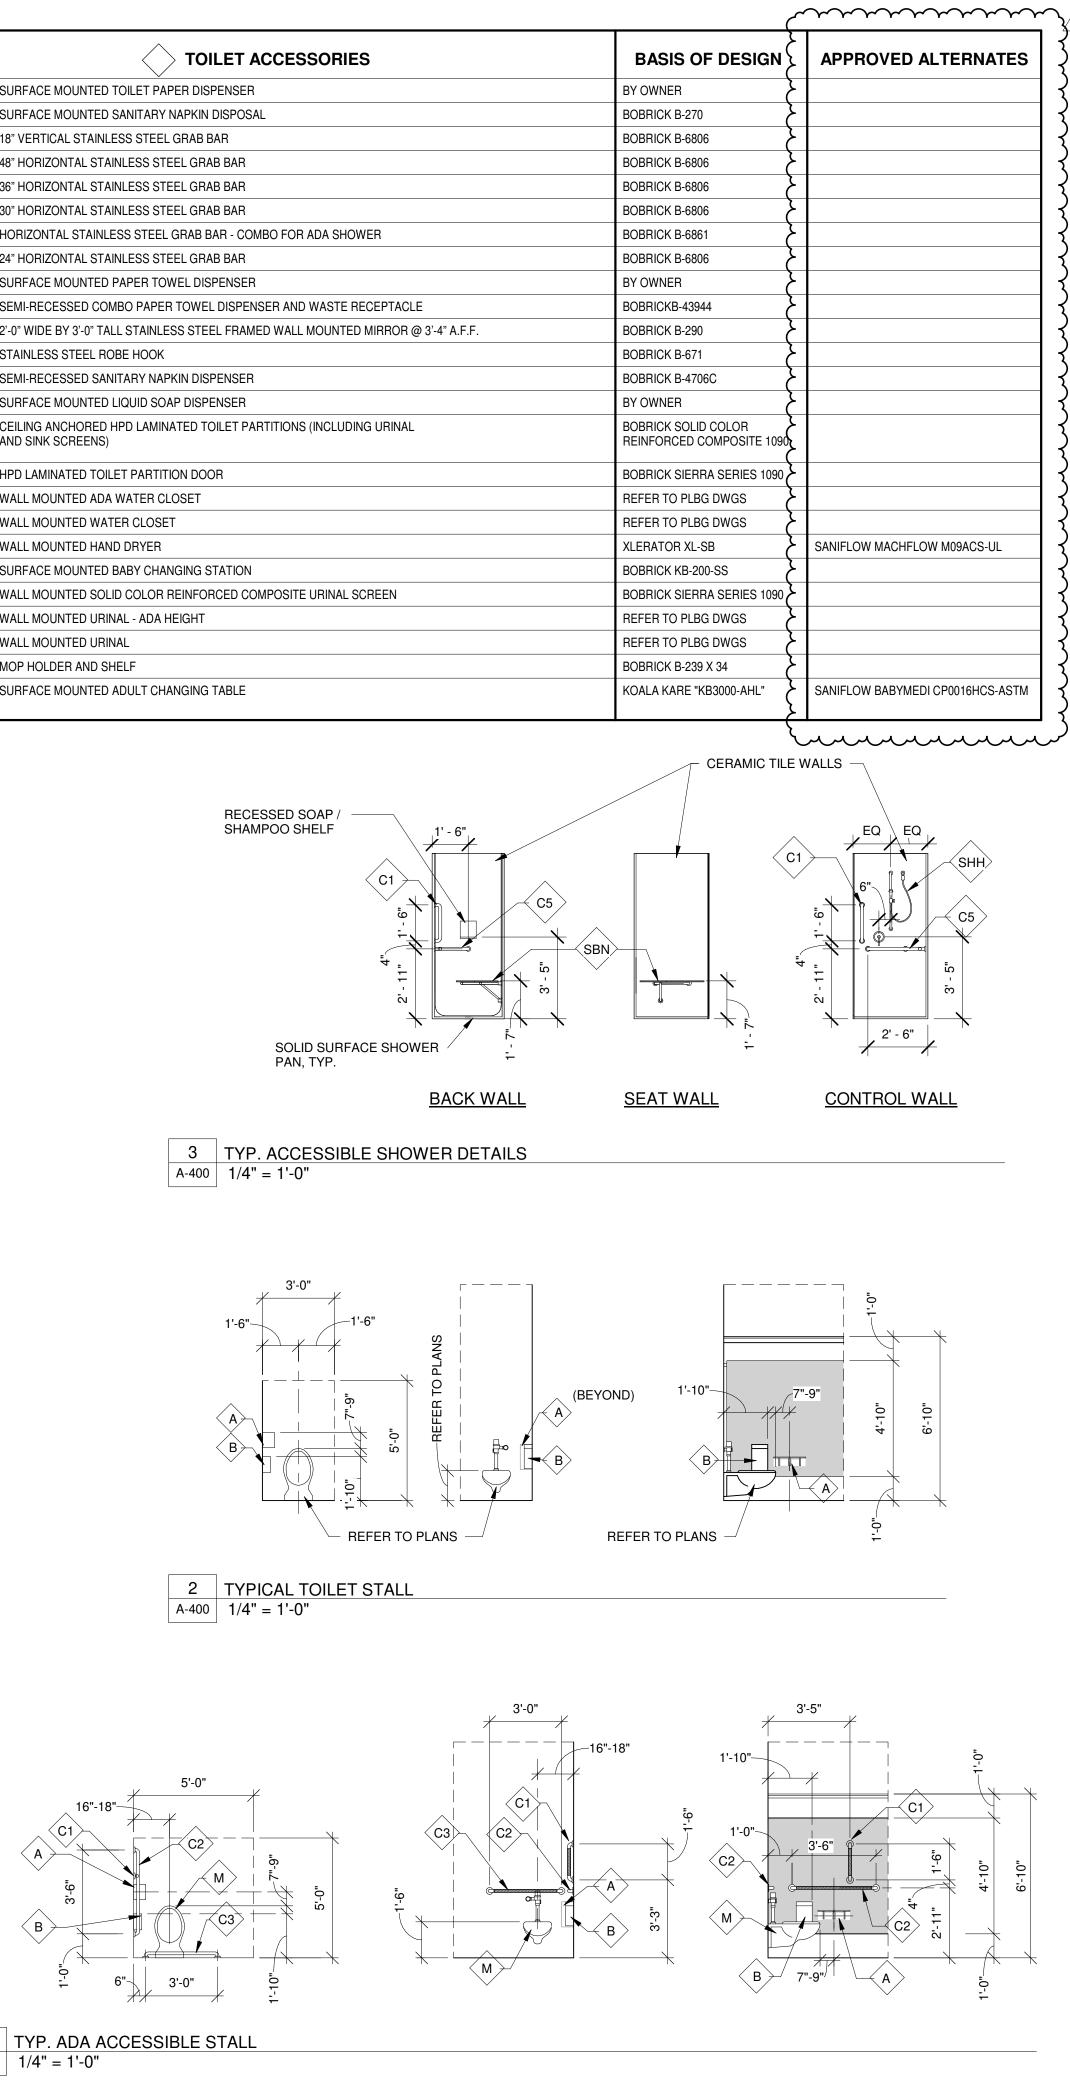

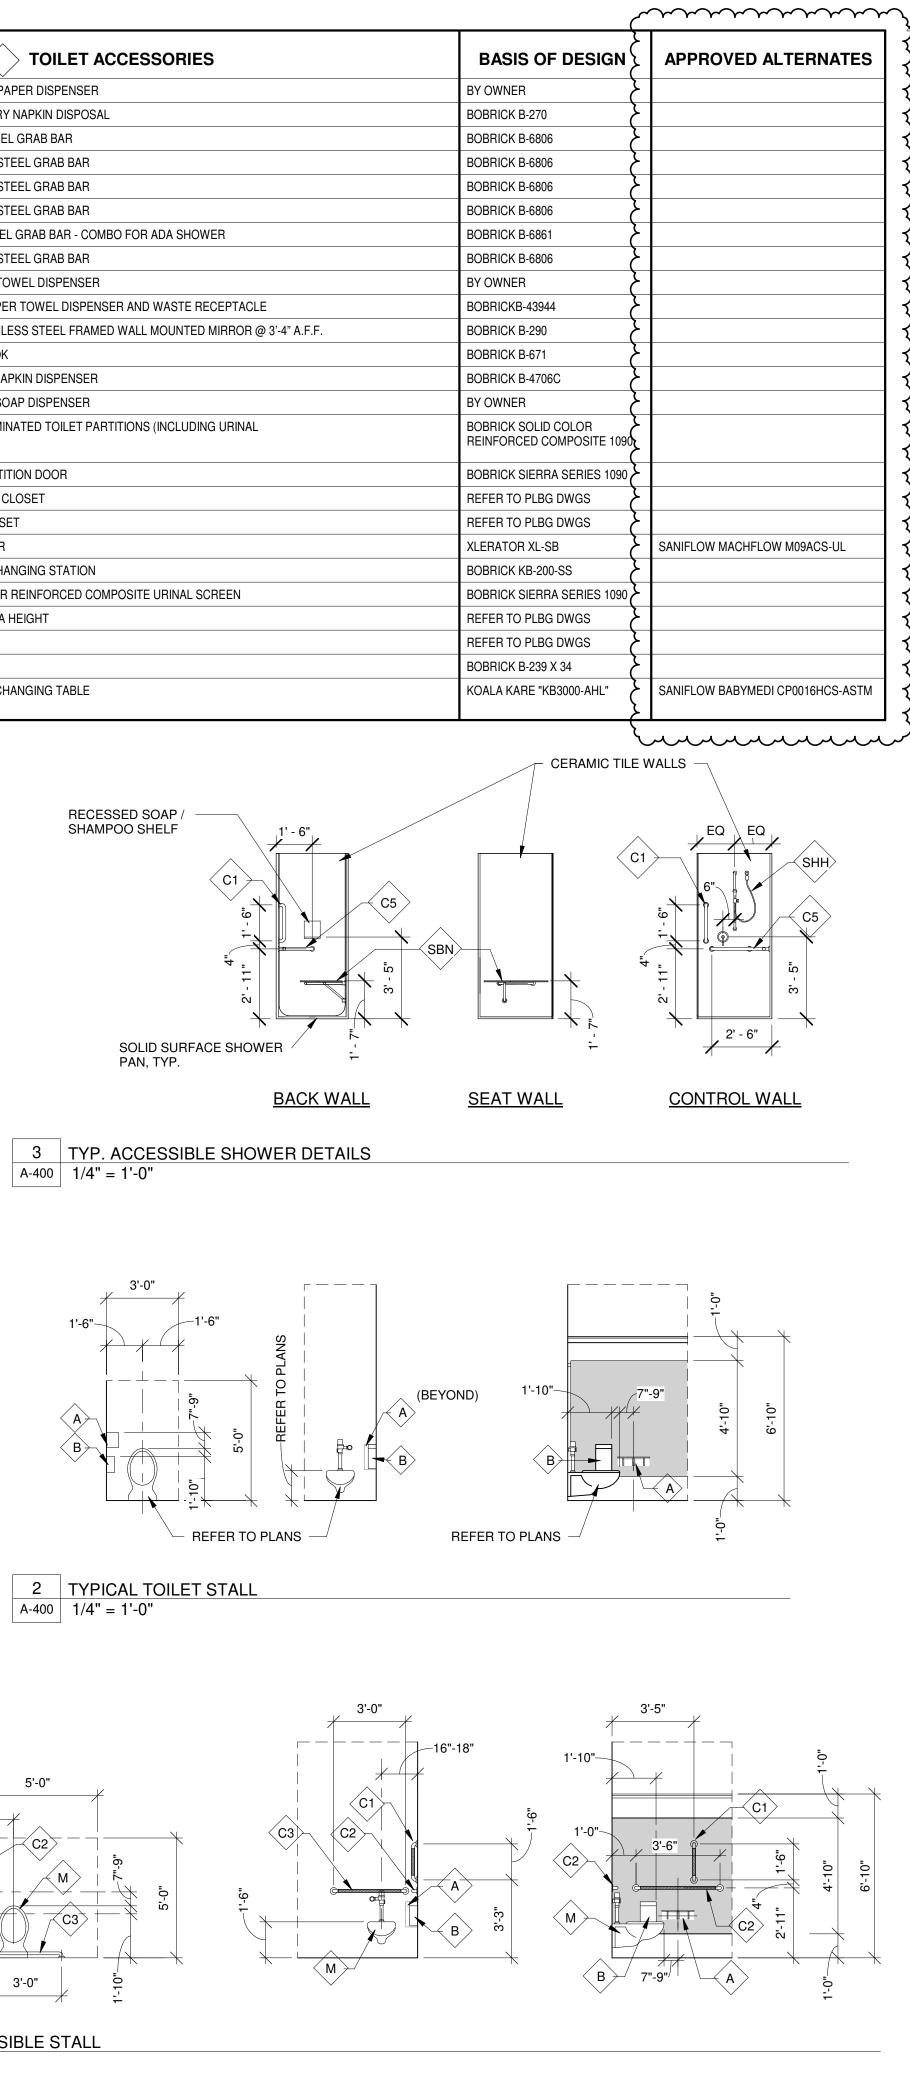


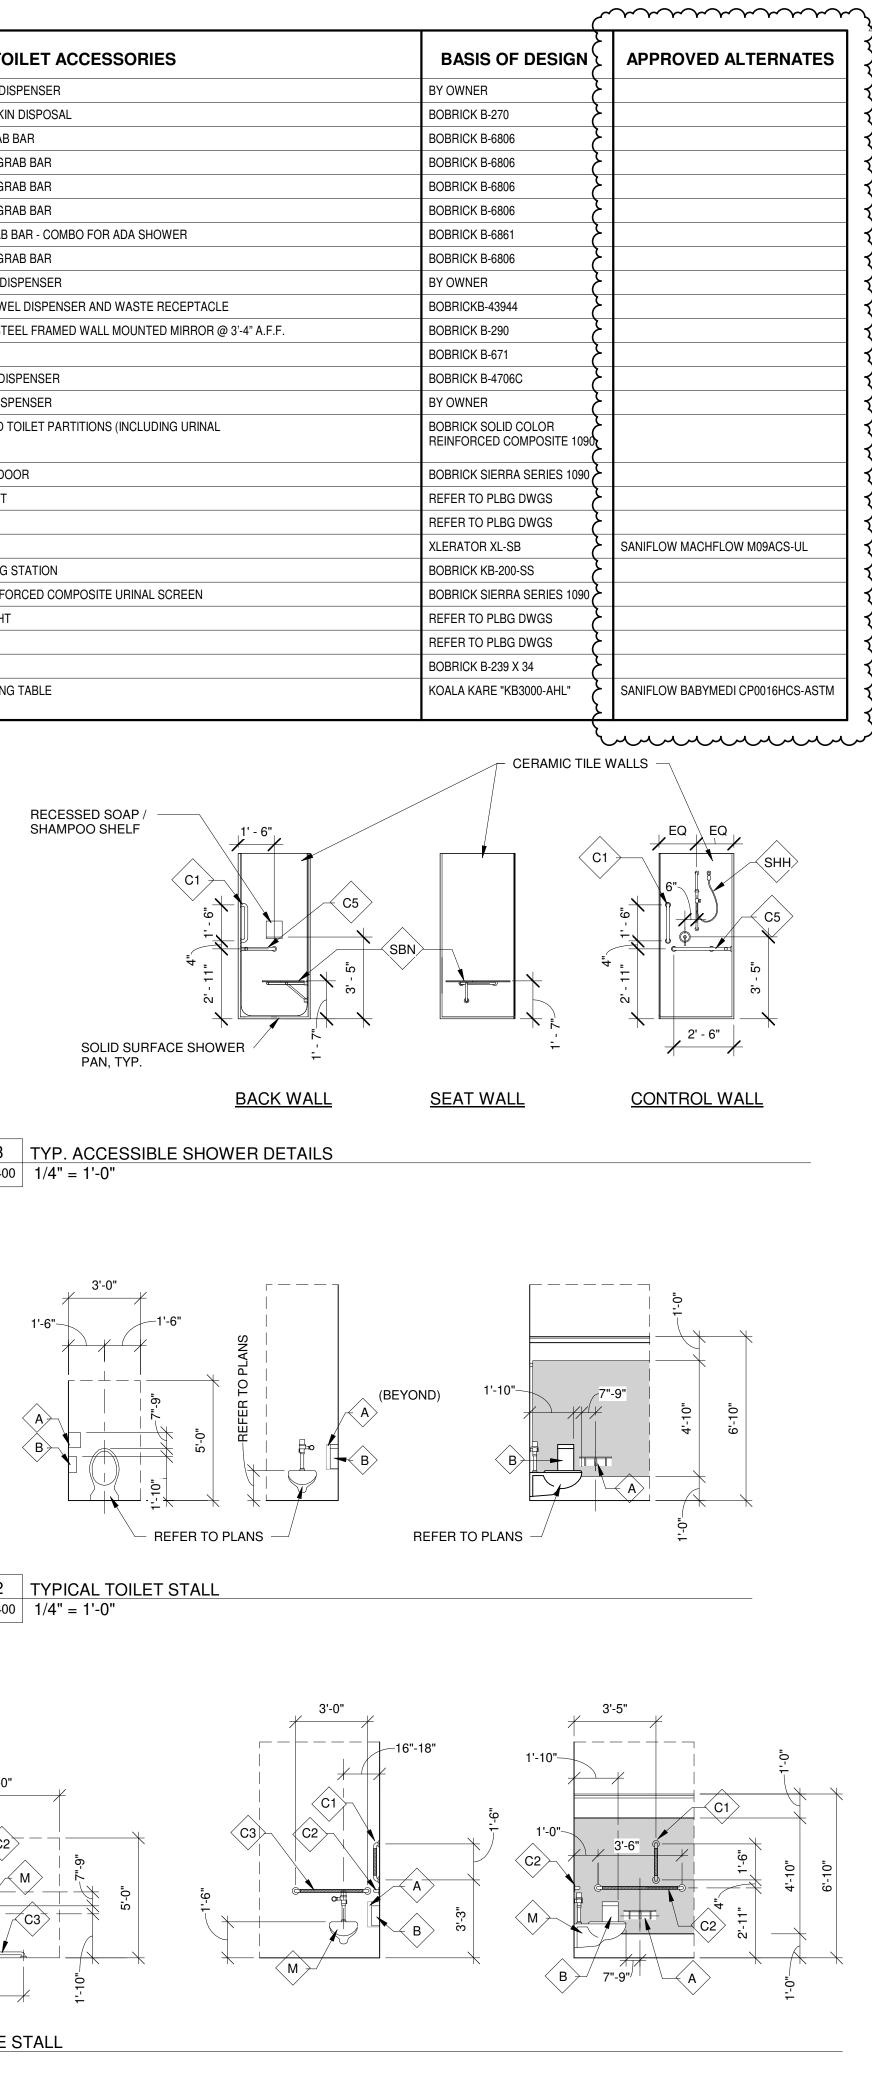


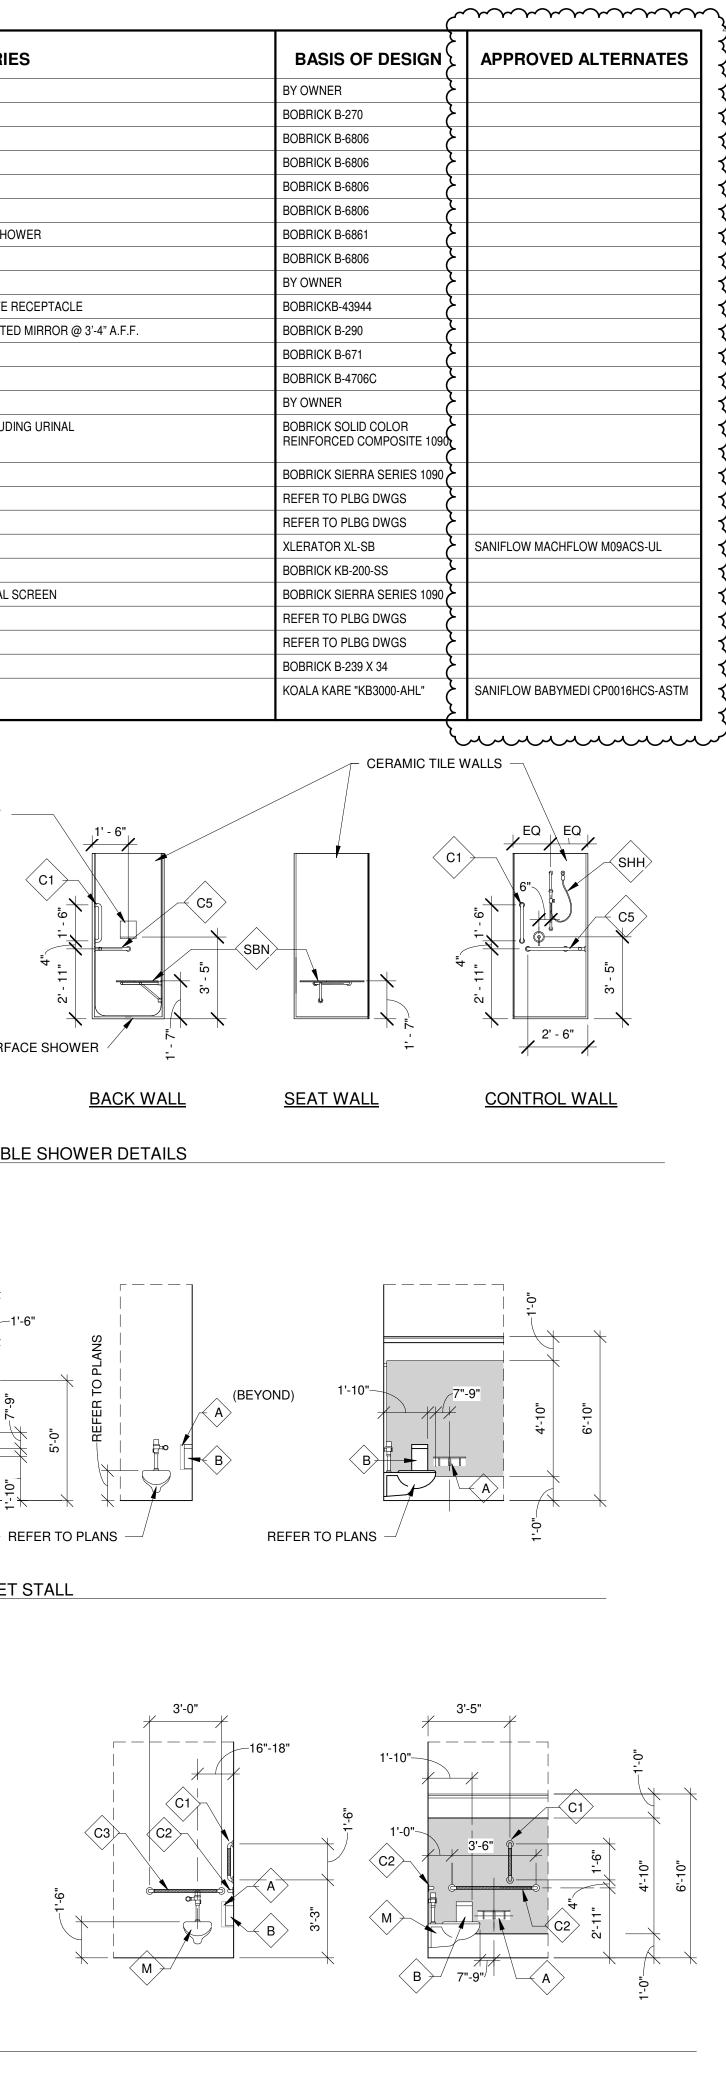


А	SURFACE MOUNTED TOILET PAPER DISPENSER
В	SURFACE MOUNTED SANITARY NAPKIN DISPOSAL
C1	18" VERTICAL STAINLESS STEEL GRAB BAR
C2	48" HORIZONTAL STAINLESS STEEL GRAB BAR
C3	36" HORIZONTAL STAINLESS STEEL GRAB BAR
C4	30" HORIZONTAL STAINLESS STEEL GRAB BAR
C5	HORIZONTAL STAINLESS STEEL GRAB BAR - COMBO FOR ADA SHOWER
C6	24" HORIZONTAL STAINLESS STEEL GRAB BAR
D	SURFACE MOUNTED PAPER TOWEL DISPENSER
Е	SEMI-RECESSED COMBO PAPER TOWEL DISPENSER AND WASTE RECEPTACLE
F	2'-0" WIDE BY 3'-0" TALL STAINLESS STEEL FRAMED WALL MOUNTED MIRROR @
G1 & G2	STAINLESS STEEL ROBE HOOK
Н	SEMI-RECESSED SANITARY NAPKIN DISPENSER
J	SURFACE MOUNTED LIQUID SOAP DISPENSER
K	CEILING ANCHORED HPD LAMINATED TOILET PARTITIONS (INCLUDING URINAL AND SINK SCREENS)
L	HPD LAMINATED TOILET PARTITION DOOR
М	WALL MOUNTED ADA WATER CLOSET
Ν	WALL MOUNTED WATER CLOSET
0	WALL MOUNTED HAND DRYER
Р	SURFACE MOUNTED BABY CHANGING STATION
R	WALL MOUNTED SOLID COLOR REINFORCED COMPOSITE URINAL SCREEN
S1	WALL MOUNTED URINAL - ADA HEIGHT
S2	WALL MOUNTED URINAL
Т	MOP HOLDER AND SHELF
U	SURFACE MOUNTED ADULT CHANGING TABLE




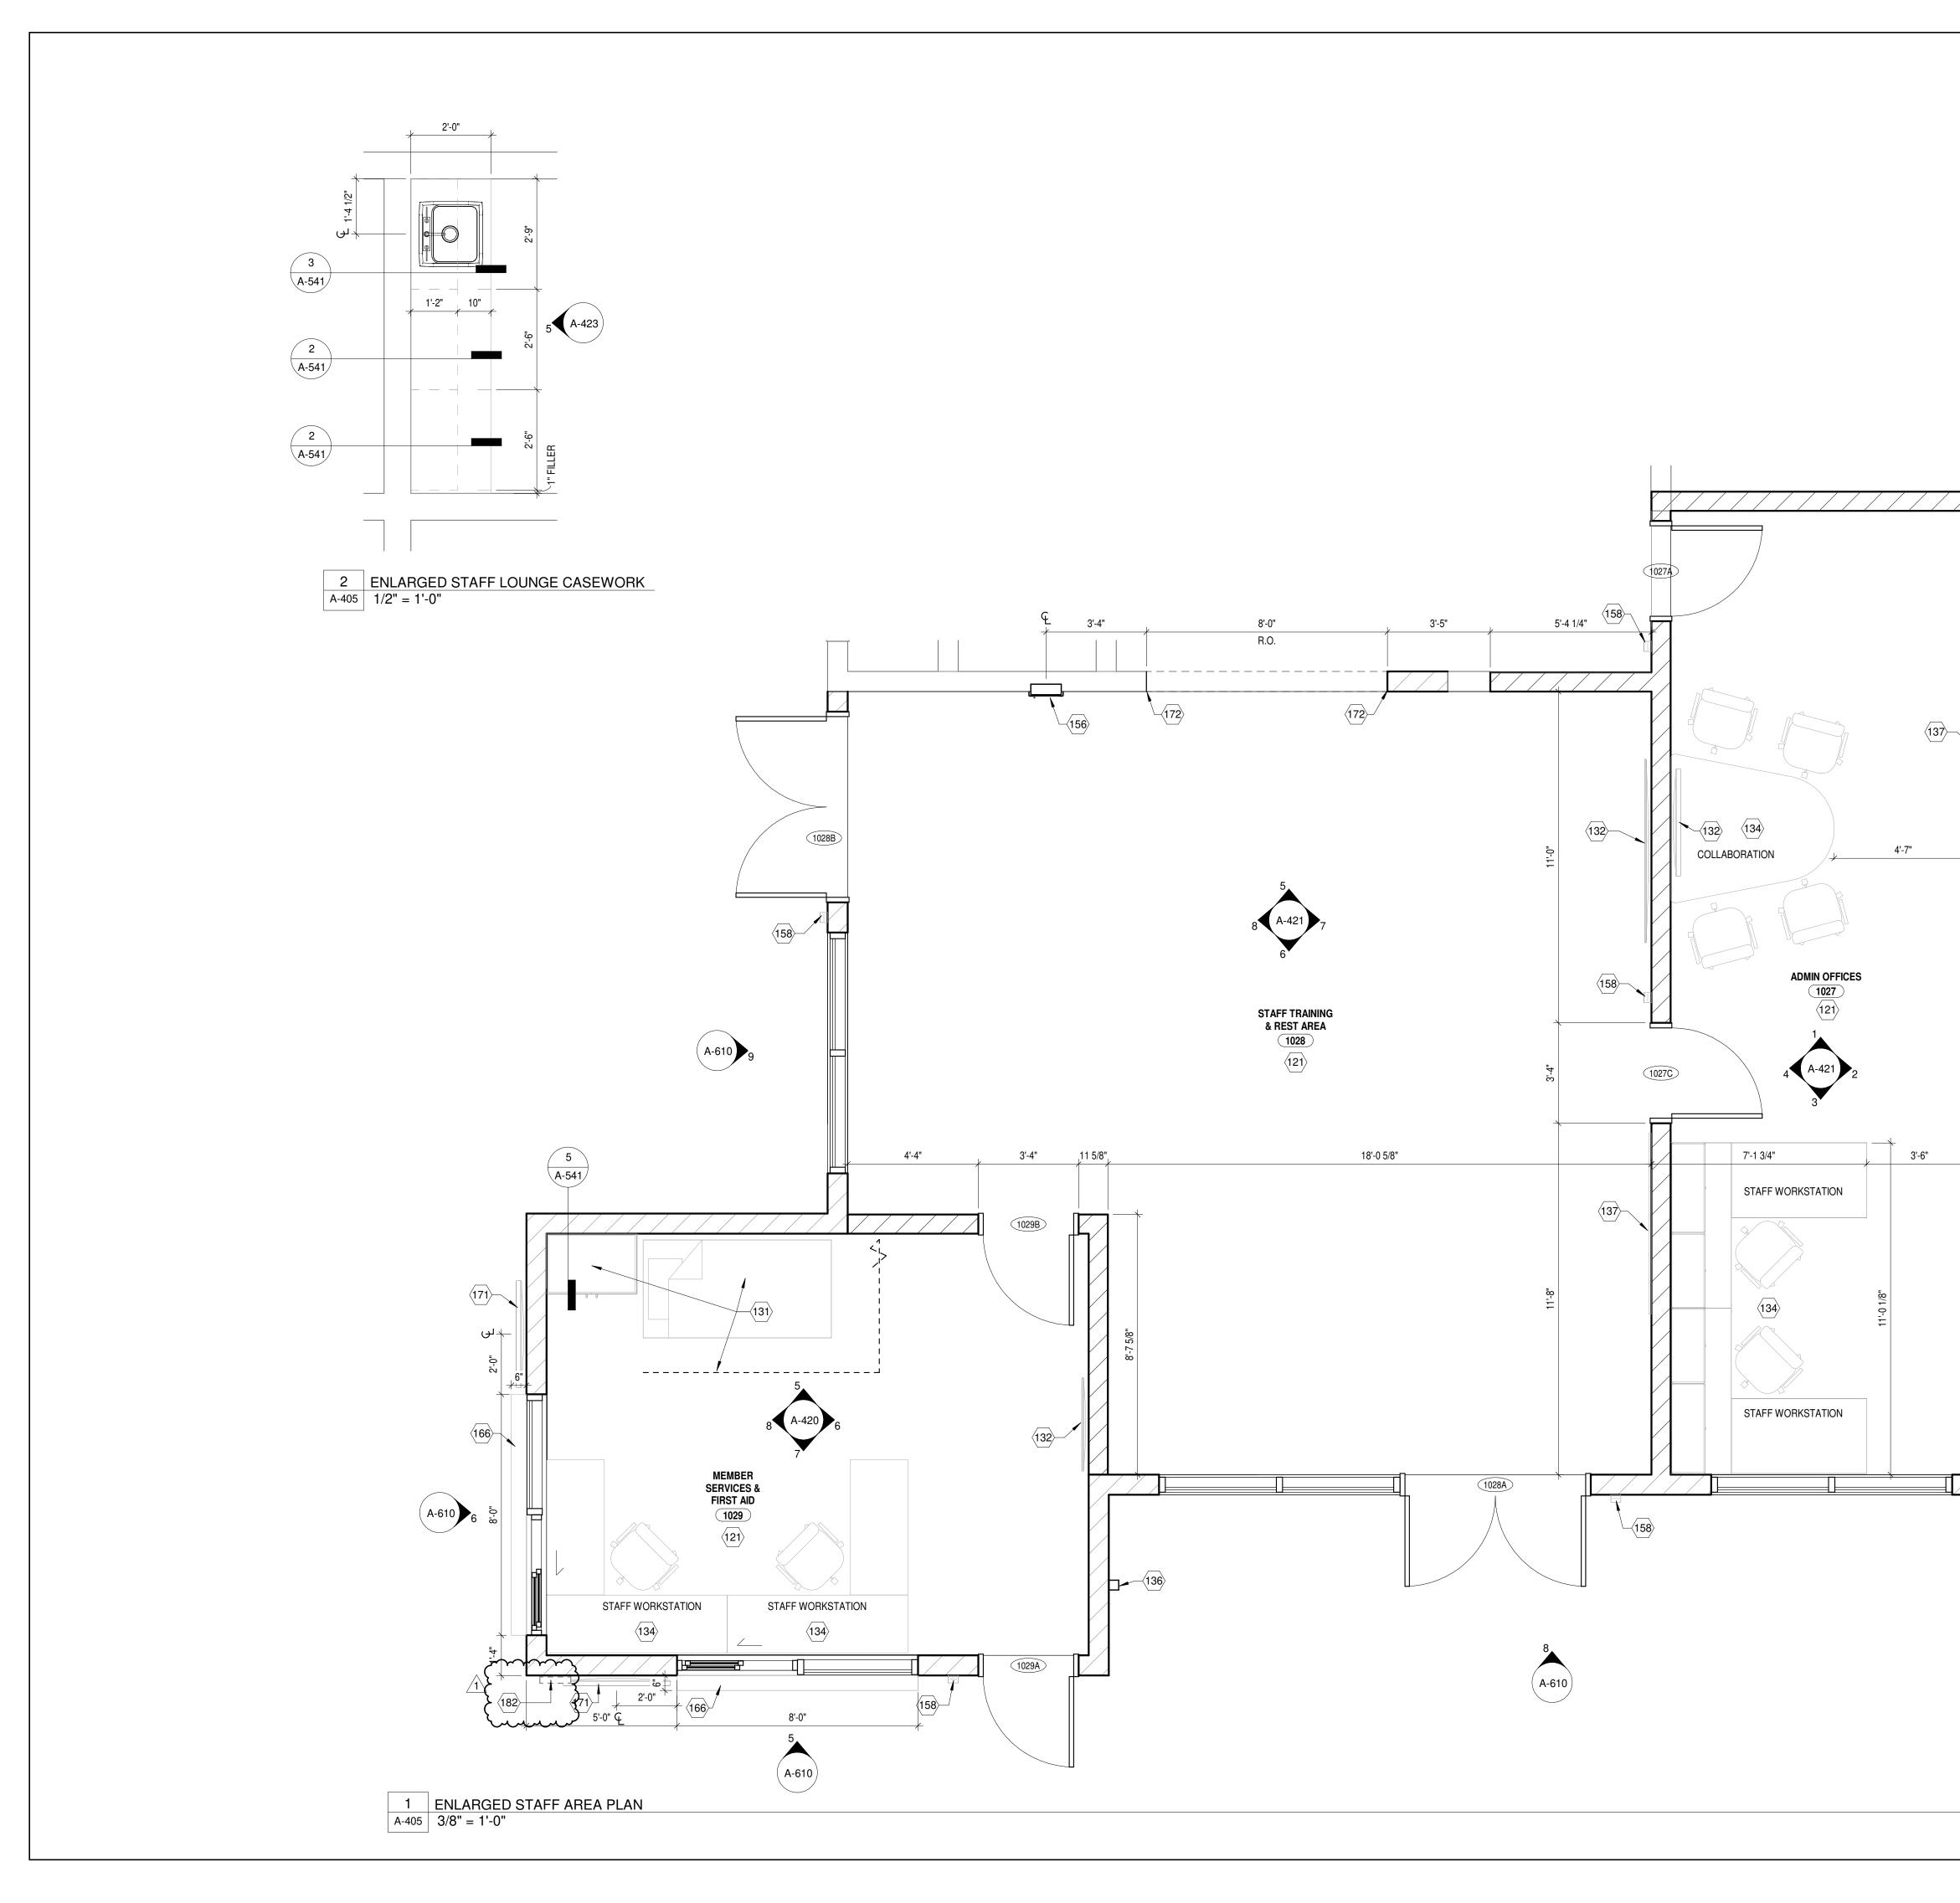


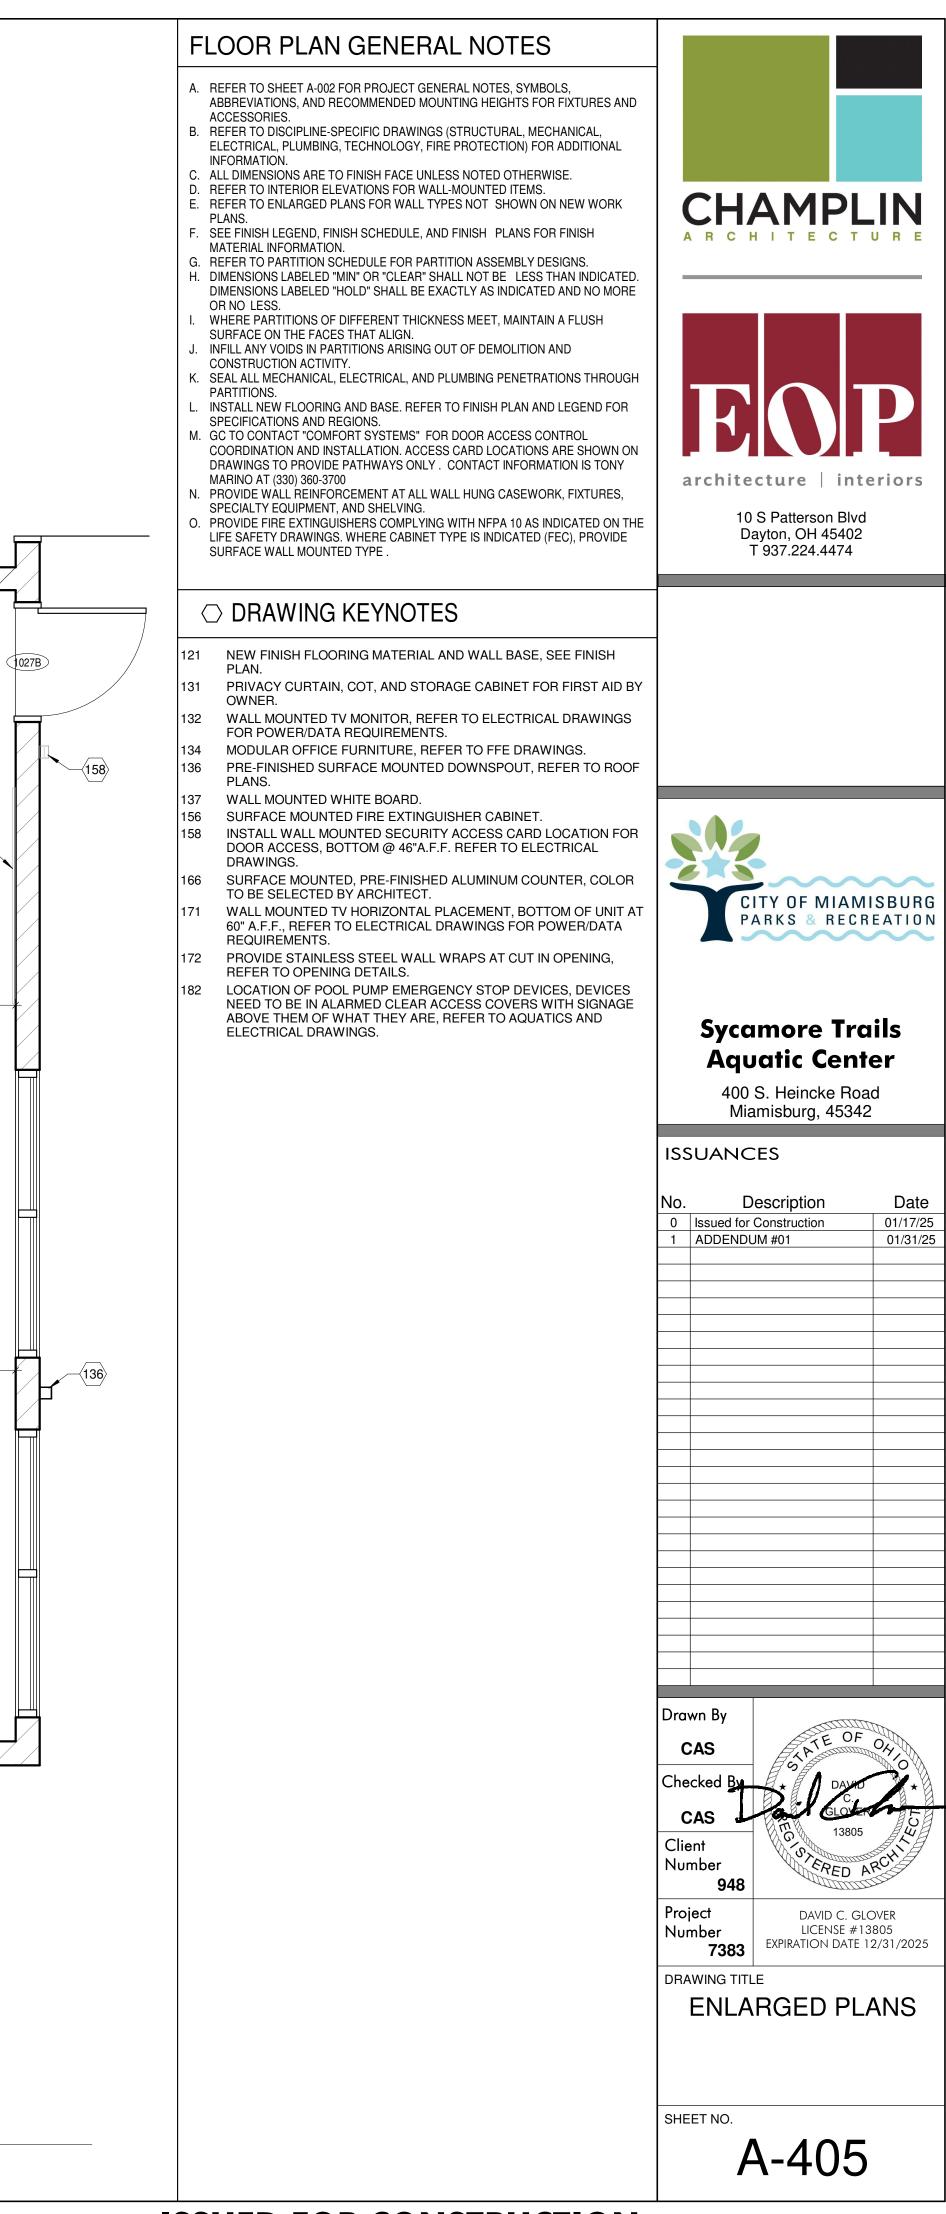

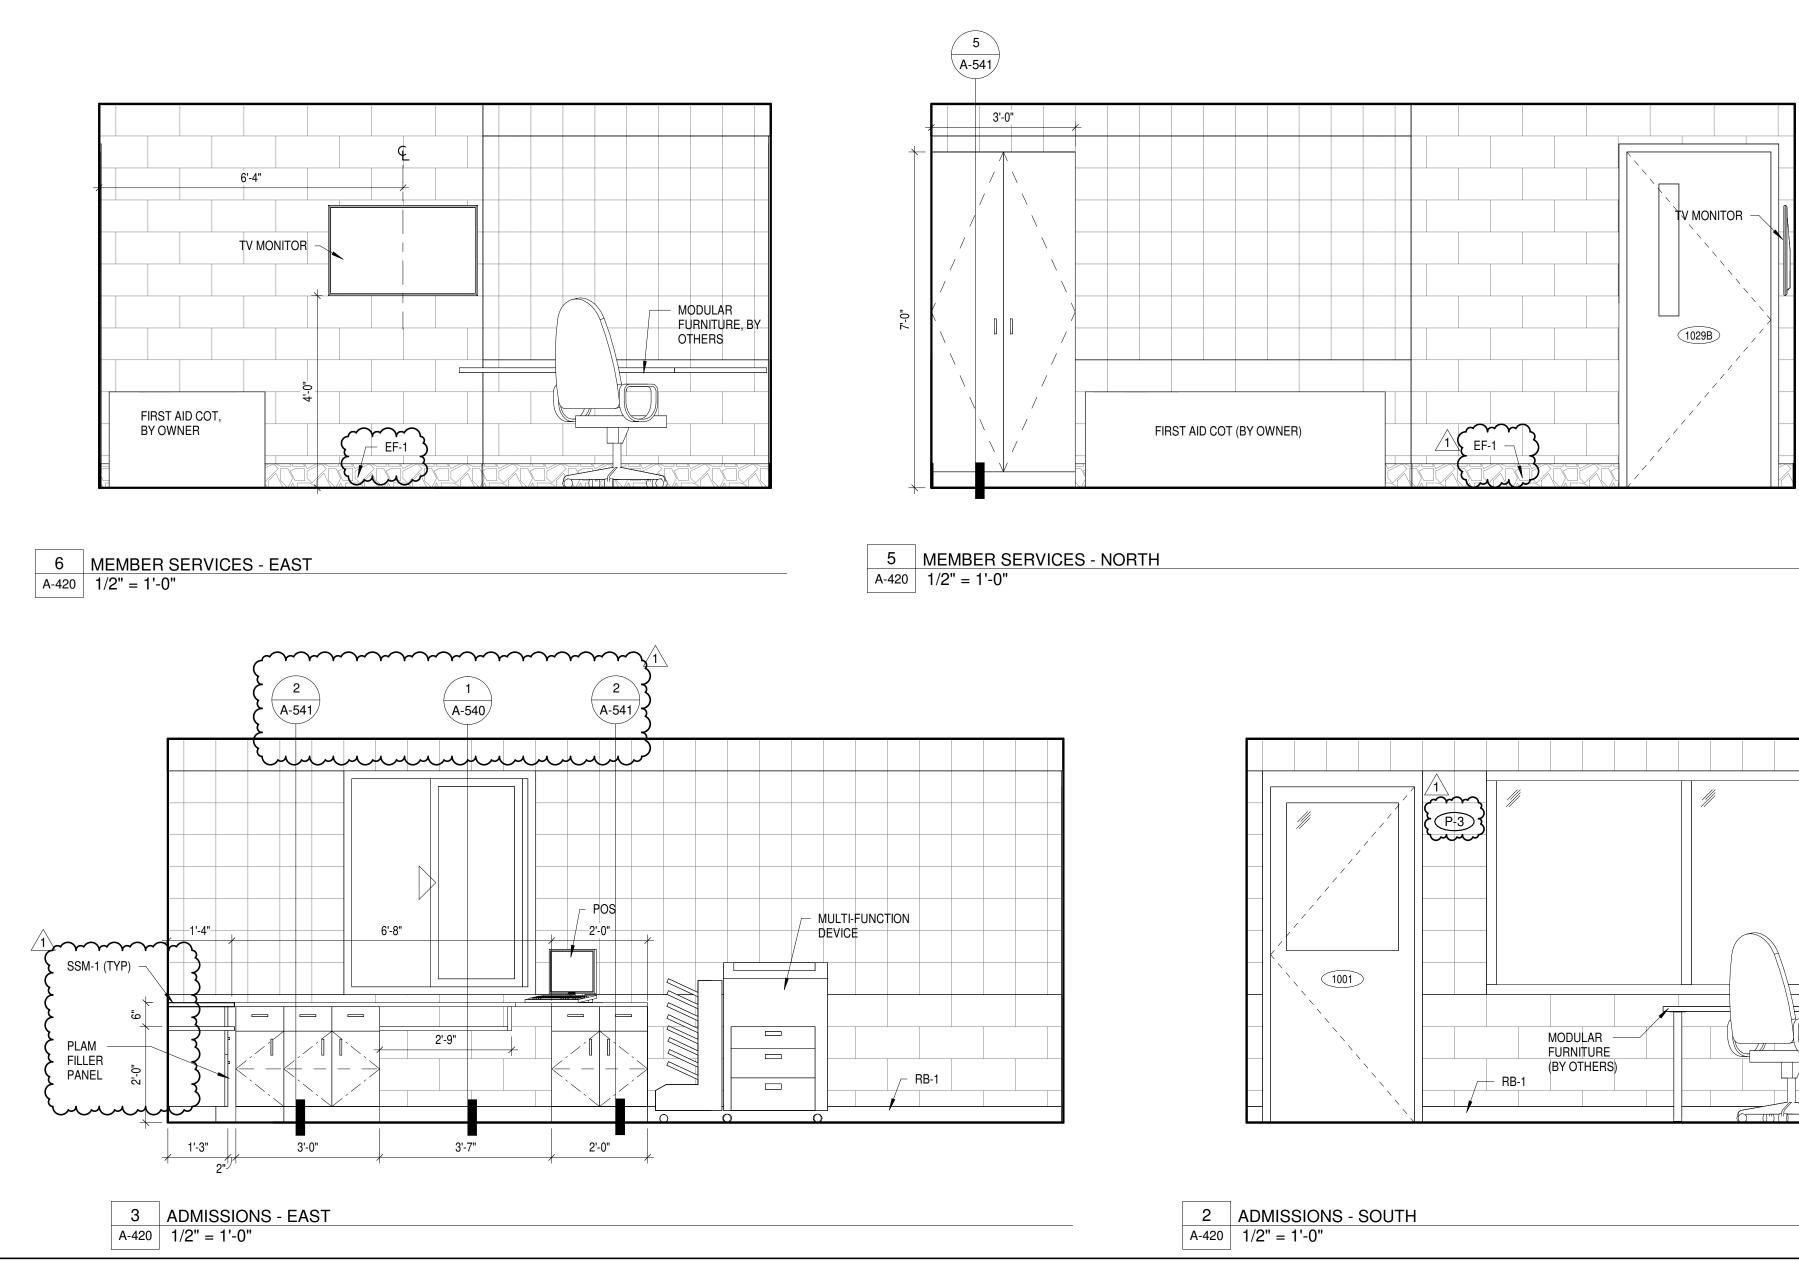





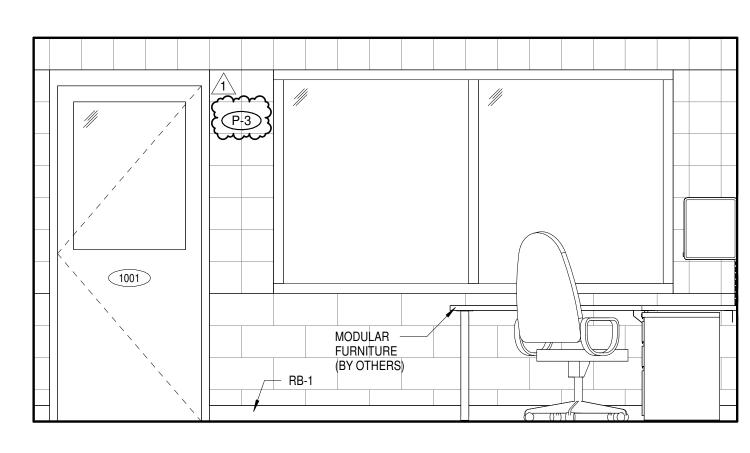


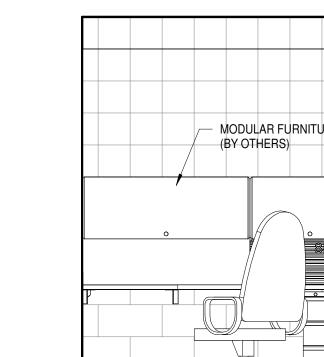





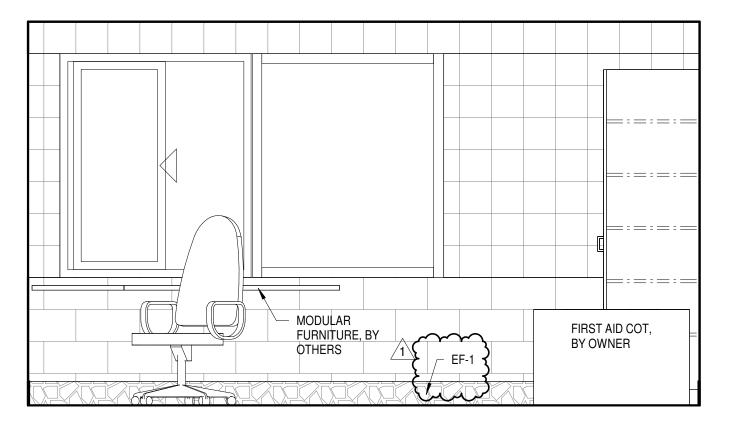


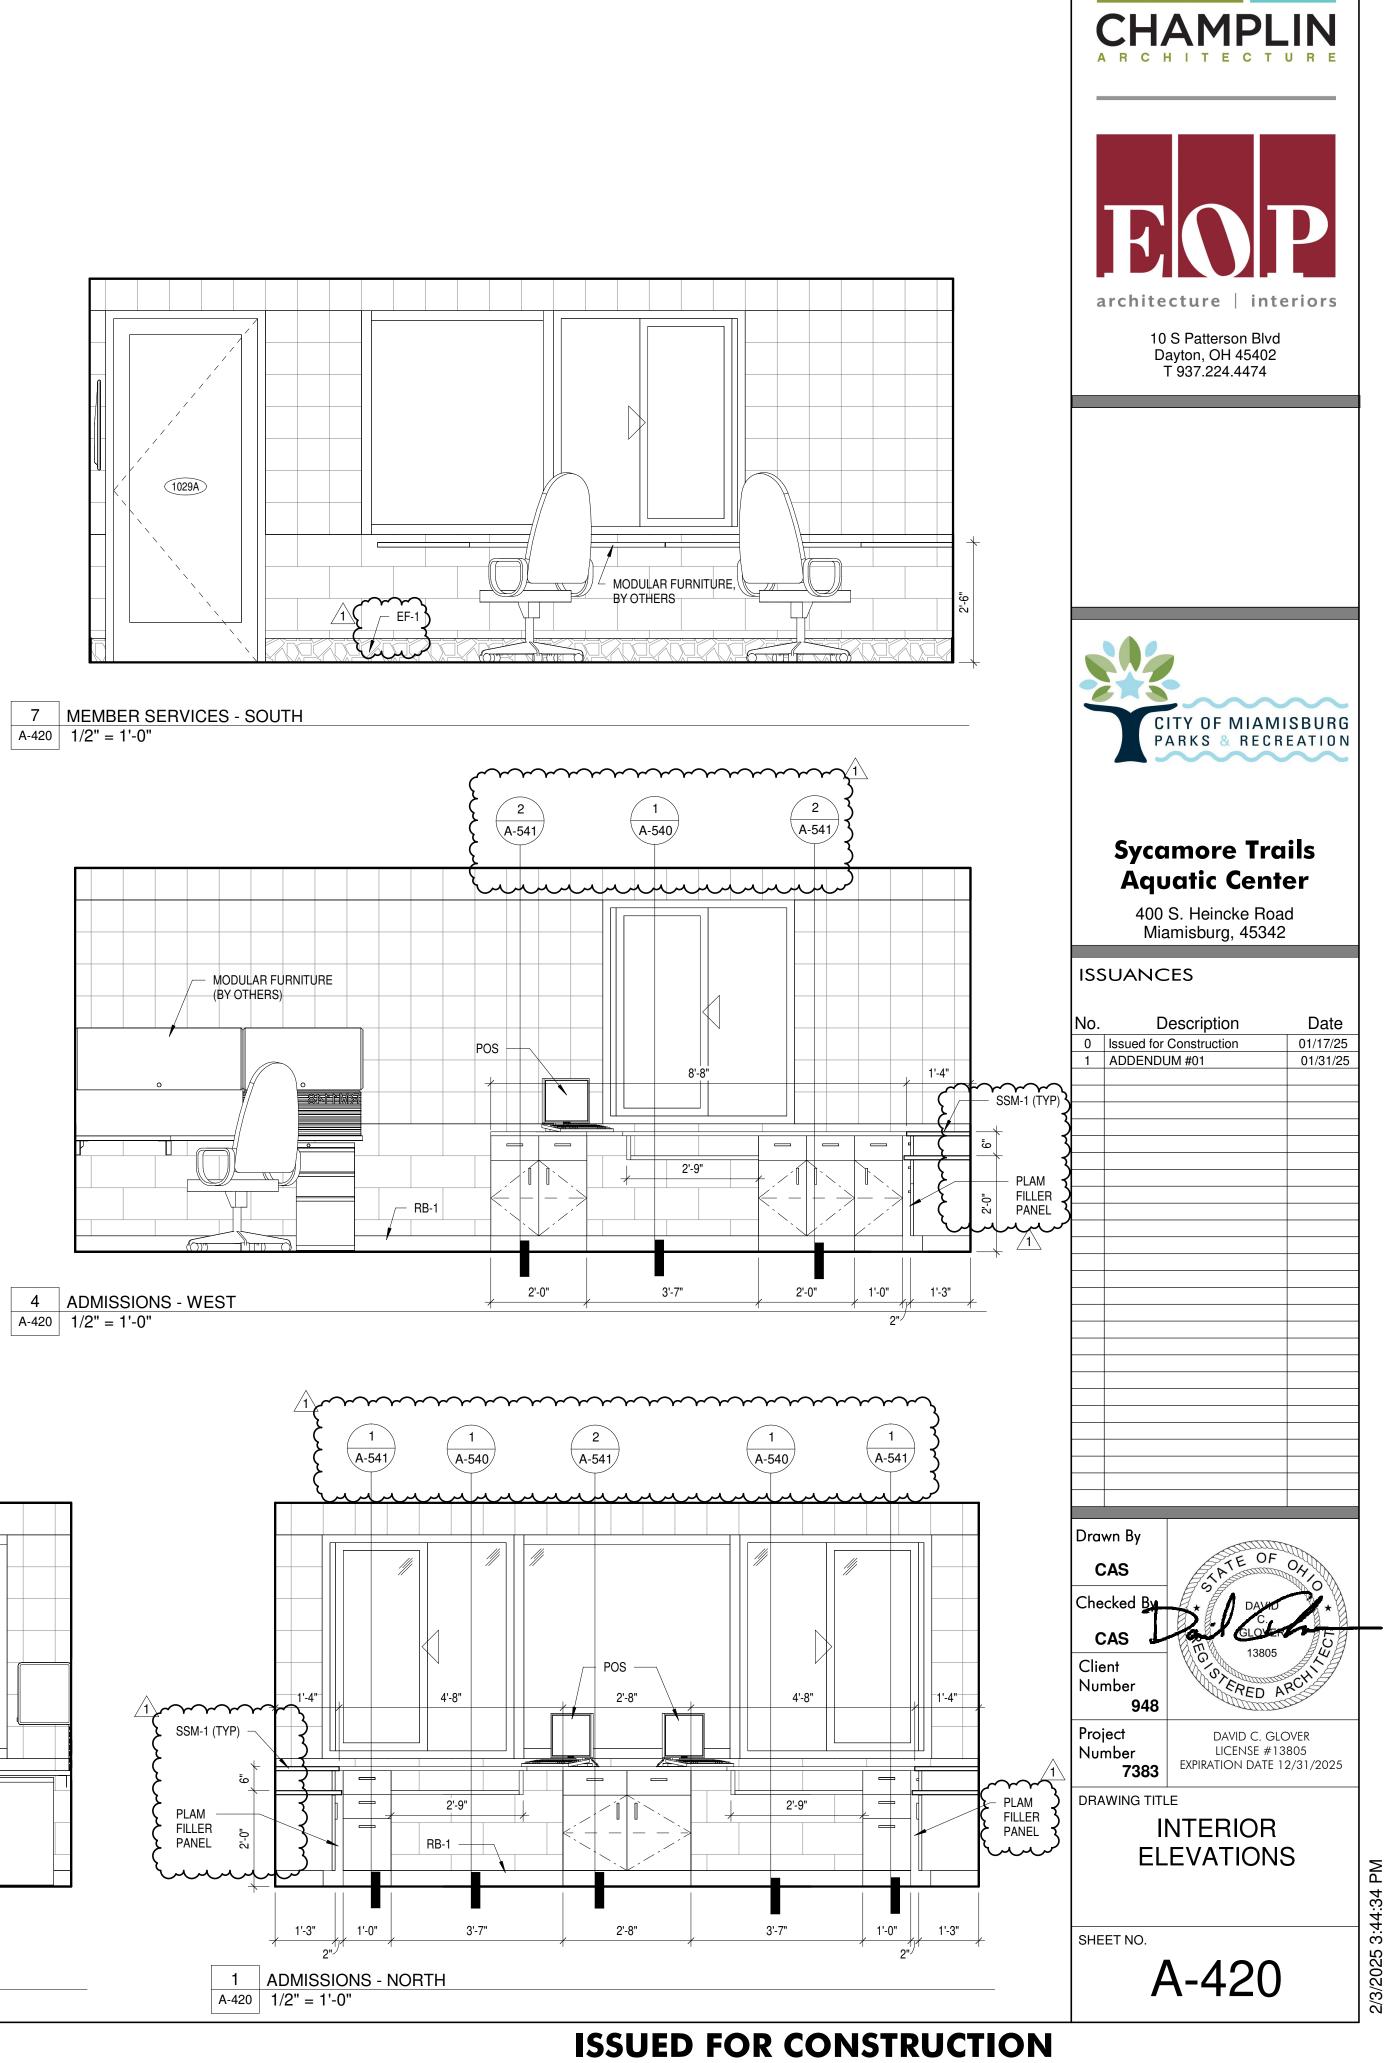


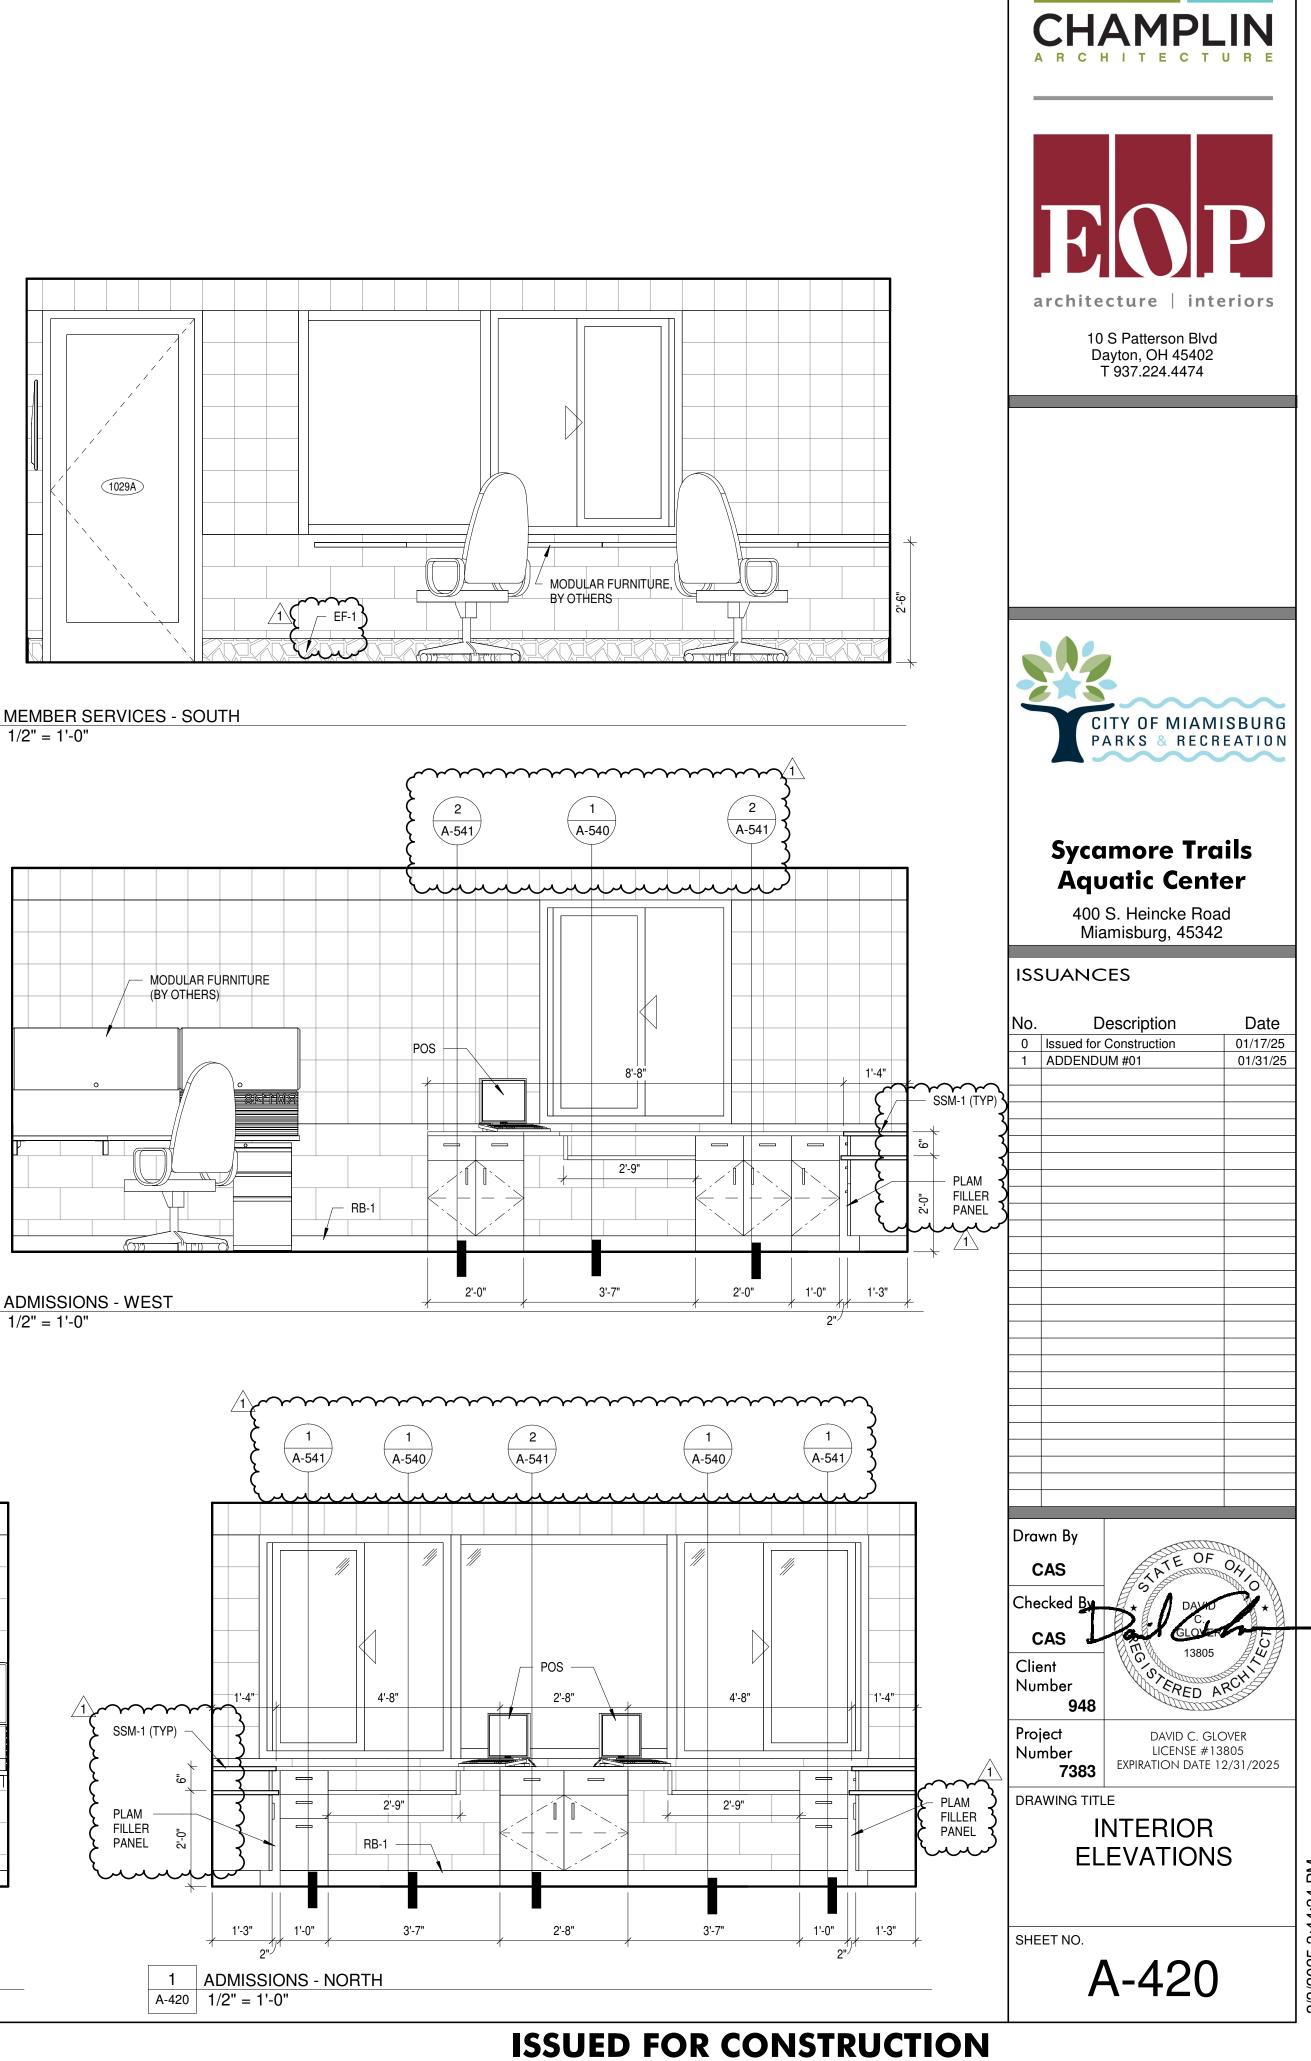


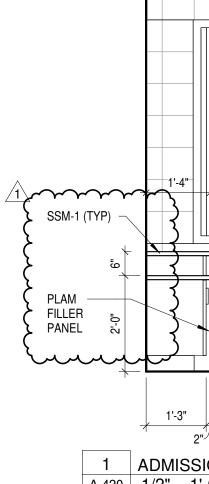


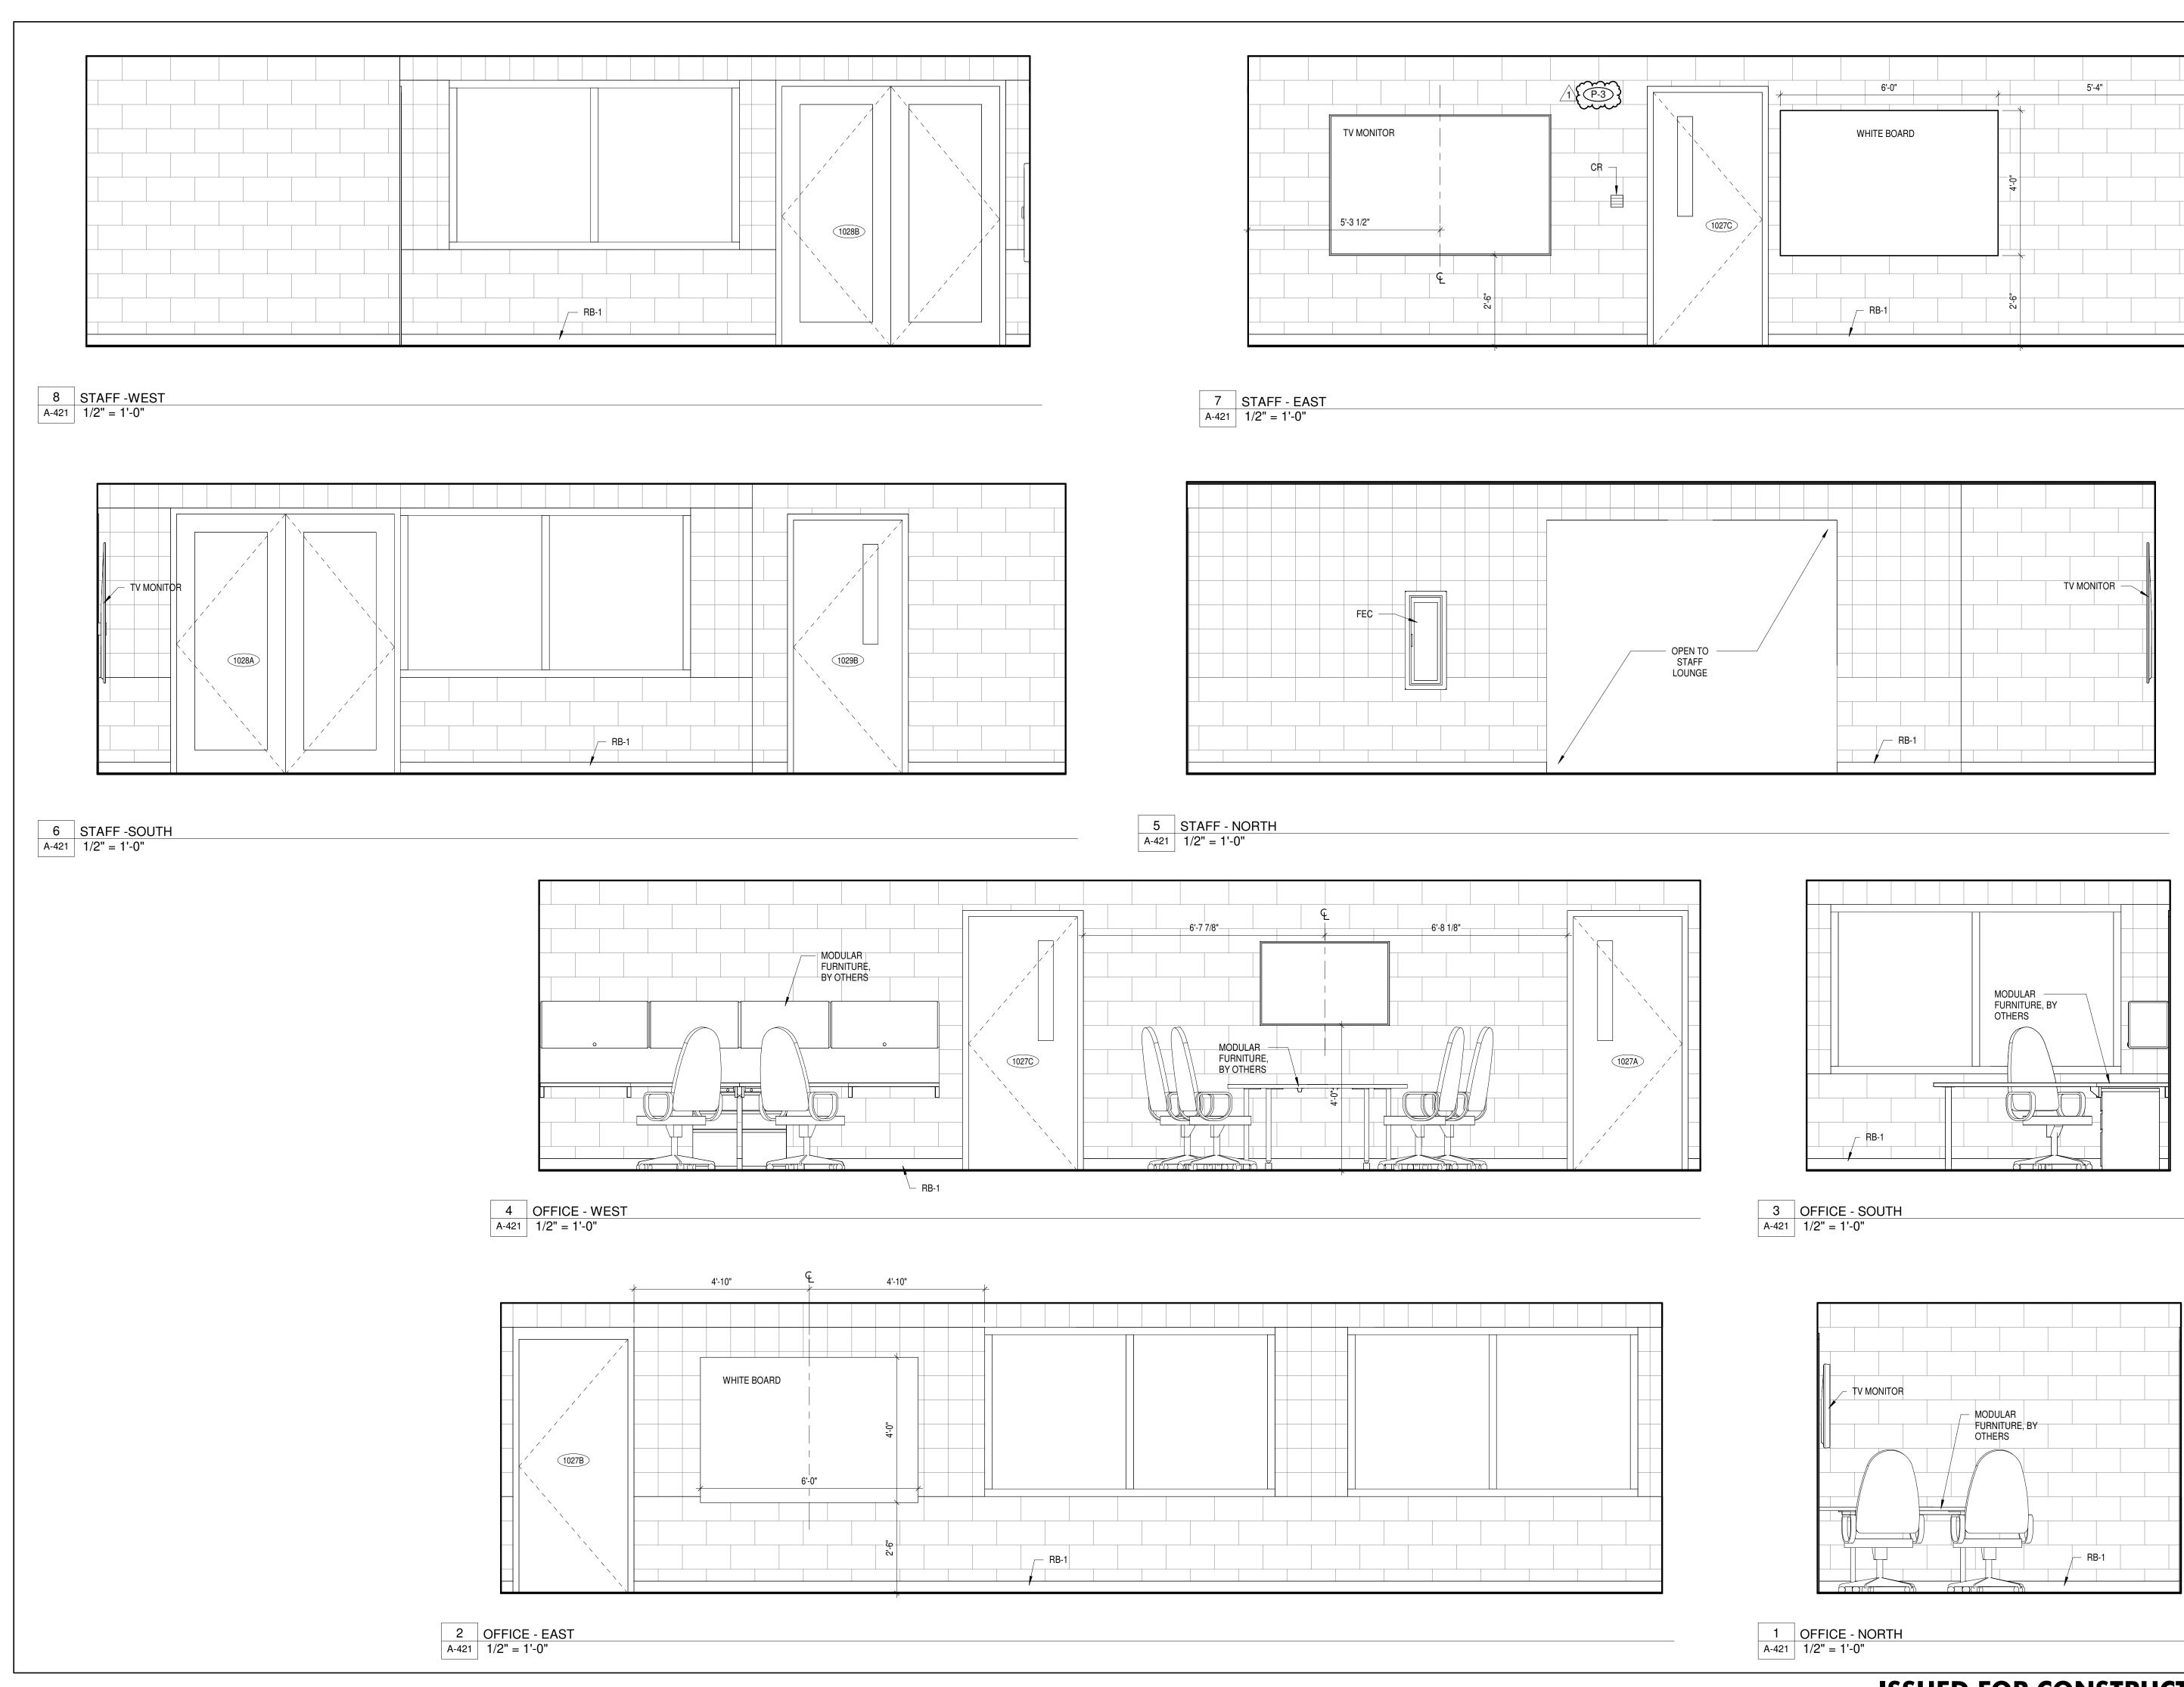

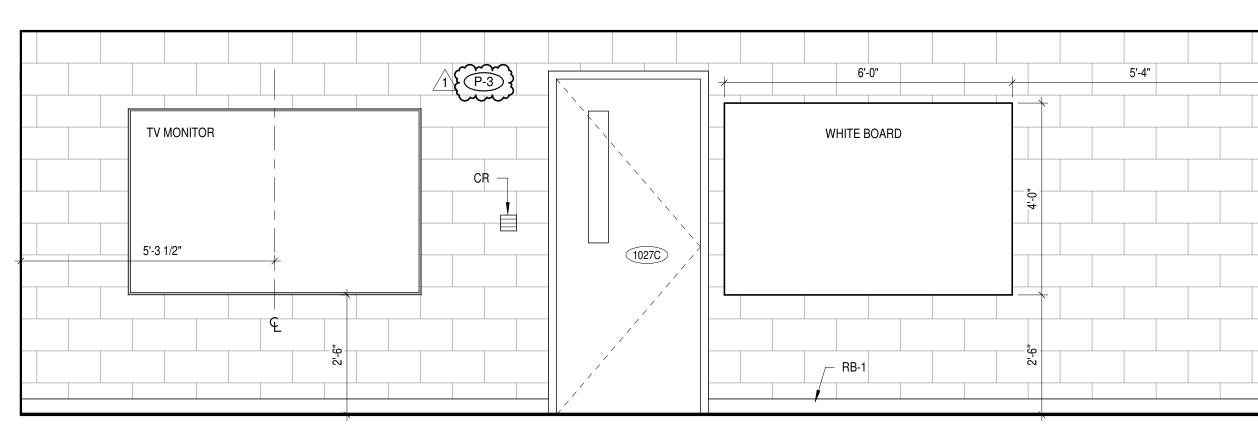


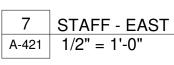


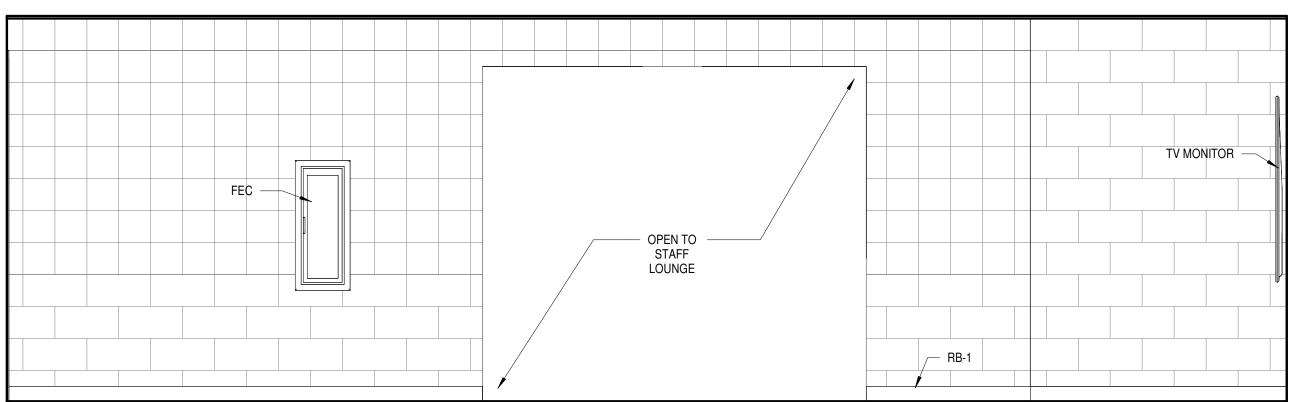


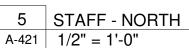





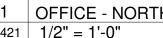


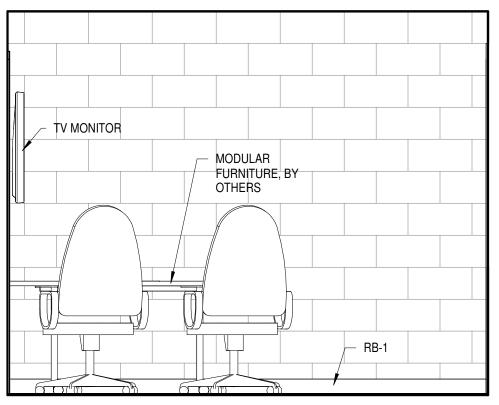


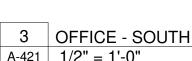


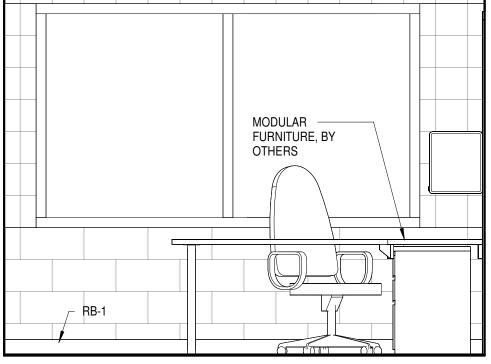

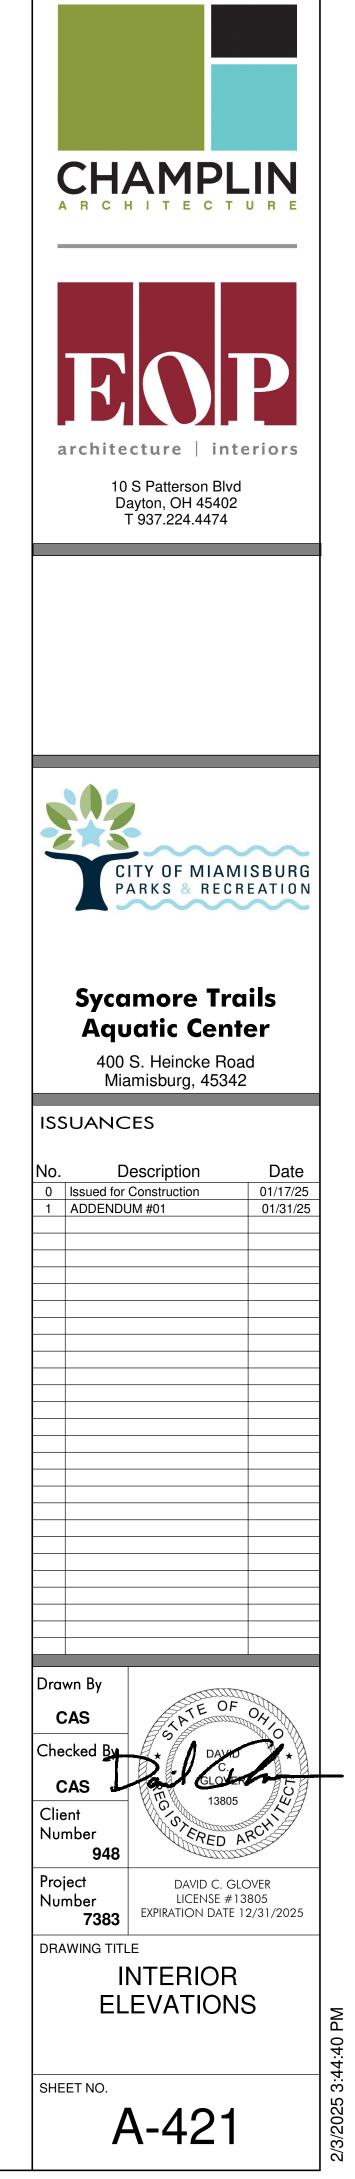


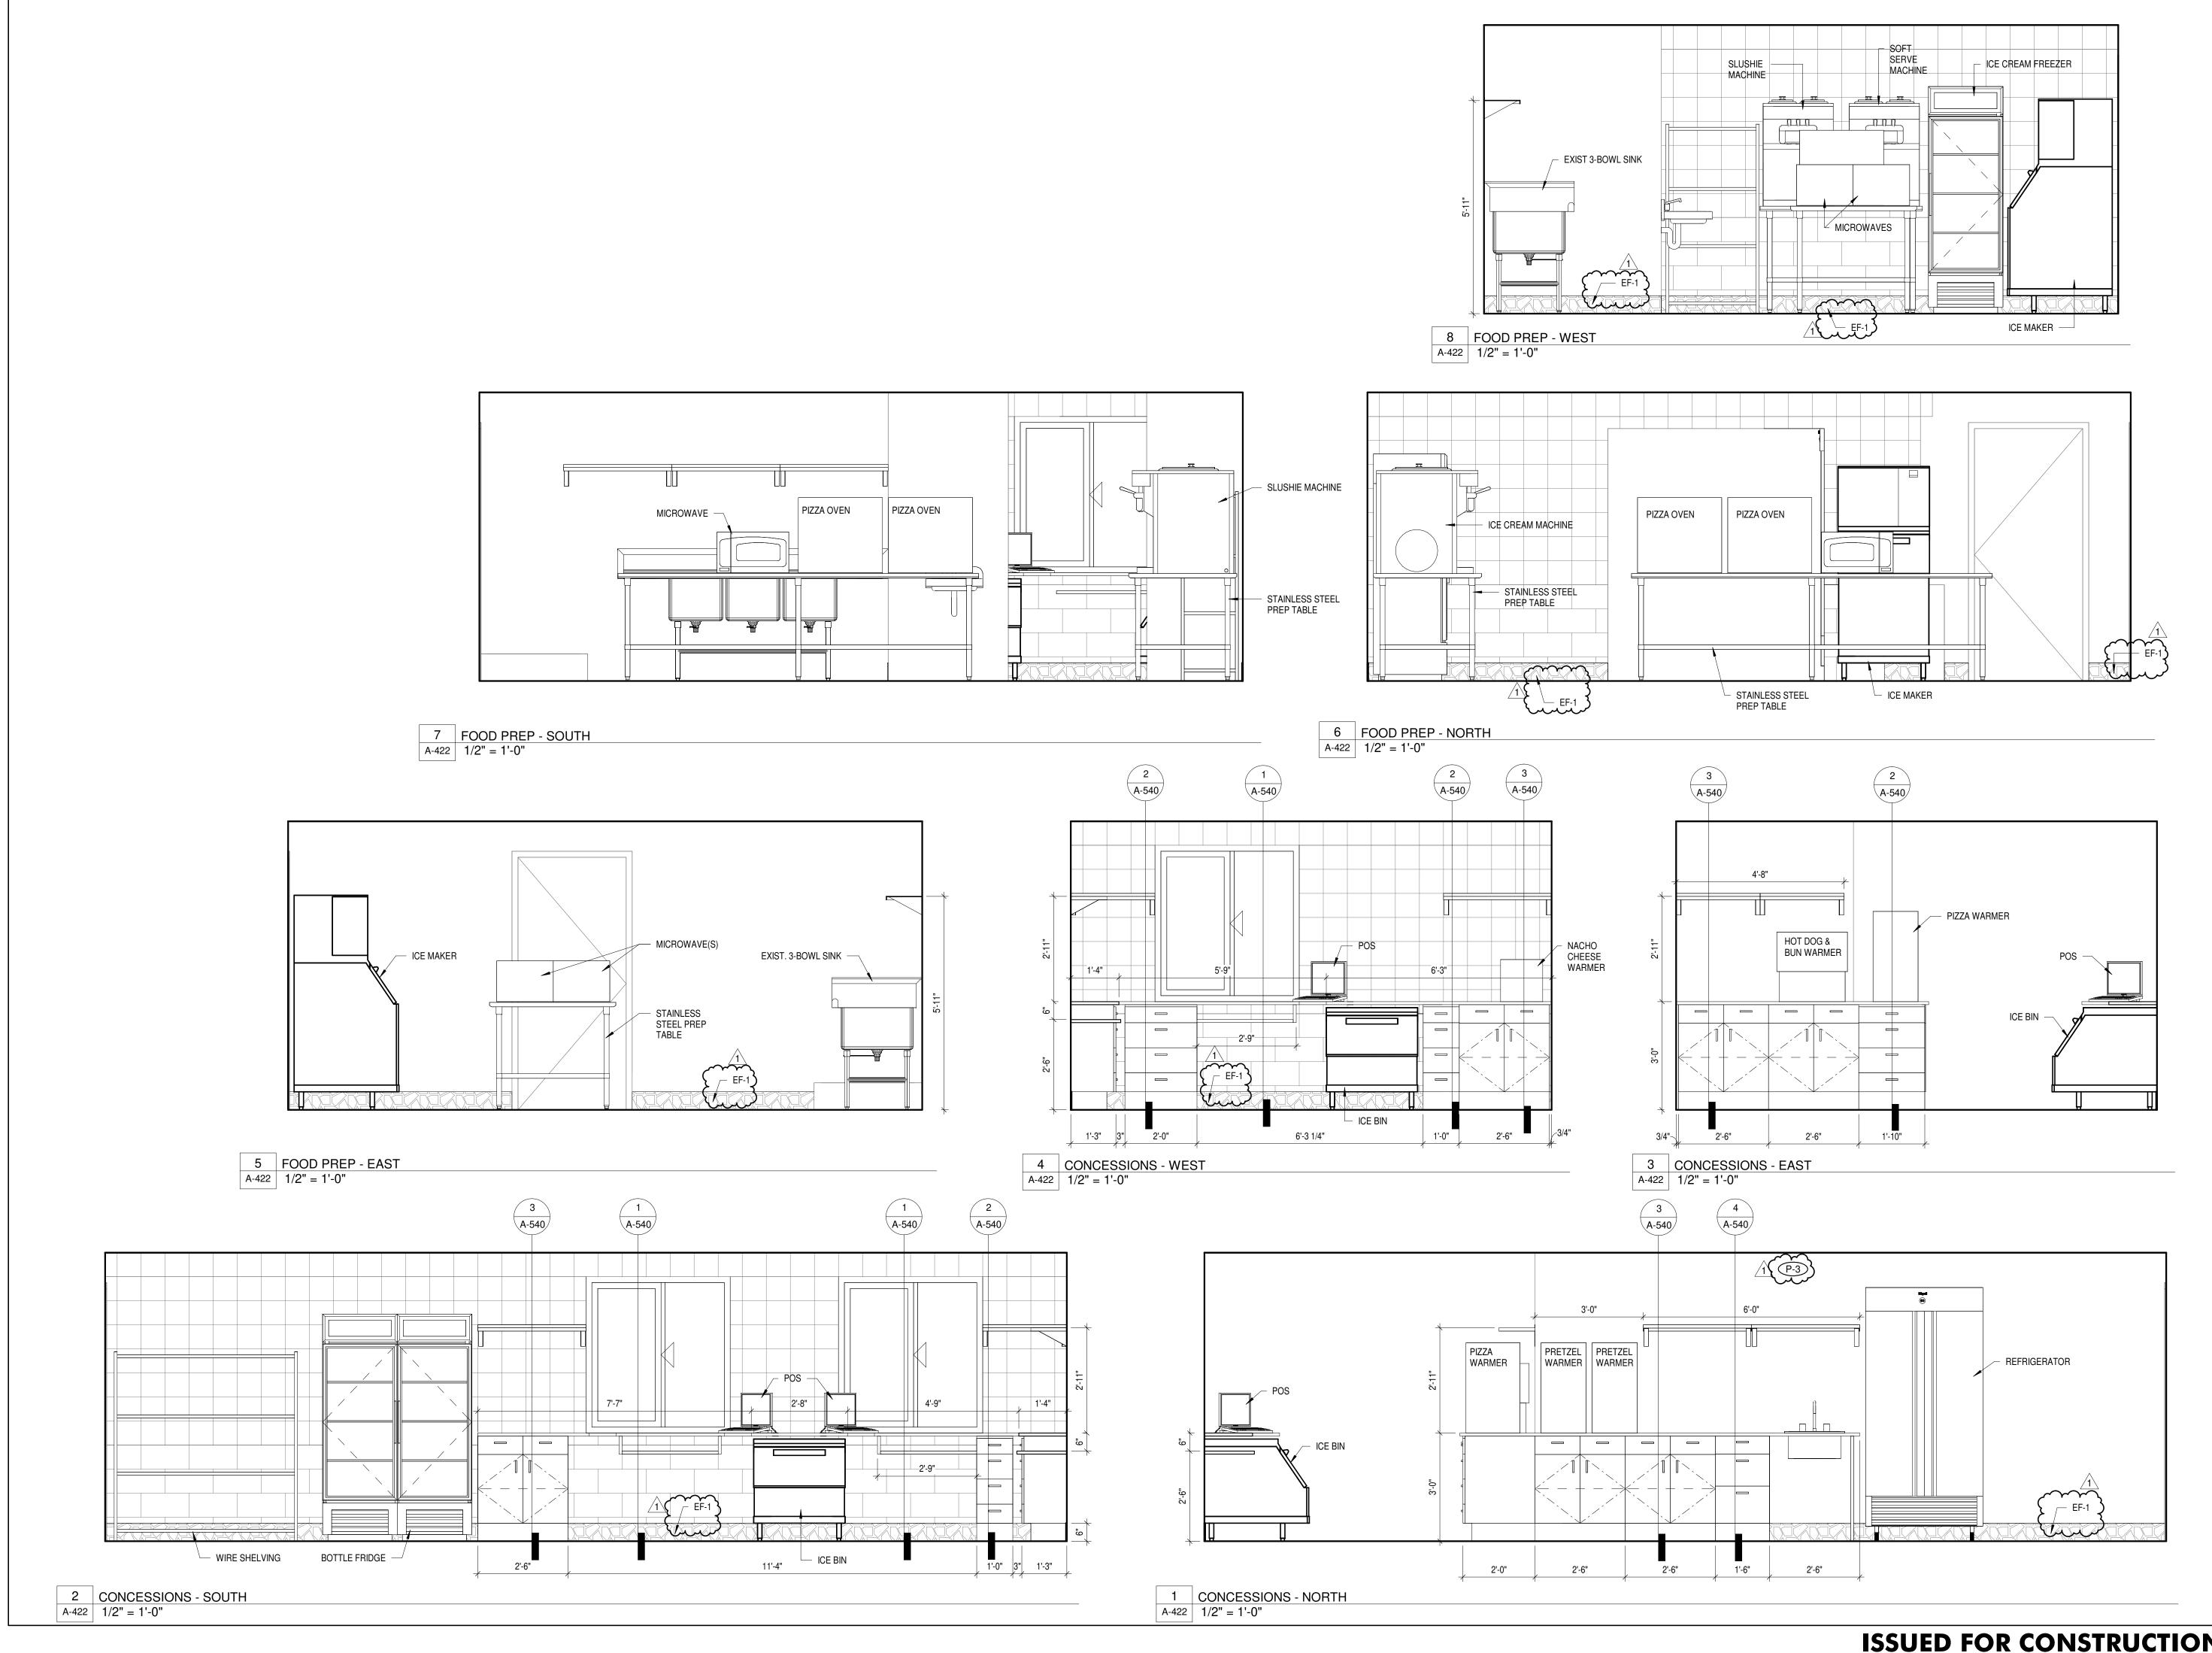


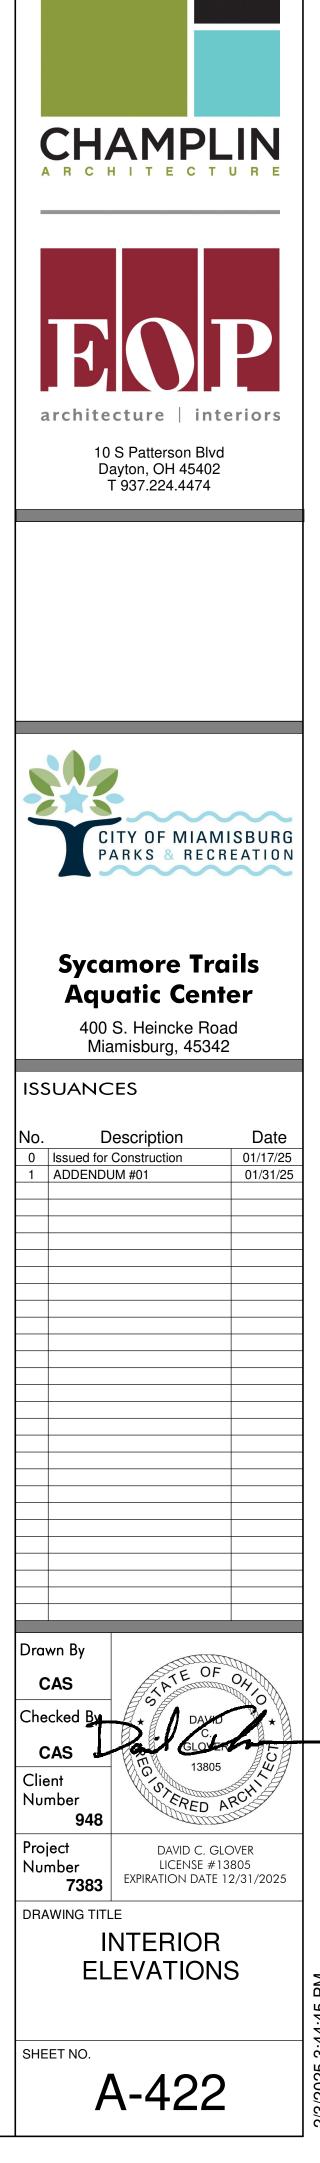


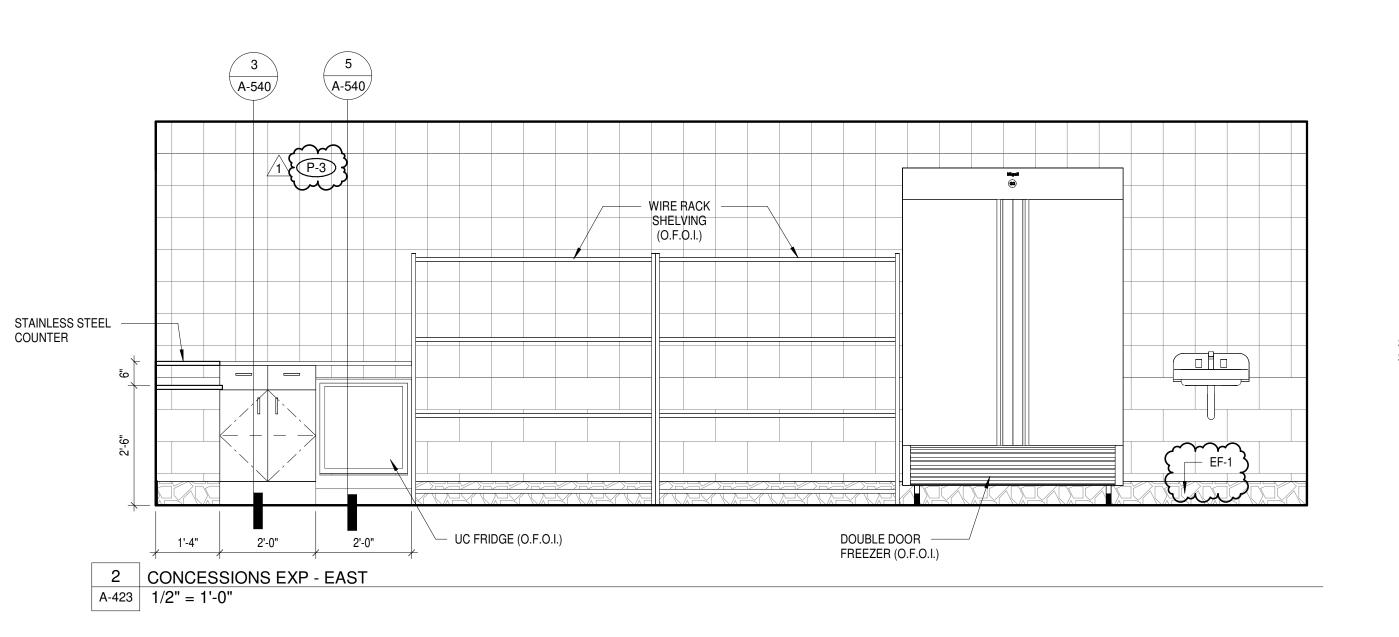



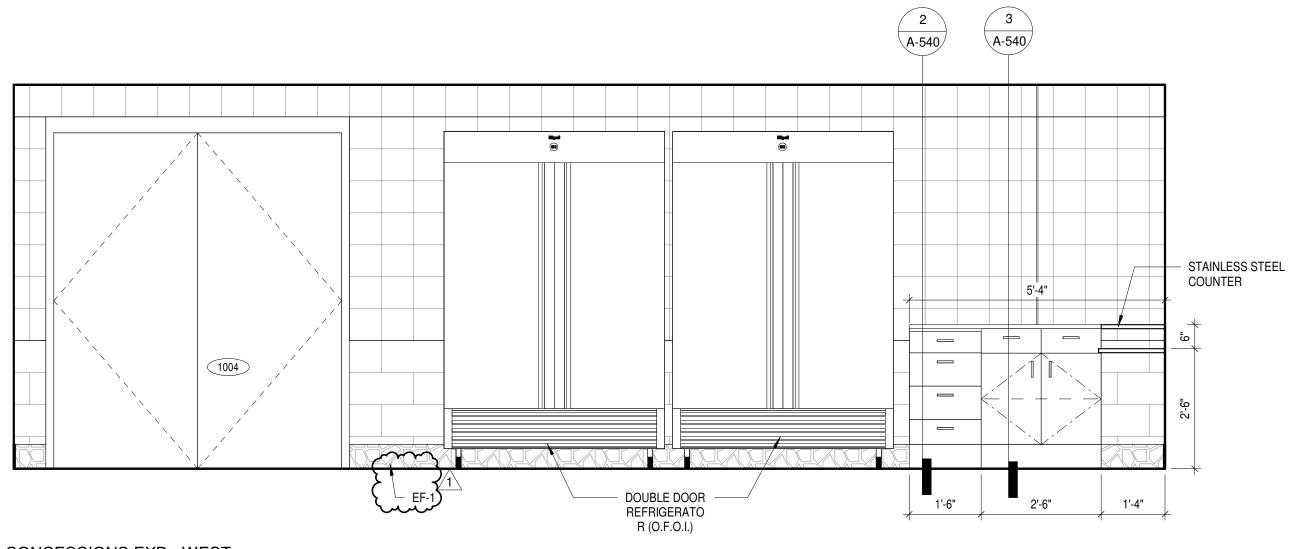


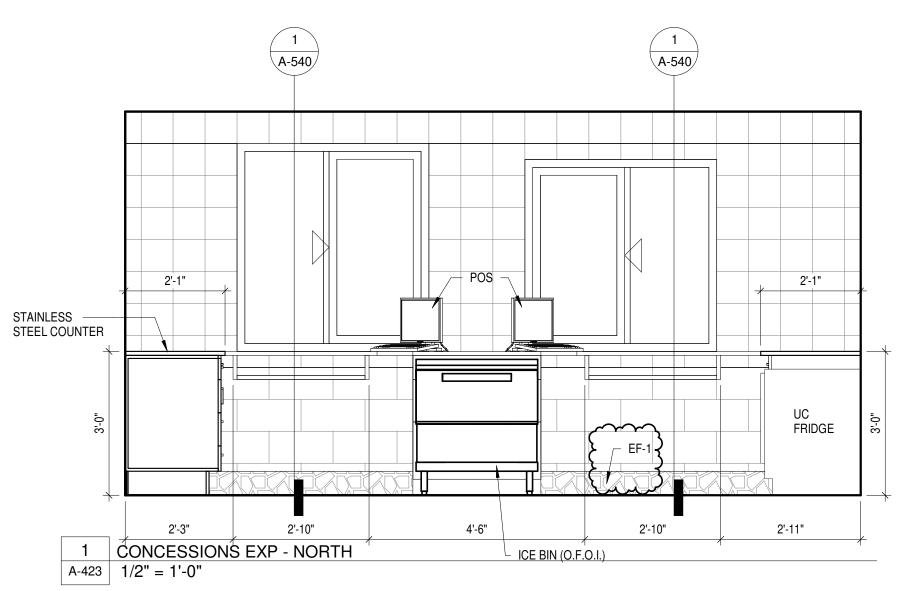

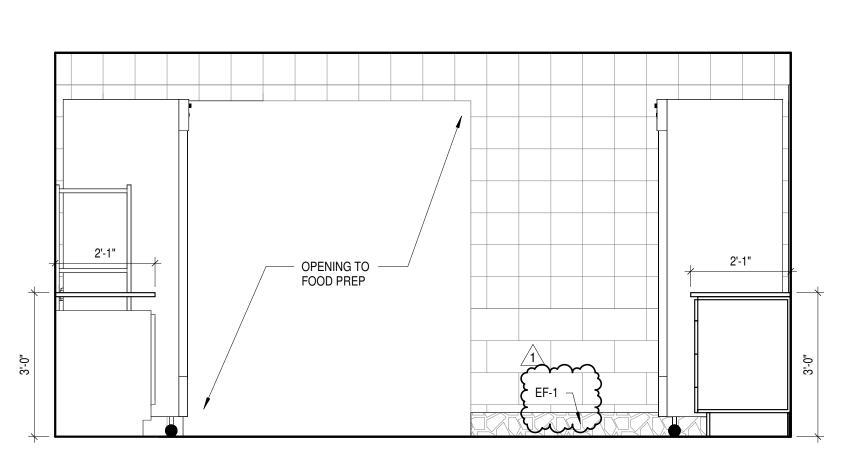


 5
 STAFF LOUNGE CASEWORK


 A-423
 1/2" = 1'-0"

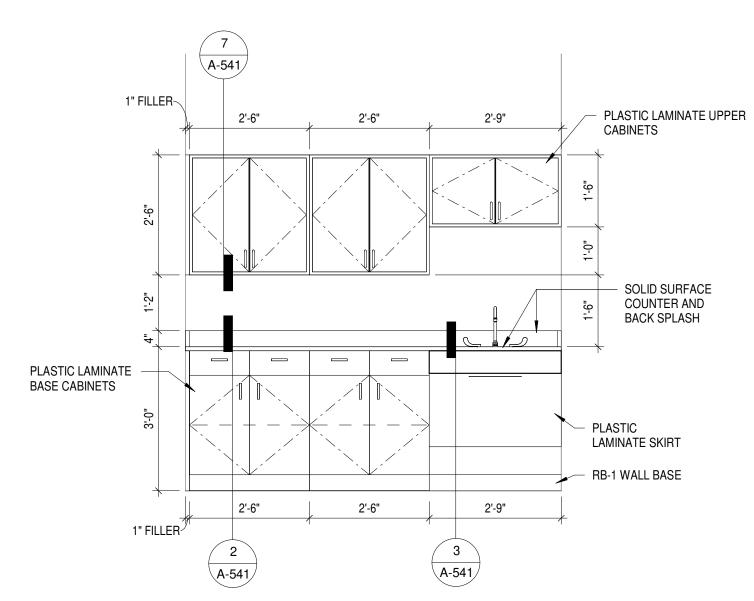




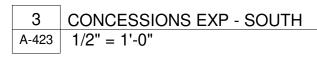



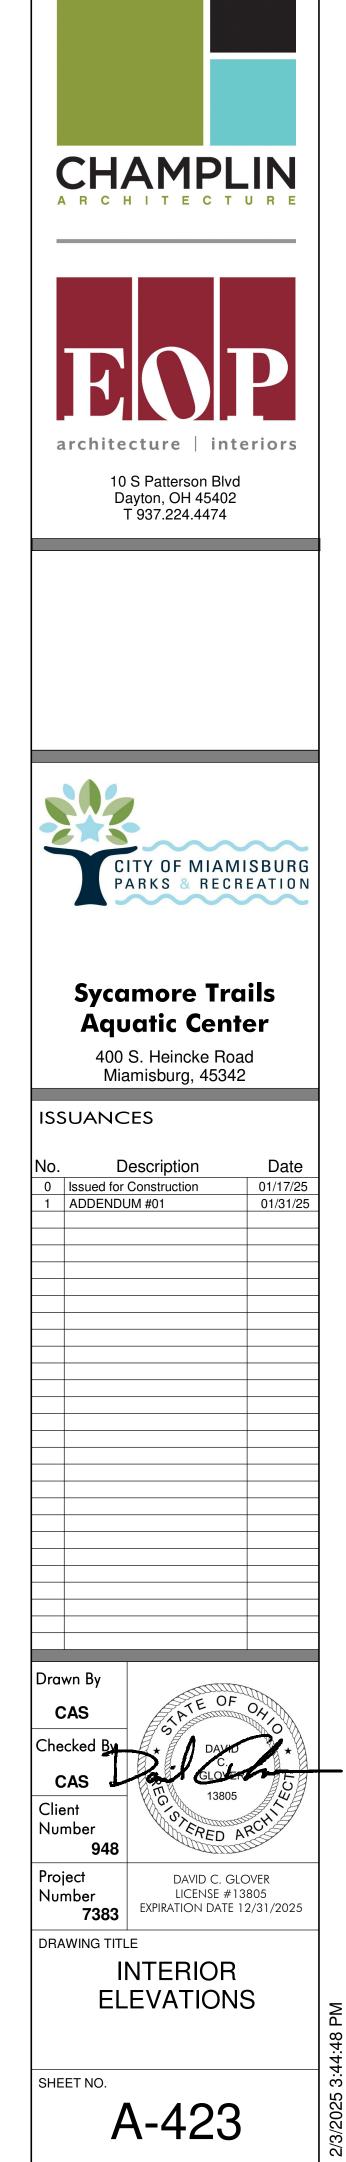


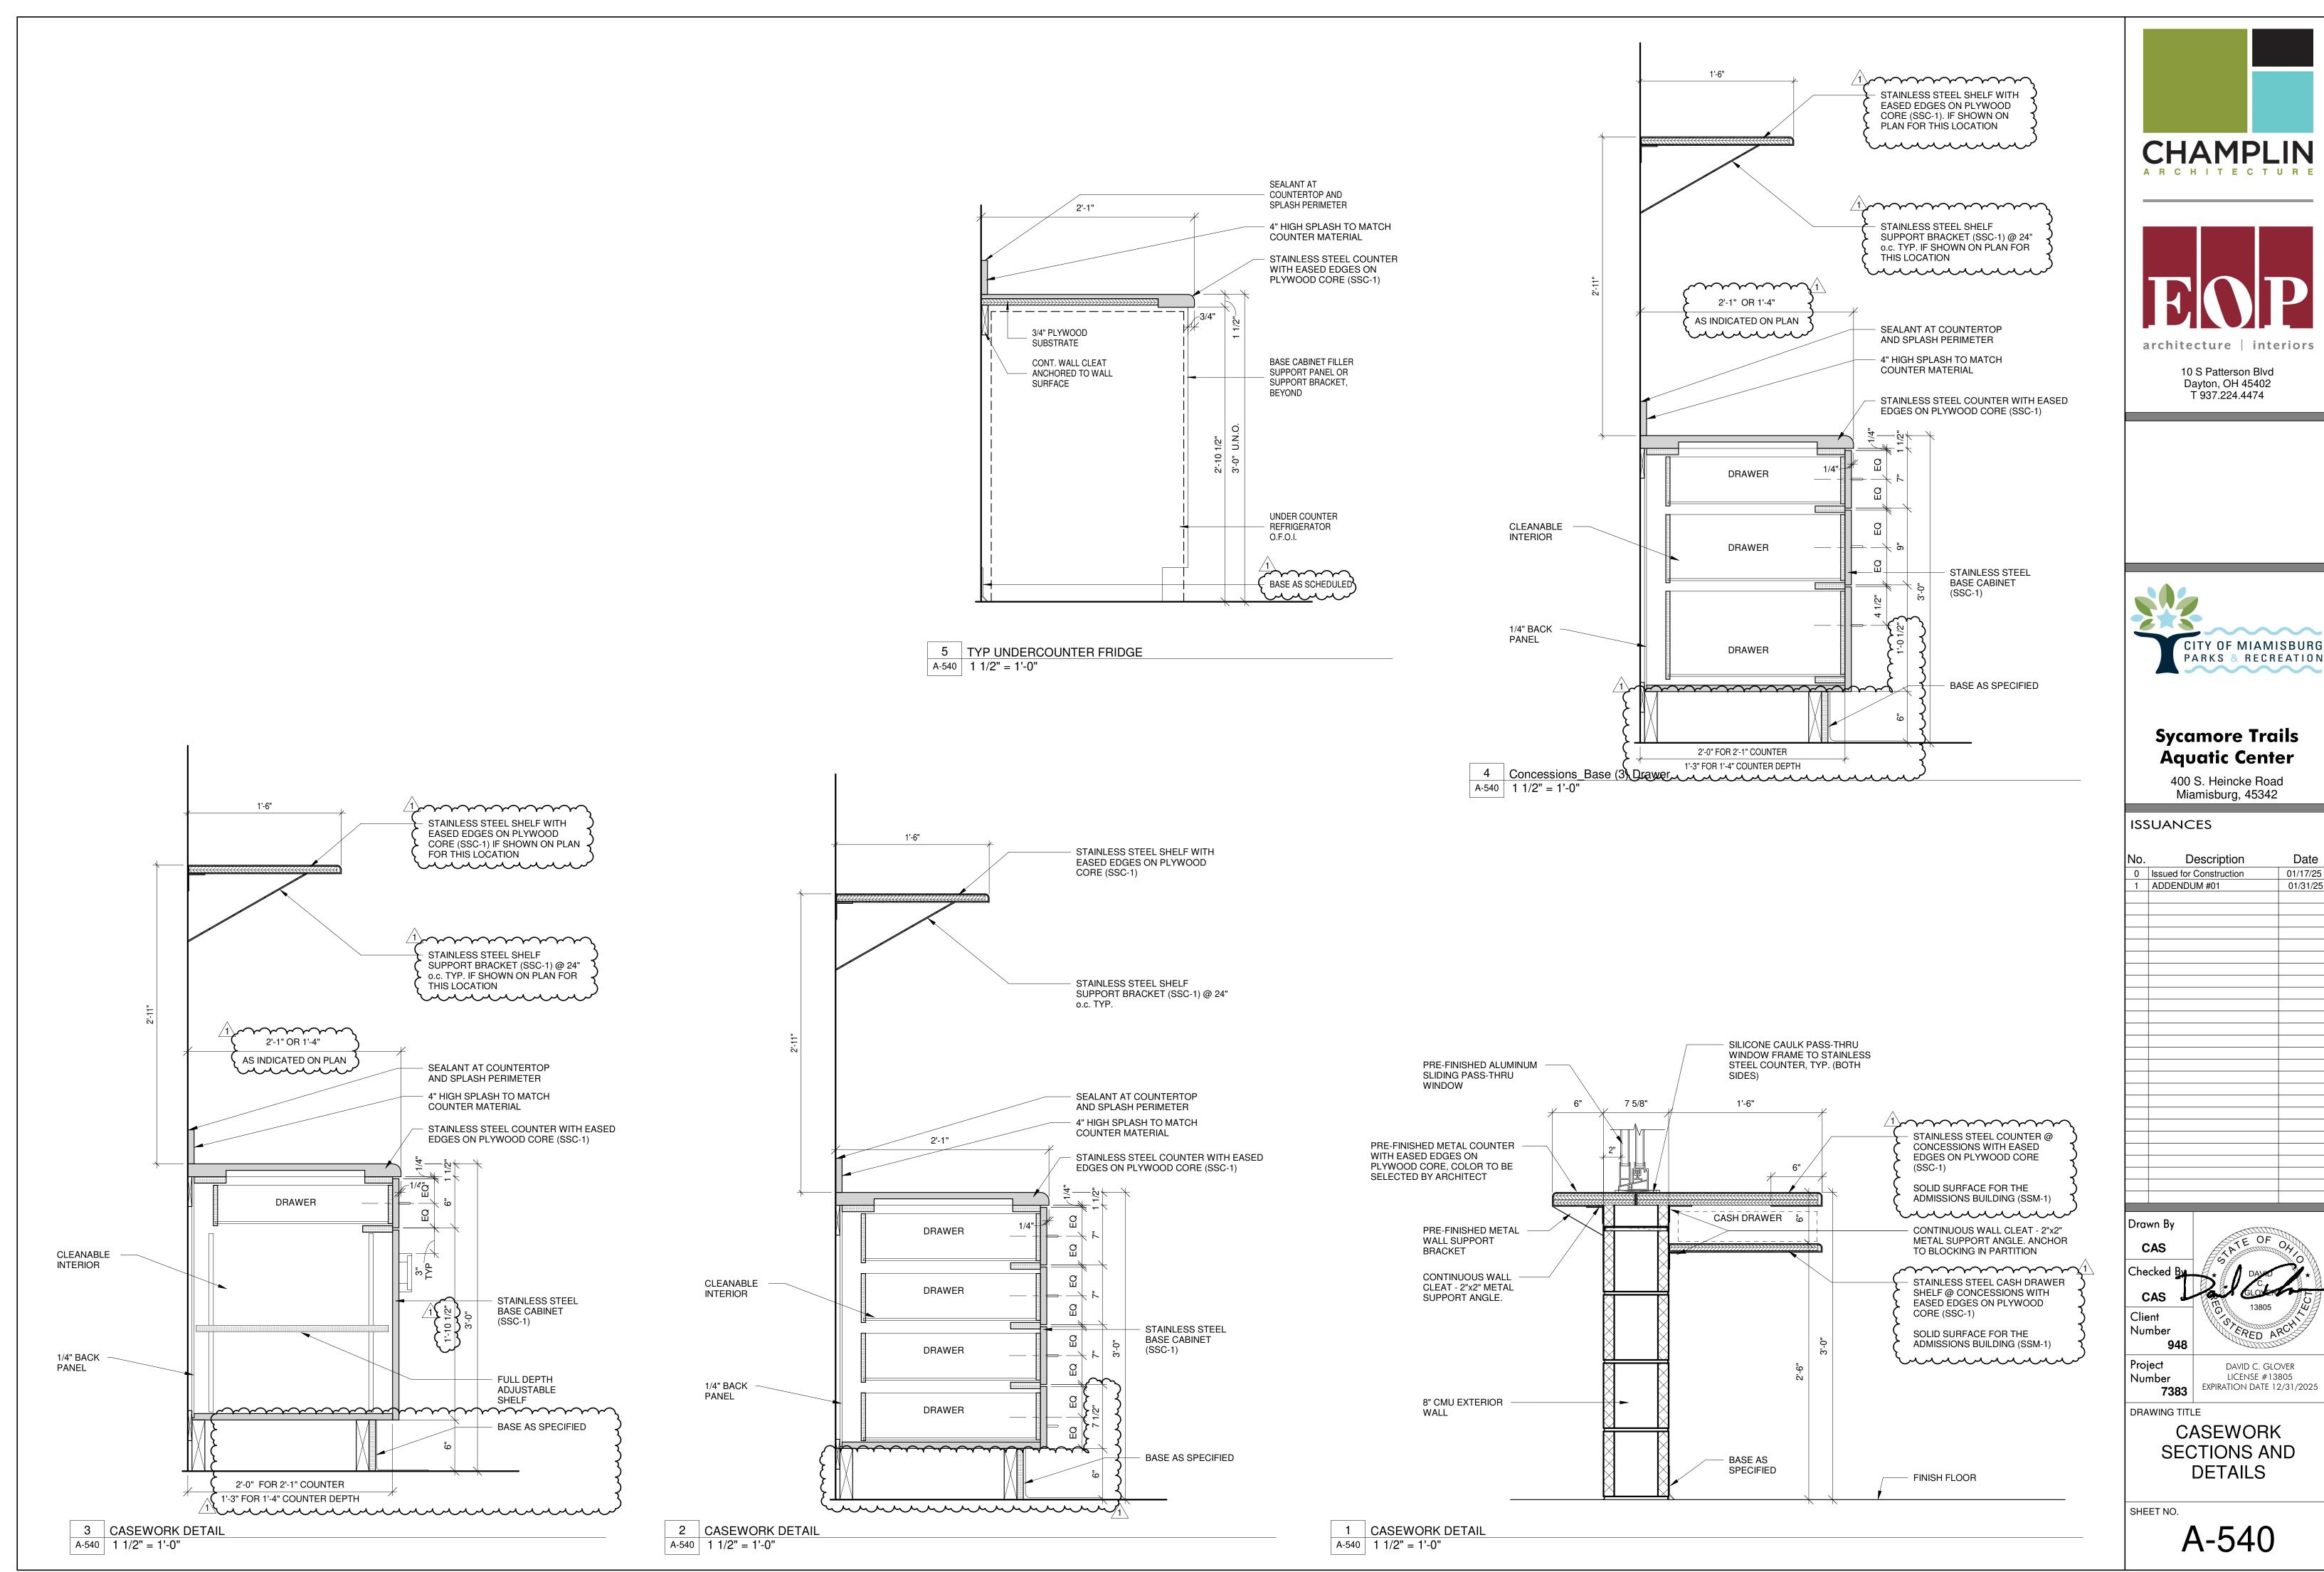


Date


01/17/25

01/31/25

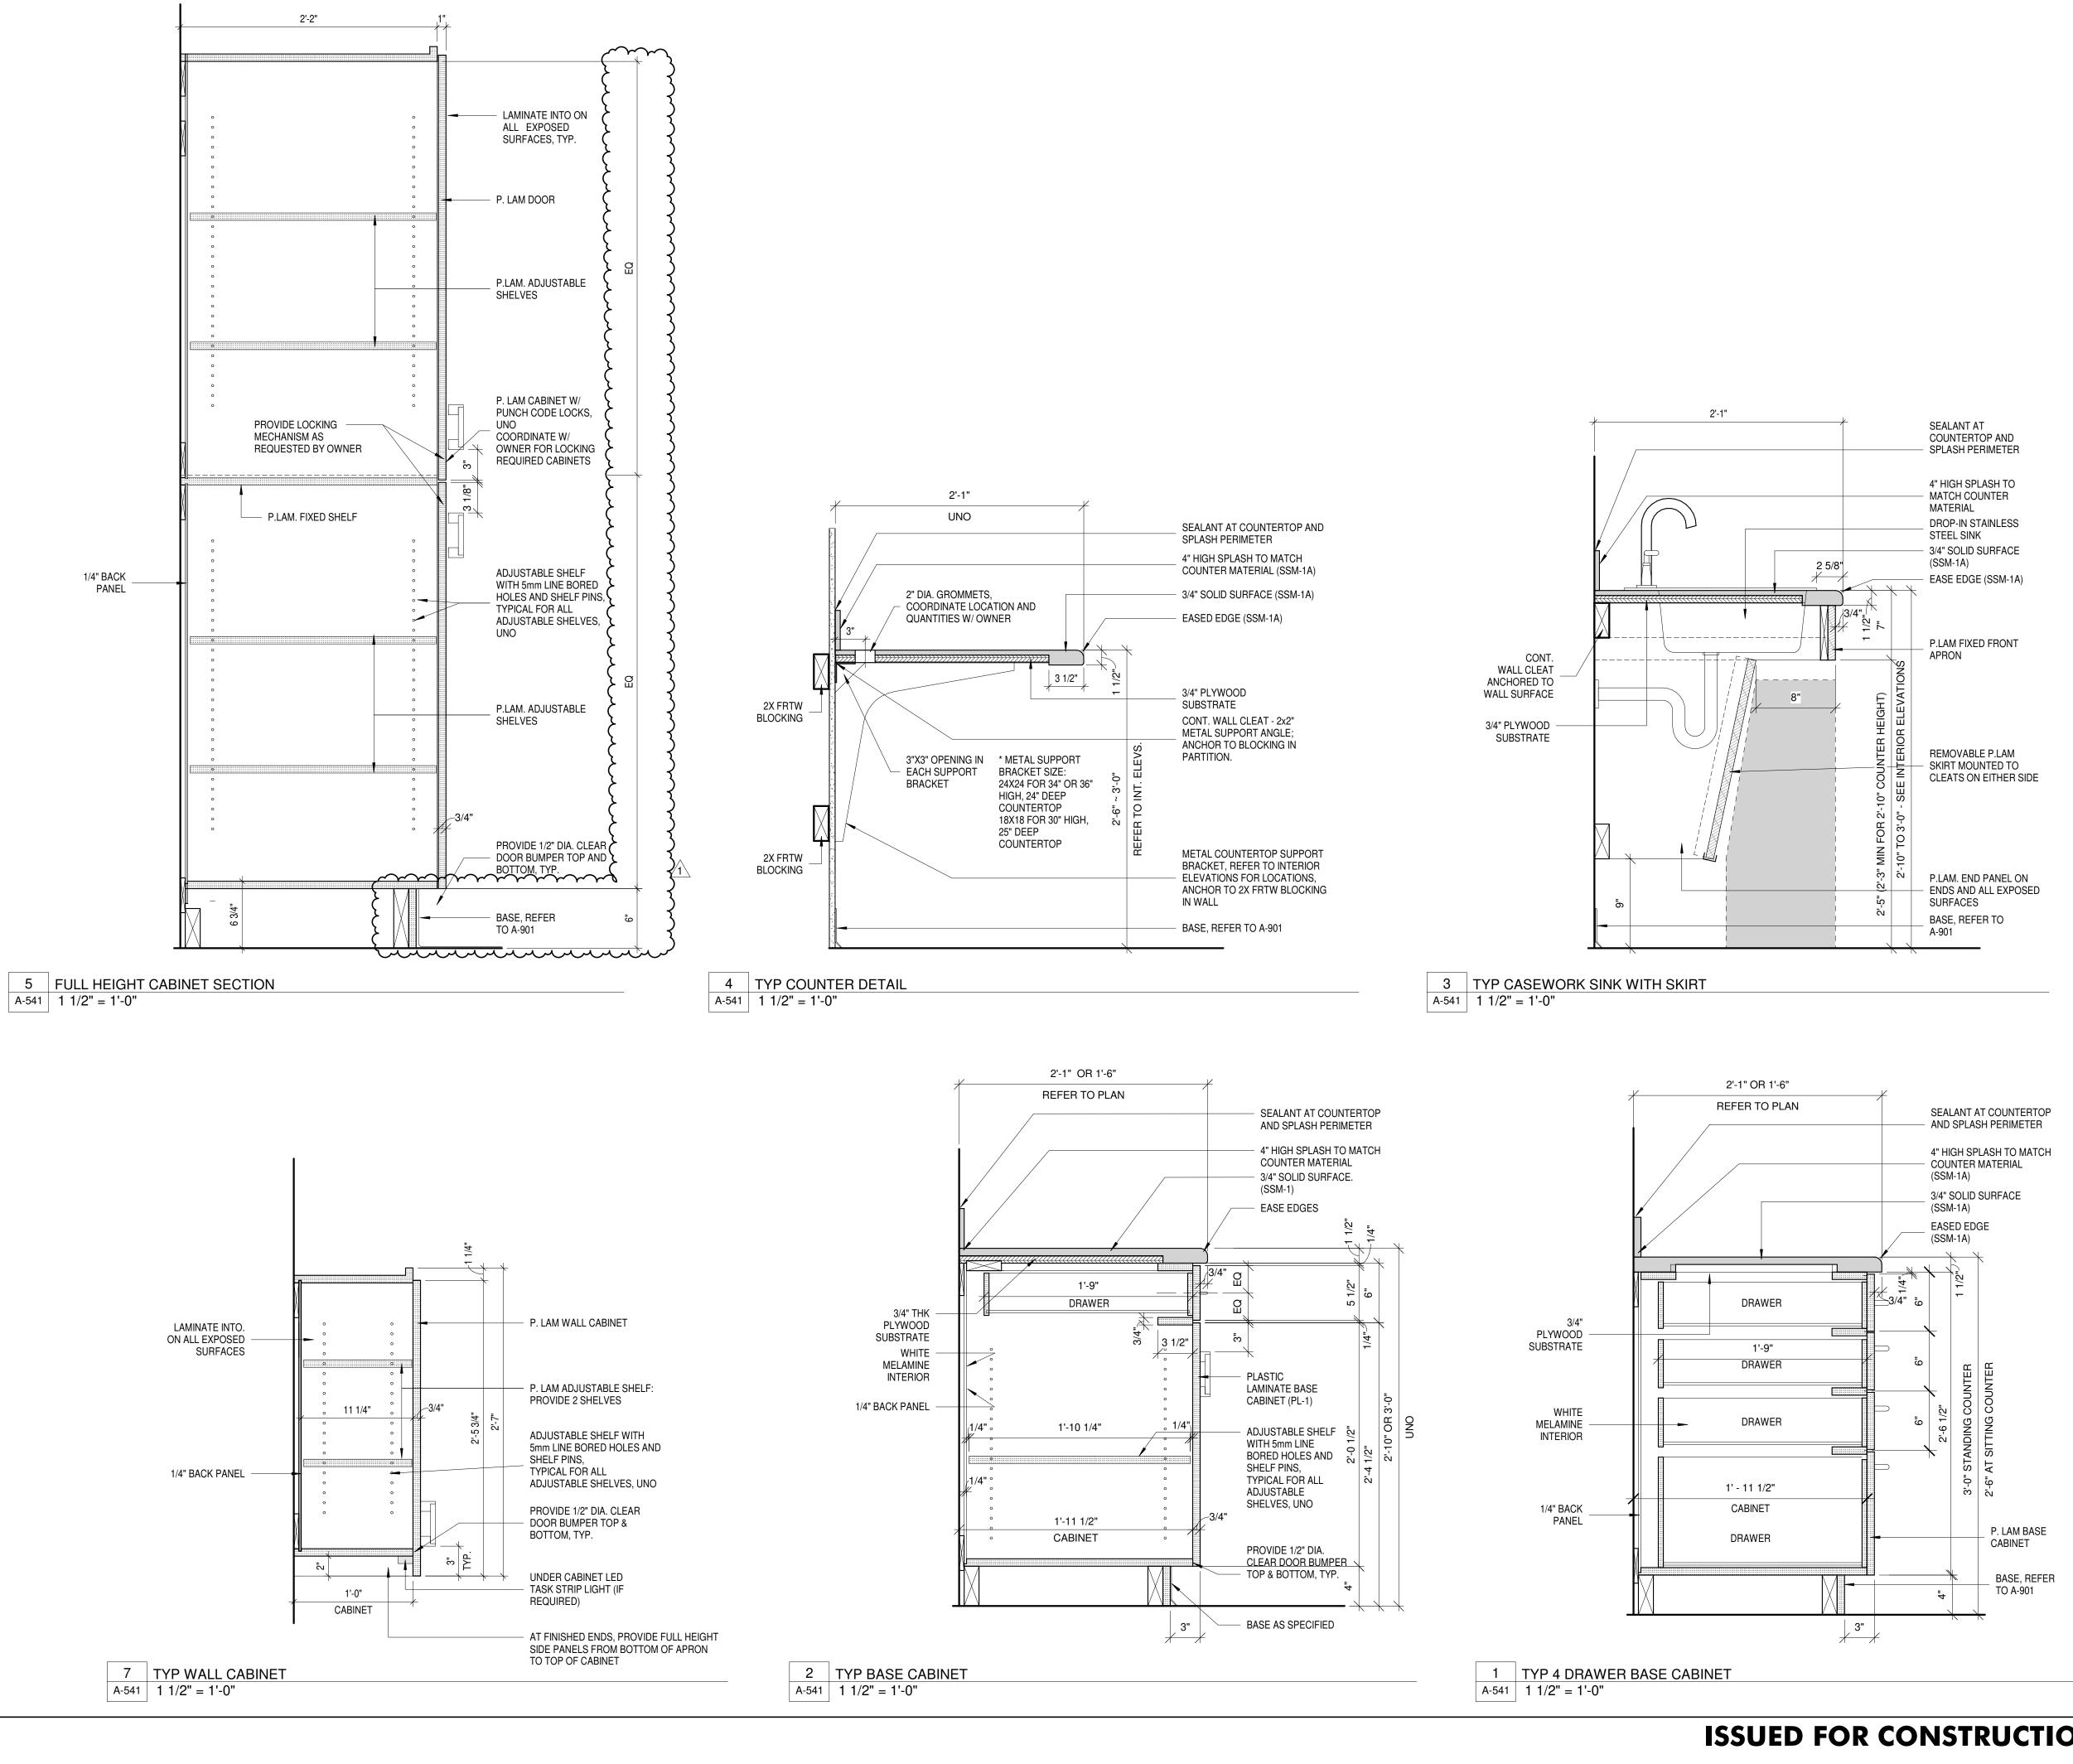



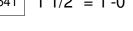

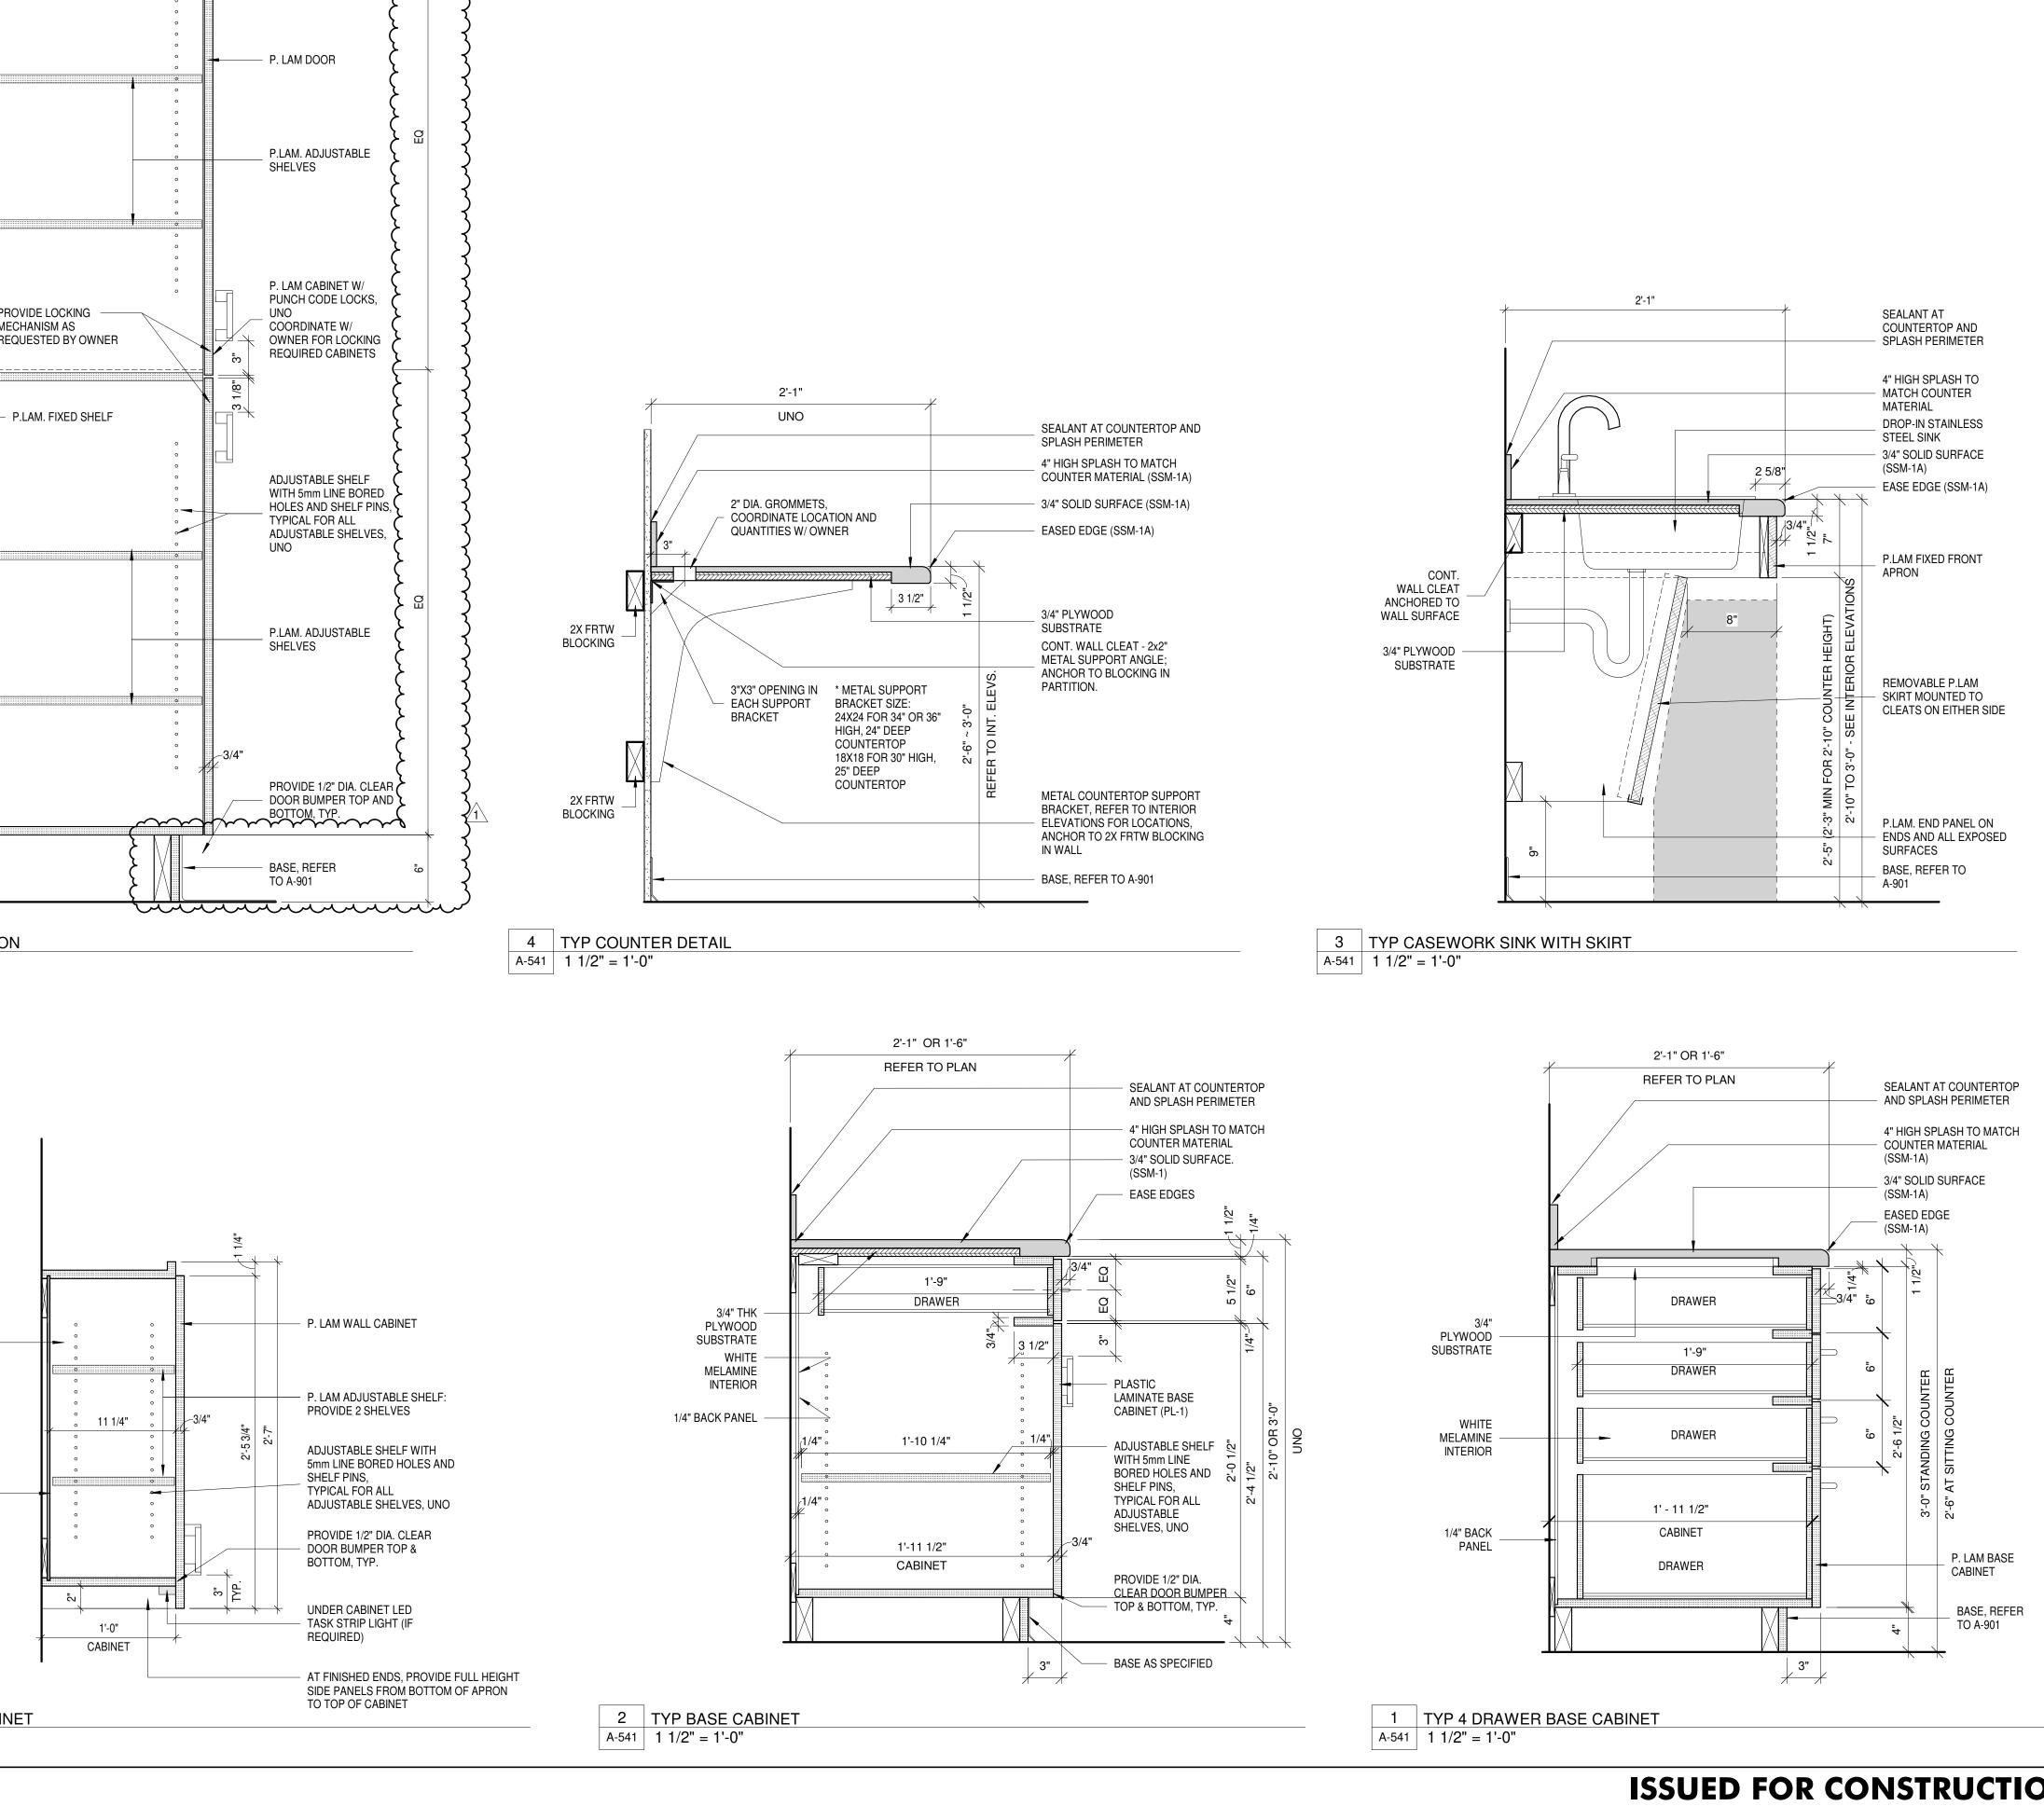





Drawn By

CAS

Checked B

CAS

948

7383

DRAWING TITLE

SHEET NO.

Client

Number

Project

Number

OF

13805

DAVID C. GLOVER LICENSE #13805

EXPIRATION DATE 12/31/2025

CASEWORK


SECTIONS AND

DETAILS

A-541

ERED

CHAMPLIN

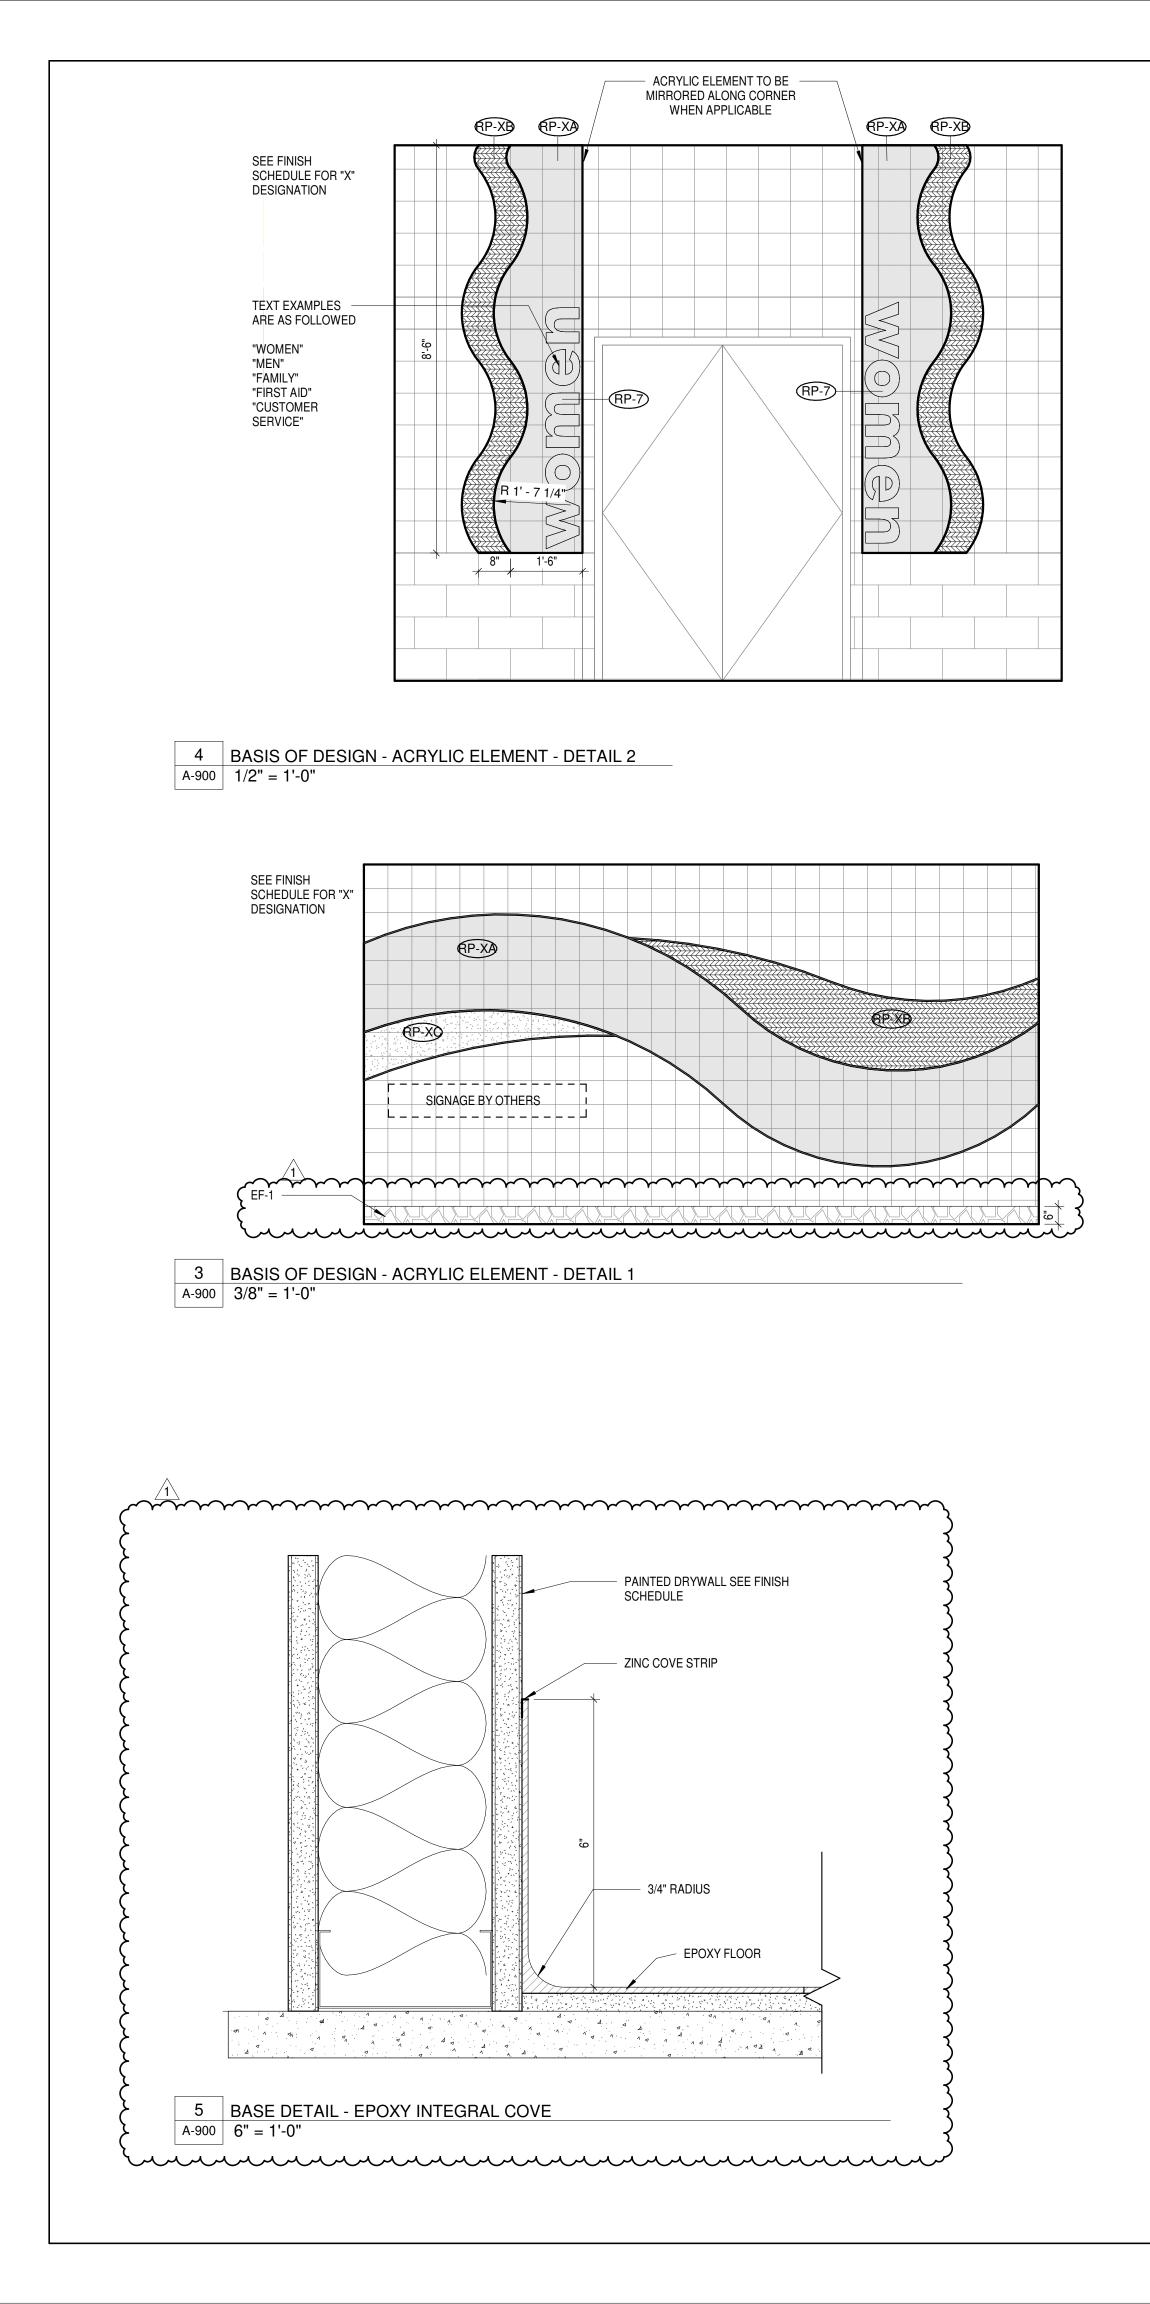

FLOO	R FINISHE	S		CASE	WORK
KEY	MATERIAL		SALES REP. & TESTING DATA	KEY	MATERIAL
EF-1 (TYPICAL)	EPOXY FLOOR	STONEHARD STONTEC TRF STONPROOF ME7 MEMBRANE SYSTEM COLOR: TEAL RIDGE FLAKE: LARGE FLAKE FINISH: TEXTURE 2 - FOR SLIP RESISTAN INSTALLATION: SEAMLESS 6" INTEGRAL COVE BASE TO MATCH ADJACENT EPOXY FLOORING	REP.: ADAM DEATON 419-806-5119 ICE	SS-1 SSM-1	STAINLESS STEEL
SV-1 (STAFF)	SHEET VINYL	MATCH ADSACENT EFOXT FEODRING MANNINGTON COMMERCIAL REALITIES III ENGLISH WALNUT COLOR: NUT BROWN 5688R SIZE: 9' ROLL THICKNESS: 2mm WELD ROD: 842478 HERBIVORE	REP.:ROBIN STEVENS 937-478-1046	(PL-1	PLASTIC LAMINATE
BASE					
RB-1	RUBBER COVE BASE	TARKETT (JOHNSONITE) 1 STYLE: D6 COLOR: 283 TOAST SIZE: 4			
				SPEC	ALTY
				RP-1A (AQUA)	RESIN PANEL
WALL	S			RP-1B (AQUA)	RESIN PANEL
P-1 (WHITE)	PAINT	SHERWIN WILLIAMS SW7009 PEARLY WHITE		RP-1C (AQUA)	RESIN PANEL
P-2 (AQUA)	PAINT	SHERWIN WILLIAMS SW 9048 SURFIN'		RP-2A (TEAL)	RESIN PANEL
P-3 (TEAL)	PAINT	SHERWIN WILLIAMS SW 6767 AQUARIUM			
P-4 (YELLOW)	PAINT	SHERWIN WILLIAMS SW 6904 GUSTO GOLD		RP-2B (TEAL)	RESIN PANEL
P-5 (ROYAL BLUE)	PAINT	SHERWIN WILLIAMS SW 6966 BLUEBLOOD		RP-2C (TEAL)	RESIN PANEL
P-6 (DARK TEAL)	PAINT	SHERWIN WILLIAMS SW 6776 BLUE NILE		RP-3A	RESIN PANEL
				(YELLOW)	
	SH TYPICA	L NOTES		RP-3B (YELLOW)	RESIN PANEL
B. ALL FINIS A001. C. REFER TC	DELEVATIONS FOR WALL FINISH	T WITH CODE INFORMATION LISTED ON HES, CASEWORK AND SURFACE DETAILS.		RP-4 (ROYAL BLUE)	RESIN PANEL
E. REFER TO F. SUBMIT A G. ALL ACCE COLOR.	D FINISH PLANS FOR ADDITIONA LL SAMPLES FOR ARCHITECTS SS PANEL DOORS, GRILLES, ET	OR ADDITIONAL CEILING INFORMATION. AL WALL AND FLOORING INFORMATION. APPROVAL. TC. ARE TO BE PAINTED TO MATCH WALL IR TO INSTALLATION OF CASEWORK AND		RP-5 (DARK TEAL)	RESIN PANEL
H. ALL FLOO MILLWOR				RP-6 (RED)	RESIN PANEL
				RP-7 (LETTERING TYPICAL)	RESIN PANEL

				ROOM FI	NISH SCHEDU	JLE - STAC				
				WALL FINISH	WALL FINISH	WALL FINISH	WALL FINIS	H	CSWK	
Name	Number	Floor Finish	Base Finish	NORTH	EAST	SOUTH	WEST	CSWK VERT.	HORIZ.	Comments
EXIST. WOMEN'S CHANGING ROOM	1002	EF-1	EF-1	P-1	P-1	P-1	P-1	-	-	ACRYLIC TO BE RP-2A, RP-2B, AND RP-20
EXIST. UTILITY	1003	-	-	-	-	-	-	-	-	
EXIST. TRASH	1008	-	-	-	-	-	-	-	-	
EXIST. FAMILY RR.	1011	EF-1	EF-1	P-1	P-1	P-1	P-4	-	-	ACRYLIC TO BE RP-3
EXIST IDF	1009	-	-	-	-	-	-	-	-	
CONCESSIONS EXPANSION	1004	EF-1	EF-1	P-1	P-1	P-1	P-1	-	-	
CONCESSIONS FOOD PREP	1005	EF-1	EF-1	P-1	P-1	P-1	P-1	-	-	
CONCESSIONS	1006	EF-1	EF-1	P-1	P-1	P-1	P-1	-	-	
STORAGE	1007	EF-1	EF-1	P-1	P-1	P-1	P-1	-	-	
STORAGE	1010	-		-	-	- ^	~~ <u>`</u>	-	-	
ADMISSIONS	1001	EF-1 1	RB-1	P-1	P-1	P-3 /1	P-1 }	-	SSM-1	
EXIST. MEN'S CHANGING ROOM	1020	EF-1	EF-1	P-1	P-1	P-1	mp.	-	-	ACRYLIC TO BE RP-1A, RP-1B, AND RP-10
EXIST. UTILITY	1021	-	-	-	-	-	-	-	-	
PARK STORAGE	1022	-	-	-	-	-	-	-	-	
SWIM TEAM STORAGE	1023	-	-	-	-	-	-	-	-	
EXIST. STAF	1024	-	-	-	-	-	-	-	-	
STORAGE	1025	-	-	-	-	-	-	-	-	
EXIST. STAFF LOUNGE	1026	SV-1	RB-1	P-1	P-3 🏠 🖌	~~P-1~~~	$\frac{p-1}{2}$	-	-	
ADMIN OFFICES	1027	SV-1	RB-1	P-1	P-1/1	P-1	Ď. P-1 }	PL-1	SSM-1	
STAFF TRAINING & REST AREA	1028	SV-1	RB-1	P-1	P-3	mp	Mp.pr	-	-	
ID CLOS.	1030	-	-	-	-	-	-	-	-	
MEMBER SERVICES & FIRST AID	1029	EF-1	EF-1	P-1	P-1	P-1	P-1	-	-	
EXIST. STO.	1031	-	-	-	-	-	-	-	-	
EXIST. ELEC.	1032	-	-	-	-	-	-	-	-	
STORAGE	1033	-	-	-	-	-	-	-	-	
EXIST FAMILY	1034	EF-1	EF-1	P-1	P-4	P-1	P-1	-	-	ACRYLIC TO BE RP-3
EXIST. RR	1012	EF-1	EF-1	P-1	P-1	P-1	P-1	-	-	


WORK

SEE SPECIFICATIONS

SALES REP. & TESTING DATA

	$\sim\sim\sim\sim\sim$	
SOLID SURFACE	WILSONART COLOR: MYSTIQUE THICKNESS: 1/2"	
PLASTIC LAMINATE	FORMICA CAMEL ELM 5795-NG.	
········		


TY		
RESIN PANEL	3FORM CHROMA COLOR: CORNFLOWER B46 THICKNESS:	REP.:SUSAN STUDER 859-653-4069
RESIN PANEL	3FORM CHROMA COLOR: SKYDIVE B48 THICKNESS:	REP.:SUSAN STUDER 859-653-4069
RESIN PANEL	3FORM CHROMA COLOR:CLOUDLESS B42 THICKNESS:	REP.:SUSAN STUDER 859-653-4069
RESIN PANEL	3FORM CHROMA COLOR: POSEIDON B22 THICKNESS:	REP.:SUSAN STUDER 859-653-4069
RESIN PANEL	3FORM CHROMA COLOR: CRUISE B21 THICKNESS:	REP.:SUSAN STUDER 859-653-4069
RESIN PANEL	3FORM CHROMA COLOR: ROBIN B39 THICKNESS:	REP.:SUSAN STUDER 859-653-4069
RESIN PANEL	3FORM CHROMA COLOR: SUNNYSIDE Y17 THICKNESS:	REP.:SUSAN STUDER 859-653-4069
RESIN PANEL	3FORM CHROMA COLOR: TAXICAB Y12 THICKNESS:	REP.:SUSAN STUDER 859-653-4069
RESIN PANEL	3FORM CHROMA COLOR: CASSIDY B26 THICKNESS:	REP.:SUSAN STUDER 859-653-4069
RESIN PANEL	3FORM CHROMA COLOR: SALTWATER B12 THICKNESS:	REP.:SUSAN STUDER 859-653-4069
RESIN PANEL	3FORM CHROMA COLOR: LOVE R18 THICKNESS:	REP.:SUSAN STUDER 859-653-4069
RESIN PANEL	3FORM CHROMA COLOR: AVALANCHE THICKNESS:	REP.:SUSAN STUDER 859-653-4069

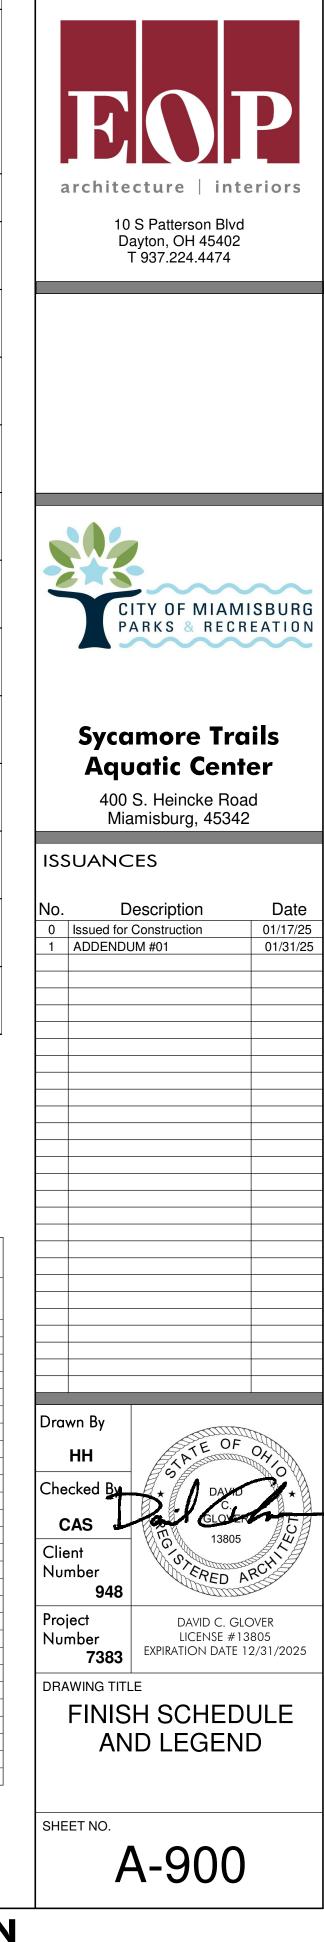


Ы

22


CHAMPLIN

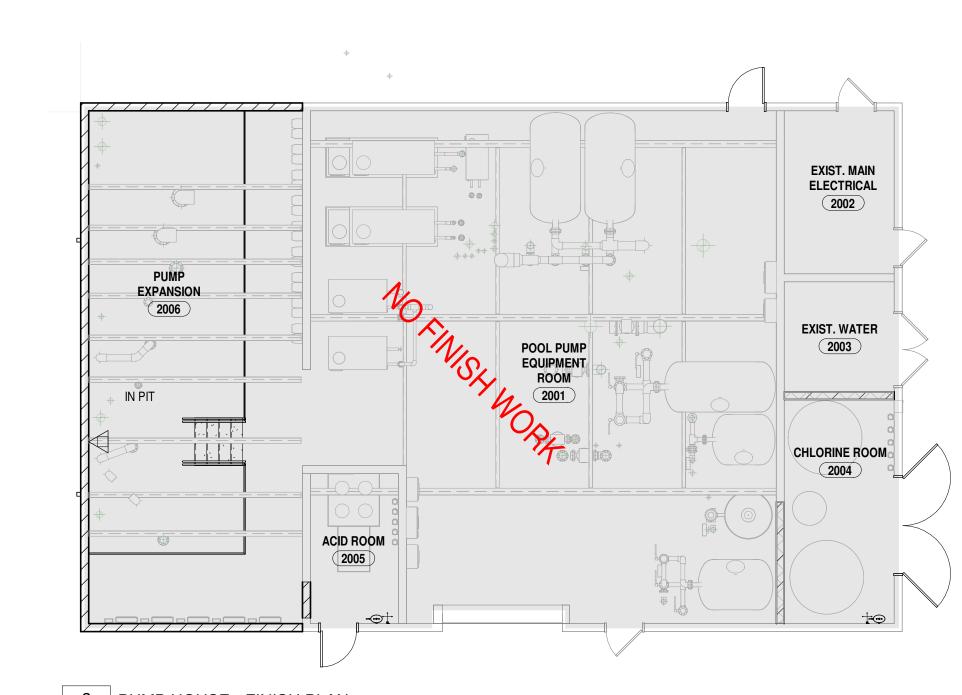



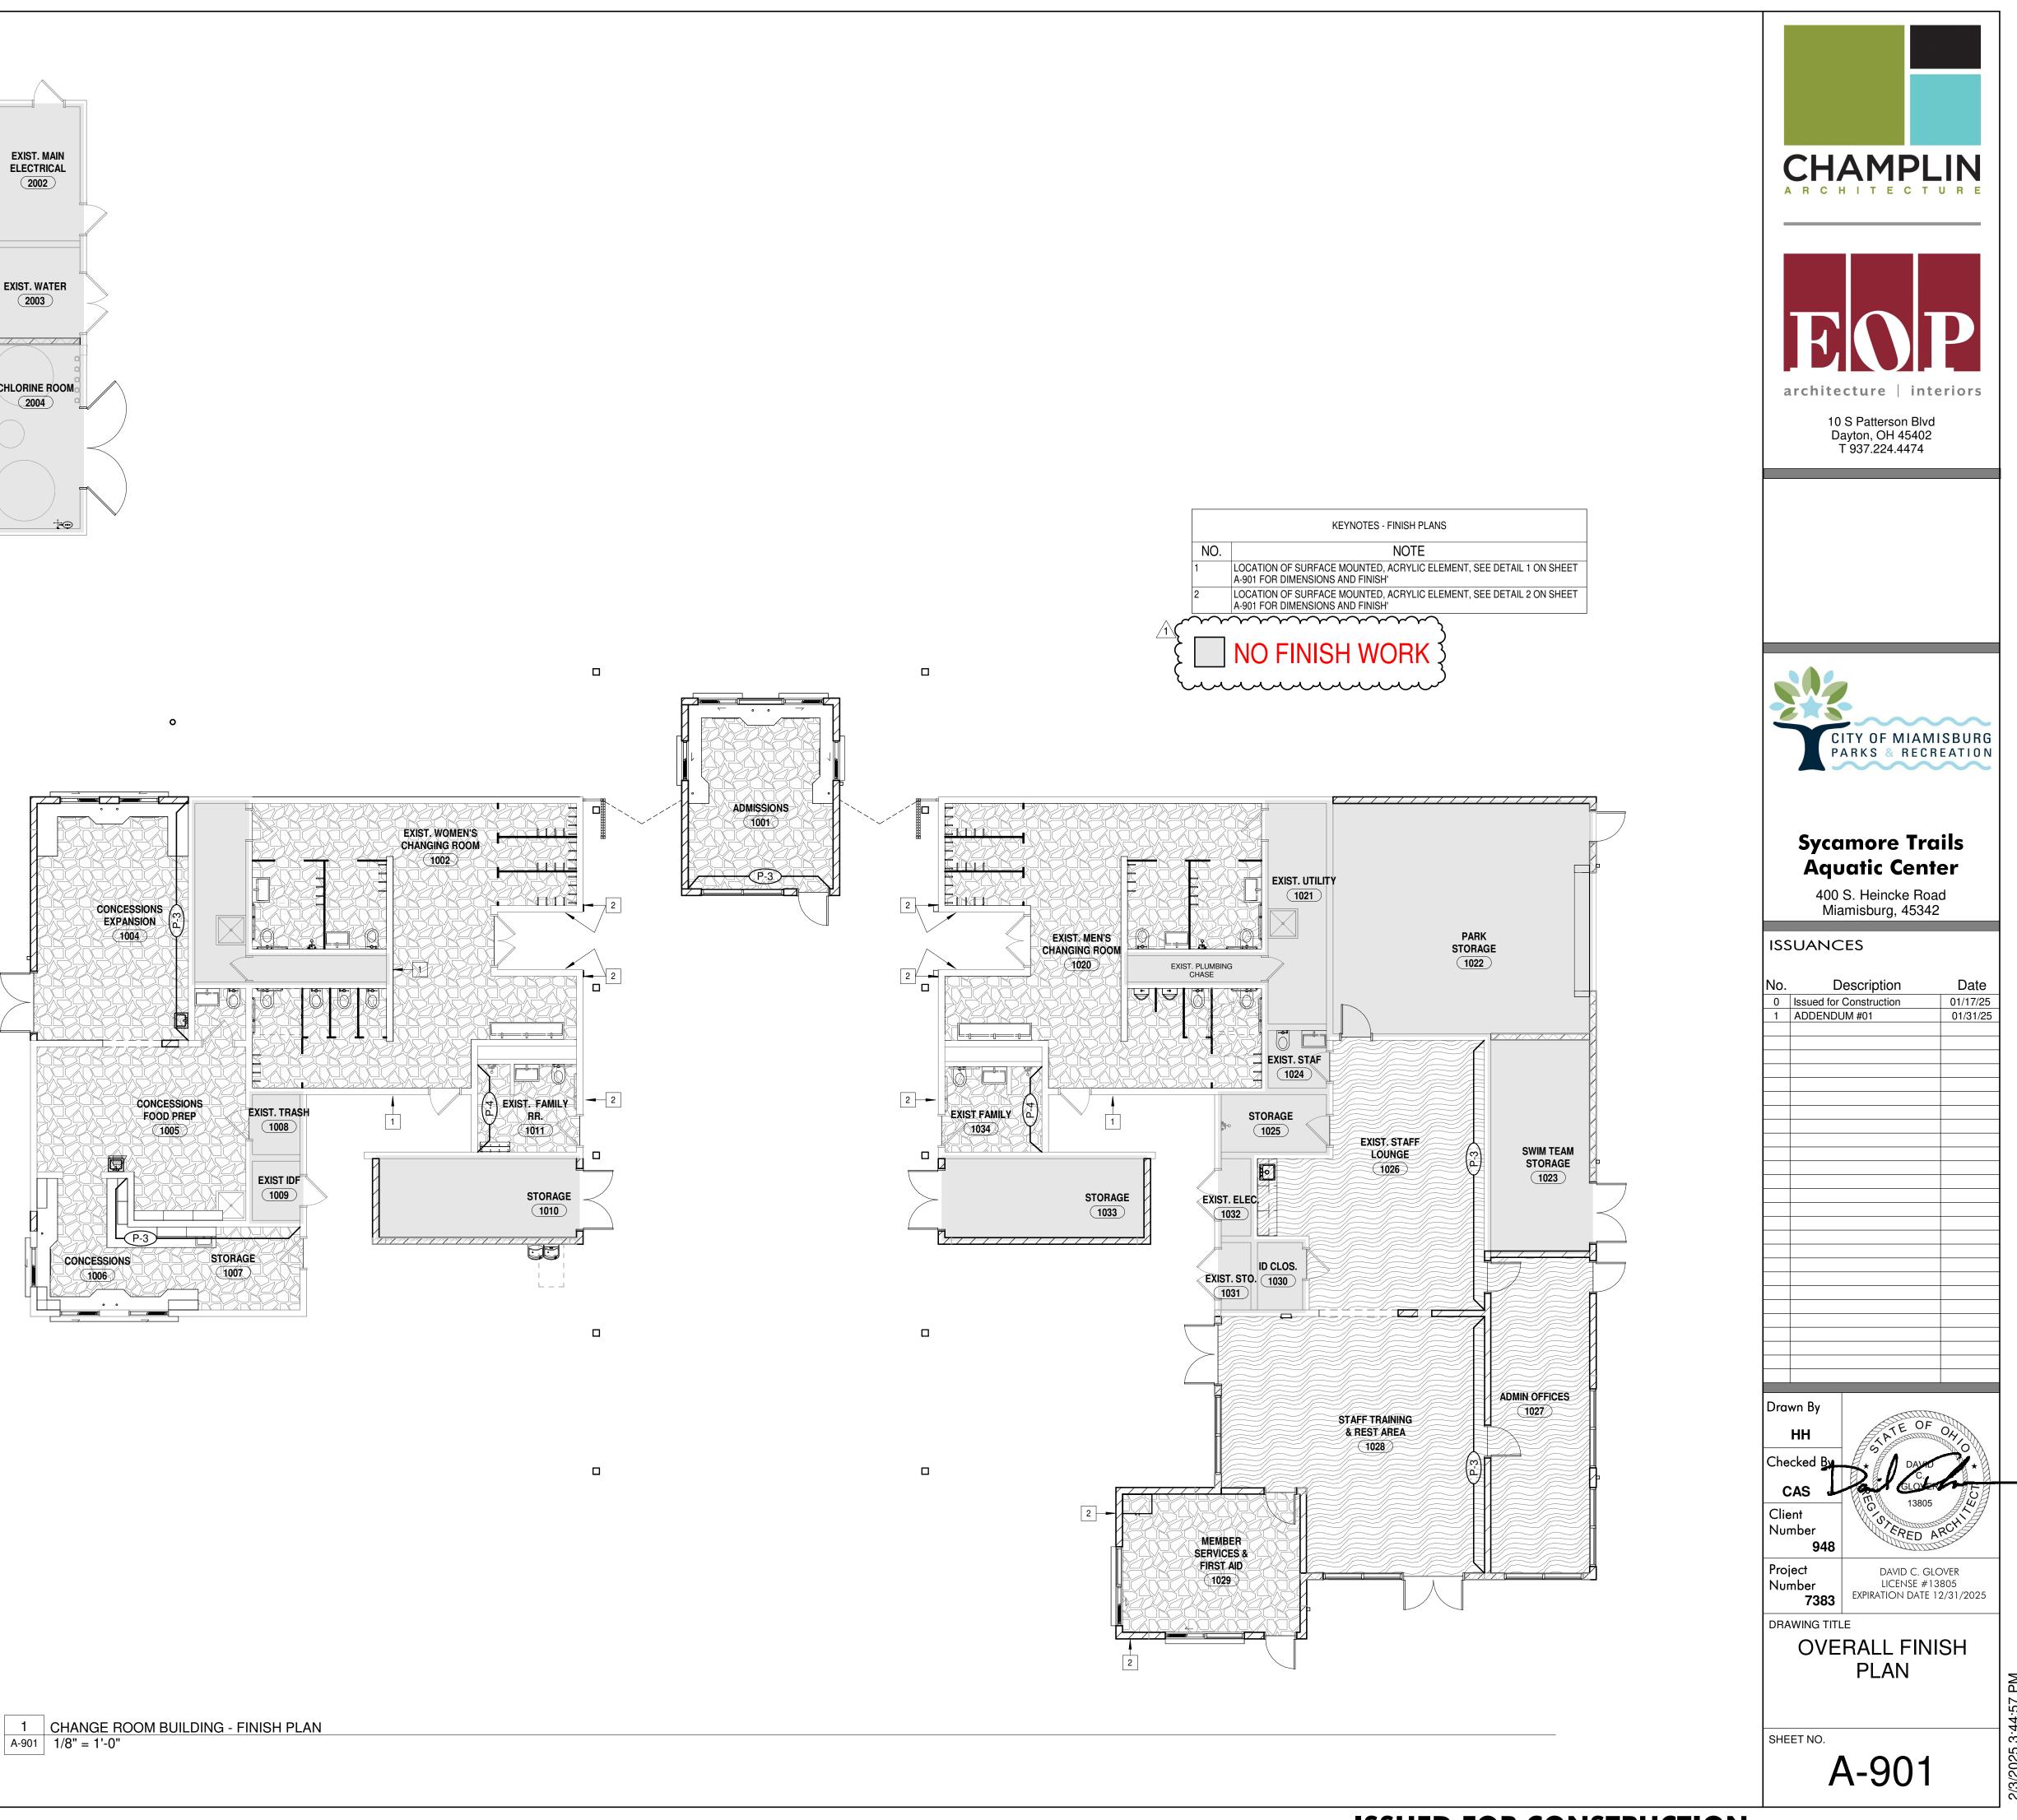


1	CHANGE ROOM
•	
A-901	1/8" = 1'-0"

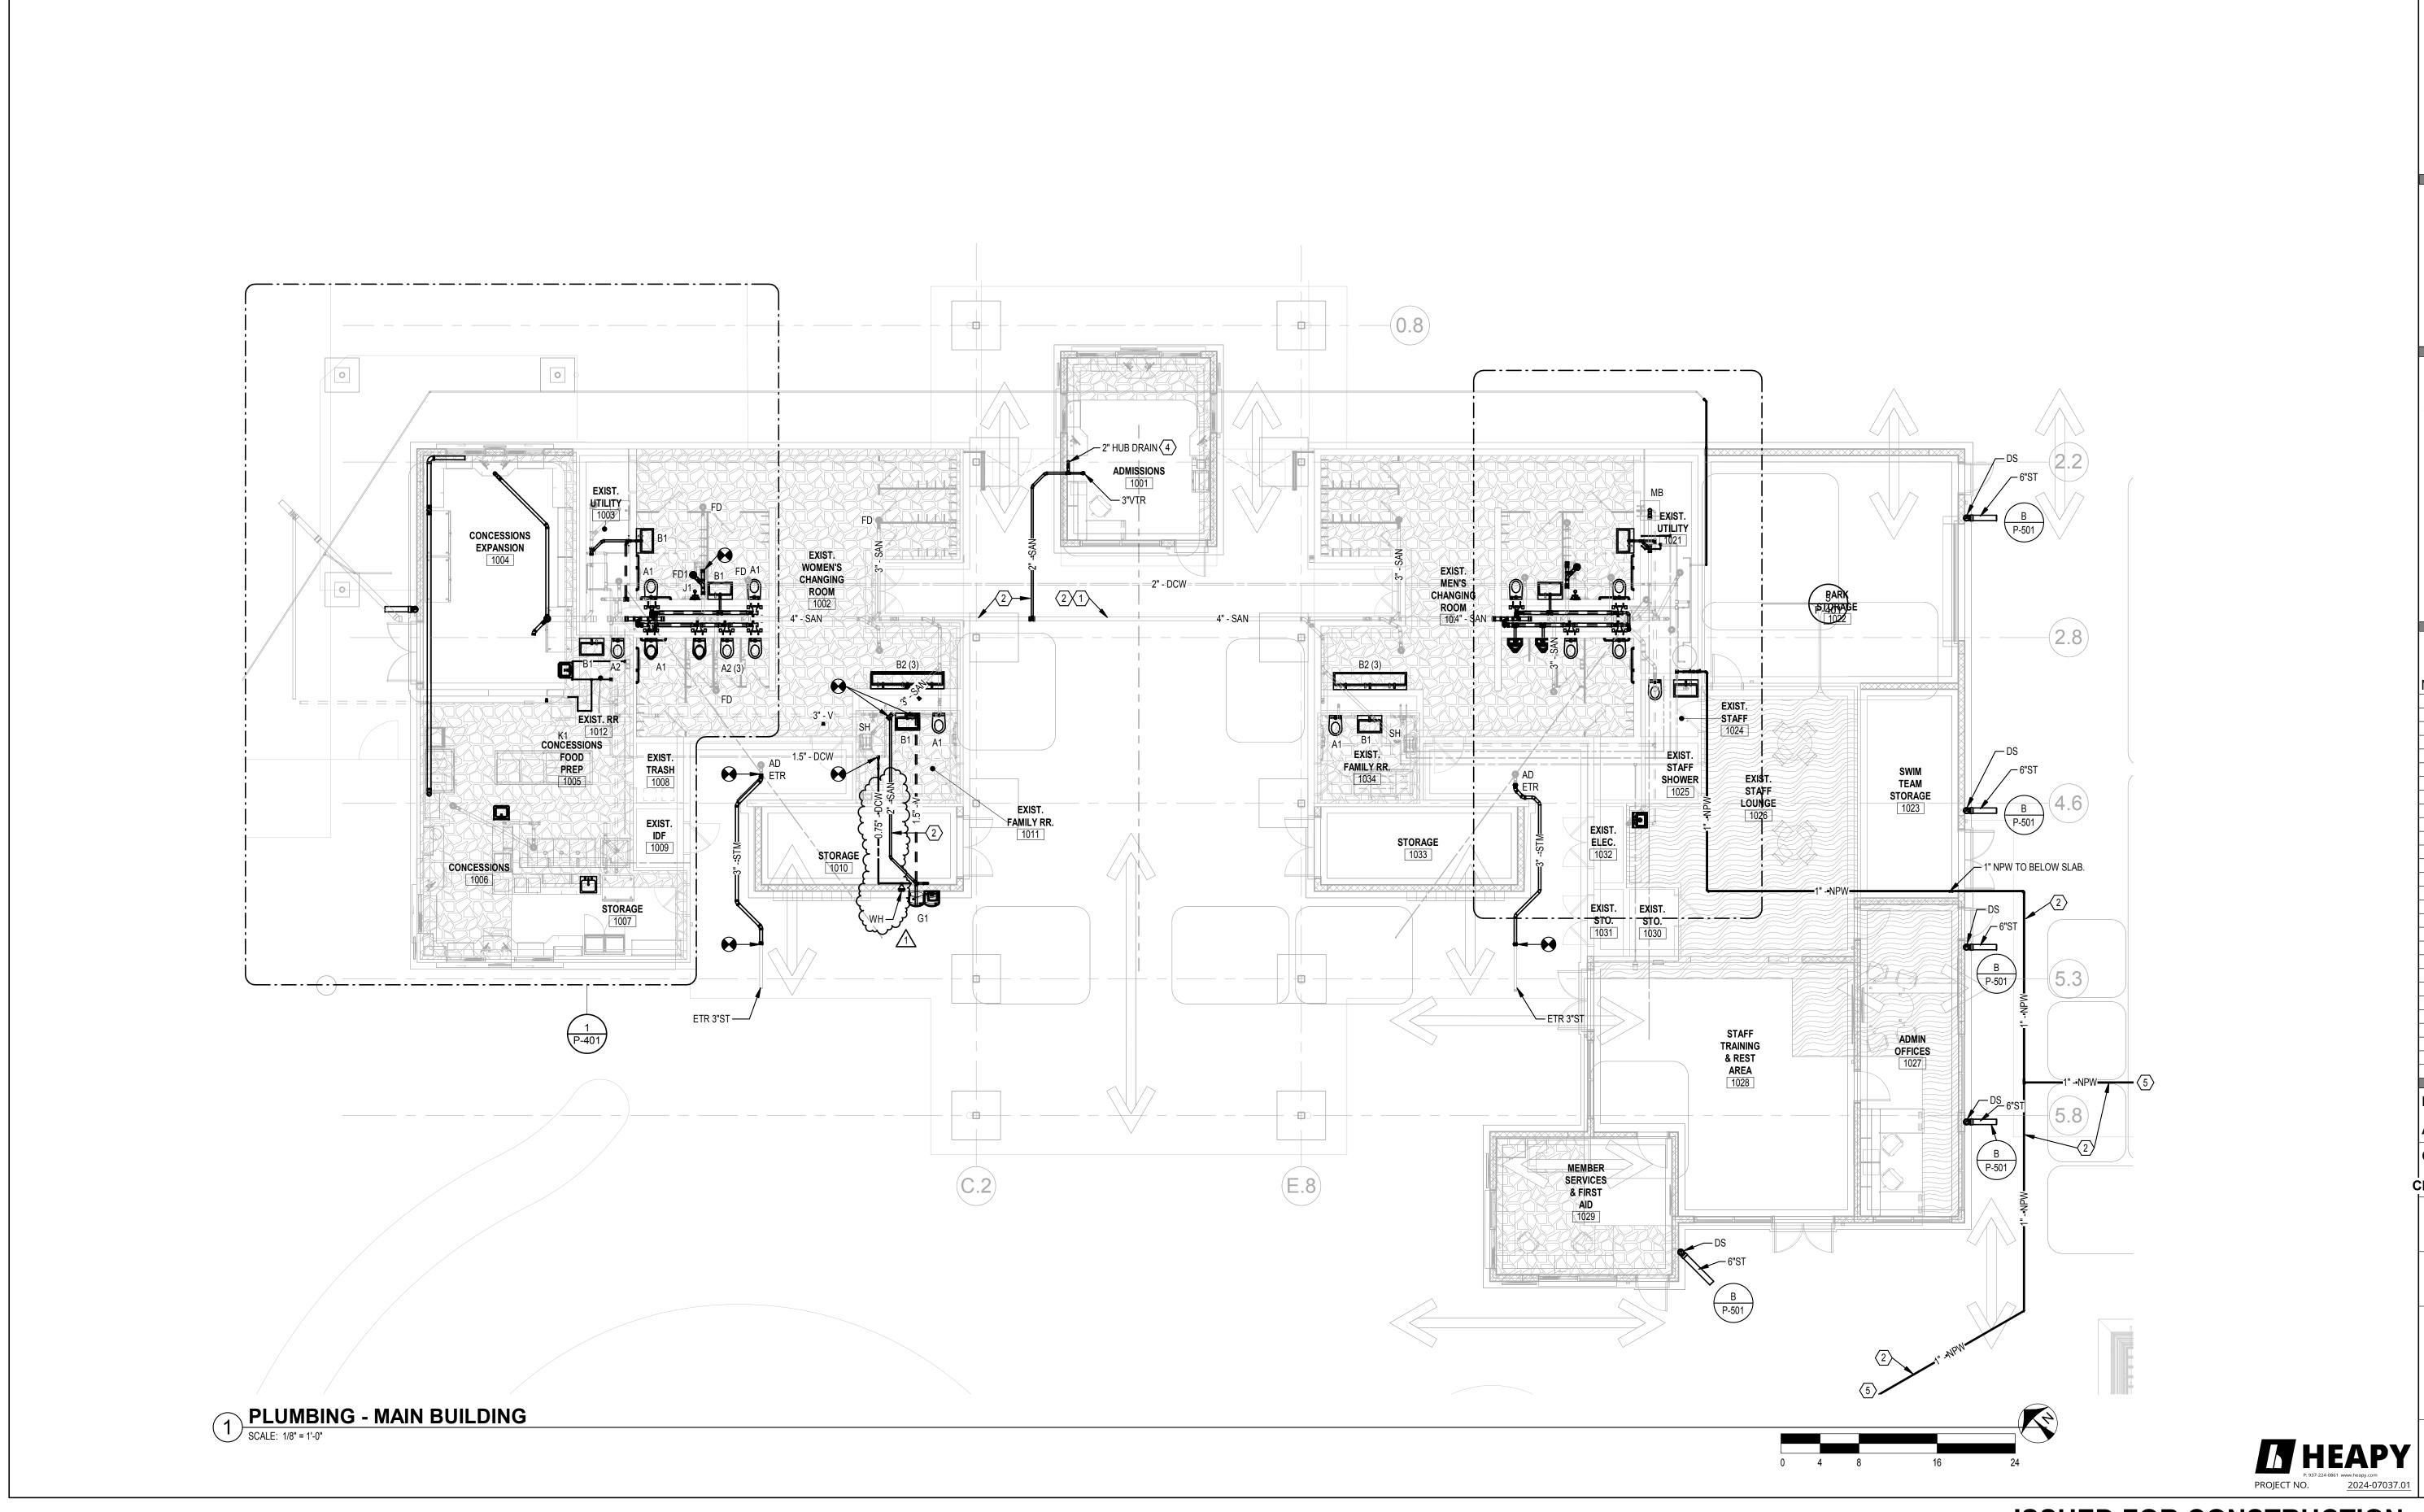

\bigcirc PLAN NOTES

- 1 EXISTING PIPING TO REMAIN.
- 2 PIPING LOCATED BELOW SLAB AND/OR GRADE.
- 3 EXISTING PLUMBING FIXTURE TO REMAIN.
- 4 PROVIDE 2" HUB DRAIN TO 4" ABOVE SLAB (FOR CONDENSATE). LOCATE TIGHT TO EXPOSED TO CMU WALL. ROUTE VENT RISER TIGHT TO WALL BEFORE OFFSET IN CEILING.
- 5 PIPING CONTINUED ON SITE/CIVL PLAN.

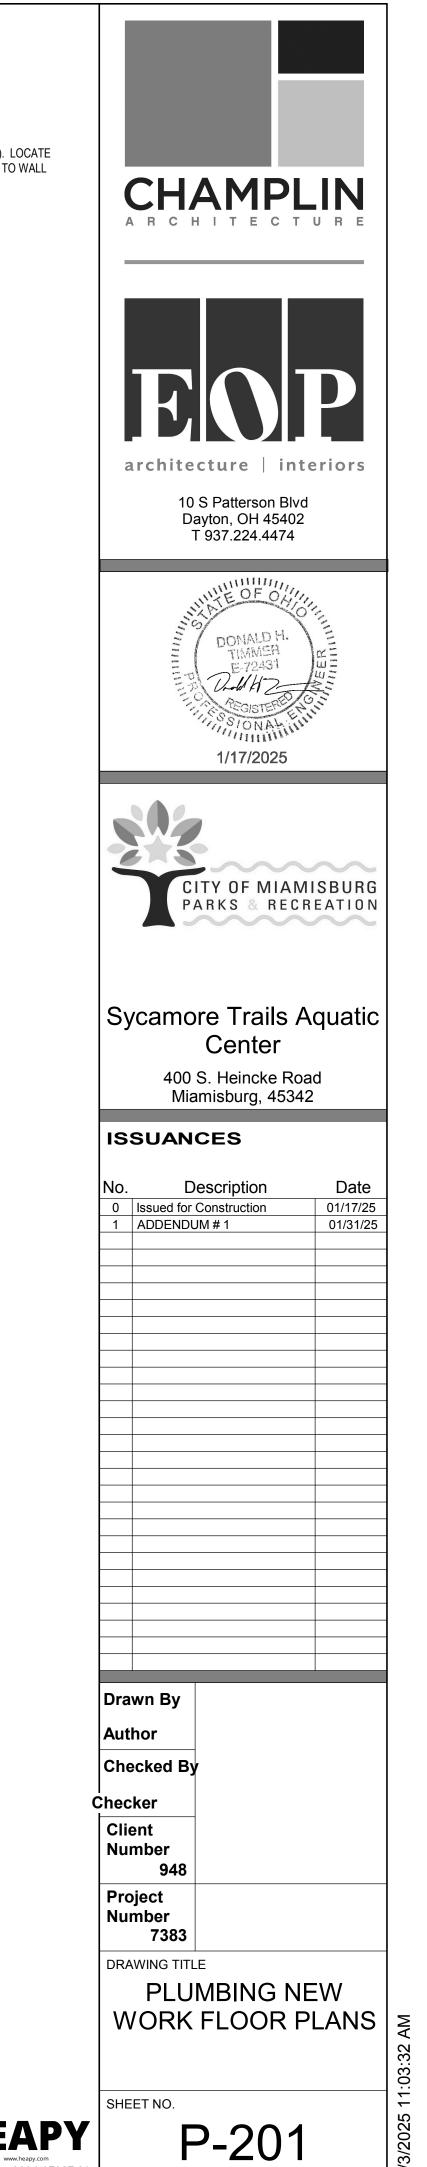

- GENERAL NOTES: A. UNLESS NOTED OTHERWISE, CAPACITIES SHALL BE BASED ON INTERIOR DESIGN CONDITIONS OF 80 DB / 67 WB COOLING; 60 DB HEATING. 3. HEAT PUMP COOLING CAPACITY SHALL BE BASED ON 95°F AMBIENT CONDITIONS. . HEAT PUMP HEATING CAPACITY SHALL BE BASED ON 47°F AMBIENT CONDITIONS.
- D. CONDENSING UNITS SHALL INCLUDE LOW AMBIENT COOLING & HEATING CONTROLS AND ACCESSORIES, OPERATIONAL TO 5°F.

NOTES:

I. POWER FOR INDOOR UNIT IS TO BE FED THRU THE OUTDOOR UNIT POWER SUPPLY.

								INDOOR UN	IIT													
		TYPE	LOCATION			FAN			COIL CAPA	CITY		ELECTF SERV		APPRO	X. DIME	NSIONS	E I)		BASIS OF	DESIGN		
								COC	DLING	HEA	TING						<u></u>				-	l
MARK	DESCRIPTION	WALL-MOUNTED CEILING-MOUNTED CEILING RECESSED DUCTED	ROOM NAME	ROOM NUMBER	CFM	EXTERNAL STATIC PRESSURE (IN. W.C.)	MOTOR (HP) ELECTRONICALLY COMMUTATED MOTOR	ENT. AIR TEMP DB/WB	TOTAL / SENSIBLE CAPACITY (MBH)	ENTERING AIR TEMP. DB	CAPACITY (MBH)	SERVED THRU OUTDOOR UNIT (NOTE 1) VOLTAGE - PHASE	MINIMUM SCCR (AMPS)	LENGTH	WIDTH	HEIGHT	COOLING COIL CONDENSATE DRAIN PUMP (N	VIBRATION ISOLATOR TYPE	MANUFACTURER	MODEL	MARK	DESCRIPTION
SHP-1	CEILING CASSETTE	- •	STAFF TRAINING & REST AREA	1028	800	-	1/4 -	80 / 67	36 / 24	68	40	• 208-1	5K	38"	38"	10"	•	J1	LG	LC369HHV	HPCU-1	OUTDOOR UNIT
SHP-2	CEILING CASSETTE	- •	ADMIN OFFICES	1027	600	-	1/4 -	80 / 67	24 / 18	68	27	• 208-1	5K	38"	38"	10"	•	J1	LG	LC249HHV	HPCU-2	OUTDOOR UNIT
SHP-3	WALL MOUNT SPLIT	•	EXIST. STAFF LOUNGE	1026	600	-	1/4 -	80 / 67	24 / 21	68	27	• 208-1	5K	38"	12"	10"	•	J1	LG	LS243HLV3	HPCU-3	OUTDOOR UNIT
SHP-4	CEILING CASSETTE	- •	MEMBER SERVICES & FIRST AID	1029	600	-	1/4 -	80 / 67	24 / 18	68	27	• 208-1	5K	38"	38"	10"	•	J1	LG	LC249HHV	HPCU-4	OUTDOOR UNIT
SHP-5	CEILING CASSETTE	- •	ADMISSIONS	1001	600	-	1/4 -	80 / 67	24 / 18	68	27	• 208-1	5K	38"	38"	10"	•	J1	LG	LC249HHV	HPCU-5	OUTDOOR UNIT
SHP-6	CEILING CASSETTE	- •	CONCESSIONS EXPANSION	1004	800	-	1/4 -	80 / 67	36 / 24	68	40	• 208-1	5K	38"	38"	10"	•	J1	LG	LC369HHV	HPCU-6	OUTDOOR UNIT
SHP-7	CEILING CASSETTE	- •	CONCESSIONS FOOD PREP	1005	800	-	1/4 -	80 / 67	36 / 24	68	40	• 208-1	5K	38"	38"	10"	•	J1	LG	LC369HHV	HPCU-7	OUTDOOR UNIT
SHP-8	CEILING CASSETTE		CONCESSIONS	1006	800	-	1/4 -	80 / 67	36 / 24	68	40	• 208-1	5K	38"	38"	10"	•	J1	LG	LC369HHV	HPCU-8	OUTDOOR UNIT

GENERAL NOTES:

AND SHALL BEAR THE A.M.C.A. LABEL.

A. ALL FANS SHALL BE A.M.C.A. 211 AND 311 PERFORMANCE CERTIFIED


. MOTOR HORSEPOWERS LISTED SHALL BE CONSIDERED MINIMUM.

D. ROOF & WALL OPENINGS ARE APPROX. VERIFY SIZE & COORDINATE.

. SONES VALUES BASED ON A.M.C.A. 301 MEASURED AT 5 FT.


GRAVITY ROOF VENTILATORS

	. NOTES: OPENING SIZES ARE APPROXIMATE. VEF OORDINATE.	RIFY SIZE			RDINATE RE REQL					- OPENI	NG,				REFER TO SPECIFICA REQUIREMENTS.	TIONS FOR
NOTES: 1.																
				W.C.)	NECK	SIZE	APPRO	DX. HOO	D SIZE		Щ			DRAFT IPER	BASIS OF D	ESIGN
MARK	DESCRIPTION	SERVICE	CFM	MAX. STATIC PRESSURE (IN.	LENGTH	WIDTH	LENGTH	WIDTH / DIAMETER	HEIGHT	CURB HEIGHT	APPROX. ROOF OPENING SIZE	APPROX. WEIGHT (LBS.)	MOTORIZED	GRAVITY	MANUFACTURER	MODEL
GRV-1	SPUN ALUMINUM INTAKE VENTILATOR	INTAKE	200	.05	8"	8"	21"	21"	12"	12"	11x11	20	-	•	GREENHECK	GRSI
GRV-2	LOUVERED INTAKE VENTILATOR	INTAKE	2100	.07	22"	22"	36"	36"	24"	12"	22x22	64	-	•	GREENHECK	WIH
GRV-3	LOUVERED EXHAUST VENTILATOR	EXHAUST	2000	.1	18"	18"	32"	32"	25"	12"	18x18	52	-	•	GREENHECK	WRH
GRV-4	LOUVERED EXHAUST VENTILATOR	EXHAUST	2000	.1	18"	18"	32"	32"	25"	12"	18x18	52	-	•	GREENHECK	WRH

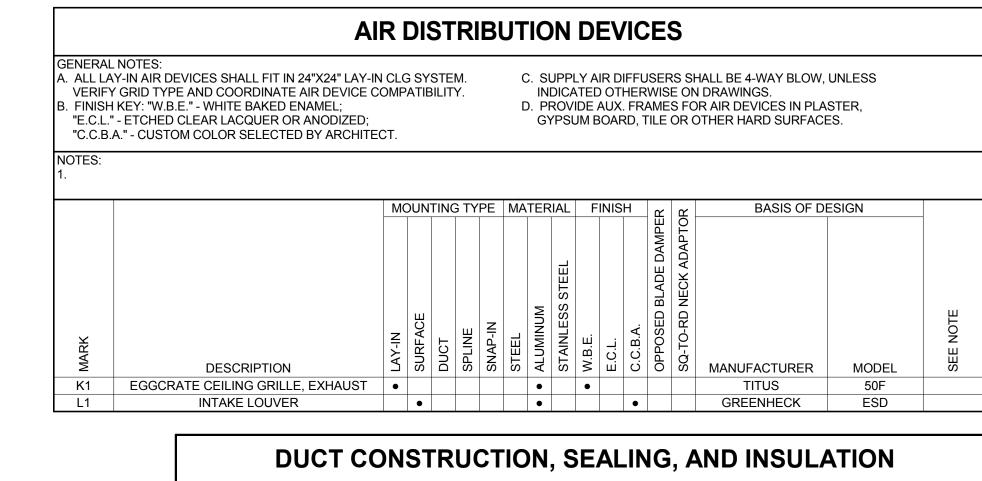

			, O				ULAII		
GENERAL NOTES: A. REFER TO SPECIFICATIONS FOR DUC SHEET METAL DUCT; INTERIOR LININ INSULATION; FIBERGLASS DUCTBOAF	G; EXTERIC		1:		JCT CONSTRU TEST S.M.A.C			ALL BE PER	
NOTES: 1. WATERTIGHT SEAL. 2. INSULATE FROM 24" UPSTREAM OF B 3. ALUMINUM DUCTWORK.	ACKDRAFT	/ ISOLA	TION	DAMP	ER TO PENET	RATION OF V	VALL / ROOF	=.	
	S.M.A	.C.N.A.	CLASS	S.					
				KAGE ASS			DOUBLE		
DUCT SYSTEM	S.P. CON- STRUCT.		RECT	RND	INTERNALLY LINED	EXTERNAL INSULATION	WALL	NOT INSULATED	SEE NOTE
GENERAL EXHAUST DUCTWORK	-1"	А	16	8	-	NOTE 2	-	-	-
PUMP & CHLORINE ROOM EXHAUST DUCTWORK	-1"	A	16	8	-	-	-	-	3
RELIEF AIR DUCTWORK AND PLENUMS	+1	A	16	8	-	NOTE 2	-	-	-
OUTSIDE AIR DUCTWORK AND PLENUMS	-1"	А	16	8	-	•	-	-	1

SPLIT SYSTEM HEAT PUMP UNITS

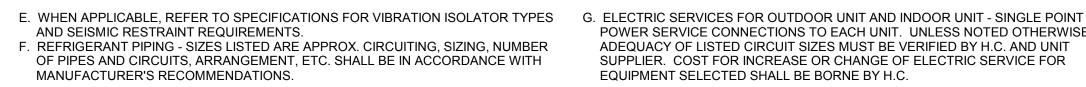


POWER SERVICE CONNECTIONS TO EACH UNIT. UNLESS NOTED OTHERWISE, ADEQUACY OF LISTED CIRCUIT SIZES MUST BE VERIFIED BY H.C. AND UNIT SUPPLIER. COST FOR INCREASE OR CHANGE OF ELECTRIC SERVICE FOR EQUIPMENT SELECTED SHALL BE BORNE BY H.C.


THE INDOOR FAN COIL UNIT SINGLE POINT POWER CONNECTION.

FANS

E. COORDINATE STEEL FRAMING AROUND ROOF OPENING WHERE REQUIRED

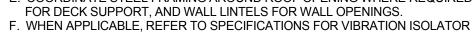

TYPES. G. VFD'S SHALL BE CONSTRUCTED AND LABELED FOR REQUIRED SCCR (SHORT CIRCUIT CURRENT RATING). COORDINATE WITH DIVISION 26.

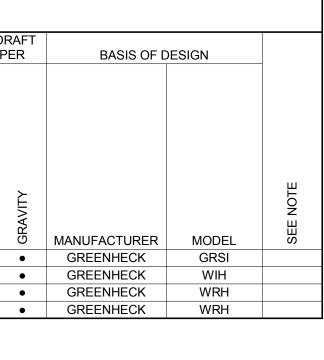

			ER SWITCH BY H.C. COORDI 80 DEG F (ADJUSTABLE).				ON. BUSINESS C	PERATIO	N SEASON.										
MARK EE-1	R TYPE (REFER TO SPECS)	UPBLAST POWE	CRIPTION R ROOF VENTILATOR	SERVICE CONCESSION EXHAUST	002 FAN CFM	in STATIC PRESSURE (IN. W.C.)	1 APPROX. WHEEL DIAMETER 9 MAXIMUM SONES	1/4	VOLTAGE - PHASE		ECM MOCP (AMPS, TOTAL)	- VARIABLE FREQUENCY DRIVE	16 APPROX. ROOF/WALL OPENING	APPROX. WEIGHT (LBS.)	VIBRATION ISOLATOR TYPE	MANUFACTUR GREENHECI	<	MODEL	L SEE NOTE
EF-2 EF-3	D2 C2			PUMP ROOM EXHAUST	3000	.25	22 8	1/2	115-1		\sim	- 5K	26x26	131		GREENHEC		CUBE	2
		(GENER																	
		B. ELEU INTE CIRC COS EQU C. ELE 3-WI NOTES 1. MOL	TING CAPACITY BASED ON 6 CTRIC SERVICE - SINGLE PO GRAL CONTROLS TRANSFO CUIT SIZE MUST BE VERIFIED T FOR INCREASE OR CHANG IPMENT SELECTED SHALL B CTRICAL SERVICE TO 3-PHA RE UNLESS NOTED OTHERV	DINT POWER CONNECTION WITH DRMER. ADEQUACY OF LISTED D BY H.C. AND UNIT SUPPLIER. GE OF ELECTRIC SERVICE FOR BE BORNE BY H.C. ASE UNITS SHALL BE		ACRC E. VERII & REC UNLE G. COO SEMI- 2. BASIS	ASE COIL LO DSS EACH PH FY / COORDIN CESS REQUIF SSED UNITS SS NOTED O RDINATE LIN RECESSED I RECESSED I	ASE. ATE CAB EMENTS SHALL HA THERWISI TELS IN M INIT WALL RAYWAL	INET DIMEN PRIOR TO C VE FOUR(4 E. ASONRY W/ OPENINGS	SIONS, MO RDERING) SIDE OVE ALLS FOR)UNTING ERLAP		BE PI OVEF REMO IS SP SYSTEM I. WHEN	ROVIDED RLOAD PR DTE ANAL ECIFIED, (1. I APPLICA	WITH FAC OTECTION OG SPEEL COORDIN/ BLE, REFI	CATED OR SPECII TORY DISCONNEC N, FIELD ADJUSTA D CONTROL INPUT ATED WITH THE BI ER TO SPECIFICA ^T EISMIC RESTRAIN	CTING ME BLE SPEI WHEN F JILDING /	EANS, INTER ED CONTRO REMOTE CO AUTOMATIC DR VIBRATIC	NAL DL, AND NTROL DN
		B. ELEU INTE CIRC COS EQU C. ELE 3-WI NOTES 1. MOL	TING CAPACITY BASED ON 6 CTRIC SERVICE - SINGLE PO GRAL CONTROLS TRANSFO CUIT SIZE MUST BE VERIFIED T FOR INCREASE OR CHANG IPMENT SELECTED SHALL B CTRICAL SERVICE TO 3-PHA RE UNLESS NOTED OTHERV	DINT POWER CONNECTION WITH DRMER. ADEQUACY OF LISTED D BY H.C. AND UNIT SUPPLIER. GE OF ELECTRIC SERVICE FOR BE BORNE BY H.C. ASE UNITS SHALL BE WISE.		ACRC E. VERII & REC UNLE G. COO SEMI- 2. BASIS 3. REFE FAN	DSS EACH PH FY / COORDIN CESS REQUIF ESSED UNITS SS NOTED O RDINATE LIN RECESSED I RECESSED I S OF DESIGN R TO FLOOR	ASE. ATE CAB EMENTS SHALL HA THERWISI TELS IN M INIT WALL RAYWAL	INET DIMEN PRIOR TO C VE FOUR(4 E. ASONRY W/ OPENINGS	SIONS, MO RDERING) SIDE OVE ALLS FOR	DUNTING ERLAP FULL &	CE A	BE PI OVEF REMO IS SP SYSTEM I. WHEN	ROVIDED RLOAD PR DTE ANAL ECIFIED, (I. I APPLICA ATOR TYP	WITH FAC OTECTION OG SPEEL COORDIN/ BLE, REFI ES AND S	TORY DISCONNEC N, FIELD ADJUSTA D CONTROL INPUT ATED WITH THE B ER TO SPECIFICA EISMIC RESTRAIN	CTING ME BLE SPEI WHEN F JILDING / TIONS FO T REQUI	EANS, INTER ED CONTRO REMOTE CO AUTOMATIC DR VIBRATIC	NAL DL, AND NTROL N
		B. ELEU INTE CIRC COS EQU C. ELE 3-WI NOTES 1. MOL	TING CAPACITY BASED ON 6 CTRIC SERVICE - SINGLE PO GRAL CONTROLS TRANSFO CUIT SIZE MUST BE VERIFIED T FOR INCREASE OR CHANG IPMENT SELECTED SHALL B CTRICAL SERVICE TO 3-PHA RE UNLESS NOTED OTHERV INTING HEIGHT TO BOTTOM COOR PLANS.	MOUNTING		ACRC E. VERII & REC F. RECE UNLE G. COO SEMI- 2. BASIS 3. REFE	DSS EACH PH FY / COORDIN CESS REQUIF ESSED UNITS SS NOTED O RDINATE LIN RECESSED I RECESSED I S OF DESIGN R TO FLOOR	ASE. ATE CAB EMENTS SHALL HA THERWISI TELS IN M NIT WALL RAYWAL PLANS FO	INET DIMEN PRIOR TO C VE FOUR(4 E. ASONRY W/ OPENINGS	SIONS, MO RDERING SIDE OVE ALLS FOR LECTRIC	DUNTING ERLAP FULL &	CE A INTEGRAL DISCONNECT A	BE PI OVEF REMO IS SP SYSTEM I. WHEN ISOL/	ROVIDED RLOAD PR DTE ANAL ECIFIED, (I. I APPLICA ATOR TYP	WITH FAC OTECTION OG SPEEL COORDIN/ BLE, REFI ES AND S	TORY DISCONNEC N, FIELD ADJUSTA D CONTROL INPUT ATED WITH THE B ER TO SPECIFICA EISMIC RESTRAIN	CTING ME BLE SPEI WHEN F JILDING / TIONS FO T REQUI	EANS, INTER ED CONTRO REMOTE CO AUTOMATIC DR VIBRATIC REMENTS.	NAL DL, AND NTROL N

H. IF EC MOTORS ARE INDICATED OR SPECIFIED, EACH MOTOR SHALL BE PROVIDED WITH FACTORY DISCONNECTING MEANS, INTERNAL OVERLOAD PROTECTION, FIELD ADJUSTABLE SPEED CONTROL, AND REMOTE ANALOG SPEED CONTROL INPUT WHEN REMOTE CONTROL IS SPECIFIED, COORDINATED WITH THE BUILDING AUTOMATION SYSTEM. I. COOLING COIL CONDENSATE PUMPS SHALL BE FACTORY-FURNISHED, COMPATIBLE WITH INDOOR FAN COIL UNIT VOLTAGE AND POWERED FROM

> OUTDOOR HEAT PUMP CONDENSING UNIT - AIR COOLED ELECTRICAL SERVICE BASIS OF DESIGN -AM 5 R á NO GAS MANUFACTURER MODEL 3 • 208-1 32 40 LG LC489HHV 5K 1 2 • 208-1 22 30 5K LG LC249HHV 2 • 208-1 LG LSU243HLV3 19 30 5K 2 • 208-1 22 30 5K LG LC249HHV LG 2 • 208-1 22 30 5K LC249HHV 1 3 • 208-1 32 40 5K LC489HHV LG 1 3 • 208-1 32 40 5K LG LC489HHV 1 3 • 208-1 32 40 5K LG LC489HHV - 1

H. IF EC MOTORS ARE INDICATED OR SPECIFIED, EACH MOTOR SHALL BE PROVIDED WITH FACTORY DISCONNECTING MEANS, INTERNAL OVERLOAD PROTECTION, FIELD ADJUSTABLE SPEED CONTROL, AND REMOTE ANALOG SPEED CONTROL INPUT WHEN REMOTE CONTROL IS SPECIFIED, COORDINATED WITH THE BUILDING AUTOMATION SYSTEM.



AM 53



