

VALLEY VIEW LOCAL SCHOOLS
Germantown, Ohio

February 9, 2026

Addendum No. 1

TRANSMISSION VIA EMAIL
RETURN RECEIPT REQUESTED

TO THE DRAWINGS AND SPECIFICATIONS FOR:

BOARD OFFICE RENOVATION PROJECT

Prepared by:
The Oregon Group Architects
300 S. Patterson Blvd.
Dayton, Ohio 45402
937-228-1511
Kyle Zepernick
kzepernick@oregongroup.com

TO ALL BIDDERS:

This Addendum supplements and amends the original Plans and Specifications and shall be taken into account in preparing proposals and shall become a part of the contract documents.

ADDITIONAL INFORMATION

Item No. 1: Find attached the Pre-Bid Conference Meeting Minutes and Sign-in Sheets.

Item No. 2: A second walk-thru for contractors has been scheduled for Wednesday, February 11th at 1:00 pm. We will meet in the entry vestibule inside the middle entrance on the east façade. This will be the last walk-thru, be certain all interested contractors are in attendance.

TO THE DRAWINGS

Item No. 3: Sheet A3.1, First Floor Finish Schedule – In Room #116 Break Room. Change resinous flooring system to LVT. LVT being provided to allow existing neutralization tank in slab to be covered and removed in the future if necessary. LVT to be Mannington, Color Anchor Collection, Groove, Color: Misty Mountain, 6"x36". Wall Base to become 4" rubber base. Prep floor and tank cover per manufacturer's recommendations for LVT installation. See attached revised Drawing Sheet. A3.1.

Item No. 4: Sheet A3.1, Door Schedule – Existing Doors E04 and E05 are to receive new levered door hardware privacy locksets to match proposed door lockset for Door 13. Provide door alterations and trim as necessary to accept new door hardware. See attached revised Drawing Sheet. A3.1.

Item No. 5: Sheet A1.3 Room Signage – Room signs at Toilet Room 117, Restrooms 110 & 111 should read “Unisex” and have both men and women’s pictograms. See attached revised Drawing Sheet. A1.3.

Item No. 6: Sheet A1.4 Firestopping Details were added for any anticipated penetrations through any fire rated floors or walls. See attached revised Drawing Sheet. A1.4.

Item No. 7: Sheet A1.3, New Work Note #2. Add to note that double stud wall is detailed on Detail 2b/A3.1. See attached revised Drawing Sheet. A1.3.

Item No. 8: Sheet A2.2, Interior Elevation Drawings b/A2.2, 4/A2.2, 5/A2.2, 6/A2.2. Remove wording “Alternate #2” from these drawing titles. See attached revised Drawing Sheet. A2.2.

Item No. 9: Sheet A1.2, new Detail a/A1.2 for concrete slab repairs at floor trenches. Repair detail would be applicable to all floor slab trench repairs.

Item No. 10: Sheet A1.3, New Work Note #13, frosted privacy glass film to be 3M Dusted Crystal Glass Finish 7725SE-314 or equal.

Item No. 11: Sheet A3.1, First Floor Finish List, CPT-1. Carpet Tile to be Tarkett, Style ‘Corollary’ 11577. Size to remain 18”X36” and Color to remain ‘Blue Strategy’ 39404.

Item No. 12: Sheet P1.1, Demolition Notes #1 and #2 revised to refer to the floor patching detail in the Architectural drawings.

Item No. 13: Sheet P2.1, Installation Notes #1 and #2 revised to refer to the floor patching detail in the Architectural drawings.

Item No. 14: Sheet P2.1, Installation Note 4 added and applied to the plan view. Reads, “EXISTING MANHOLE COVER AND BASIN TO REMAIN. GENERAL CONTRACTOR TO COVER WITH FLOORING. DRAIN SYSTEM NO LONGER BEING USED FOR CHEMISTRY LABORATORIES AND WILL NOT REQUIRE REGULAR MAINTENANCE AS IT IS NO LONGER PROVIDING NEUTRALIZATION.”

Item No. 15: Sheet M2.1, The return air sound traps have been sized and quantities updated. These were previously shown, but not sized.

Item No. 16: Sheet M2.1, Installation Note 16 added and applied to the plan view. Read “THE SOUTH AND EAST WALL OF THE MECHANICAL ROOM WILL HAVE OPEN STUD BAYS ABOVE THE CEILING LEVEL TO ALLOW FOR AIR MOVEMENT FROM THE AIR PLENUM TO THE MECHANICAL ROOM. TRANSFER DUCT NOT REQUIRED HERE.”

Item No. 17: Sheet M5.1, Ventilation Schedule – AUV-5 revised as the graphics of it resulted in some cells being blacked out. Content otherwise unchanged.

Item No. 18: Sheet M5.1, Control Valve Schedule consolidated to save space on sheet. Now identifies 3-way vs 2-way valves.

Item No. 19: Sheet M5.1, Sequence of Operations added to the drawings.

Item No. 20: Sheet M5.2, “Air Transfer Detail” renamed to “Sound Boot Detail” as it is referred to a sound boot on other sheets.

Item No. 21: Sheet M5.2, On the Return Air Sound Trap Detail, the duct dimension has been revised to read “SEE PLAN.”

END OF ADDENDUM NO. 1



O R E G O N G R O U P A R C H I T E C T S

The Parsonage House | 300 S. Patterson Blvd. Dayton, OH 45402-2845 | Phone: 937.228.1511 Fax: 937.228.9669 | www.oregongroup.com

Valley View Local Schools Board Office Renovation

PRE-BID MEETING MINUTES

DATE, TIME: February 4, 2026, 1:30 PM

PROJECT NO.: 251431

Meeting Location: Valley View Old High School Campus

Attendee	Company	Phone	Email
Kyle Zepernick	Oregon Group Architects	937-228-1511	kzepernick@oregongroup.com
Valorie Hill	Valley View Local Schools		valorie.hill@valleyview.K12.oh.us
Erick Depew	Valley View Local Schools		erick.depew@valleyview.K12.oh.us

*See attached sign-in sheets for complete list of attendees.

1. This is a publicly bid project. The Instructions to Bidders, Sample Contract, General Conditions, Bid Guaranty & Contract Bond Forms, and Bid Form are included in front end specifications. Contractors to ensure they are familiar with these documents.
2. Channel of Communications shall be through Oregon Group Architects and will be forwarded to the appropriate party for response. Contact information is in the specifications.
3. All questions should be submitted in writing to Oregon Group Architects, preferably via email. Deadline for bidding questions is Thursday, February 5, 2026, 5:00 pm.
4. A walk-thru tour will be conducted after this meeting. No additional visits are scheduled at this time.
5. Bid Due Date – Wednesday, February 18, 2026, 2:00 pm at Valley View Local Schools Board of Education Offices, 59 Peffley Street, Germantown, OH 45327.
 - a. Bids will be opened and read aloud at that time. Please mark clearly on exterior of envelope "Valley View LSD – Board Office Renovation Project Bid". It is strongly recommended that bids be hand delivered.
 - b. Any Bid received after 2:00 PM will not be considered responsive.
 - c. No faxed or emailed bids will be accepted.
 - d. Bid envelope MUST contain 1 original and 1 copy of the completed Bid Form, the Bid Guaranty, if applicable a Contract Bond, and Contractor's Qualification Statement.
 - e. Bid Guaranty Form must be for the full amount of the bid, including all ADD alternates (do not include deduct alternates), or the line left blank. If the line is left blank, the penal sum will be the full amount of the bid, including add alternates. A percentage is NOT acceptable and the bid will be rejected. If Bidder wishes, a certified check, cashier's check or irrevocable letter of credit in the amount of 10% of the bid plus all ADD alternates would be acceptable. AIA or EJCDC Bid Bond forms are not acceptable.
6. This project does NOT require Prevailing Wages to be paid.
7. Valley View Local Schools is tax exempt.
8. Project Summary
 - a. Kyle Zepernick, Project Architect provided a summary of the project.
 1. Board Office Renovation.

- a. Work consists of renovation of an office suite in the old Valley View High School building. Work includes reorganization of office spaces and new plumbing, mechanical, electrical, security and IT systems.
- b. The office suite space will be vacant during renovation work. Other areas of the building will remain occupied, including a Pre-school program and a YMCA before school and after school program. Contractors will need to be aware of and sensitive to children being in the building. See working hours and noisy and odorous work restrictions in Section 01 10 00 Summary.
- c. School year ends at the end of May. Valley View Pre-School program does not operate during the summer break months. The YMCA before school and after school program MAY operate in the summer months.
- d. Estimated construction cost for the project \$550,000.
- e. Improvements are anticipated to be completed between March 2026 and August 3, 2026.
- f. Project is to be Substantially Complete by August 3, 2026. Staff will move in that week.
- g. Bi-weekly coordination and progress meetings will be required. All contractors conducting work on site will be required to attend meetings.
- h. Bid Documents are available thru Arc Document Solutions Dayton 937-277-7930.
- i. No Alternates included in project.
- j. Building Permit has been applied for through the Montgomery County Building Department. Building Permit application fee has been paid for. Contractors shall be responsible for all required permit fees.
- k. Contractors shall pay all aid-to-construction fees associated with the project.
- l. Substitution requests are required to be submitted by a bidding contractor 10 days prior to the Bid Opening date. Falls on a Sunday so deadline this Friday, Feb. 6th. Substitution Form is in specs.
- m. Critical Path Method schedule is required for this project.
- n. Addendum will be released prior to 72 hours before bid opening.
- o. No smoking is permitted in the building or on the property. This will be strictly enforced and workers in violation will be removed from site.
- p. See Aerial Photo in Drawings for location of assigned Contractor's parking spaces and laydown area. Exact area to be coordinated with the Owner.

9. Nothing presented in this Pre-bid Meeting is intended to conflict with the Contract Documents. Where conflicts may occur, Contract Documents take precedence. Verbal interpretations of the Contract documents, and any statements made at the Pre-Bid meeting by the A/E, the Owner, or its representatives will not be binding. Any and all changes to the Contract Documents will be made by written addendum.

10. Site Review – tour of the areas of work will follow this meeting. Keep in mind this is an occupied building and children are present. Please do not include any staff or children in photos. Please keep noise to a minimum.

The above information constitutes our understanding of the activities and events of this meeting. If in your opinion, additions or modifications are required please advise the author in writing immediately.

Kyle Zepernick
OREGON GROUP ARCHITECTS, INC.

PRE-BID MEETING
SIGN IN SHEET

PROJECT: Valley View LSD
Board of Education Office Renovation
February 4, 2026

Name

Company

Phone

Email

Marcus Horner

Ascon Builders

937-692-6330

Marcus.horner@asconbuilders.com

Clay Aikman

AKA Construction

937-902-0031

Clay@aka-construction.com

KIP MYERS

BRUMBAUGH

937-692-5107

KIP@BRUMBAUGHCONSTRUCTION.COM

Erik Depew

Valley View

937-903-7644

ERIK@VALLEYVIEW.ORG

Mark Hu

Valley View

937-623-9215

MARK.HU@VALLEYVIEW.ORG

PRE-BID MEETING SIGN IN SHEET

**PROJECT: Valley View LSD
Board of Education Office Renovation
February 4, 2026**

Name _____
Company _____

ALLISON RODRIGUEZ

LEVEL MB

937-671-436

ADOBELIBER@LEVERMB.COM

Patrick Kohlmeier

Vancor General Contractors

937-474-0380


Quality Commercial Floors @ PatrickVanonge.com

owner:



**VALLEY
VIEW
LOCAL SCHOOLS**

architect:

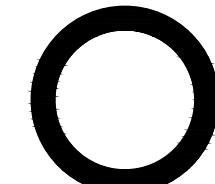

OREGON GROUP ARCHITECTS
ARCHITECTURE INTERIORS CODE CONSULTANTS

mechanical engineer:



renovation for:
valley view local schools
6027 farmersville pike
germantown, ohio 45327

issued	
BID DOCUMENTS	
revised	
	
<p>KYLE D. ZEPERNICK No. 10884 REGISTERED ARCHITECT Kyle Zepernick, Licence #10884 Expiration Date 12-31-2027</p>	
<p>THESE DRAWINGS AND SPECIFICATIONS, THE DRAWINGS DISCLOSED OR REFERENCED THEREIN, AND THE SERVICES REPRESENTED THEREIN ARE THE EXCLUSIVE PROPERTY OF THE OREGON GROUP ARCHITECTS, INC. THE DRAWINGS AND SPECIFICATIONS ARE PROVIDED UPON THE UNDERSTANDING THAT THE CONTRACTOR UPON RECEIPT HEREOF, WILL NOT REPRODUCE OR DISCLOSE THE DRAWINGS AND SPECIFICATIONS TO ANYONE, EXCEPT AS PROVIDED IN THE CONTRACT DOCUMENTS. THE OREGON GROUP ARCHITECTS, INC. RESERVES THE RIGHT TO REPRODUCE THE DRAWINGS AND SPECIFICATIONS FOR THE CONTRACTOR'S USE.</p>	


general notes

- THE GENERAL NOTES CONTAINED HEREIN ARE PART OF THE PLANS AND SPECIFICATIONS AND ARE TO BE COMPLIED WITH IN ALL RESPECTS. MORE RESTRICTIVE NOTES SPECIFIED ELSEWHERE ARE TO TAKE PRIORITY OVER THOSE LISTED BELOW.
- THE CONTRACT DOCUMENTS INCLUDE THE WORKING DRAWINGS, APPENDIX, MODIFICATIONS, GENERAL CONDITIONS OF THE CONSTRUCTION CONTRACT AND SPECIFICATIONS.
- ALL WORK SHALL CONFORM TO THE REQUIREMENTS OF ALL CODES AND REGULATIONS OF ALL AUTHORITIES HAVING JURISDICTION. SUCH CODES AND REGULATIONS SHALL HAVE PRIORITY OVER THAT WHICH IS INDICATED ON THE CONSTRUCTION DOCUMENTS. IN CASES OF DISCREPANCIES, OMISSIONS, CHANGES IN THE CODES OR CODE INTERPRETATIONS BY CODE OFFICIALS WHICH CAUSE A CHANGE IN THE WORK, NOTIFY ARCHITECT PRIOR TO PROCEEDING WITH THAT PORTION OF THE WORK AFFECTED BY THE CHANGE. CONTRACTOR SHALL PAY AND OBTAIN BUILDING PERMITS AND ALL NECESSARY APPROVALS. CONTRACTOR SHALL OBTAIN ALL APPROVALS AND PERMITS FOR CONSTRUCTION FROM THE AUTHORITIES HAVING JURISDICTION, PRIOR TO COMMENCEMENT OF WORK, AT HIS OWN EXPENSE.
- THE GENERAL CONTRACTOR SHALL PERFORM DEMOLITION WORK AS REQUIRED TO COMPLETE CONSTRUCTION DESCRIBED IN THE DOCUMENTS. BEFORE UNDERTAKING DEMOLITION, ALL SERVICES ARE TO BE MADE SAFE FOR DEMOLITION.
- CONTRACTOR SHALL PROPERLY CLEAN UP DURING PROCESS OF WORK. CONTRACTOR, UPON COMPLETION OF WORK, SHALL LEAVE PREMISES CLEAN, NEAT AND ORDERLY.
- ALL WORK TO BE EXECUTED TO FULFILL THE INTENDED DESIGN ACCORDING TO ACCEPTED INDUSTRY STANDARDS FOR THEIR FULL FUNCTIONING AND OPERATION.
- IF CONFLICTS OCCUR BETWEEN DRAWINGS AND SPECIFICATIONS OR PRODUCTS, PROCEDURES, ETC., THE MORE STRINGENT DETAIL AND HIGHER QUALITY SHALL BE CONSIDERED THE INTENT OF THE CONTRACT DOCUMENTS. ARCHITECT'S CONFORMANCE IS REQUIRED.
- THESE DOCUMENTS HAVE BEEN COMPILED WITH THE BEST AVAILABLE INFORMATION AND ARE NOT INTENDED TO LIMIT THE SCOPE OF WORK. THE CONTRACTOR MAY ENCOUNTER HIDDEN OR COVERED CONDITIONS, NOT INDICATED IN THE DOCUMENTS, REQUIRING ADDITIONAL WORK FOR THE COMPLETION OF THIS CONTRACT. IT WILL BE ASSUMED THAT THE CONTRACTOR HAS INSPECTED THE SITE PRIOR TO BIDDING AND VERIFIED ALL CONDITIONS, DIMENSIONS, AND OTHER INFORMATION HEREIN SUPPLIED. THE CONTRACTOR SHALL NOTIFY THE ARCHITECT OF ANY UNEXPECTED FIELD CONDITIONS OR DISCREPANCIES PRIOR TO BEGINNING THEIR WORK.
- ALL DIMENSIONS AND LAYOUTS SHALL BE FIELD COORDINATED BY THE CONTRACTOR WITH THE ARCHITECTURAL, MECHANICAL, PLUMBING AND ELECTRICAL DRAWINGS. ALL SHOP DRAWINGS AND EXISTING CONDITIONS, ANY INCONSISTENCIES SHALL BE REPORTED TO THE ARCHITECT BEFORE PROCEEDING WITH THE WORK. THE CONTRACTOR SHALL BE RESPONSIBLE FOR AND SHALL RESOLVE AT NO COST TO THE OWNER AND TO THE SATISFACTION OF THE ARCHITECT, ANY AND ALL CONFLICTS BETWEEN THE WORK OF THE VARIOUS TRADES ARISING FROM ERRORS IN COORDINATION BETWEEN TRADES.
- THE CONTRACTOR SHALL NOT SCALE DRAWINGS.
- THE DRAWINGS AND SPECIFICATIONS, INCLUDING DRAWINGS PREPARED BY SPECIFIC ENGINEERING DISCIPLINES (SUCH AS CIVIL, STRUCTURAL, MECHANICAL, ELECTRICAL, ETC.) ARE COMPLEMENTARY; ITEMS SHOWN IN ANY ONE LOCATION IN THE DRAWINGS SHALL BE CONSIDERED TO BE REQUIREMENTS OF THE CONTRACT FOR CONSTRUCTION. IN THE EVENT OF AN INCONSISTENCY BETWEEN THE DRAWINGS AND SPECIFICATIONS, OR WITHIN EITHER DOCUMENT, THE CONTRACTOR SHALL SEEK CLARIFICATION OR INTERPRETATION FROM THE ARCHITECT PRIOR TO BIDDING. WHERE INCONSISTENCIES ARE NOT CLARIFIED PRIOR TO BIDDING, AND WHERE THE ACTUAL SOLUTION OR INTENT CANNOT BE REASONABLY INFERRED, THE CONTRACTOR SHALL PROVIDE THE BETTER QUALITY OR GREATER QUANTITY OF WORK.
- THE CONTRACTOR SHALL TAKE FIELD MEASUREMENTS AND VERIFY FIELD CONDITIONS AND SHALL CAREFULLY COMPARE SUCH FIELD MEASUREMENTS, CONDITIONS, AND OTHER INFORMATION KNOWN TO THE CONTRACTOR WITH THE CONTRACT DOCUMENTS BEFORE COMMENCING ACTIVITIES. ERRORS, INCONSISTENCIES, OR OMISSIONS DISCOVERED SHALL BE REPORTED TO THE ARCHITECT AT ONCE. NO ALLOWANCE WILL BE MADE ON BEHALF OF THE CONTRACTOR OR SUBCONTRACTORS FOR FAILURE TO VISIT THE SITE, USE OF THE WORD "VERIFY" POINTS OUT A SITUATION WHICH MUST BE CONFIRMED PRIOR TO PROCEEDING WITH THE WORK, FABRICATION OF EQUIPMENT, OR ORDERING MATERIAL. NOTIFY THE ARCHITECT OF ANY DISCREPANCY DISCOVERED.
- ALL SUB-SURFACES SHALL BE PROPERLY PREPARED BEFORE APPLICATION OF FINISHES. CONTRACTOR SHALL ASSUME RESPONSIBILITY FOR SUBSTRATE CONDITIONS WHERE FINISHES ARE APPLIED.
- BUILDING CONSTRUCTION INFILL OF WALLS, CEILINGS, ETC. SHALL MATCH EXISTING ADJACENT MATERIALS AND FINISHES UNLESS NOTED OTHERWISE. VOIDS WHERE EXISTING EQUIPMENT OR SYSTEMS WERE REMOVED SHALL BE INFILLED TO MATCH ADJACENT CONSTRUCTION, UNLESS NOTED OTHERWISE.
- BLOCKING SHALL BE PROVIDED IN WALLS WHERE MOUNTING ANCHORAGE WILL BE REQUIRED. LOCATIONS INCLUDE, BUT ARE NOT LIMITED TO, OPEN AND CLOSED SHELVING, CABINETRY, COUNTERTOPS, ACCESSORIES AND TRIM. ALL WOOD BLOCKING SHALL BE FIRE RETARDANT TREATED AS REQUIRED BY CODE AND FIRE STUFFED.
- PENETRATIONS OF PIPES, TUBES, CONDUIT, WIRES, CABLES, DUCTS, VENTS, CABINETS, LIGHTING, AND OTHER FIXTURES THROUGH FIRE RATED ASSEMBLIES SHALL BE INSTALLED AND PROTECTED TO MAINTAIN FIRE RATING.

applicable codes

- CONTRACTOR SHALL PROVIDE ADEQUATE PROTECTION FOR ALL FINISHED FLOOR SURFACES, EXISTING OR NEW INCLUDING BUT NOT LIMITED TO, CERAMIC TILE, VINYL TILE, CONCRETE, ETC., THROUGHOUT THE CONSTRUCTION PERIOD.
- ATTACHMENTS, CONNECTIONS OR FASTENINGS OF ANY NATURE ARE TO BE PROPERLY AND PERMANENTLY SECURED IN CONFORMANCE WITH BEST PRACTICE AND THE CONTRACTOR IS RESPONSIBLE FOR PROVIDING THEM ACCORDINGLY TO SPECIFIC CONDITIONS. THE DRAWINGS PROVIDED SHOW ONLY SPECIAL CONDITIONS TO ASSIST THE CONTRACTOR. THE DRAWINGS DO NOT ILLUSTRATE EVERY SUCH DETAIL.
- IF SPRINKLER SYSTEM WORK IS INCLUDED, THE WORK SHALL BE DESIGN/BUILD FOR THE SPRINKLER SYSTEM. CONTRACTORS ARE REQUIRED TO FINALIZE THE DESIGN OF THEIR RESPECTIVE SYSTEMS FOR FULL AND PROPER OPERATIONS ACCORDING TO THE APPLICABLE LAWS AND SPECIFICATIONS, IN ORDER TO SATISFY INTENDED FUNCTION AND DESIGN OF MECHANICAL AND ELECTRICAL DRAWINGS PROVIDED. PROVIDE AND INSTALL ALL SPRINKLER PIPING. THESE SYSTEMS SHALL FULLY OPERATE ACCORDING TO THE DESIGN, AND IN ACCORDANCE WITH THE APPLICABLE CODES. PROVIDE DESIGN LAYOUTS AND EQUIPMENT SUBMITTALS TO ARCHITECT AND OWNER FOR REVIEW BEFORE ORDERING OR INSTALLATION. SYSTEMS DESIGN DRAWINGS, MANUFACTURERS PRODUCT SHEETS AND SHOP DRAWINGS FOR ALL REQUIRED SYSTEMS AND PRODUCTS ARE TO BE PROVIDED FOR ARCHITECTS AND OWNER'S REVIEW. CONTRACTOR SHALL SUBMIT TO AUTHORITY HAVING JURISDICTION AS NECESSARY FOR APPLICABLE PERMITS.
- DRAWINGS ARE PREPARED USING DIMENSIONS AND PRODUCT CONFIGURATIONS OR DETAILS OF SPECIFIC MANUFACTURERS. DIMENSIONS AND DETAILS FOR SPECIFIC PRODUCTS MAY CHANGE DURING THE CONSTRUCTION PHASE. IT IS NECESSARY TO INCORPORATE INTO THE WORK ANY PRODUCTS BY OTHER MANUFACTURERS. ARE ALSO ACCEPTABLE. THEREFORE, ACTUAL INSTALLATION DETAILS AND DIMENSIONS MAY DIFFER FROM THOSE SHOWN. CONTRACTOR SHALL VERIFY INSTALLATION REQUIREMENTS FOR ALL PRODUCTS TO BE INCORPORATED IN THE WORK (INCLUDING THICKNESSES FOR RECESSED OR SEMI-RECESSED PRODUCTS), AND IS RESPONSIBLE FOR ACCOMMODATING AND COORDINATING CHANGES TO OTHER MATERIALS OR PRODUCTS THAT ARE NECESSARY BECAUSE OF THESE DIFFERENCES.
- THE CONTRACTOR SHALL CONTINUOUSLY CHECK ARCHITECTURAL AND STRUCTURAL CLEARANCES FOR ACCESSIBILITY OF EQUIPMENT, MECHANICAL AND ELECTRICAL SYSTEMS. NO ALLOWANCE OF ANY KIND WILL BE MADE FOR THE CONTRACTOR'S NEGLIGENCE TO FORESEE MEANS OF INSTALLING EQUIPMENT INTO POSITION INSIDE STRUCTURES.
- WITH REFERENCE TO CEILINGS, CONTRACTOR SHALL COORDINATE WITH ALL TRADES INVOLVED AND PREPARE COMPOSITE SHOP DRAWINGS TO ENSURE CLEARANCES FOR FIXTURES, CEILINGS, ETC. NECESSARY TO MAINTAIN THE SPECIFIED FINISH CEILING HEIGHT ABOVE THE FINISH FLOOR AS NOTED ON THE DRAWINGS. CLARIFY CONFLICTS WITH ARCHITECT.
- NO WORK DEFECTIVE IN CONSTRUCTION OR QUALITY OR DEFICIENT IN ANY REQUIREMENTS OF DRAWINGS AND SPECIFICATIONS WILL NOT BE ACCEPTABLE IN CONSEQUENCE OF OWNER'S OR ARCHITECT'S FAILURE TO DISCOVER OR TO POINT OUT DEFECTS OR DEFICIENCIES DURING CONSTRUCTION, NOR WILL PRESENCE OF INSPECTORS ON SITE RELIEVE CONTRACTOR FROM RESPONSIBILITY FOR SECURING QUALITY AND PROGRESS OF WORK AS REQUIRED BY CONTRACT. DEFECTIVE WORK REVEALED AFTER REQUIRED TIME GUARANTEES SHALL BE REPAIRED BY WORK CONFORMING WITH INTENT OF CONTRACT. NO PAYMENT, WHETHER PARTIAL OR FINAL, SHALL BE CONSTRUED AS AN ACCEPTANCE OF DEFECTIVE WORK OR IMPROPER MATERIALS.
- MATERIALS AND WORKMANSHIP SPECIFIED BY REFERENCE TO NUMBER SYMBOL, OR TITLE OF A SPECIFICATION SUCH AS COMMERCIAL STANDARDS, FEDERAL SPECIFICATIONS, TRADE ASSOCIATION STANDARD, OR OTHER SIMILAR STANDARD, SHALL COMPLY WITH REQUIREMENTS IN LATEST EDITION OR REVISION THEREOF AND WITH ANY AMENDMENT OR SUPPLEMENT THERETO IN EFFECT ON DATE OF ORIGIN OF THE PROJECT'S CONTRACT DOCUMENTS. SUCH REFERENCED STANDARD SHALL BECOME A PART OF THE CONTRACT DOCUMENTS AS THOUGH PRINTED HEREIN.
- CONTRACTOR SHALL WAIVE "COMMON PRACTICE" AND "COMMON USAGE" AS CONSTRUCTION CRITERIA WHEREVER DETAILS AND CONTRACT DOCUMENTS OR GOVERNING CODES, ORDINANCES, ETC. REQUIRE GREATER QUANTITY OR BETTER QUALITY THAN COMMON PRACTICE OR COMMON USAGE WOULD REQUIRE.
- CONTRACTOR SHALL ORDER AND SCHEDULE DELIVERY OF MATERIALS IN AMple TIME TO AVOID DELAYS IN CONSTRUCTION. IF AN ITEM IS FOUND TO BE UNAVAILABLE, CONTRACTOR SHALL NOTIFY THE ARCHITECT IMMEDIATELY TO ALLOW THE ARCHITECT A REASONABLE AMOUNT OF TIME TO SELECT A SUITABLE SUBSTITUTE.
- IF, AT ANY TIME BEFORE COMMENCEMENT OF WORK, OR DURING PROGRESS THEREOF, CONTRACTOR'S METHODS, EQUIPMENT OR APPLIANCES ARE INEFFICIENT OR INAPPROPRIATE FOR SECURING QUALITY OF WORK OR RATE OF PROGRESS INTENDED BY CONTRACT DOCUMENTS, OWNERS MAY ORDER CONTRACTOR TO IMPROVE THEIR QUALITY OR INCREASE THEIR EFFICIENCY. THIS WILL NOT RELIEVE CONTRACTOR OR HIS SURETIES FROM THEIR OBLIGATIONS TO SECURE QUALITY OF WORK AND RATE OR PROGRESS SPECIFIED IN CONTRACT.
- THE GENERAL CONTRACTOR SHALL PROVIDE ALL ACCESS PANELS (FIRE RATED AND SIZED AS REQUIRED), AT WALLS AND CEILINGS WHERE MECHANICAL, PLUMBING OR ELECTRICAL ACCESS IS NECESSARY PER CODE, OR AS REQUIRED FOR EQUIPMENT ACCESS AND MAINTENANCE. ARCHITECT TO APPROVE LOCATION AND SIZE OF ALL ACCESS PANELS NOT SHOWN ON DRAWINGS.

vicinity map

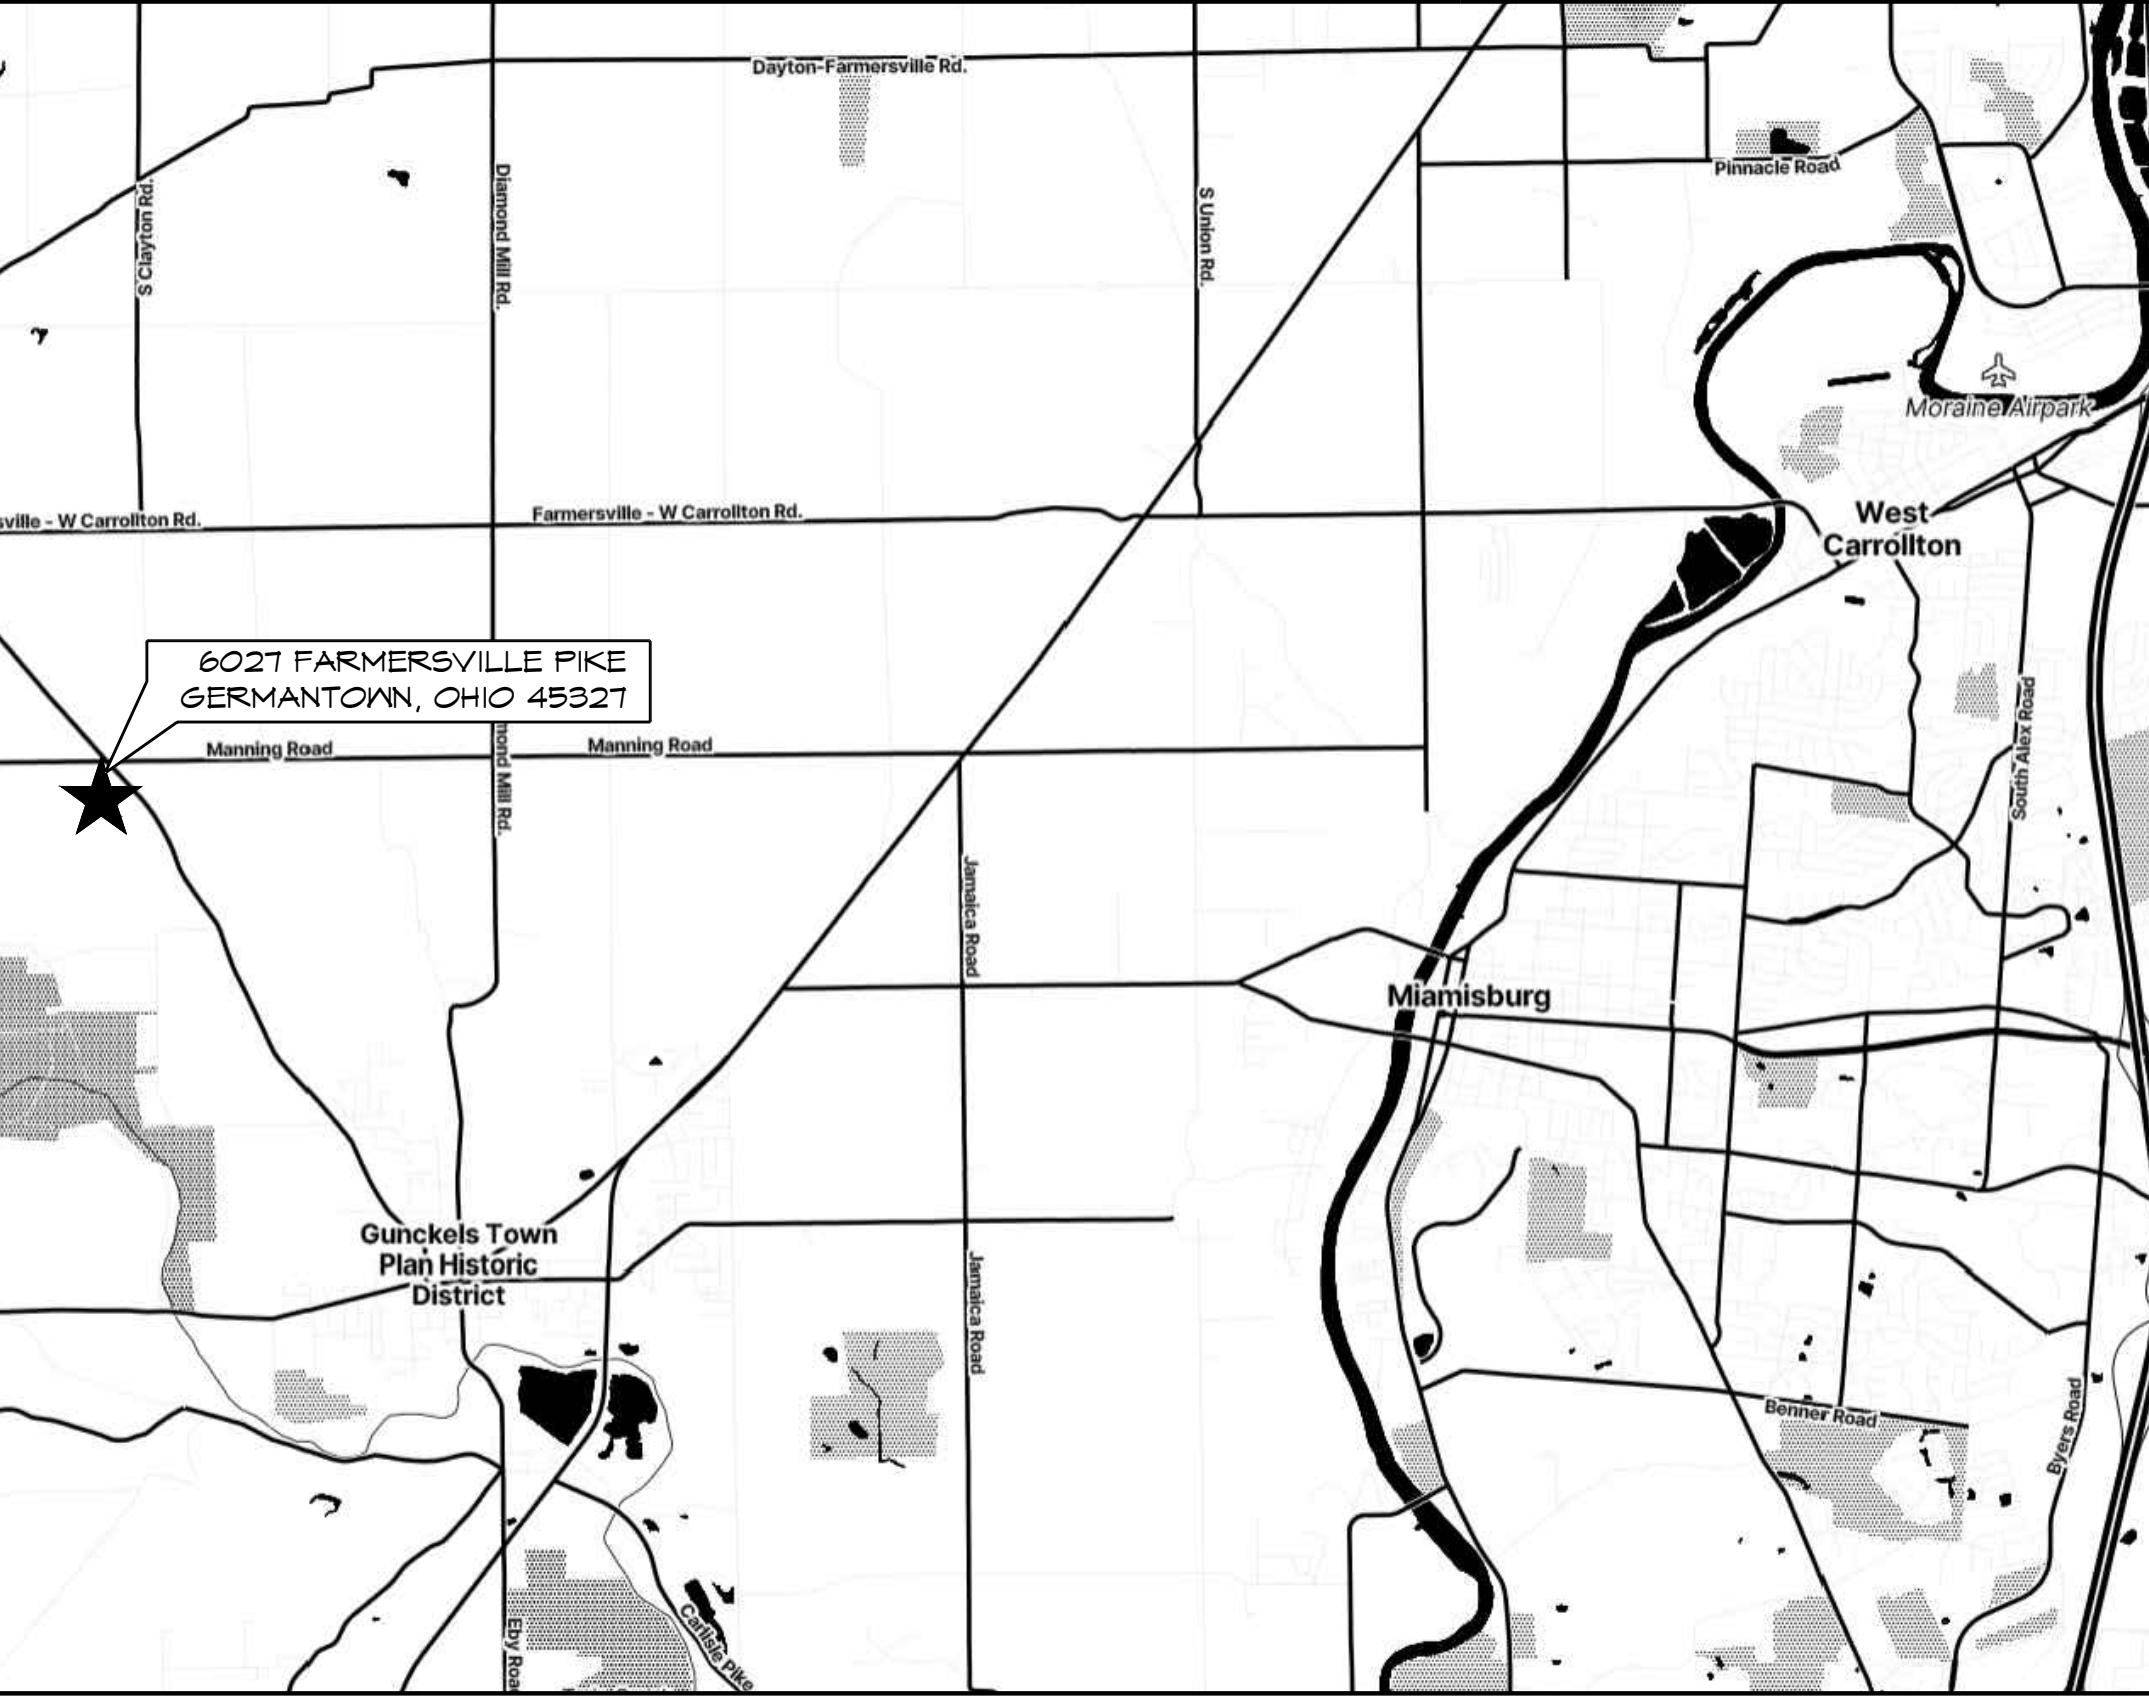

drawing index

GENERAL
T1.1 TITLE SHEET

ARCHITECTURAL
A1.1 FIRST FLOOR PLAN
A1.2 DEMO PLAN
A1.3 NEW WORK PLAN
A1.4 PROPOSED REFLECTED CEILING PLAN
A2.1 ENLARGED PLANS, INTERIOR ELEVATIONS
A2.2 INTERIOR ELEVATIONS
A3.1 DOOR SCHEDULE, FINISH SCHEDULE

PLUMBING
P0.1 PLUMBING GENERAL NOTES AND LEGENDS
P0.2 PLUMBING SPECIFICATIONS
P1.1 PLUMBING DEMOLITION PLAN
P2.1 PLUMBING NEW WORK PLAN
P6.1 PLUMBING SCHEDULES

MECHANICAL
M0.1 MECHANICAL GENERAL NOTES AND LEGENDS
M0.2 MECHANICAL SPECIFICATIONS
M1.1 MECHANICAL DEMOLITION PLAN
M2.1 MECHANICAL NEW WORK PLAN
M5.1 MECHANICAL SCHEDULES
M5.2 MECHANICAL DETAILS


ELECTRICAL
E0.1 ELECTRICAL NOTES, LEGEND, AND SPECS
E1.1 ELECTRICAL DEMOLITION PLAN
E2.1 LIGHTING NEW WORK PLAN
E2.2 POWER NEW WORK PLAN
E5.1 ELECTRICAL DETAILS, EQUIPMENT SCHEDULES
E6.1 PANEL SCHEDULES AND SINGLE-LINE DIAGRAM

accessibility requirements

CODE: 2017 ICC A117.1
ALL PRODUCTS, MATERIALS AND INSTALLATIONS SHALL MEET ADA REQUIREMENTS FOR ACCESSIBILITY IN ACCORDANCE WITH ANSI A117.1. ALL PUBLIC ACCOMMODATIONS SHALL COMPLY WITH ICC A117.1-2017.

CONTRACTOR SHALL VERIFY THAT PRODUCTS PROVIDED ARE IN FULL COMPLIANCE WITH THE REQUIREMENTS FOR THE PRODUCT AND THE INSTALLATION.

aerial photo

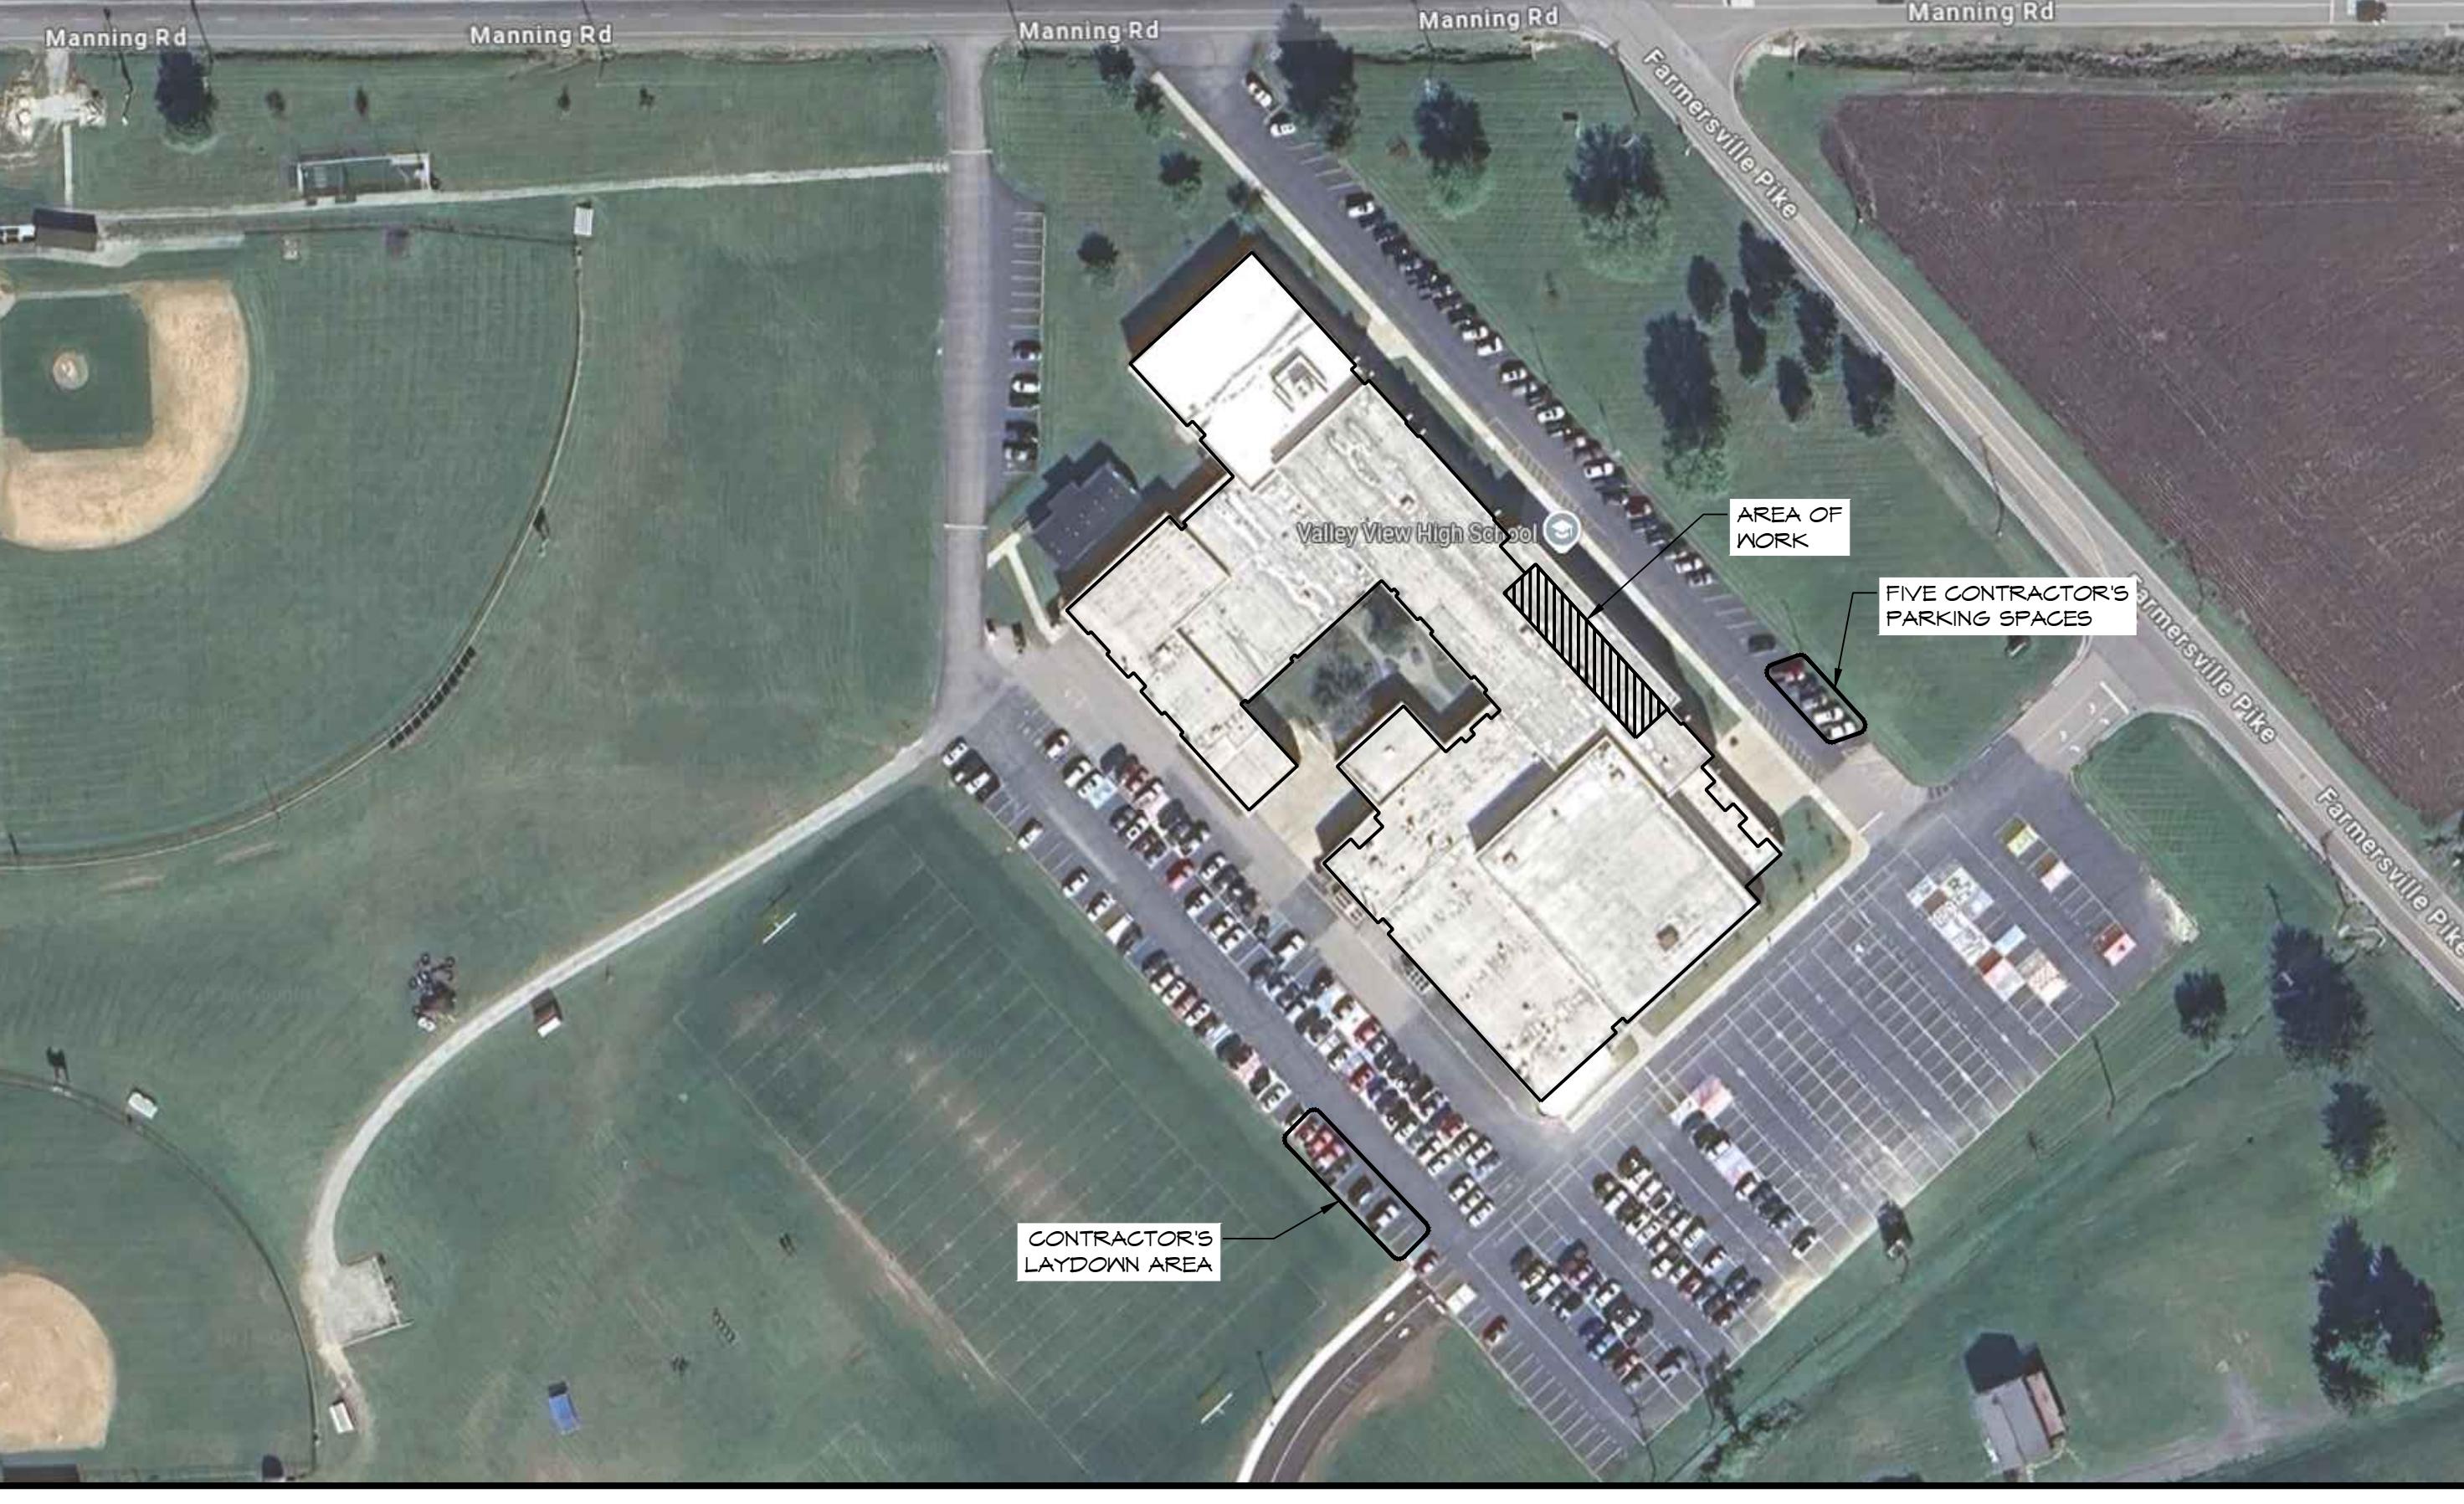

abbreviations

AFF	ABOVE FINISH FLOOR
ATC	ACOUSTICAL TILE CEILING
BULK	BULKING
BLG	BEARING
CI	CAST IRON
CIP	CAST IN PLACE
CIR	CIRCUIT
CL	CENTERLINE
CLG	CEILING
CMU	CONCRETE MASONRY UNIT
CONC	CONCRETE
CPT	CARPET
CT	CERAMIC TILE
DF	DRINKING FOUNTAIN
DIA	DIAMETER
FDN	FOUNDATION
FIN	FINISH
FF	FINISH FLOOR
FTG	FOOTING
GA	GAUGE
GB	GYPSUM BOARD
HM	HOLLOW METAL
MO	MASONRY OPENING
MTD	MOUNTED
NIC	NOT IN CONTRACT
OC	ON CENTER
PL, LAM.	PLASTIC LAMINATE
PA	PAINT
RO	ROUGH OPENING
SM	SHEET METAL
SPM	SINGLE PLY MEMBRANE
TYP	TYPICAL
UNO	UNLESS NOTED OTHERWISE


renovation for:
valley view local schools
6027 farmersville pike
germantown, ohio 45327

title sheet

project number
251431
date
1/23/2026
drawn by
RMT
checked by
KDZ

sheet

T1.1

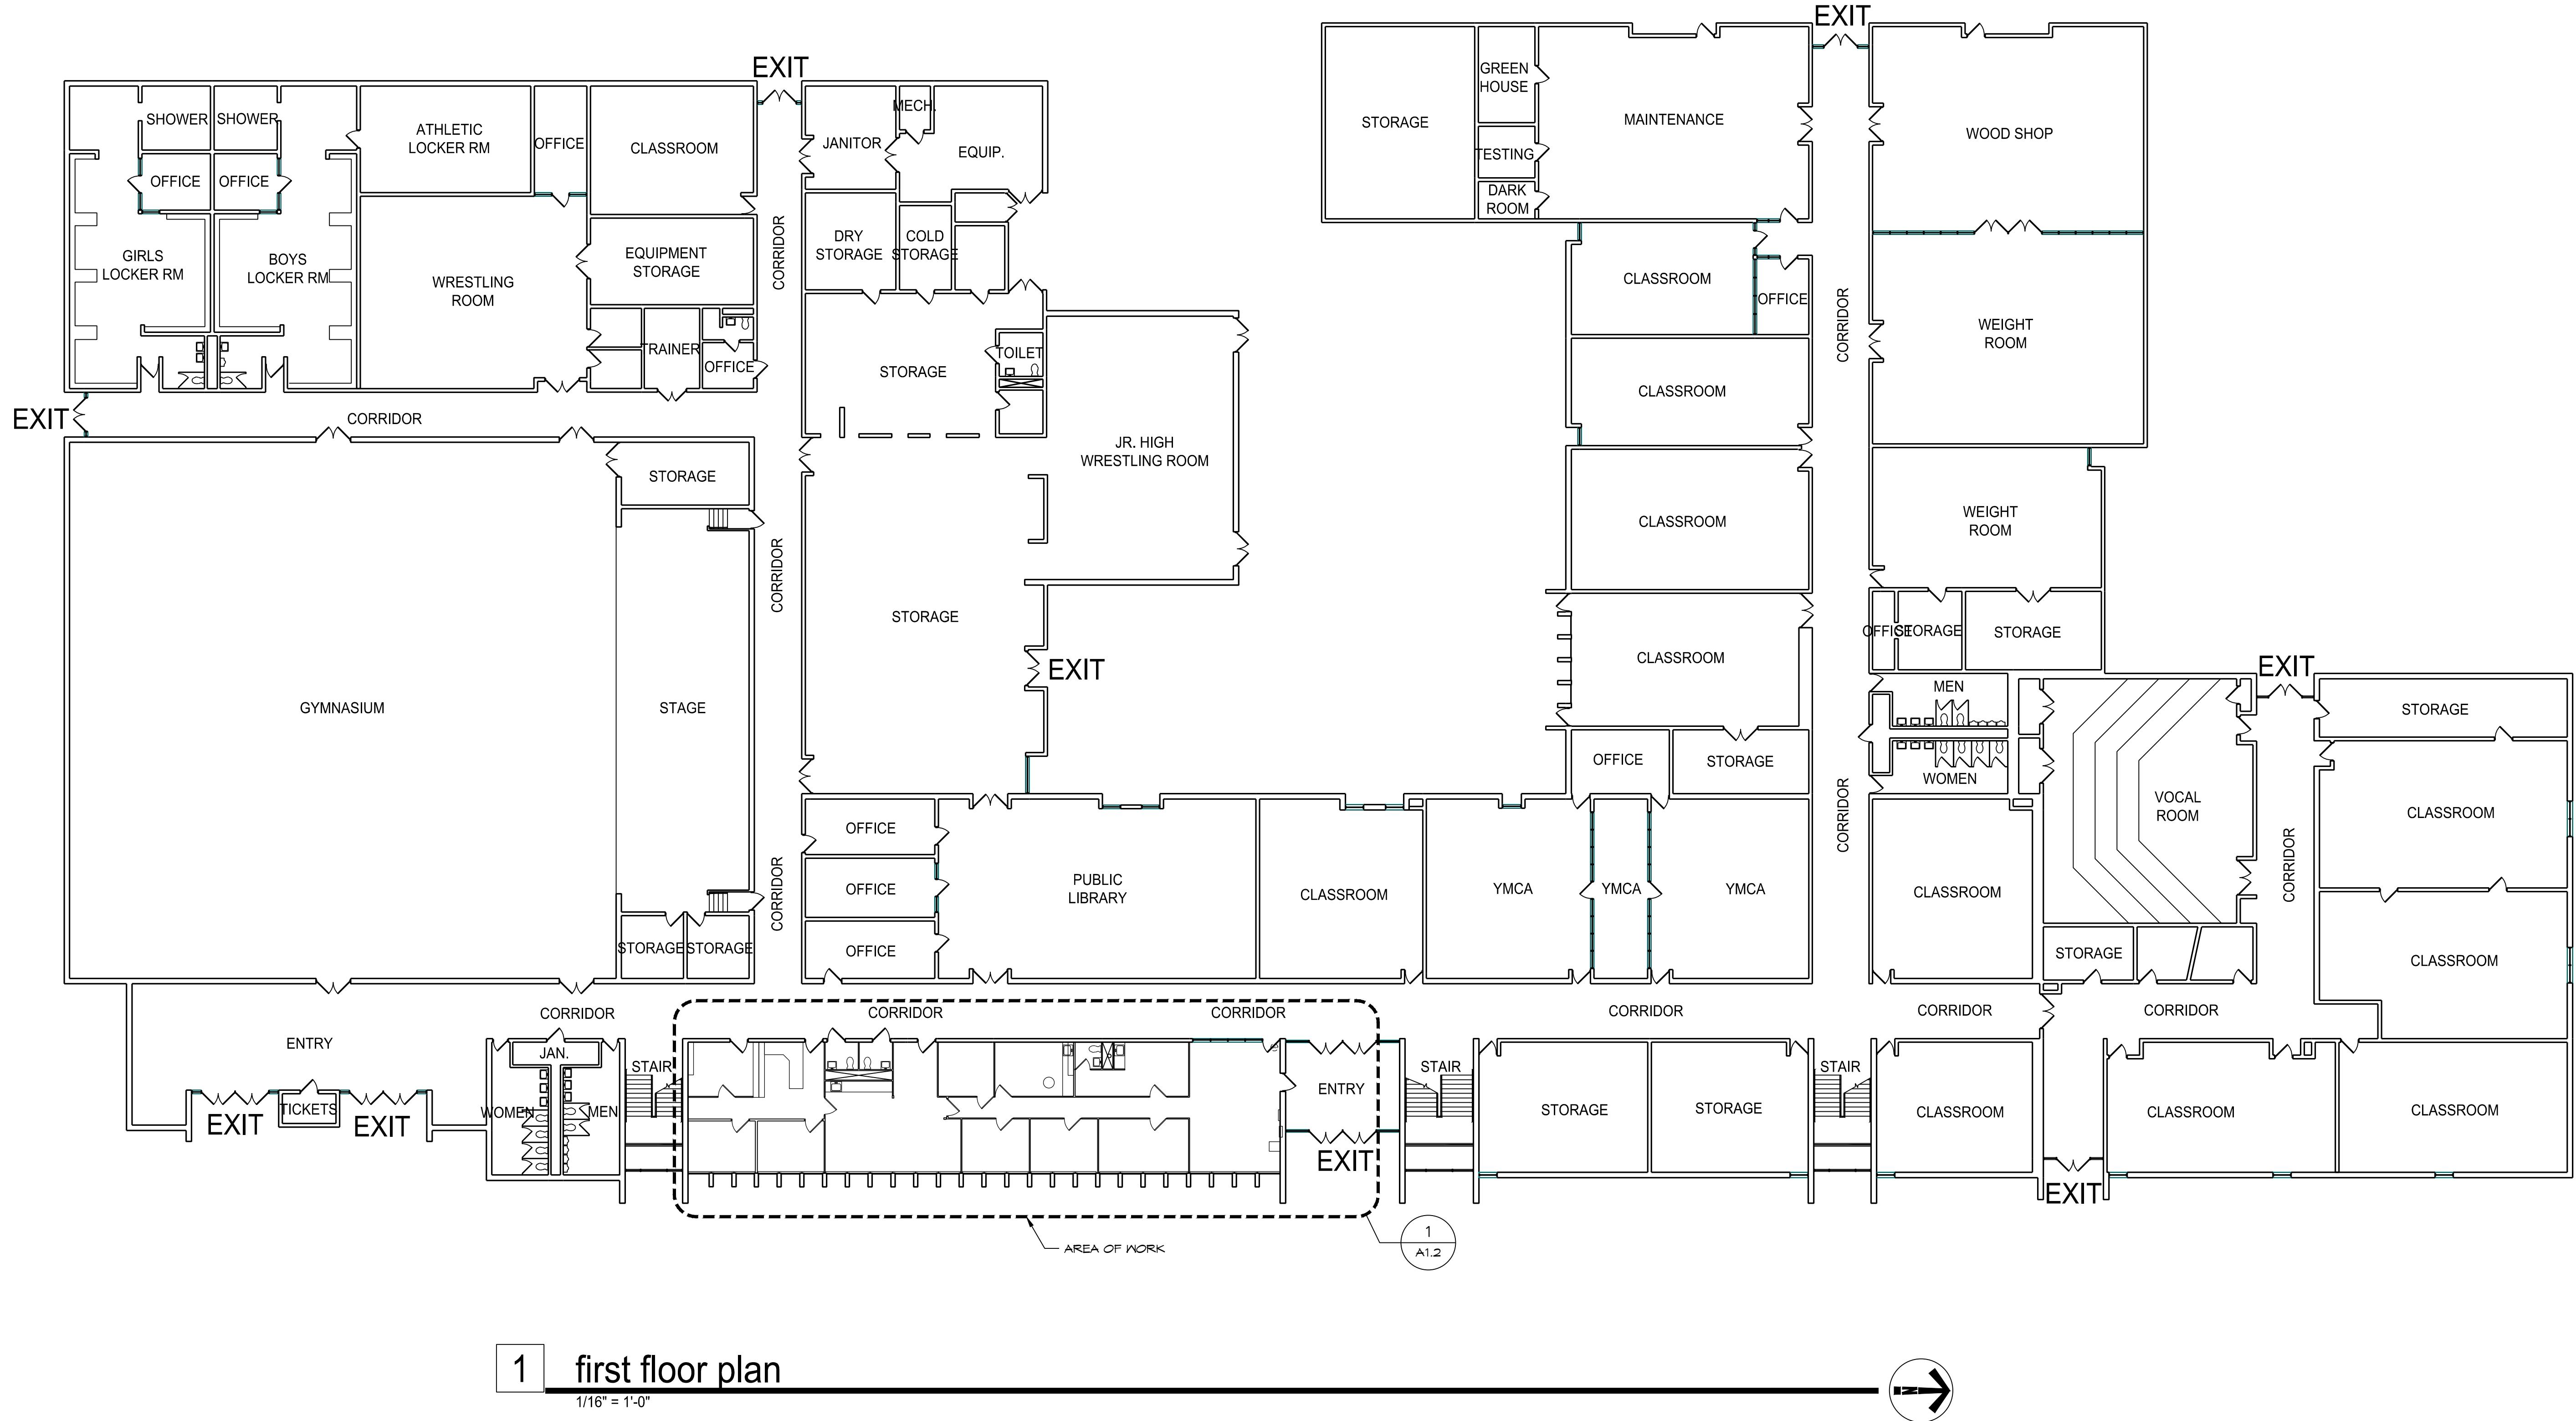


The logo for Oregon Group Architects is a large, stylized graphic. It features a thick, black-outlined circle on the left, which is partially cut through by a thick, black-outlined letter 'G'. To the right of this graphic, the word 'OREGON' is written in a bold, sans-serif font, with each letter stacked on top of the other. To the right of 'OREGON', the word 'GROUP' is written in a smaller, bold, sans-serif font, with each letter stacked on top of the other. To the right of 'GROUP', the word 'ARCHITECTS' is written in a bold, sans-serif font, with each letter stacked on top of the other. Below 'ARCHITECTS', the words 'INTERIORS CODE CONSULTANTS' are written in a smaller, bold, sans-serif font, with each word stacked on top of the other.

valley view local schools
6027 farmersville pike
germantown, ohio 45327

project number
251431
date
1/23/2026
drawn by
RMT
checked by
KDZ


sheet

À 1.1

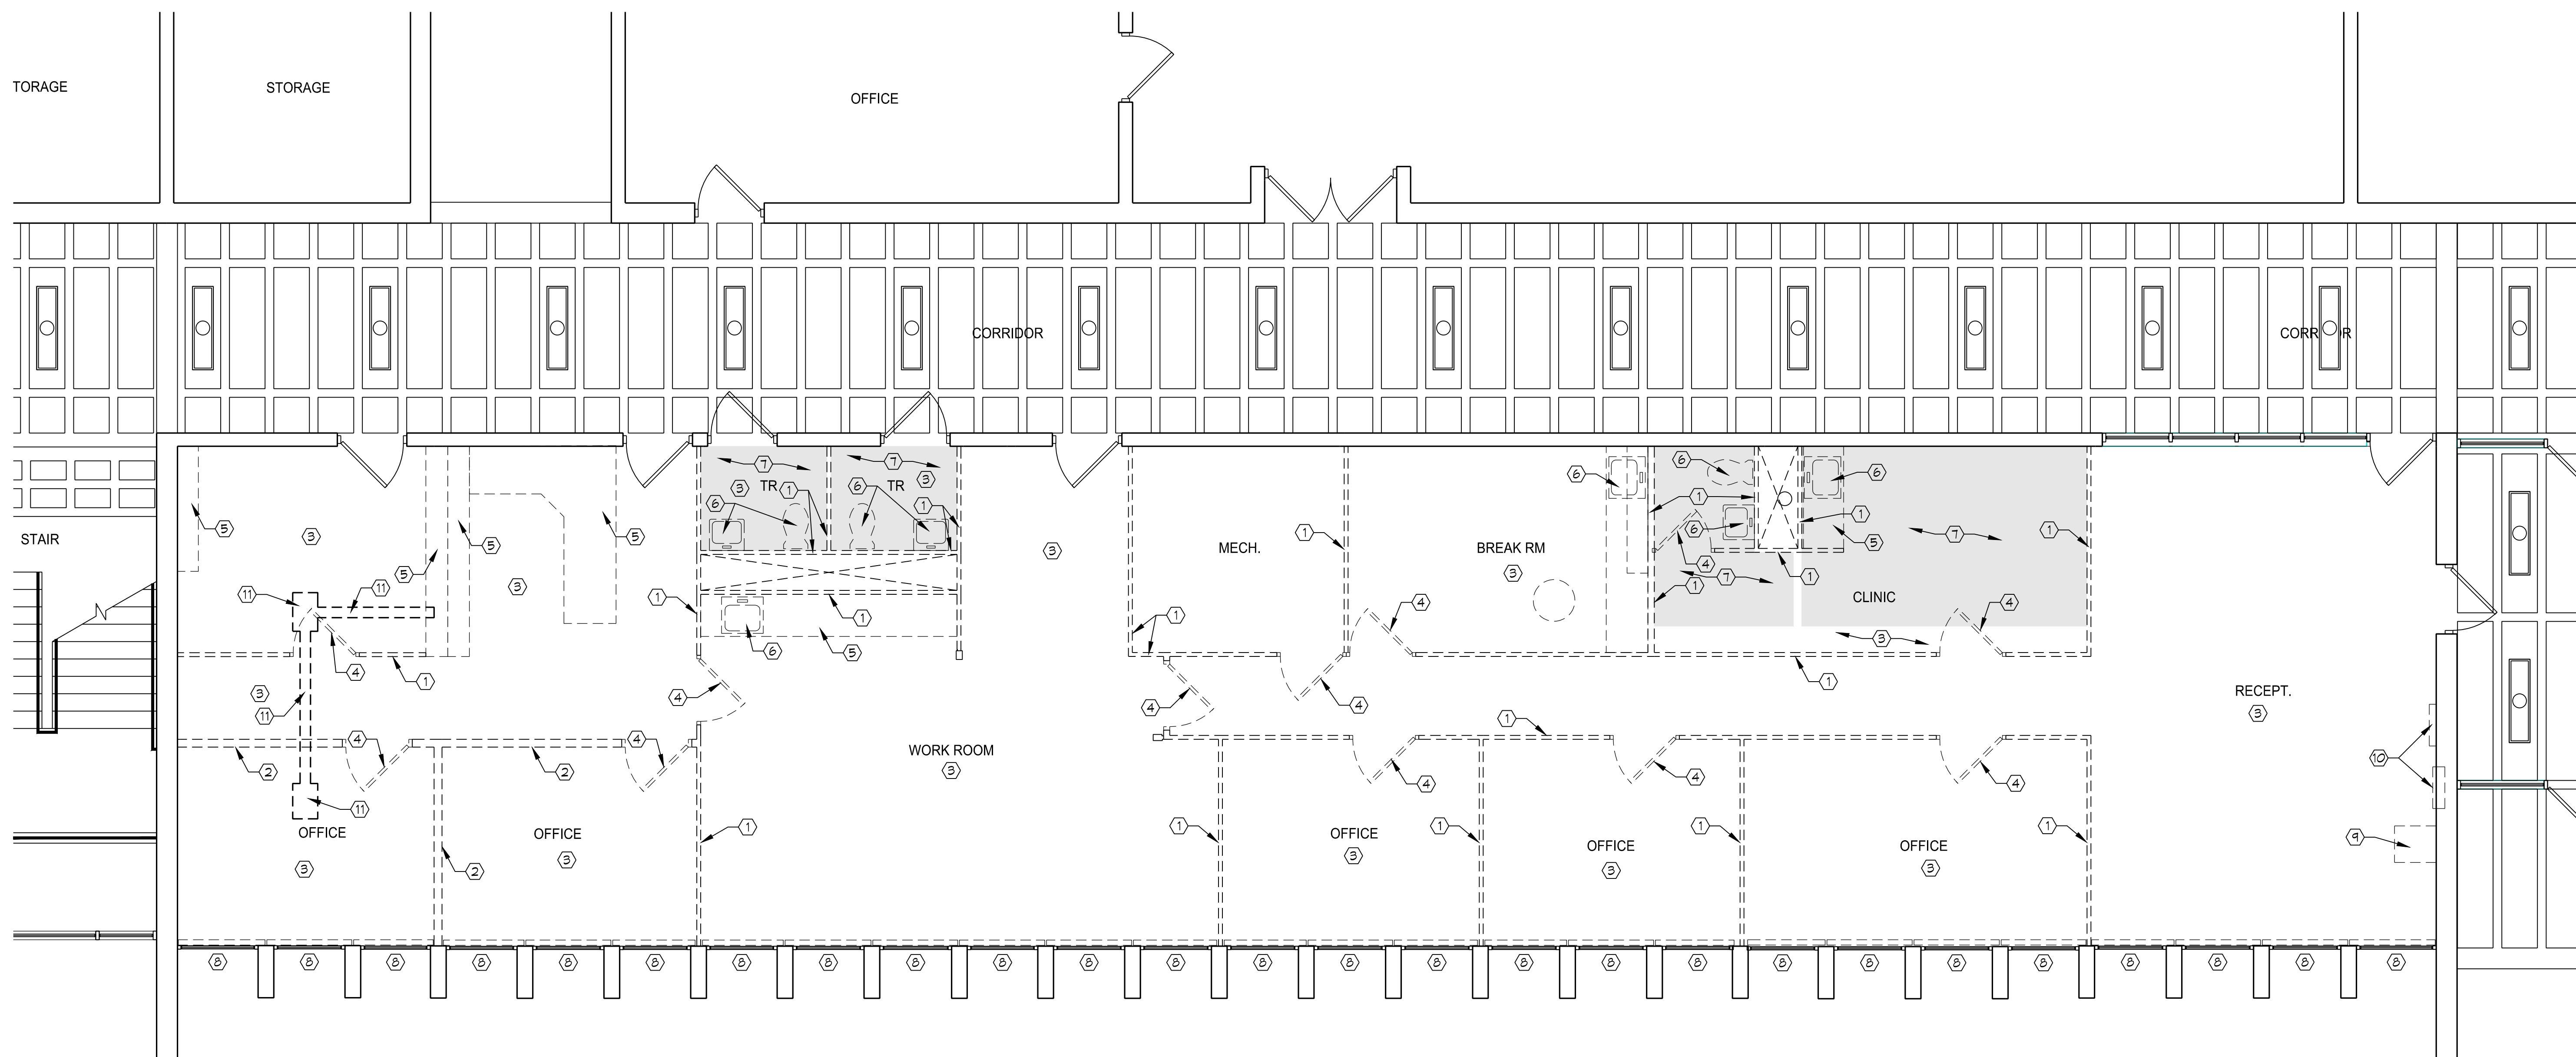

1 demo floor plan

1/4" = 1'-0"

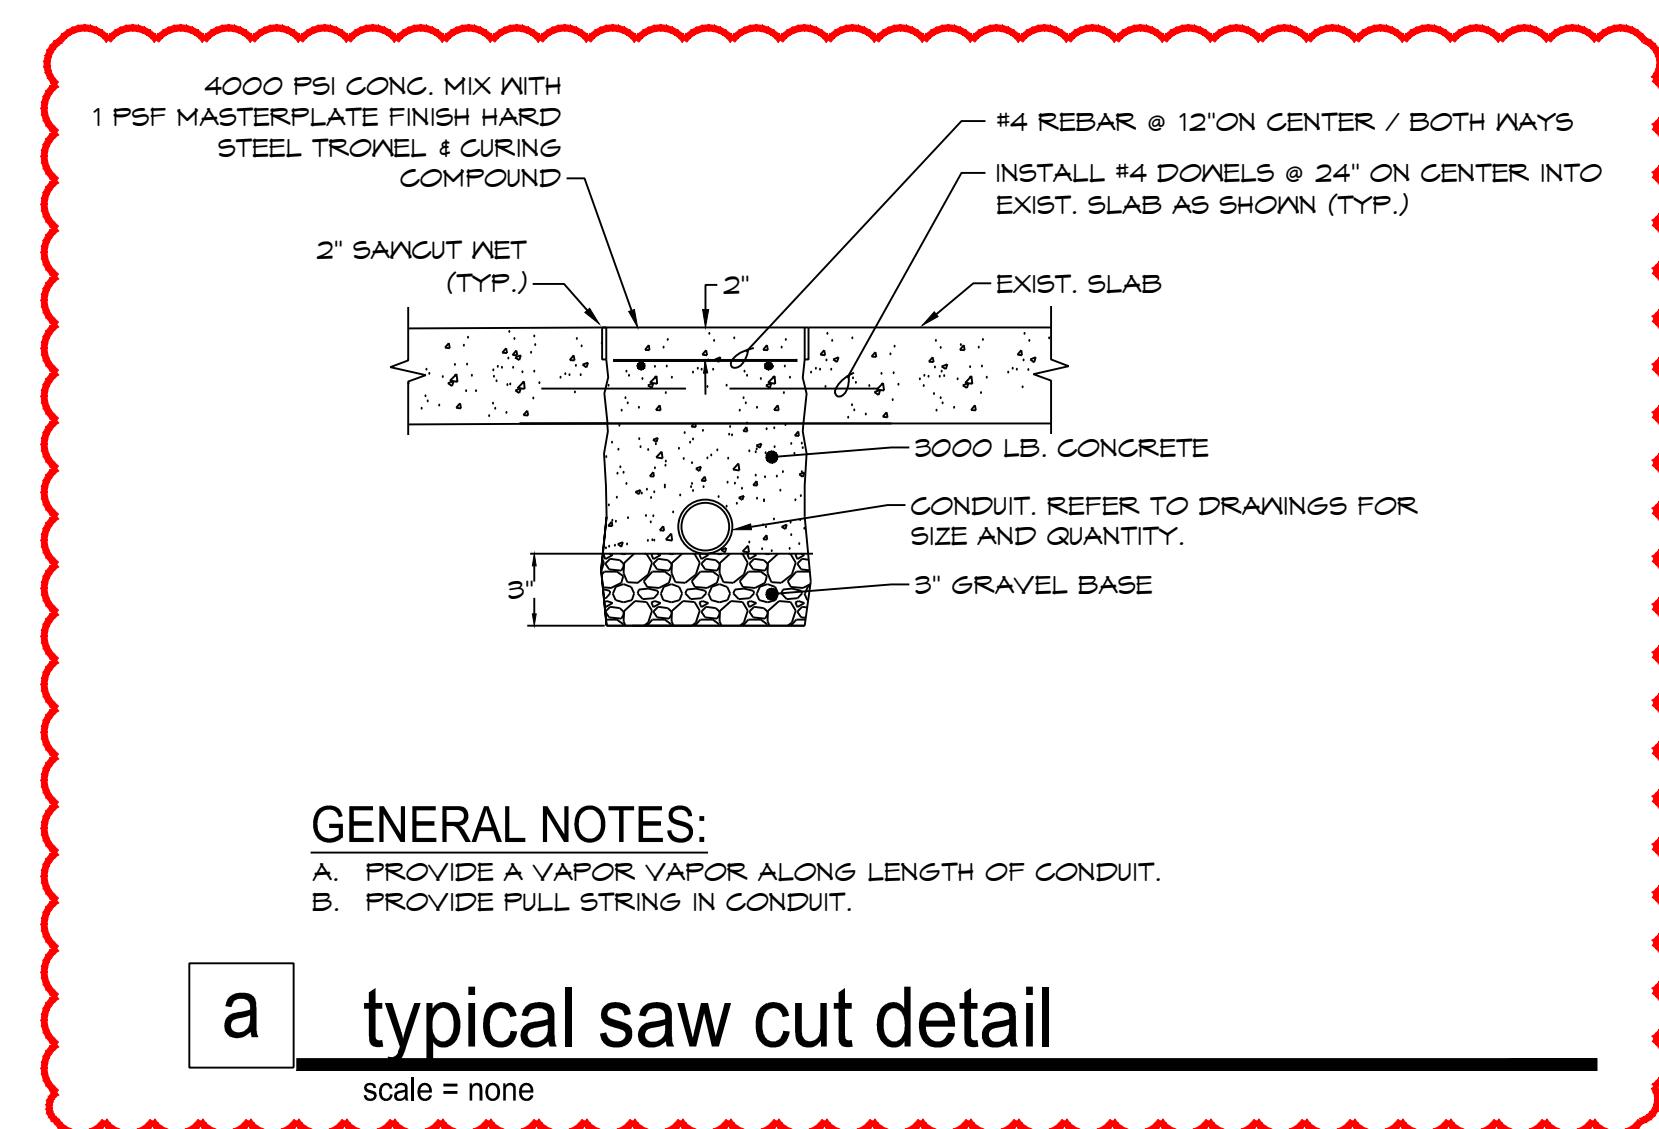

GENERAL NOTES:

- PROVIDE A VAPOR VAPOR ALONG LENGTH OF CONDUIT.
- PROVIDE FULL STRING IN CONDUIT.

a typical saw cut detail

scale = none

④ demo notes

1. REMOVE EXISTING MODULAR WALLS COMPLETE.
2. REMOVE EXISTING STUD AND DRYWALL PARTITION COMPLETE.
3. REMOVE EXISTING FLOORING AND WALL BASE ENTIRE WORK AREAS.
4. REMOVE EXISTING DOOR AND FRAME COMPLETE.
5. REMOVE EXISTING CASEWORK AND ASSOCIATED ACCESSORIES.
6. REMOVE EXISTING PLUMBING FIXTURE, REFERENCE PLUMBING DRAWINGS.
7. EXISTING RESINOUS FLOORING IN SHADED AREA SHALL REMAIN.
8. REMOVE EXISTING WINDOW COVERING AND EXPOSED BLOCKING.
9. REMOVE EXISTING PA SYSTEM, COIL EXISTING CABLING ABOVE CEILING, TURN PA SYSTEM OVER TO OWNER, REFERENCE ELECTRICAL DRAWINGS.
10. REMOVE EXISTING EQUIPMENT CABINET, REFERENCE ELECTRICAL DRAWINGS.
11. SAW-CUT EXISTING CONCRETE SLAB AS REQUIRED FOR NEA FLOOR ELECTRICAL BOXES AND CONDUIT. REFERENCE ELECTRICAL DRAWINGS.

issued	
BID DOCUMENTS	
revised	
1/29/2026	CODE COMMENT REV.

STATE OF OHIO
 REGISTERED ARCHITECT
 KYLE D. ZEPERNICK
 No. 10884
 Kyle Zepernick, Licence #10884
 Expiration Date 12-31-2027

THESE DRAWINGS AND SPECIFICATIONS, THE DESIGNS DESCRIBED THEREIN, AND THE SERVICES REPRESENTED THEREBY ARE THE EXCLUSIVE PROPERTY OF THE CROZEN GROUP ARCHITECTS, INC. NO PART OF THESE DRAWINGS OR DESIGNS MAY BE REPRODUCED IN WHOLE OR IN PART, OR DISCLOSED TO ANY PERSON, FIRM, OR CORPORATION, EXCEPT AS AUTHORIZED IN THE CONTRACTS, AGREEMENTS, OR WRITTEN REQUESTS AND ARE NOT TO BE REPRODUCED IN WHOLE OR IN PART, OR DISCLOSED TO ANY PERSON, FIRM, OR CORPORATION, EXCEPT AS AUTHORIZED IN THE CONTRACTS, AGREEMENTS, OR WRITTEN REQUESTS, UNLESS THE CROZEN GROUP ARCHITECTS, INC. CONSENTS IN WRITING. THE CROZEN GROUP ARCHITECTS, INC. 2020.




O REGON GROUP ARCHITECTS
 ARCHITECTURE INTEGRITY HOUSE
 THE PARSONAGE HOUSE
 310 S. PATTERSON BLVD. DAYTON, OHIO 45402
 937-226-1511 F 937-226-5663

renovation for:
 valley view local schools
 6027 farmersville pike
 germantown, ohio 45327
 demo plan


project number
 251431
 date
 1/23/2026
 drawn by
 ####
 checked by
 ####

sheet


A1.2

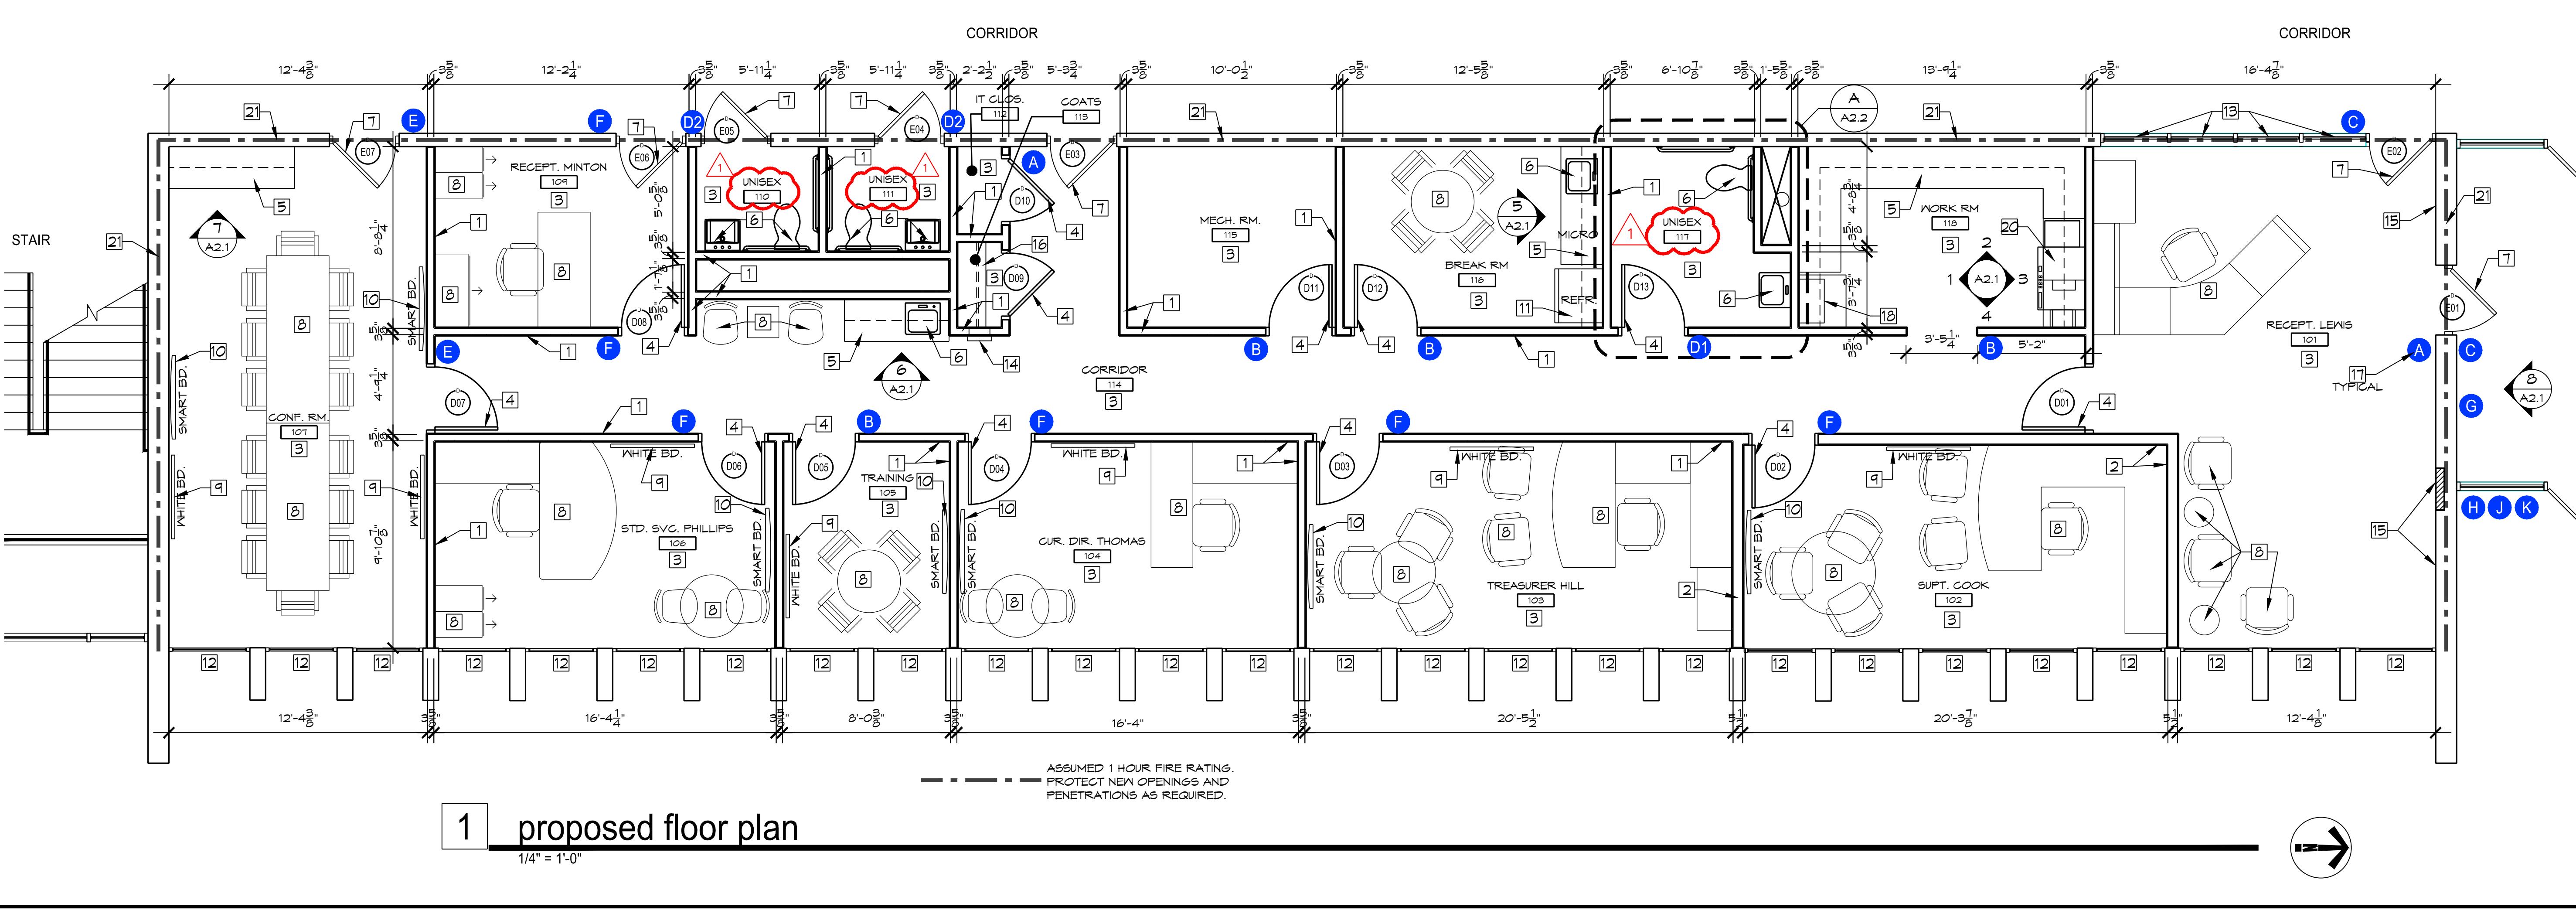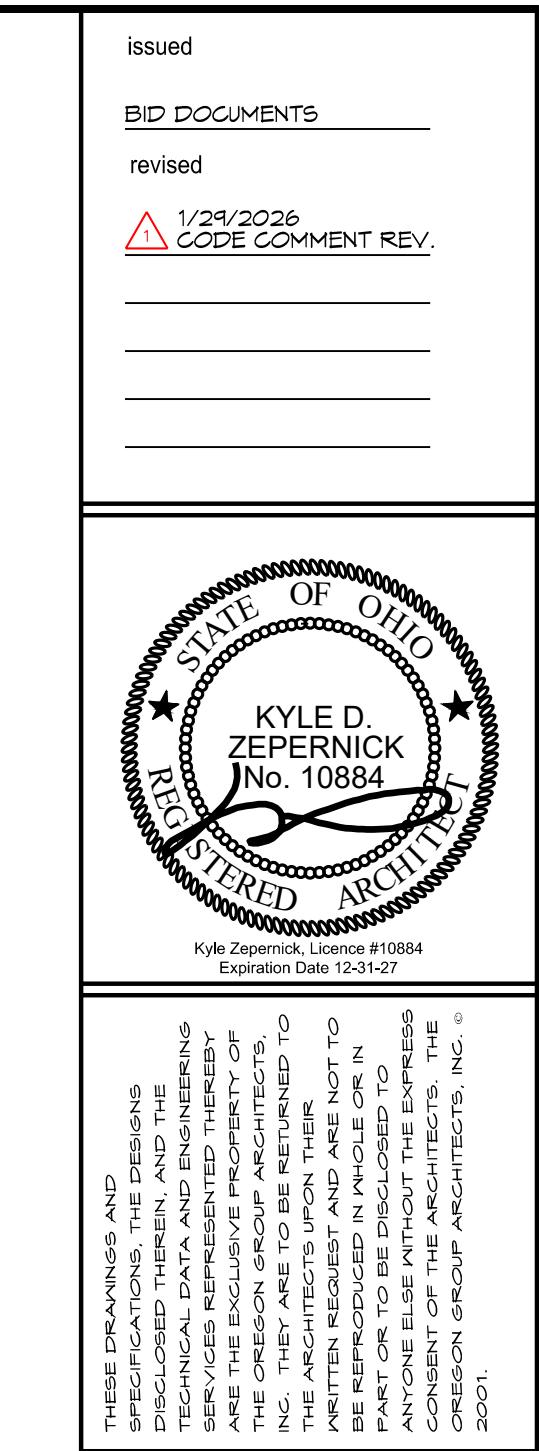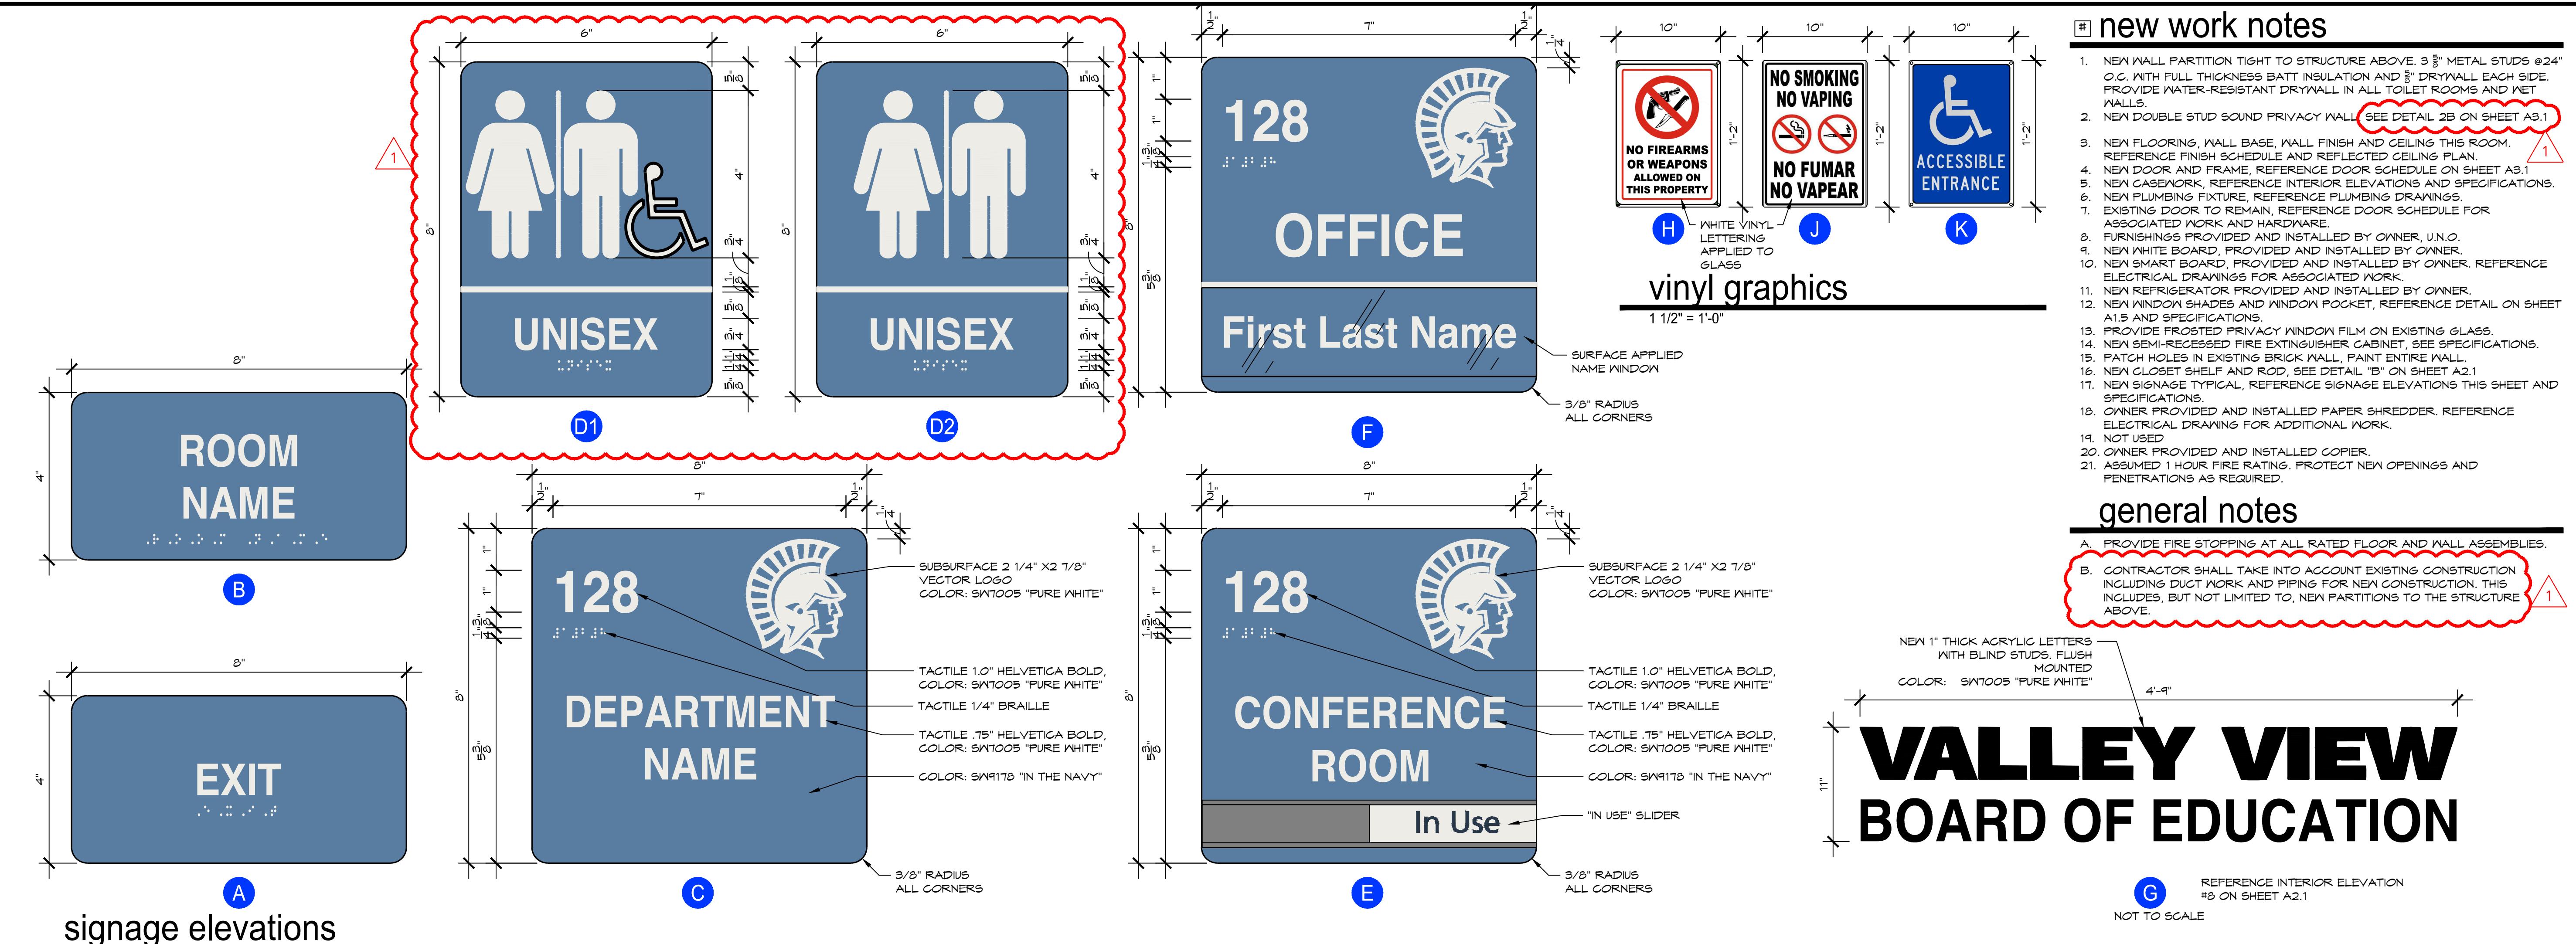

A1.3

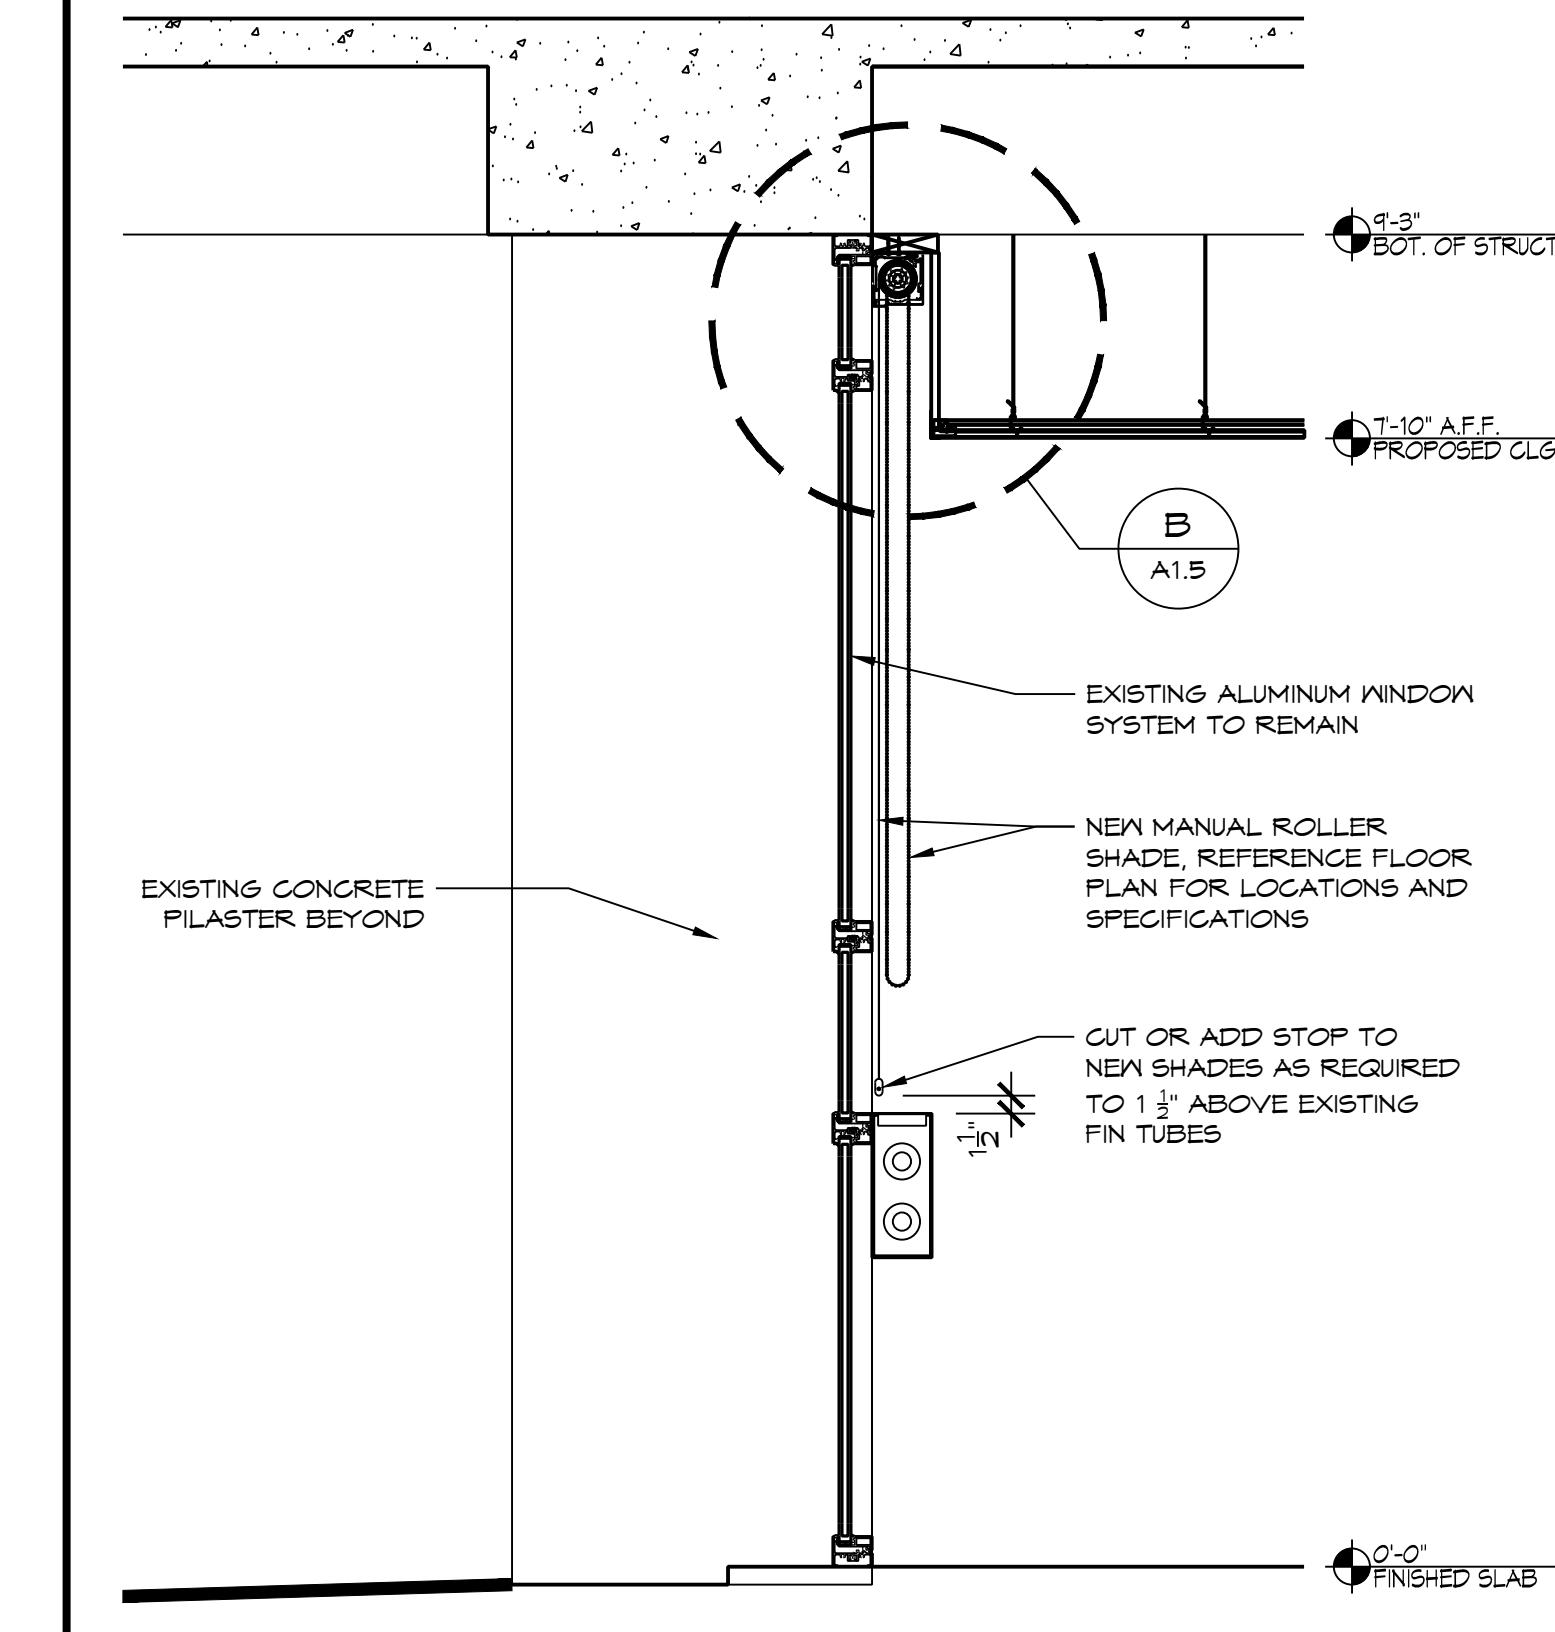

a section

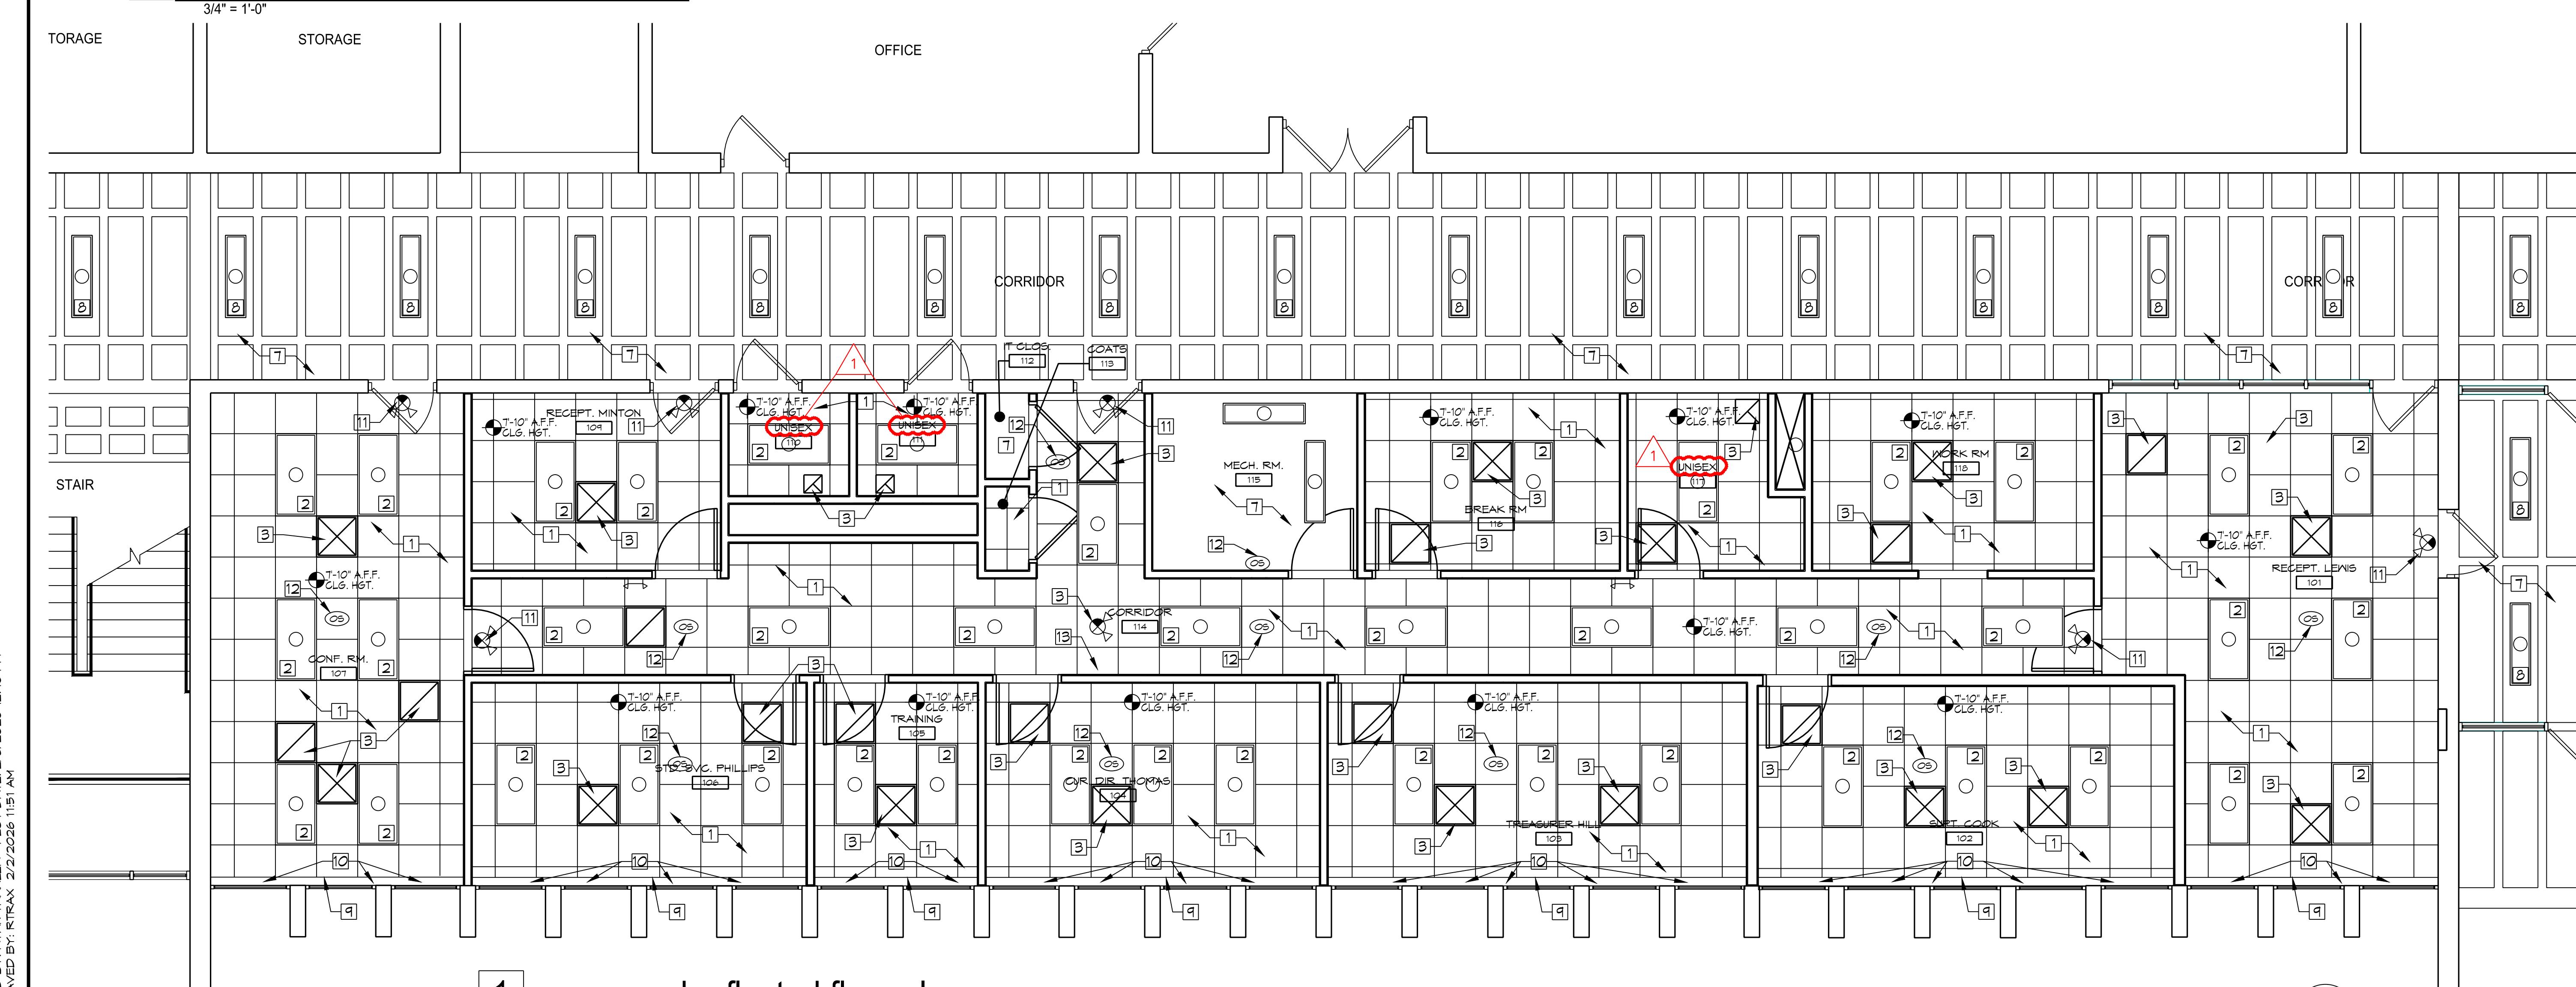

1 proposed reflected floor plan

1/4" = 1'-0"

ceiling new work notes

1. NEW 2X2 CEILING GRID, TILE, HANGERS AND ACCESSORIES, REFERENCE SPECIFICATIONS.
2. NEW LIGHT FIXTURE, REFERENCE ELECTRICAL DRAWINGS
3. NEW MECHANICAL DEVICE, REFERENCE MECHANICAL DRAWINGS.
4. NEW FIRE ALARM DEVICE, REFERENCE ELECTRICAL DRAWINGS.
5. REINSTALL EXISTING WIRELESS ACCESS POINT, REFERENCE ELECTRICAL DRAWINGS.
6. REINSTALL EXISTING CAMERA, REFERENCE ELECTRICAL DRAWINGS.
7. EXISTING EXPOSED STRUCTURE TO REMAIN.
8. EXISTING LIGHT FIXTURE TO REMAIN.
9. NEW WINDOW POCKET, SEE DETAIL "A" THIS SHEET.
10. NEW WINDOW SHADES, REFERENCE SPECIFICATIONS AND DETAIL "A" THIS SHEET.
11. NEW EXIT SIGN, REFERENCE ELECTRICAL DRAWINGS.
12. NEW OCCUPANCY SENSOR, REFERENCE ELECTRICAL DRAWINGS.
13. NEW EMERGENCY LIGHT FIXTURE, REFERENCE ELECTRICAL DRAWINGS.

issued
BID DOCUMENTS
revised
1/29/2026
CODE COMMENT REV.
STATE OF OHIO
KYLE D. ZEPERNICK
No. 10884
Kyle Zepernick, Licence #10884
Expiration Date 10/31/2027
THESE DRAWINGS AND SPECIFICATIONS, AND THE SERVICES THEREIN, ARE THE EXCLUSIVE PROPERTY OF THE OREGON GROUP ARCHITECTS, INC. THE DRAWINGS AND SPECIFICATIONS UPON WHICH THESE DRAWINGS ARE BASED, ARE NOT TO BE REPRODUCED IN WHOLE OR IN PART, OR DISCLOSED TO ANYONE, EXCEPT AS CONSENTED TO BY THE OREGON GROUP ARCHITECTS, INC. THE OREGON GROUP ARCHITECTS, INC. IS THE EXCLUSIVE CONTRACTOR UPON WHICH THESE DRAWINGS ARE BASED, AND THE DRAWINGS ARE NOT TO BE REPRODUCED IN WHOLE OR IN PART, OR DISCLOSED TO ANYONE, EXCEPT AS CONSENTED TO BY THE OREGON GROUP ARCHITECTS, INC. THE OREGON GROUP ARCHITECTS, INC. © 2020.


OREGON GROUP ARCHITECTS
ARCHITECTURE INTERIORS CONSULTANTS
THE PARSONAGE HOUSE
310 S. PATTERSON BLVD. DAYTON, OHIO 45402
937-226-1511 F 937-226-3663


renovation for:
valley view local schools
6027 farmersville pike
germantown, ohio 45327
proposed reflected ceiling

project number
251431
date
1/23/2026
drawn by
RMT
checked by
KDZ


sheet

A1.5

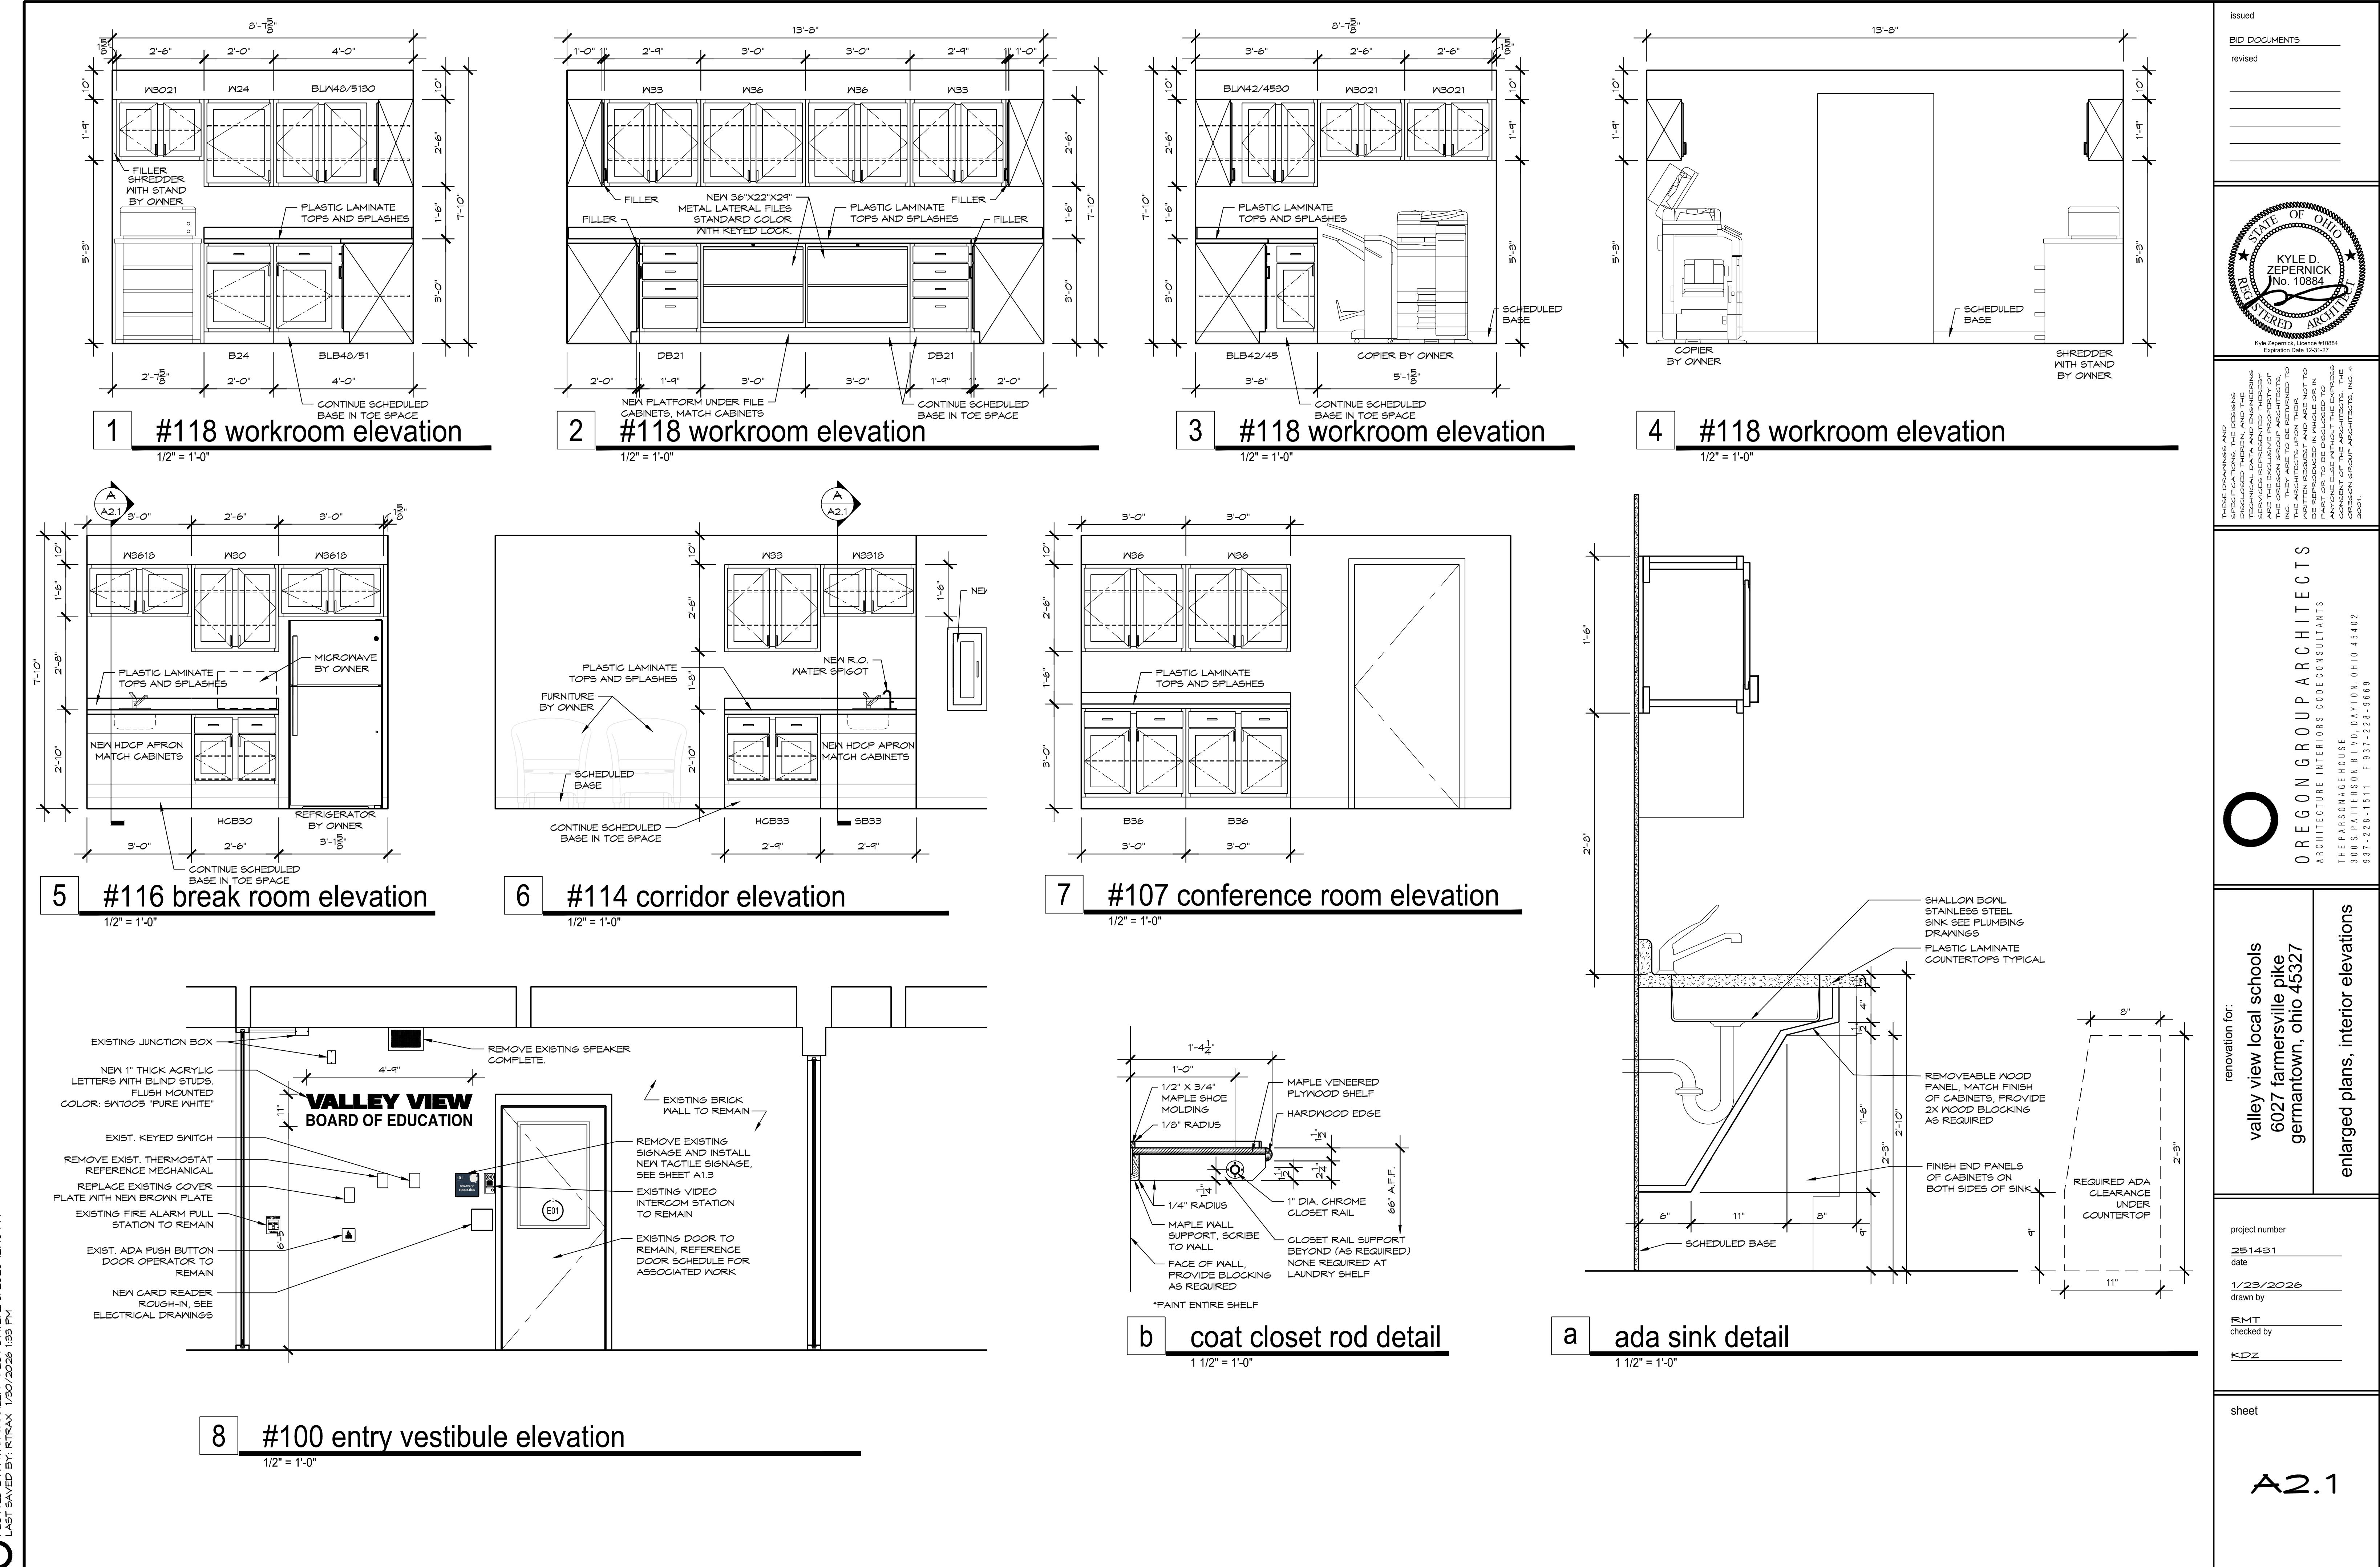


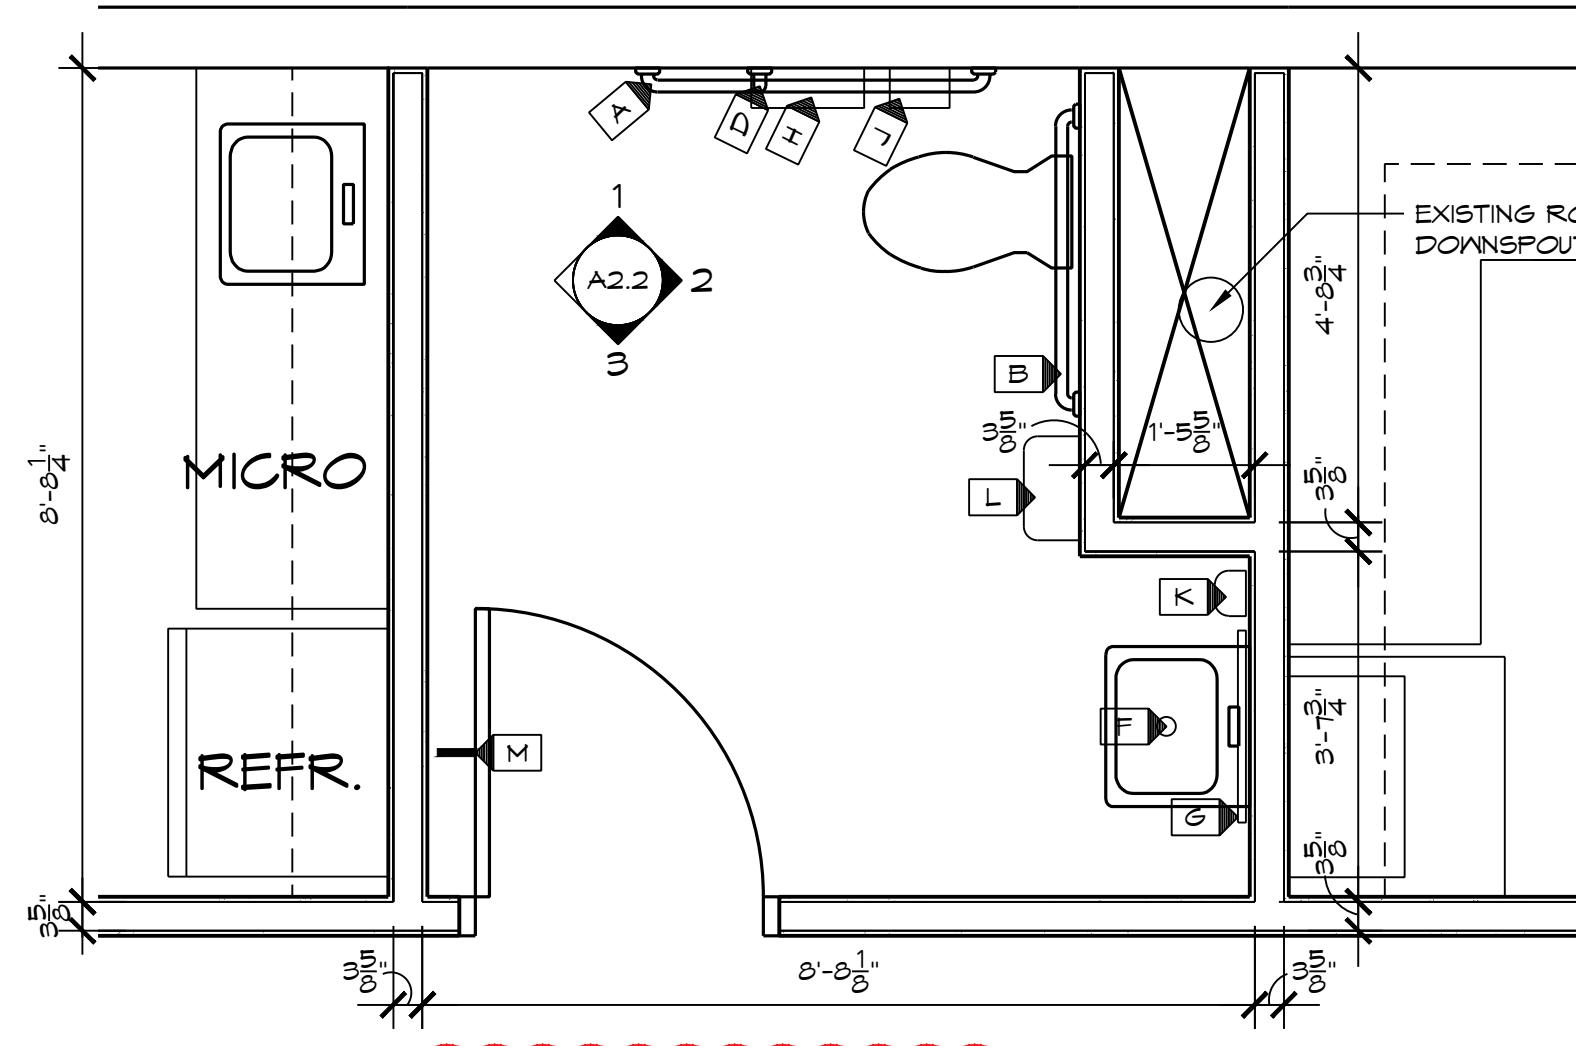


a #117 unisex plan 1

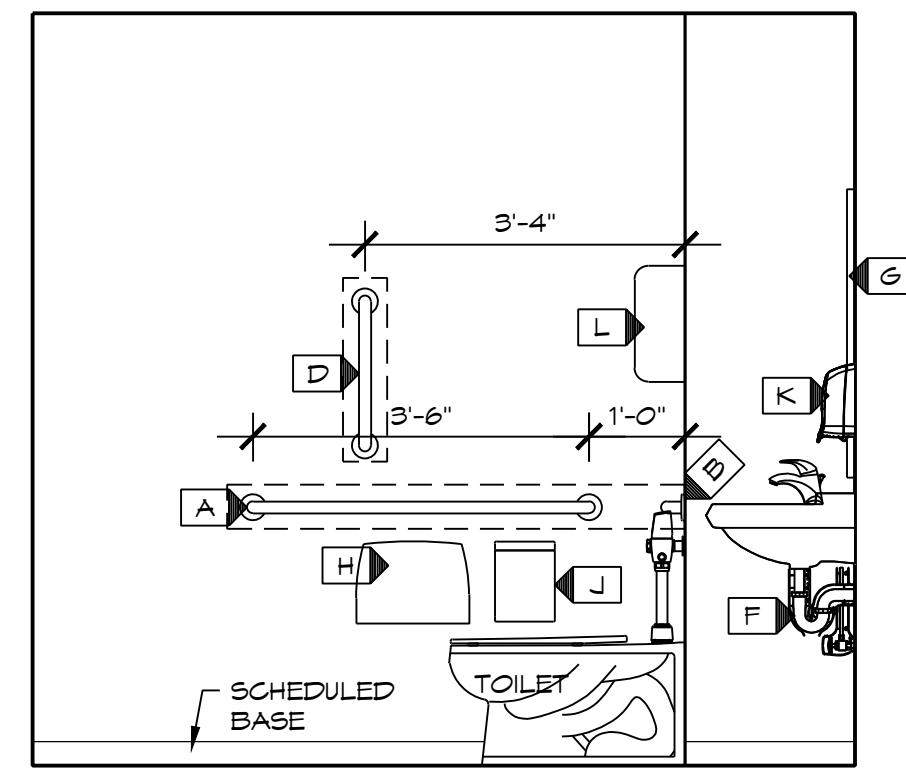


1 #117 unisex elev. 1

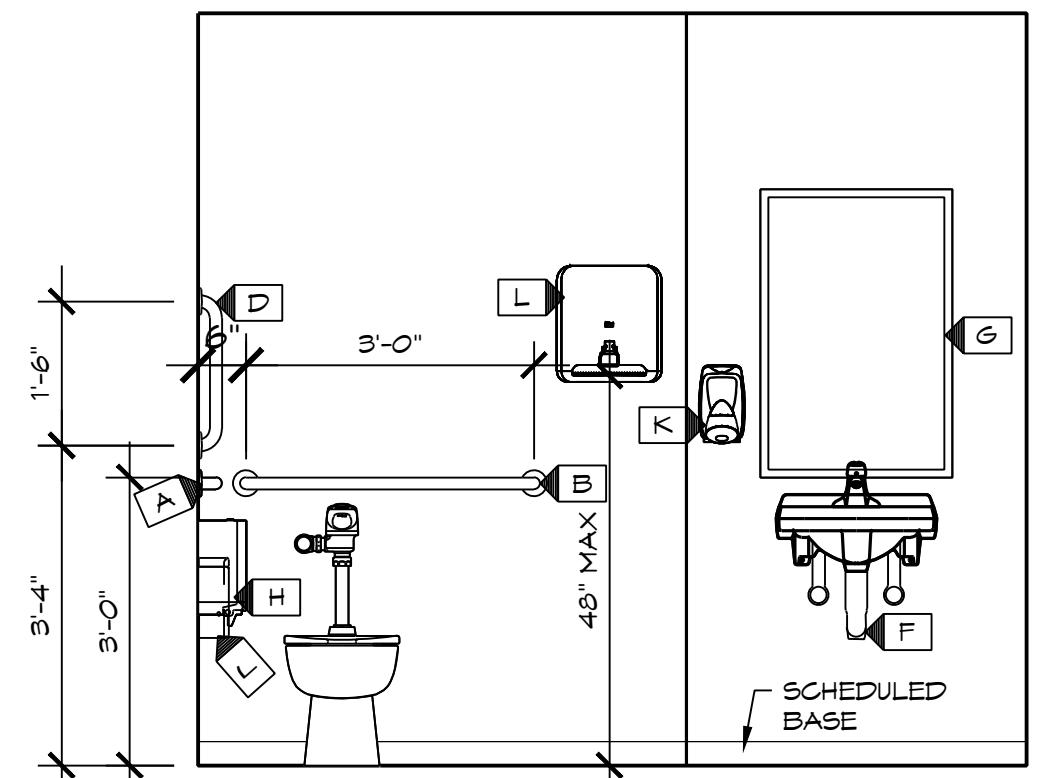


2 #117 unisex elev. 1

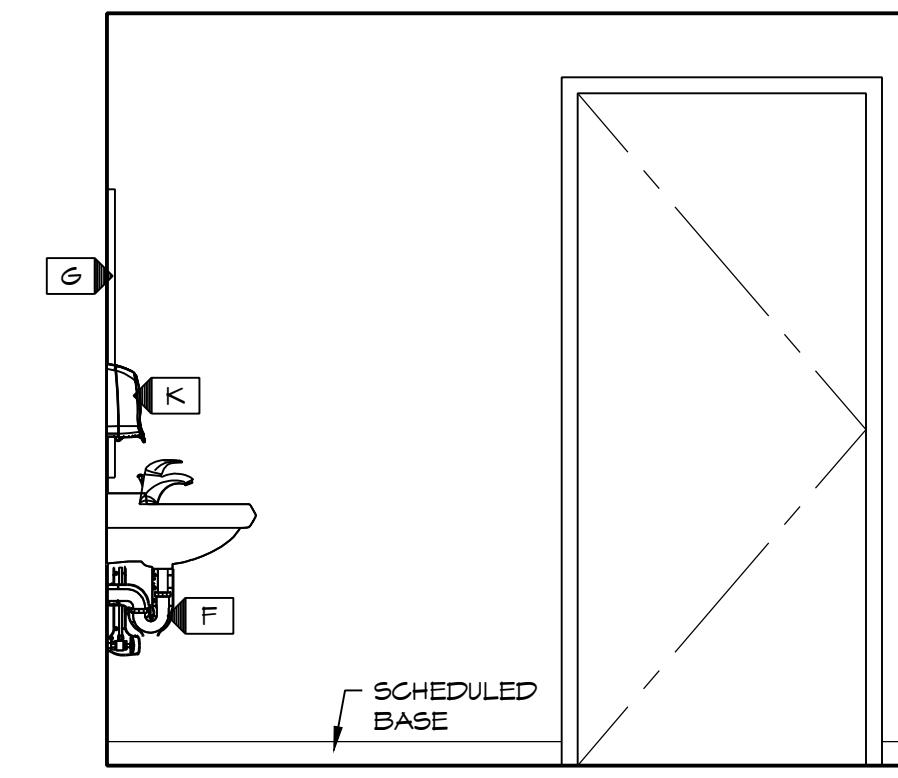


3 #117 unisex elev. 1

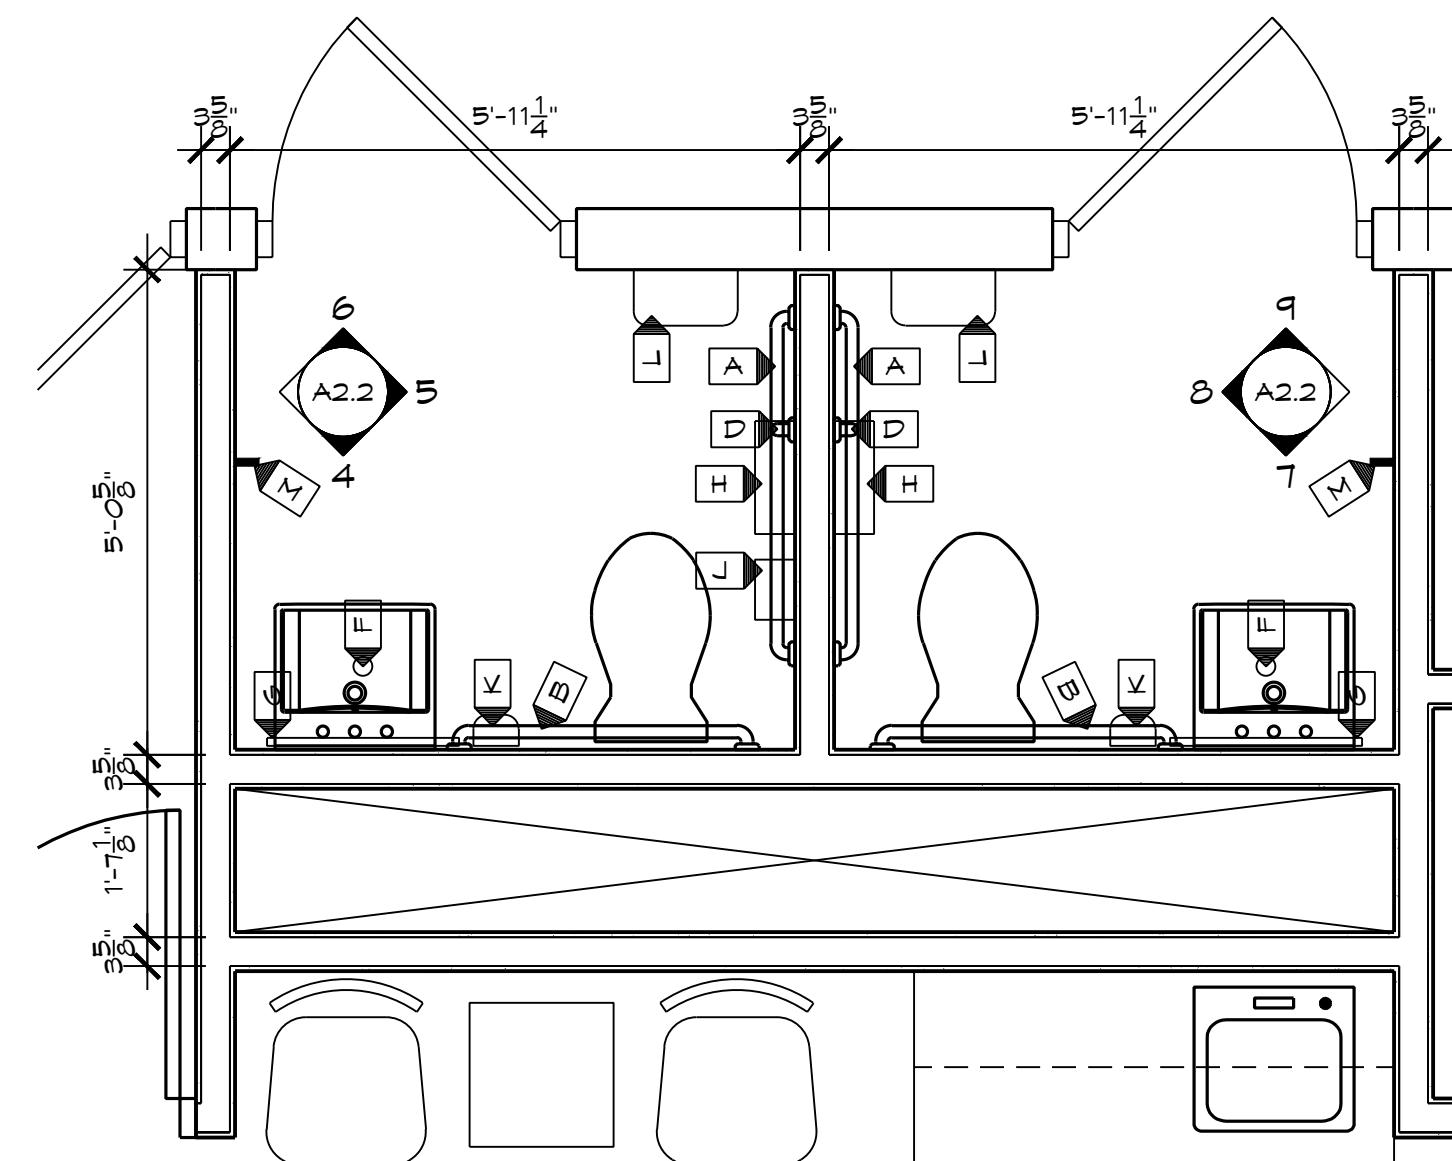


b #110 unisex / #111 unisex plan 1

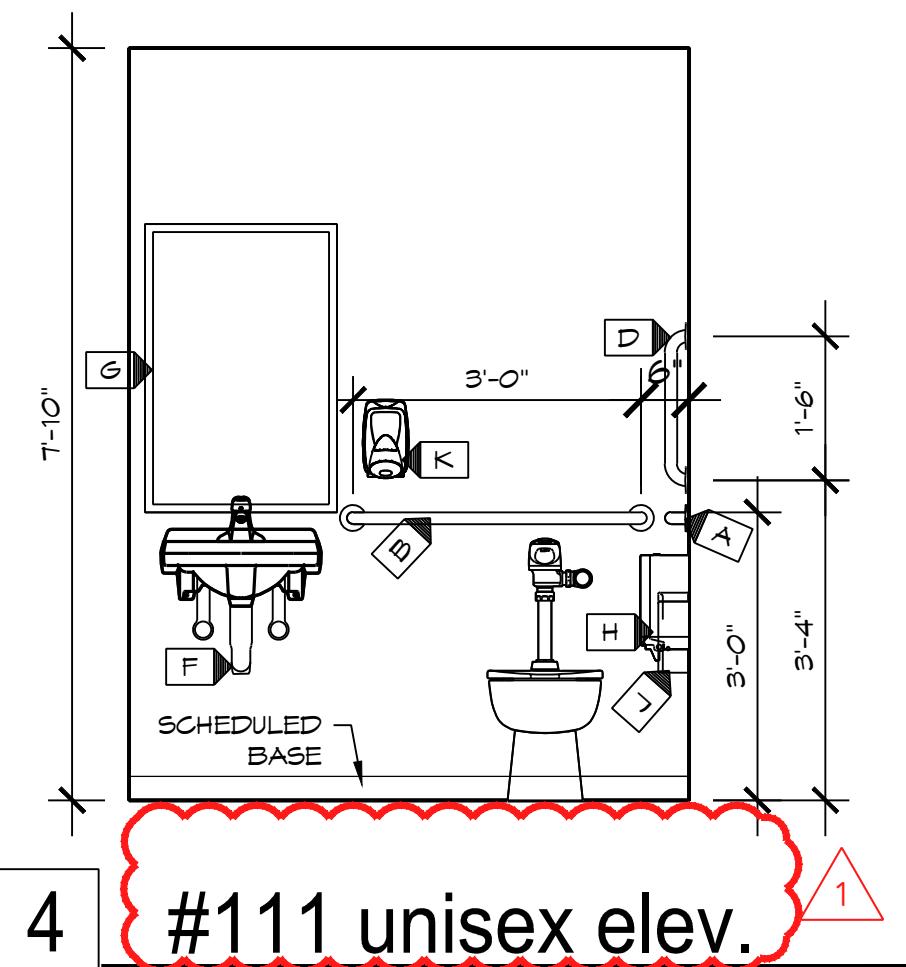


4 #111 unisex elev. 1

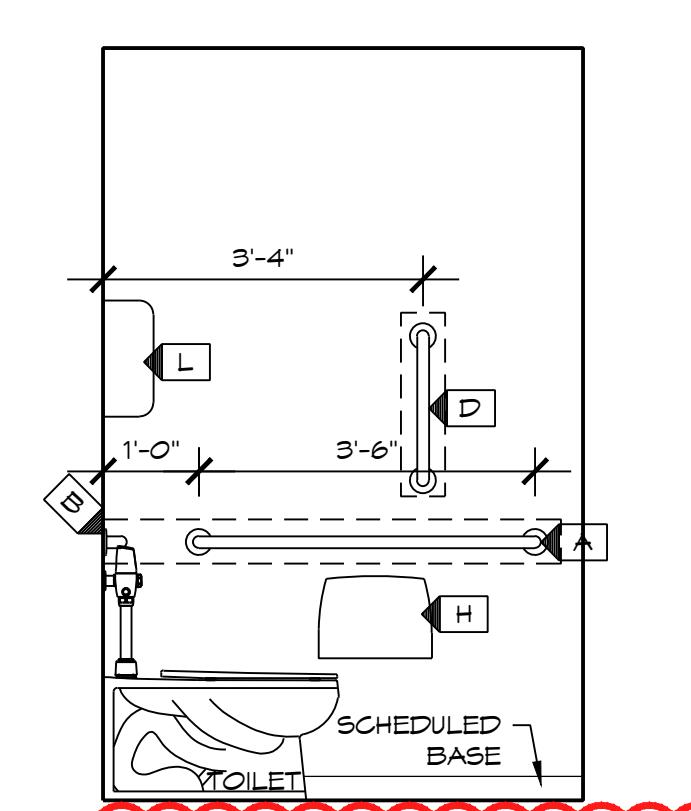


5 #111 unisex elev. 1

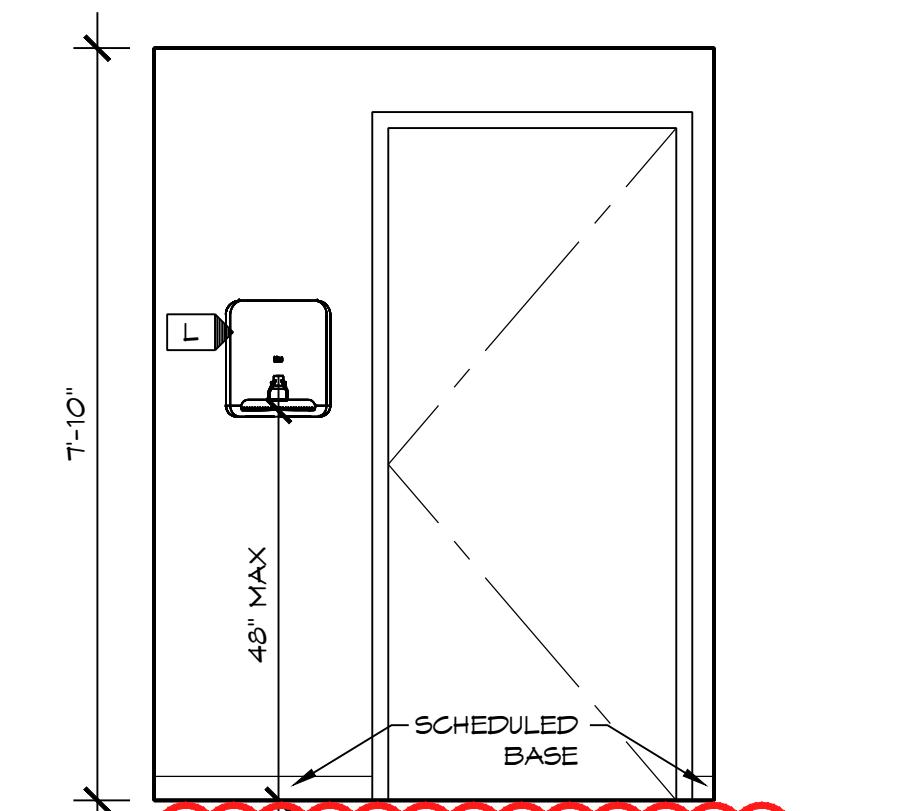


6 #111 unisex elev. 1

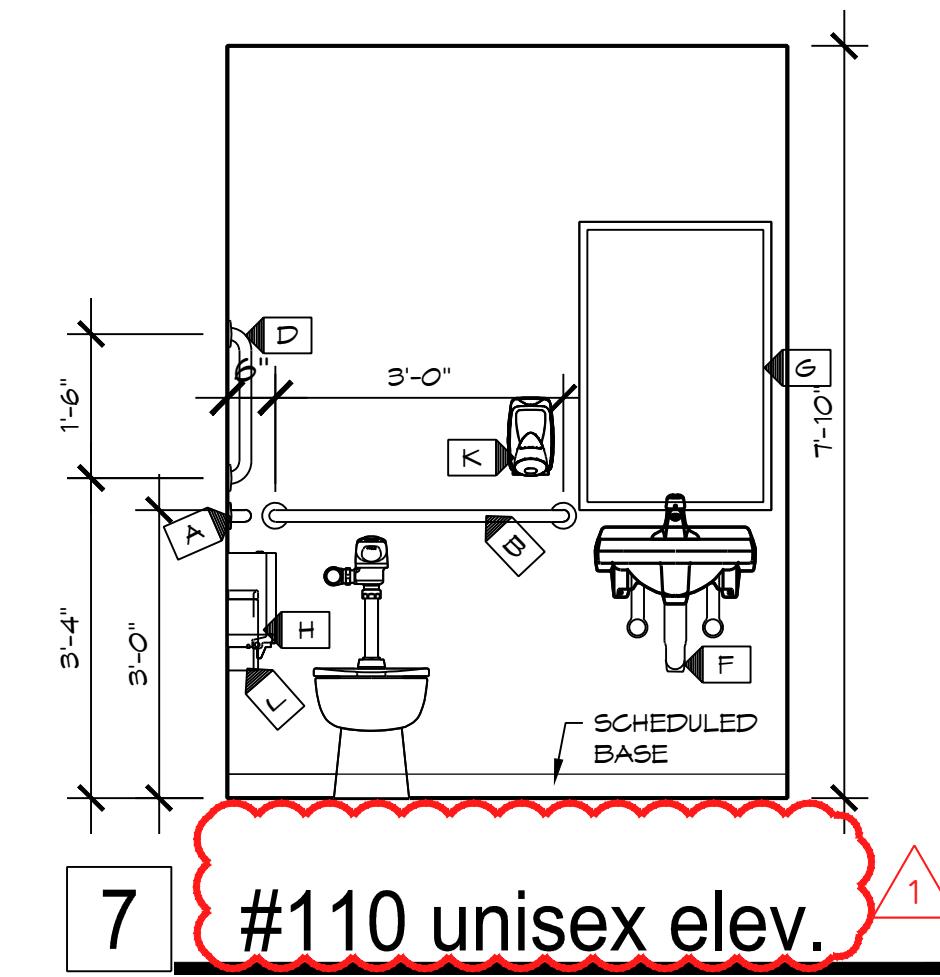

7 #110 unisex elev. 1

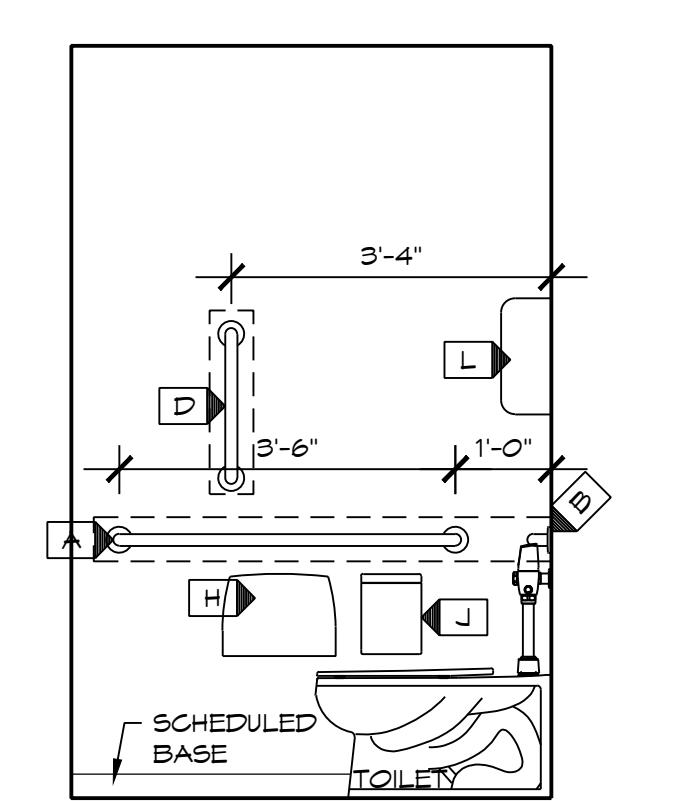

8 #110 unisex elev. 1

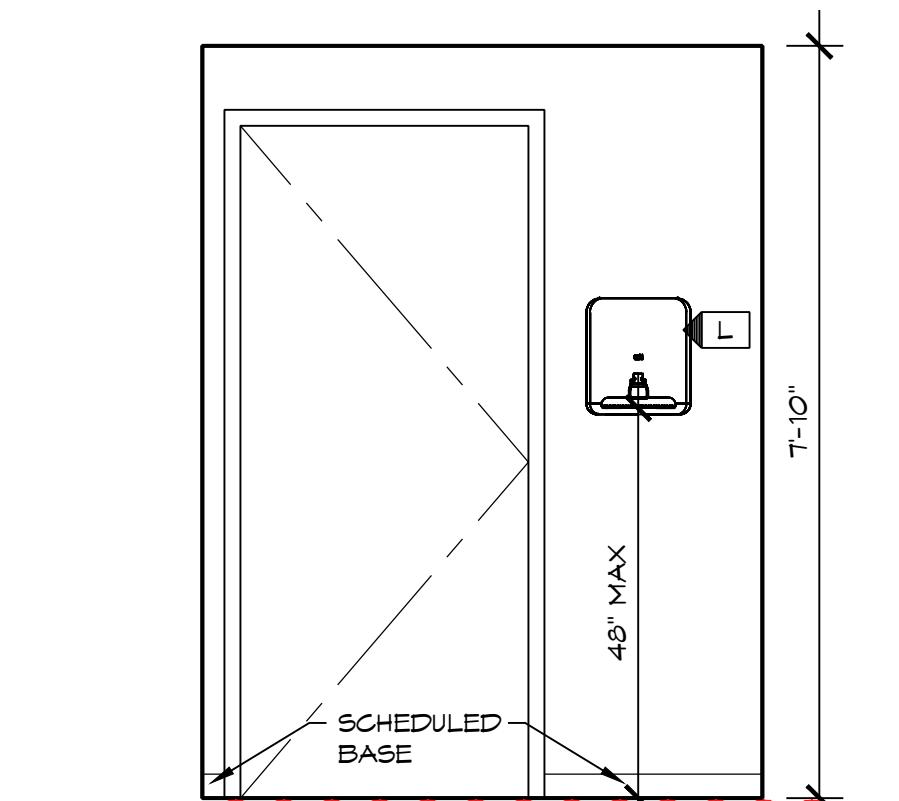

9 #110 unisex elev. 1

toilet accessory schedule				
ITEM	DESCRIPTION	MANUF	MODEL	NOTES
A	42" GRAB BAR	ASI	3800 42"	
B	36" GRAB BAR	ASI	3800 36"	
C	NOT USED	-	-	
D	18" GRAB BAR	ASI	3800 18"	
E	NOT USED	-	-	
F	PIPE GUARD	TRUBRO	LAV GUARD 2	
G	FRAMED MIRROR 24"W X 36"H	SEE SPECS	SEE SPECS	
H	SURF MTD. TOILET PAPER DISPENSER	CINTAS	-	SEE NOTE #1
J	SANITARY NAPKIN DISPOSAL	ASI	20852	
K	SOAP DISPENSER	CINTAS	-	SEE NOTE #1
L	PAPER TOWEL DISPENSER	CINTAS	-	SEE NOTE #1
M	ROBE HOOK	ASI	7305	

NOTES:

1. ACCESSORY PROVIDED BY OWNER AND INSTALLED BY CONTRACTOR.
2. PROVIDE WOOD BLOCKING AT ALL WALL MOUNTED ACCESSORIES

issued
BID DOCUMENTS
revised
1/29/2026
CODE COMMENT REV.
1
STATE OF OHIO
KYLE D. ZEPERNICK
No. 10884
Kyle Zepernick, Licence #10884
Expiration Date 12-31-2027
REGISTERED ARCHITECT
THESE DRAWINGS AND SPECIFICATIONS, THE DESIGNS AND DESIGNS OF THE CONTRACTOR, AND THE SERVICES REPRESENTED THEREBY ARE THE EXCLUSIVE PROPERTY OF THE OREGON GROUP ARCHITECTS, INC. THE CONTRACTOR UPON THE CONTRACTOR'S REQUEST AND ARE NOT TO BE REPRODUCED IN WHOLE OR IN PART, OR DISCLOSED TO ANYONE, EXCEPT AS PROVIDED IN THE CONTRACT DOCUMENTS. THE OREGON GROUP ARCHITECTS, INC. CONSENTS TO THE CONTRACTOR'S USE OF THE DRAWINGS AND DESIGNS FOR THE EXCLUSIVE PURPOSE OF CONSTRUCTION UPON THE CONTRACTOR'S PAYMENT OF THE CONTRACT PRICE TO THE OREGON GROUP ARCHITECTS, INC. THE OREGON GROUP ARCHITECTS, INC. CONSENTS TO THE CONTRACTOR'S USE OF THE DRAWINGS AND DESIGNS FOR THE EXCLUSIVE PURPOSE OF CONSTRUCTION UPON THE CONTRACTOR'S PAYMENT OF THE CONTRACT PRICE TO THE OREGON GROUP ARCHITECTS, INC.


OREGON GROUP ARCHITECTS
ARCHITECTURE INTEGRITY CONSULTANTS
THE PARSONAGE HOUSE
310 S. PATTERSON BLVD. DAYTON, OHIO 45402
937-226-1511 F 937-226-3663

renovation for:
valley view local schools
6027 farmersville pike
germantown, ohio 45327
interior elevations

project number
251431
date
1/29/2026
drawn by
RMT
checked by
KDZ
sheet

A2.2


new door schedule										
DOOR #	DOOR SIZE	FRAME		DOOR		DETAIL		FIRE RATING	HARDWARE SET NO.	REMARKS
		HOLLOW MTL	EXISTING FRAME	SOLID CORE WOOD	EXISTING DOOR	HEAD	JAMB	SILL		
D01	3'-0" x T-0"	F1		D2		1A	1B	1E	-	
D02	3'-0" x T-0"	F1		D2		2A	2B	1E	-	
D03	3'-0" x T-0"	F1		D2		1A	1B	1E	-	
D04	3'-0" x T-0"	F1		D2		1A	1B	1E	-	
D05	3'-0" x T-0"	F1		D2		1A	1B	1E	-	
D06	3'-0" x T-0"	F1		D2		1A	1B	1E	-	
D07	3'-0" x T-0"	F1		D2		1A	1B	1E	-	
D08	3'-0" x T-0"	F1		D2		1A	1B	1E	-	
D09	3'-0" x T-0"	F1		D1		1A	1B	1E	-	
D10	3'-0" x T-0"	F1		D3		1A	1B	1E	-	WITH LOUVER
D11	3'-0" x T-0"	F1		D1		1A	1B	1D	-	
D12	3'-0" x T-0"	F1		D2		1A	1B	1C	-	
D13	3'-0" x T-0"	F1		D1		1A	1B	1C	-	

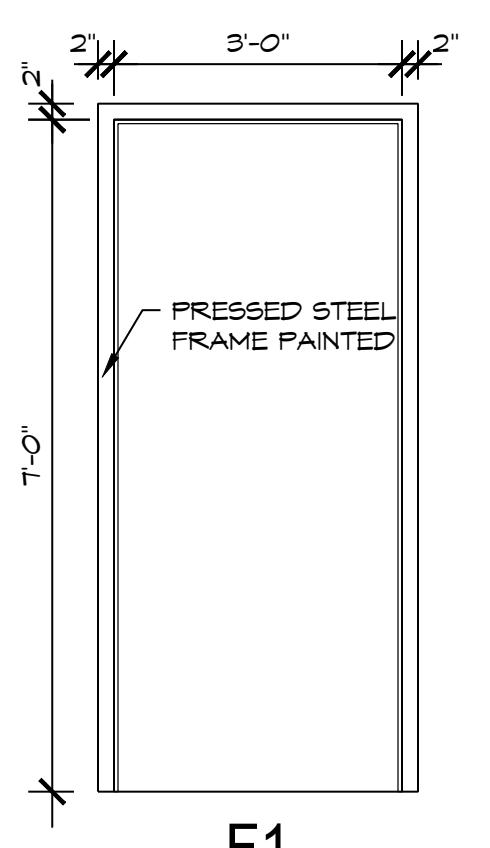

F1

frame elevations

1/2" = 1'-0"

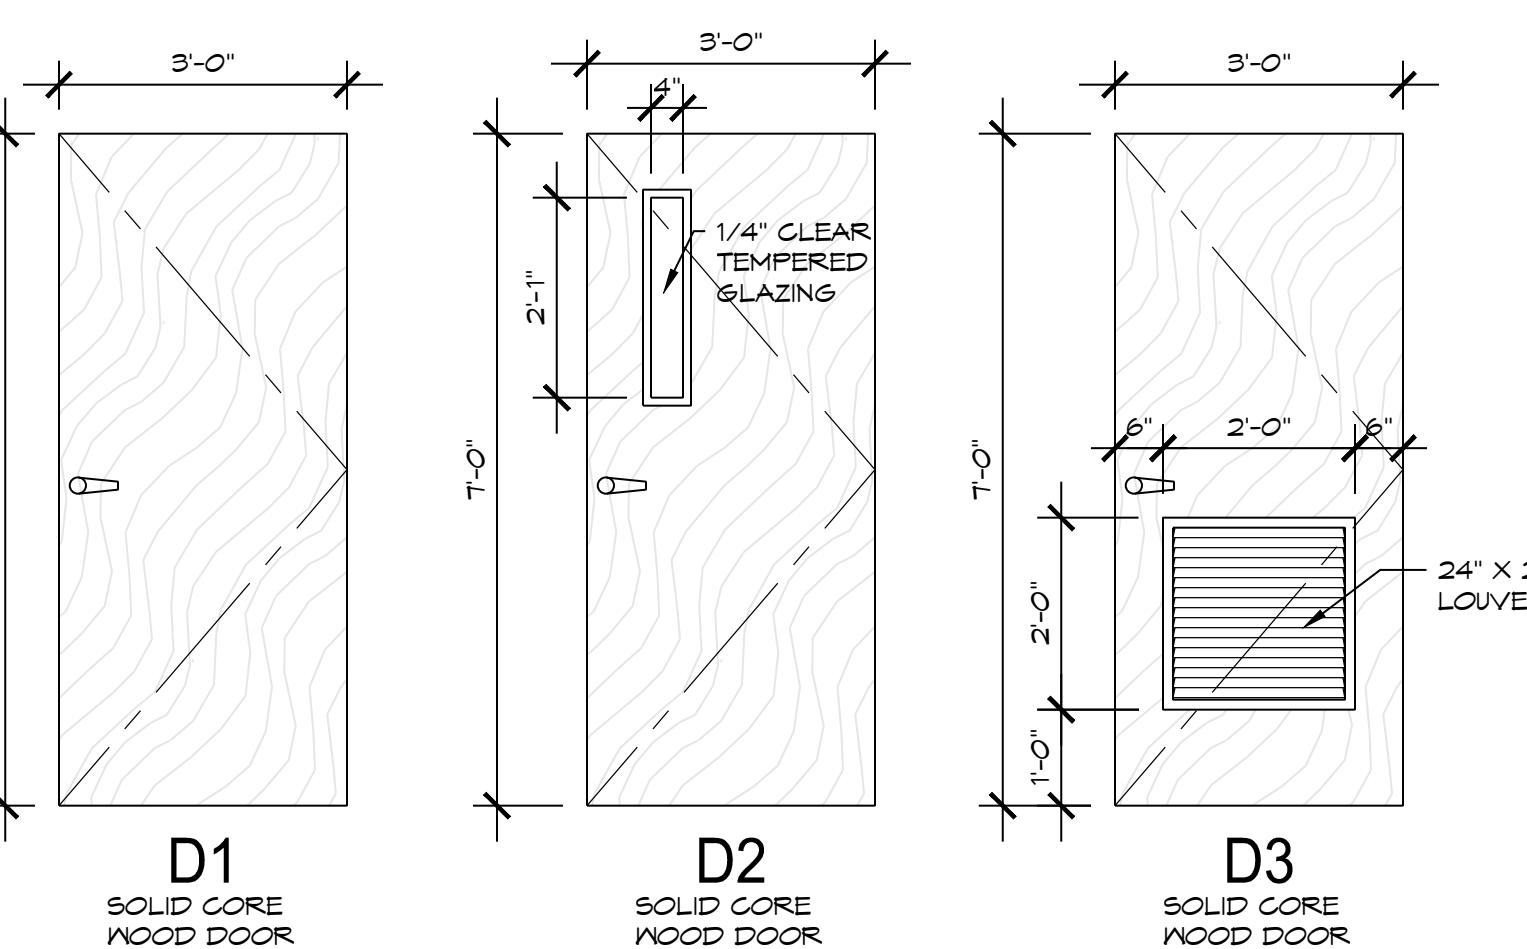


door elevations


1/2" = 1'-0"

existing door schedule										
DOOR #	DOOR SIZE	FRAME		DOOR		DETAIL		FIRE RATING	HARDWARE SET NO.	REMARKS
		HOLLOW MTL	EXISTING FRAME	SOLID CORE WOOD	EXISTING DOOR	HEAD	JAMB	SILL		
E01	3'-0" x T-0"	x	x			20MIN	-	●	●	
E02	3'-0" x T-0"	x	x			20MIN	-	●	●	
E03	3'-0" x T-0"	x	x			20MIN	-	●	●	
E04	3'-0" x T-0"	x	x			20MIN	-	●	●	REPLACE PRIVACY LATCH WITH LEVER STYLE MATCH DOOR D18
E05	3'-0" x T-0"	x	x			20MIN	-	●	●	REPLACE PRIVACY LATCH WITH LEVER STYLE MATCH DOOR D18
E06	3'-0" x T-0"	x	x			20MIN	-	●	●	
E07	3'-0" x T-0"	x	x			20MIN	-	●	●	


NOTE 1 - ROUGH-IN FOR NEW CARD READER, REFERENCE ELECTRICAL DRAWINGS.

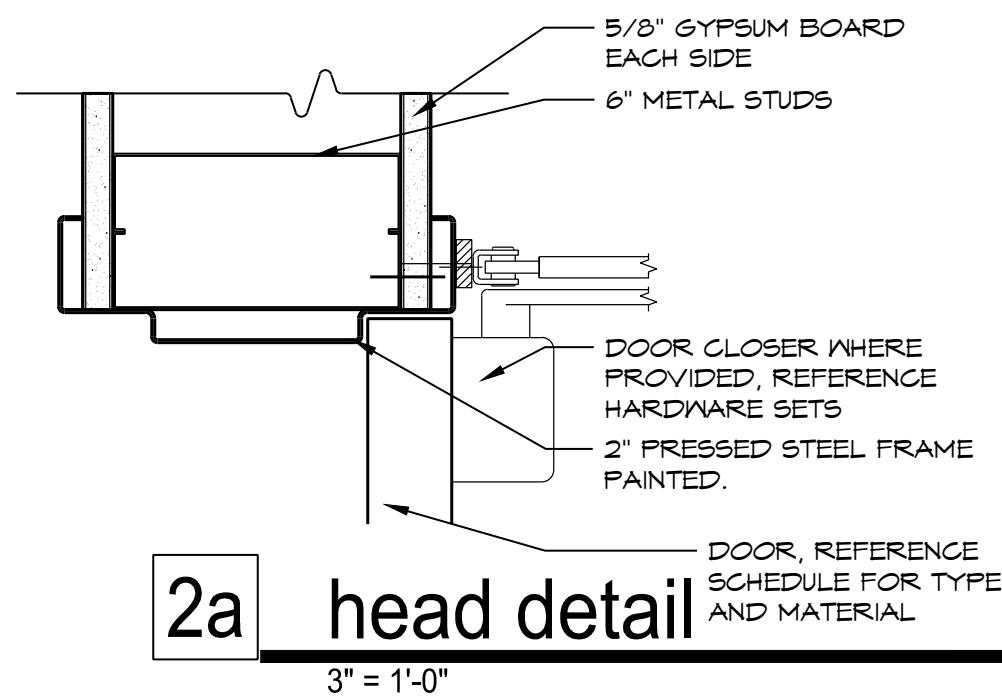


2a head detail

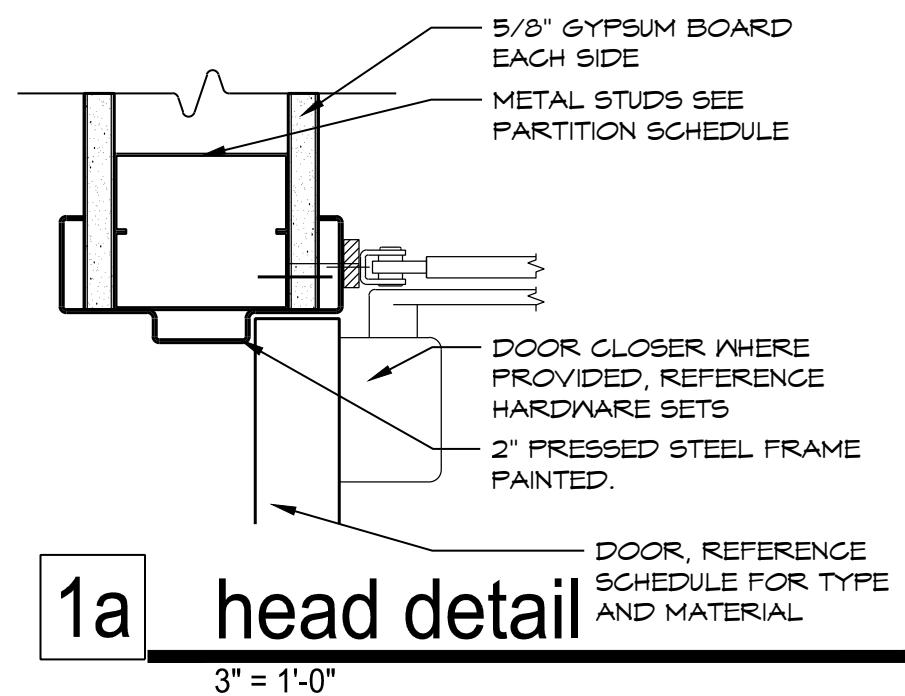


1a head detail

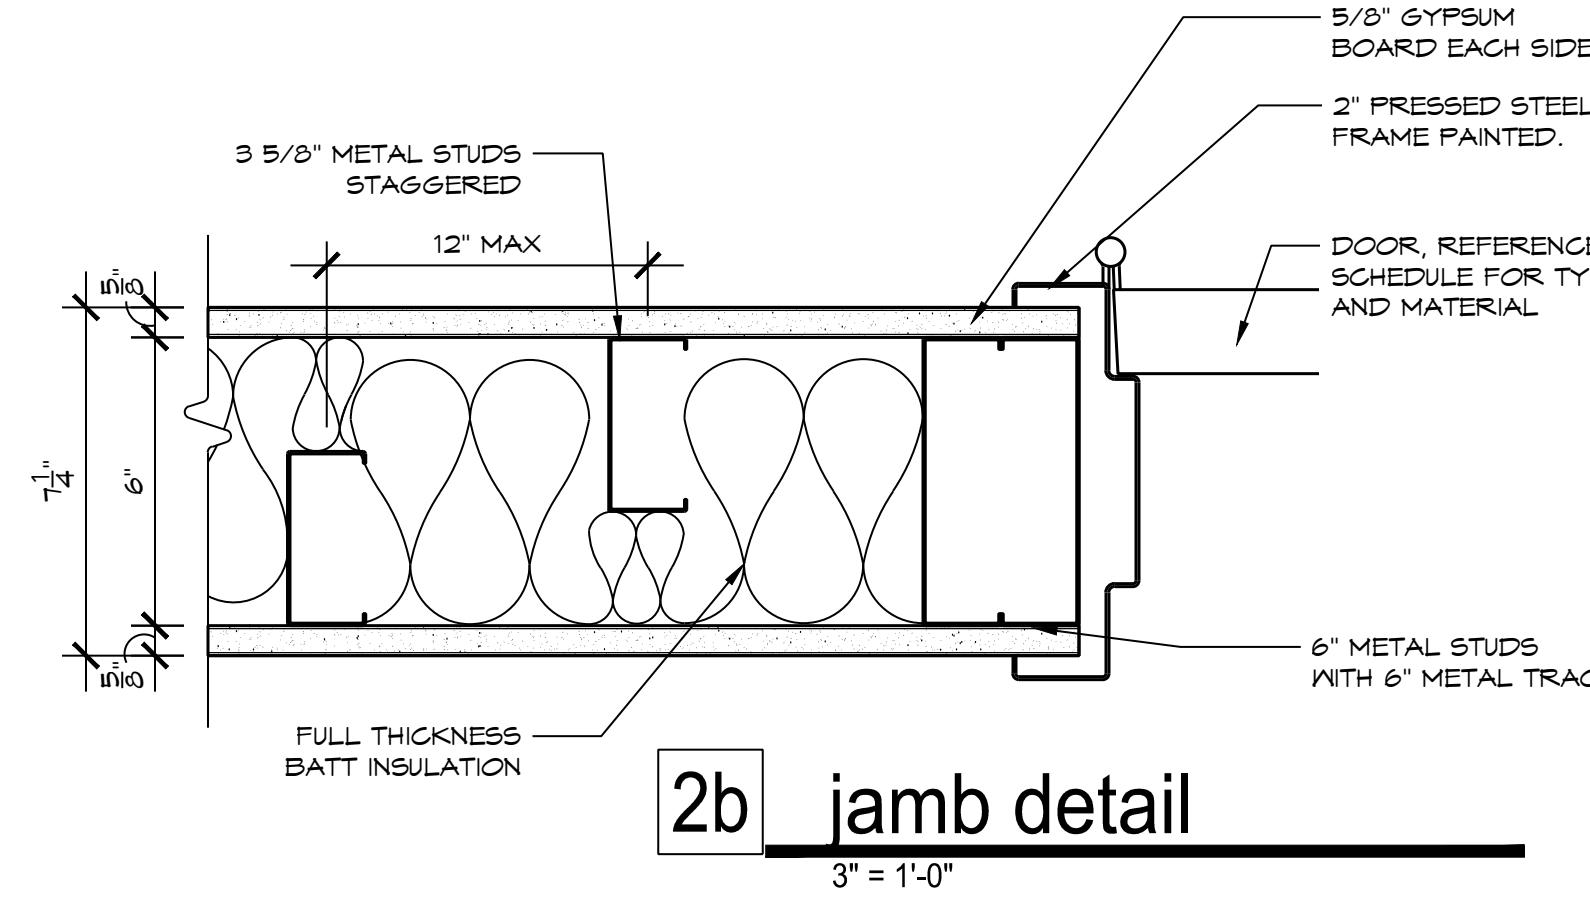


2b jamb detail

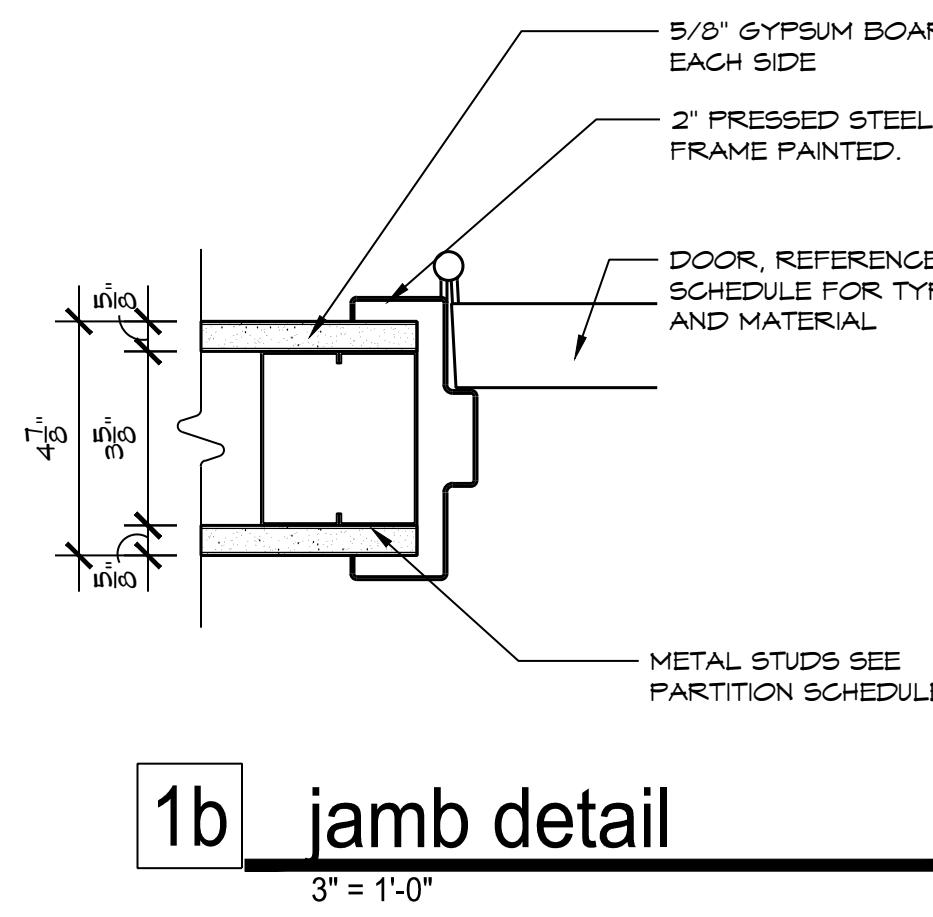


1b jamb detail

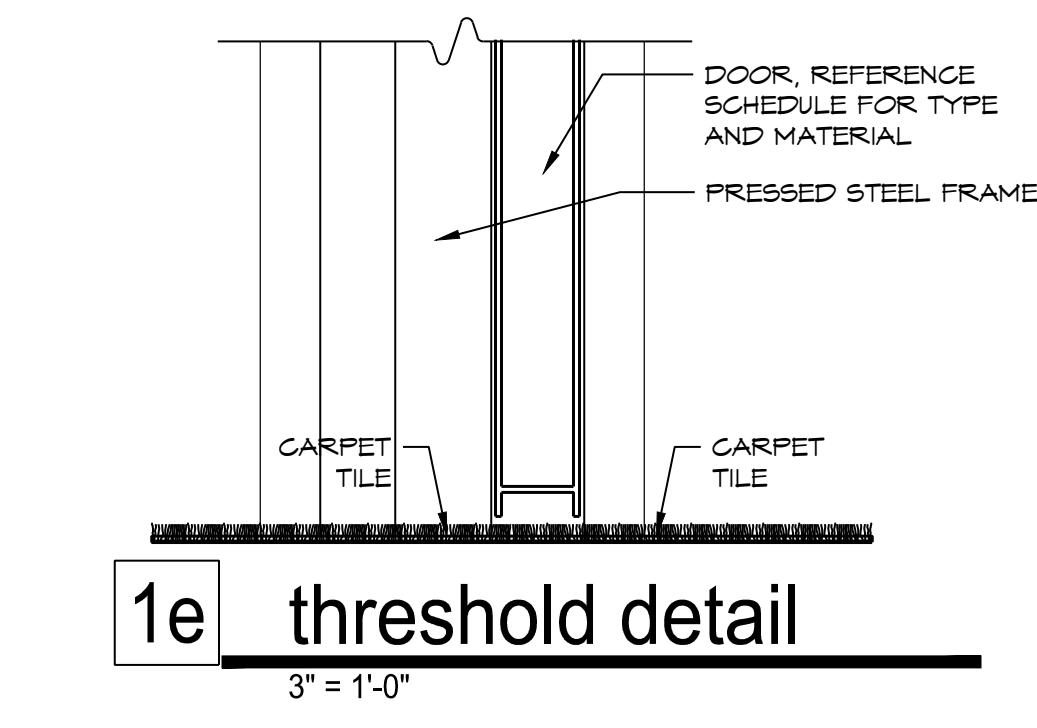

1e threshold detail

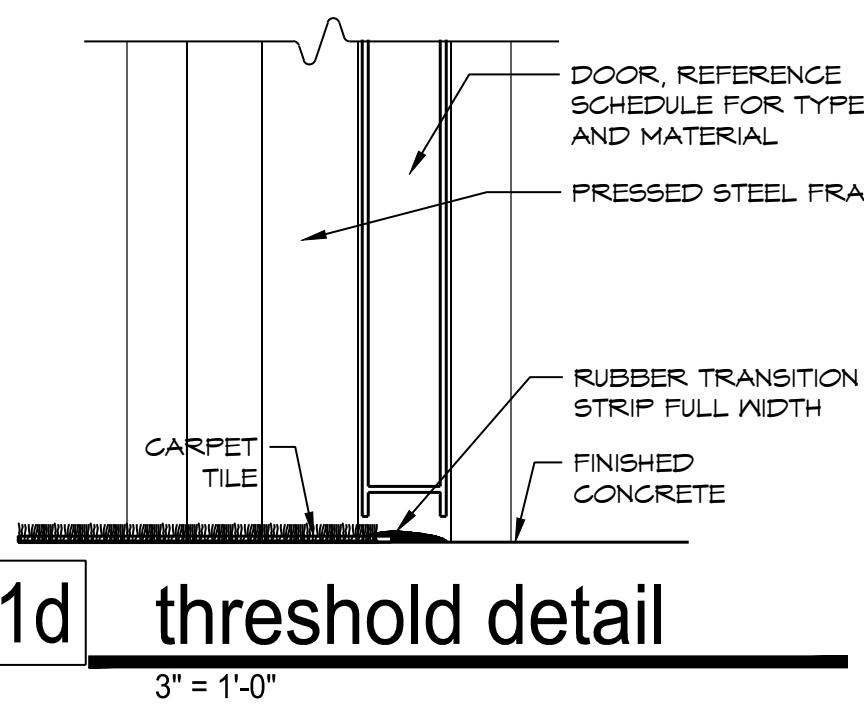

1d threshold detail

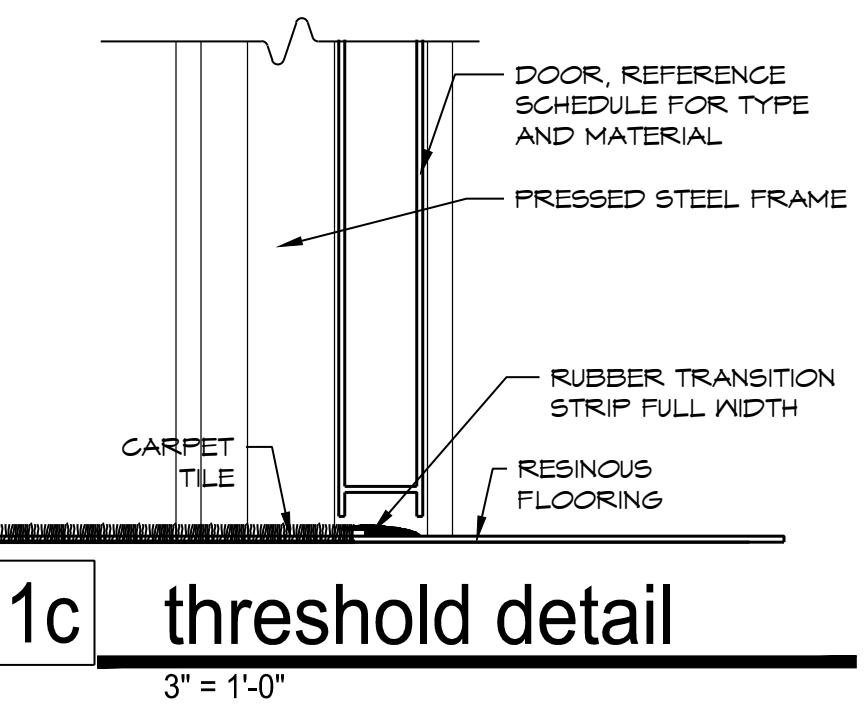

1c threshold detail

first floor finish schedule										
		FLOOR	BASE	WALL	CEILING	CLG. HGT.	MISCL.	REMARKS		
ROOM #	ROOM NAME									
101	RECEPTION - LENS			NEW CARPET TILE (CPT-1)						
102	SUPERINTENDENT COOK			NEW RESIN BASED FLOORING (RES-1)						
103	TREASURER HILL			NEW LVT (LVT-1)						
104	CURRICULUM DIR.			EXISTING RESIN BASED FLOORING (REMAN)						
105	TRAINING			NEW RESIN BASED FLOORING (REMAN)						
106	STUDENT SERVICES			NEW RESIN BASED FLOORING (REMAN)						
107	CONFERENCE ROOM			NEW RESIN BASED FLOORING (REMAN)						
108	NOT USED			NEW RESIN BASED FLOORING (REMAN)						
109	RECEPTION - MINTON			NEW RESIN BASED FLOORING (REMAN)						
110	UNISEX			NEW RESIN BASED FLOORING (REMAN)						
111	UNISEX			NEW RESIN BASED FLOORING (REMAN)						
112	IT CLOSET			NEW RESIN BASED FLOORING (REMAN)						
113	COATS			NEW RESIN BASED FLOORING (REMAN)						
114	CORRIDOR			NEW RESIN BASED FLOORING (REMAN)						
115	MECHANICAL ROOM			NEW RESIN BASED FLOORING (REMAN)						
116	BREAK ROOM			NEW RESIN BASED FLOORING (REMAN)						
117	UNISEX			NEW RESIN BASED FLOORING (REMAN)						
118	WORK ROOM			NEW RESIN BASED FLOORING (REMAN)						

(NOTES)
1. PROVIDE (1) ONE PAINTED ACCENT WALL PER ROOM, SEE FINISH LIST PT-2. COORDINATE ACCENT WALL LOCATIONS WITH OWNER.
2. INSTALL NEW 4" HIGH RESINOUS WALL BASE OVER CEMENT TILE BACKER BOARD AT GYP WALL LOCATIONS. REFERENCE SPECIFICATIONS.

finish list

FLOORING:	
CPT-1	TARKETT STYLE: COROLLARY CARPET TILE SIZE: 18"X36" COLOR: "BLUE STRATEGY" 34404
RES-1	KEY RESIN COMPANY KEY CHIP 100 CUSTOM PRIME: MED GREY 135 BROADCAST: FLAKES $\frac{1}{4}$ " 101446-FB900 220527 CUSTOM #2 GROUT: 511 UV TOPCOAT: PA
LVT-1	MANNINGTON COLOR: ANCHOR COLLECTION STYLE: GROOVE COLOR: MISTY MOUNTAIN SIZE: 6"X36"
ACT-1	CEILING: MFG: ARMSTRONG SIZE: 24" X 24" X $\frac{1}{8}$ " STYLE: FINE FISSURED EDGE: SQUARE GRID SIZE: $\frac{1}{16}$ "
ACT-2	CEILING: MFG: ARMSTRONG SIZE: 24" X 24" X $\frac{1}{8}$ " STYLE: CERAMAGUARD FINE FISSURED EDGE: SQUARE GRID SIZE: $\frac{1}{16}$ "
RB-1	ROPPE RUBBER BASE SIZE: 4" HIGH COILS COLOR: "#139" DEEP NAVY"
RESB-1	KEY RESIN COMPANY KEY CHIP 100 CUSTOM PRIME: MED GREY 135 BROADCAST: FLAKES $\frac{1}{4}$ " 101446-FB900 220527 CUSTOM #2 GROUT: 511 UV TOPCOAT: PA

issued	
BID DOCUMENTS	
revised	
1/23/2026	CODE COMMENT REV.
THESE DRAWINGS AND SPECIFICATIONS, THE DRAWINGS, AND THE SERVICES REPRESENTED THEREIN ARE THE EXCLUSIVE PROPERTY OF THE ARCHITECTS. THE DRAWINGS AND SPECIFICATIONS ARE NOT TO BE REPRODUCED IN WHOLE OR IN PART, OR OTHERWISE USED, WITHOUT THE WRITTEN CONSENT OF THE ARCHITECTS. THE DRAWINGS AND SPECIFICATIONS ARE THE PROPERTY OF THE ARCHITECTS AND ARE TO BE RETURNED UPON THE COMPLETION OF THE WORK. THE DRAWINGS AND SPECIFICATIONS ARE NOT TO BE REPRODUCED IN WHOLE OR IN PART, OR OTHERWISE USED, WITHOUT THE WRITTEN CONSENT OF THE ARCHITECTS.	


OREGON GROUP ARCHITECTS
ARCHITECTURE INTEGRITY CONSULTANTS
310 S. PATTERSON BLDG, DAYTON, OHIO 45402
937-226-1511 F 937-226-5663

renovation for:
valley view local schools
6027 farmersville pike
germantown, ohio 45327
door schedule, finish schedule

PIPING LINETYPES

—	- EXISTING PIPING TO REMAIN
— - - - -	- EXISTING PIPING TO BE REMOVED
— — — — —	- DOMESTIC COLD WATER PIPING
— — — — —	- DOMESTIC HOT WATER PIPING
— — — — —	- DOMESTIC HOT WATER RETURN PIPING
— SS — — —	- SANITARY DRAIN PIPING
— — — — —	- SANITARY VENT PIPING
— G — — —	- GAS PIPING

MISCELLANEOUS SYMBOLS

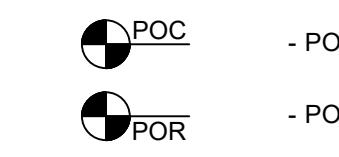


POC	- POINT OF CONNECTION
POR	- POINT OF REMOVAL

PIPING SYMBOLS

X PA	- PIPE ANCHOR
PG	- PIPE GUIDE
— — —	- EXPANSION JOINT
— — —	- VENTURI
— — —	- GATE VALVE
— — —	- GLOBE VALVE
— — —	- NEEDLE VALVE
— — —	- HOSE VALVE WITH CAP
— — —	- BUTTERFLY VALVE
— — —	- CHECK VALVE
NN	- BACKFLOW PREVENTER
— — —	- BALANCING VALVE
— — —	- BALL VALVE
— — —	- PLUG VALVE
S	- SOLENOID VALVE
— — —	- SAFETY / PRESSURE RELIEF, ANGLE VALVE
— — —	- SAFETY / PRESSURE RELIEF, STRAIGHT THRU VALVE
— — —	- PRESSURE REGULATING VALVE
— — —	- AUTOMATIC CONTROL VALVE, 2 WAY
— — —	- AUTOMATIC CONTROL VALVE, 3 WAY
— — —	- LATERAL Y
— — —	- CAP
— — —	- ELBOW, 90°
— — —	- ELBOW, 90° TURNED UP
— — —	- ELBOW, 90° TURNED DOWN
— — —	- ELBOW, 45°
— — —	- TEE
— — —	- TEE, TURNED UP
— — —	- TEE, TURNED DOWN
— — —	- REDUCER, CONCENTRIC
— — —	- UNION
— — —	- STRAINER
M	- METER
R	- REGULATOR
C.O.	- CLEANOUT
F.D.	- FLOOR DRAIN
E.T.R.	- EXISTING TO REMAIN
V.T.R.	- VENT THRU ROOF

GENERAL PLUMBING NOTES:

1. PROVIDE PLUMBING SYSTEMS COMPLETE, UNLESS NOTED OTHERWISE. COMPLETE INSTALLATION SHALL INCLUDE, BUT NOT BE LIMITED TO, ALL PIPE AND FITTINGS, PIPE HANGERS AND ANCHORS, EQUIPMENT, FIXTURES, SPECIALTIES, ETC. THIS CONTRACTOR SHALL COORDINATE PROVISIONS FOR PENETRATIONS IN BLOCK WALLS (I.E. SLEEVES, LINTELS, ETC.) WITH THE GENERAL CONTRACTOR.
2. THIS CONTRACTOR IS RESPONSIBLE FOR FILING ALL PERMIT APPLICATIONS AND ASSOCIATED COSTS WITH THE NECESSARY GOVERNING AUTHORITIES RELATIVE TO DOMESTIC WATER, NATURAL GAS, AND SANITARY SEWER INSTALLATION WORK ON THIS PROJECT. ALL WORK SHALL CONFORM TO ALL CODES THAT APPLY (MATERIAL AND LABOR), INCLUDING ALL CURRENT 'ADA' REQUIREMENTS WHERE APPLICABLE.
3. CONSULT THE ARCHITECTURAL, MECHANICAL, AND ELECTRICAL DRAWINGS TO AVOID INTERFERENCES AND CONFLICTS WITH OTHER TRADES. THIS CONTRACTOR WILL BE EXPECTED TO COVER ALL REWORK COSTS DUE TO LACK OF COORDINATION BY THIS CONTRACTOR.
4. FIELD VERIFY EXISTING PIPE SIZES, LOCATIONS, RELATIVE DIMENSIONS, ETC.
5. CONCEAL PIPES WITHIN WALLS OR CHASES WHENEVER PRACTICAL.
6. MAINTAIN DIMENSIONED "AS-BUILT" DRAWINGS FOR ALL UNDERGROUND UTILITIES DURING CONSTRUCTION AND PROVIDE TO ARCHITECT AT PROJECT COMPLETION.
7. WORK SHALL CONFORM TO ASSOCIATED SPECIFICATIONS.
8. DEMONSTRATE OPERATION OF SYSTEMS AND EQUIPMENT TO THE OWNER. THE OPERATING AND SERVICE MANUALS FOR ALL EQUIPMENT SHALL BE FURNISHED TO THE OWNER.
9. PROVIDE DOMESTIC HOT AND COLD WATER DISTRIBUTION TO ALL OBVIOUSLY NECESSARY LOCATIONS INCLUDING ALL VALVES, FITTINGS, HANGERS, BACKFLOW PREVENTERS, WATER HEATERS, ETC.
10. WATER PIPING SHALL BE INSTALLED MEETING THE REQUIREMENTS OF OBC - PLUMBING CODE, LATEST EDITION, AND AS DESCRIBED BELOW.
 - A. PIPING SHALL BE SUPPORTED WITH 3/8" ALL THREAD AND CLEVIS HANGERS AND IN ACCORDANCE WITH SECTION 308 OF THE OBC - PLUMBING CODE, LATEST EDITION.
 - B. INSULATE NEW DOMESTIC HOT AND COLD WATER DISTRIBUTION INCLUDING FITTINGS.
 - C. PROVIDE SERVICE VALVES ON DOMESTIC HOT AND COLD WATER DISTRIBUTION TO EACH FIXTURE. ALL VALVES SHALL BE LOCATED IN CONVENIENT LOCATIONS.
 - D. PROVIDE WATER HAMMER ARRESTERS AT EQUIPMENT WITH QUICK CLOSING VALVES.
 - E. DOMESTIC WATER PIPING SHALL BE ASTM B 88 TYPE L, HARD COPPER TUBE WITH SOLDERED FITTINGS ASME B16.18 CAST COPPER ALLOY OR ASME B16.22 WROUGHT COPPER. ALL JOINTS SHALL BE SOLDERED WITH ASTM B 32 95-5 TIN-ANTIMONY SOLDER OR APPROVED EQUAL.
 - F. PIPE INSULATION SHALL BE 1" THICK WITH ALL SERVICE JACKET. THE INSULATION BLANKET SHALL HAVE A "U" VALUE OF 0.28 BTUH-IN/SQ.FT.-F AT 100°F MEAN TEMPERATURE DIFFERENCE AND A COMPOSITE FIRE AND SMOKE HAZARD RATING AS TESTED PROCEDURE ASTM E-84 NFPA 255 AND UL 723, NOT EXCEEDING CLASS SPREAD 25 AND SMOKE DEVELOPED SPREAD. INSULATION SHALL BE AS MANUFACTURED BY KNAUF OR APPROVED EQUAL. ALL INSULATION JOINTS SHALL BE TIGHTLY BUTTED AND COVERED WITH 4" WIDE X .0025" FOIL TAPE ADHERED WITH LAP SEAL ADHESIVE TO PROVIDE A COMPLETE VAPOR BARRIER ENVELOPE.
11. PROVIDE SANITARY SEWER TO ALL NECESSARY LOCATIONS INCLUDING FLOOR DRAINS, CLEANOUTS, TRAPS, VENTS, ETC.
12. SANITARY SEWER SHALL BE INSTALLED MEETING THE REQUIREMENTS OF OBC - PLUMBING CODE, LATEST EDITION, AND AS DESCRIBED BELOW.
 - A. SANITARY SEWER PIPE SHALL BE INSTALLED WITH 1/4" PER FOOT MINIMUM SLOPE, UNLESS NOTED OTHERWISE.
 - B. EXPOSED TRAPS AND TRIM SHALL BE BRIGHT CHROME, UNLESS OTHERWISE NOTED. ALL PLUMBING FIXTURES SHALL BE WHITE, UNLESS OTHERWISE NOTED.
 - C. VENTS SHALL BE LOOPED ABOVE SUSPENDED CEILING AND / OR WITHIN ATTIC TO MINIMIZE ROOF PENETRATIONS.
 - D. PVC NOT ACCEPTABLE FOR VENT PIPING IN CEILING PLENUM SPACES.
 - E. PVC PIPE IS ACCEPTABLE FOR WASTE AND VENT PIPING. COORDINATE PIPE MATERIALS AND CEILING PLENUMS.
 - F. REFERENCE ARCHITECTURAL SHEETS FOR PLUMBING FIXTURE LOCATIONS, MOUNTING HEIGHTS, ETC.
 - G. FLOOR DRAINS SHALL HAVE TRAP PRIMER CONNECTIONS, UNLESS OTHERWISE NOTED.

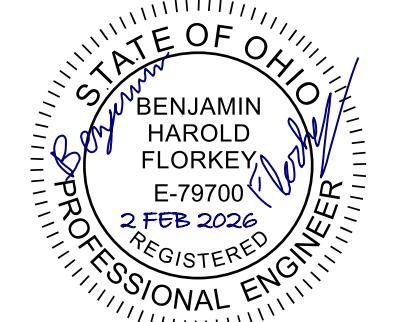issued	PERMIT DRAWINGS
revised	_____
_____	_____
_____	_____
_____	_____
 <p>STATE OF OHIO PROFESSIONAL ENGINEER BENJAMIN HAROLD FLORKEY E-79700 2 FEB 2023 REGISTERED</p>	
<small>THESE DRAWINGS AND SPECIFICATIONS, THE DESIGNS AND THE TECHNICAL INFORMATION CONTAINED THEREIN ARE THE EXCLUSIVE PROPERTY OF THE OREGON GROUP ARCHITECTS, INC. THE DRAWINGS AND SPECIFICATIONS ARE TO BE USED ONLY FOR THE PROJECT REQUESTED AND ARE NOT TO BE REPRODUCED IN WHOLE OR IN PART, OR TO BE DISCLOSED TO ANY OTHER PERSON, UNLESS EXPRESSLY CONSENTED TO BY THE OREGON GROUP ARCHITECTS, INC. © 2001.</small>	

OREGON GROUP ARCHITECTS
ARCHITECTURE IN FINEST DETAILS CONSULTANTS

THE PERSONAL HOME
310 S. PATTERSON BLVD. DAYTON, OHIO 45402
937-224-1511 F 937-224-3663

office renovation for:
valley view board of education
6027 farmersville pike
germantown, ohio 45327
plumbing general notes and legends

project number
251431
date
1/23/2026
drawn by
JEW
checked by
BHF

sheet
P.O. 1

PLUMBING SPECIFICATIONS

SECTION 220719 PLUMBING PIPING INSULATION

1.01 REGULATORY REQUIREMENTS

- A. SURFACE BURNING CHARACTERISTICS: FLAME SPREAD INDEX/SMOKE DEVELOPED INDEX OF 25/50, MAXIMUM, WHEN TESTED IN ACCORDANCE WITH ASTM E84 OR UL 723.

2.01 EXAMINATION

- A. VERIFY THAT PIPING HAS BEEN TESTED BEFORE APPLYING INSULATION MATERIALS.
- B. VERIFY THAT SURFACES ARE CLEAN AND DRY, WITH FOREIGN MATERIAL REMOVED.

2.02 INSTALLATION

- A. INSTALL IN ACCORDANCE WITH MANUFACTURER'S INSTRUCTIONS.
- B. INSULATED PIPES CONVEYING FLUIDS BELOW AMBIENT TEMPERATURE: INSULATE ENTIRE SYSTEM INCLUDING FITTINGS, VALVES, UNIONS, FLANGES, STRAINERS, FLEXIBLE CONNECTIONS, AND EXPANSION JOINTS.
- C. FOR HOT PIPING CONVEYING FLUIDS 140 DEGREES F (60 DEGREES C) OR LESS, DO NOT INSULATE FLANGES AND UNIONS AT EQUIPMENT, BUT BEVEL AND SEAL ENDS OF INSULATION.
- D. GLASS FIBER INSULATED PIPES CONVEYING FLUIDS ABOVE AMBIENT TEMPERATURE:
 - 1. PROVIDE STANDARD JACKETS, WITH OR WITHOUT VAPOR BARRIER, FACTORY-APPLIED OR FIELD-APPLIED. SECURE WITH SELF-SEALING LONGITUDINAL LAPS AND BUTT STRIPS WITH PRESSURE-SENSITIVE ADHESIVE. SECURE WITH OUTWARD CLINCH EXPANDING STAPLES.
 - 2. INSULATE FITTINGS, JOINTS, AND VALVES WITH INSULATION OF LIKE MATERIAL AND THICKNESS AS ADJOINING PIPE. FINISH WITH GLASS CLOTH AND ADHESIVE OR PVC FITTING COVERS.
- F. CONTINUE INSULATION THROUGH WALLS, SLEEVES, PIPE HANGERS, AND OTHER PIPE PENETRATIONS. FINISH AT SUPPORTS, PROTRUSIONS, AND INTERRUPTIONS. AT FIRE SEPARATIONS, SEE SECTION 078400.

SECTION 221005 PLUMBING PIPING

2.01 GENERAL REQUIREMENTS

- A. POTABLE WATER SUPPLY SYSTEMS: PROVIDE PIPING, PIPE FITTINGS, AND SOLDER AND FLUX (IF USED), THAT COMPLY WITH NSF 61 AND NSF 372 FOR MAXIMUM LEAD CONTENT; LABEL PIPE AND FITTINGS.

2.02 SANITARY WASTE PIPING, BURIED WITHIN 5 FEET (1500 MM) OF BUILDING

- A. CAST IRON PIPE: ASTM A74 EXTRA HEAVY WEIGHT.
 - 1. FITTINGS: CAST IRON.
 - 2. JOINTS: HUBB-AND-SPIGOT, CISPI HSN COMPRESSION TYPE WITH ASTM C564 NEOPRENE GASKETS OR LEAD AND OAKUM.
- B. PVC PIPE: ASTM D2665 OR ASTM D3034.
 - 1. FITTINGS: PVC.
 - 2. JOINTS: SOLVENT WELDED, WITH ASTM D2564 SOLVENT CEMENT.

2.03 SANITARY WASTE PIPING, ABOVE GRADE

- A. CAST IRON PIPE: ASTM A74 EXTRA HEAVY WEIGHT
 - 1. FITTINGS: CAST IRON
 - 2. JOINT SEALS: ASTM C564 NEOPRENE GASKETS, OR LEAD AND OAKUM.
- B. STEEL PIPE: ASTM A53/A53M, GRADE B, TYPE F, SCHEDULE 40, GALVANIZED.
 - 1. THREADED JOINTS: ASME B16.4 CAST IRON FITTINGS.
- C. PVC PIPE: ASTM D2729.
 - 1. FITTINGS: PVC.
 - 2. JOINTS: SOLVENT WELDED, WITH ASTM D2564 SOLVENT CEMENT.

2.04 DOMESTIC WATER PIPING, BURIED WITHIN 5 FEET (1500 MM)

OF BUILDING

- A. COPPER PIPE: ASTM B42, ANNEALED.
 - 1. FITTINGS: ASME B16.26, CAST BRONZE.
 - 2. JOINTS: FLARED.

2.05 DOMESTIC WATER PIPING, ABOVE GRADE

- A. COPPER PIPE: ASTM B88 (ASTM B88M), TYPE K (A), DRAWN (H).
 - 1. FITTINGS: ASME B16.18, CAST COPPER ALLOY OR ASME B16.22, WROUGHT COPPER AND BRONZE.
 - 2. JOINTS: ASTM B32, ALLOY SN95 SOLDER.

2.10 PIPE FLANGES, UNIONS, AND COUPLINGS

- A. UNIONS FOR PIPE SIZES 3 INCH (80 MM, DN) AND UNDER:
 - 1. COPPER TUBE AND PIPE: CLASS 150 BRONZE UNIONS WITH SOLDERED JOINTS.

2.11 PIPE HANGERS AND SUPPORTS

- A. PROVIDE HANGERS AND SUPPORTS THAT COMPLY WITH MSS SP-58.
 - 1. IF TYPE OF HANGER OR SUPPORT FOR A PARTICULAR SITUATION IS NOT INDICATED, SELECT APPROPRIATE TYPE USING MSS SP-58 RECOMMENDATIONS.
- 2. OVERHEAD SUPPORTS: INDIVIDUAL STEEL ROD HANGERS ATTACHED TO STRUCTURE OR TO TRAPEZE HANGERS.
- 3. TRAPEZE HANGERS: WELDED STEEL CHANNEL FRAMES ATTACHED TO STRUCTURE.
- 4. VERTICAL PIPE SUPPORT: STEEL RISER CLAMP.

C. PLUMBING PIPING - DRAIN, WASTE, AND VENT:

- 1. HANGERS FOR PIPE SIZES 1/2 TO 1-1/2 INCH (15 TO 40 MM, DN): MALLEABLE IRON, ADJUSTABLE SWIVEL, SPLIT RING.
- 2. HANGERS FOR PIPE SIZES 2 INCH (50 MM, DN) AND OVER: CARBON STEEL, ADJUSTABLE, CLEVIS.
- 3. WALL SUPPORT FOR PIPE SIZES TO 3 INCH (80 MM, DN): CAST IRON HOOK.
- 4. WALL SUPPORT FOR PIPE SIZES 4 INCH (100 MM, DN) AND OVER: WELDED STEEL BRACKET AND WROUGHT STEEL CLAMP.

D. PLUMBING PIPING - WATER:

- 1. HANGERS FOR PIPE SIZES 1/2 TO 1-1/2 INCH (15 TO 40 MM, DN): MALLEABLE IRON, ADJUSTABLE SWIVEL, SPLIT RING.
- 2. HANGERS FOR COLD PIPE SIZES 2 INCH (50 MM, DN) AND OVER: CARBON STEEL, ADJUSTABLE, CLEVIS.
- 3. HANGERS FOR HOT PIPE SIZES 2 TO 4 INCH (50 TO 100 MM, DN): CARBON STEEL, ADJUSTABLE, CLEVIS.

3.01 PREPARATION

- A. REAM PIPE AND TUBE ENDS. REMOVE BURRS. BEVEL PLAIN END FERROUS PIPE.
- B. REMOVE SCALE AND DIRT, ON INSIDE AND OUTSIDE, BEFORE ASSEMBLY.
- C. PREPARE PIPING CONNECTIONS TO EQUIPMENT WITH FLANGES OR UNIONS.

3.02 INSTALLATION

- A. INSTALL IN ACCORDANCE WITH MANUFACTURER'S INSTRUCTIONS.
- B. ROUTE PIPING IN ORDERLY MANNER AND MAINTAIN GRADIENT. ROUTE PARALLEL AND PERPENDICULAR TO WALLS.
- C. INSTALL PIPING TO MAINTAIN HEADROOM, CONSERVE SPACE, AND NOT INTERFERE WITH USE OF SPACE.
- D. GROUP PIPING WHENEVER PRACTICAL AT COMMON ELEVATIONS.
- E. INSTALL PIPING TO ALLOW FOR EXPANSION AND CONTRACTION WITHOUT STRESSING PIPE, JOINTS, OR CONNECTED EQUIPMENT. SEE SECTION 220516.
- F. PROVIDE CLEARANCE IN HANGERS AND FROM STRUCTURE AND OTHER EQUIPMENT FOR INSTALLATION OF INSULATION AND ACCESS TO VALVES AND FITTINGS.

- G. COPPER PIPE AND TUBE: MAKE SOLDERED JOINTS IN ACCORDANCE WITH ASTM B828, USING SPECIFIED SOLDER, AND FLUX MEETING ASTM B813; IN POTABLE WATER SYSTEMS USE FLUX ALSO COMPLYING WITH NSF 61 AND NSF 372.

- H. PVC PIPE: MAKE SOLVENT-WELDED JOINTS IN ACCORDANCE WITH ASTM D2855.

3.03 FIELD TESTS AND INSPECTIONS

- A. VERIFY AND INSPECT SYSTEMS ACCORDING TO REQUIREMENTS BY THE AUTHORITY HAVING JURISDICTION. IN THE ABSENCE OF SPECIFIC TEST AND INSPECTION PROCEDURES PROCEED AS INDICATED BELOW.

B. DOMESTIC WATER SYSTEMS:

- 1. PERFORM HYDROSTATIC TESTING FOR LEAKAGE PRIOR TO SYSTEM DISINFECTION.
- 2. TEST PREPARATION: CLOSE EACH FIXTURE VALVE OR DISCONNECT AND CAP EACH CONNECTED FIXTURE.
- 3. GENERAL:
 - a. FILL THE SYSTEM WITH WATER AND RAISE STATIC HEAD TO 10 PSI (345 KPA) ABOVE SERVICE PRESSURE. MINIMUM STATIC HEAD OF 50 TO 150 PSI (345 TO 1,034 KPA). AS AN EXCEPTION, CERTAIN CODES ALLOW A MAXIMUM STATIC PRESSURE OF 80 PSI (551.6 KPA).

3.04 DISINFECTION OF DOMESTIC WATER PIPING SYSTEM

- C. DISINFECT WATER DISTRIBUTION SYSTEM IN ACCORDANCE WITH SECTION 330110.58.
- D. PRIOR TO STARTING WORK, VERIFY SYSTEM IS COMPLETE, FLUSHED, AND CLEAN.
- E. ENSURE ACIDITY (PH) OF WATER TO BE TREATED IS BETWEEN 7.4 AND 7.6 BY ADDING ALKALI (CAUSTIC SODA OR SODA ASH) OR ACID (HYDROCHLORIC).
- F. INJECT DISINFECTANT, FREE CHLORINE IN LIQUID, POWDER, TABLET, OR GAS FORM THROUGHOUT SYSTEM TO OBTAIN 50 TO 80 MG/L RESIDUAL.
- G. BLEED WATER FROM OUTLETS TO ENSURE DISTRIBUTION AND TEST FOR DISINFECTANT RESIDUAL AT MINIMUM 15 PERCENT OF OUTLETS.
- H. MAINTAIN DISINFECTANT IN SYSTEM FOR 24 HOURS.
- I. IF FINAL DISINFECTANT RESIDUAL TESTS LESS THAN 25 MG/L, REPEAT TREATMENT.
- J. FLUSH DISINFECTANT FROM SYSTEM UNTIL RESIDUAL EQUAL TO THAT OF INCOMING WATER OR 1.0 MG/L.
- K. TAKE SAMPLES NO SOONER THAN 24 HOURS AFTER FLUSHING, FROM 10 PERCENT OF OUTLETS AND FROM WATER ENTRY, AND ANALYZE IN ACCORDANCE WITH AWWA C651.

SECTION 224000 PLUMBING FIXTURES

1.01 SUBMITTALS

- A. PRODUCT DATA: PROVIDE CATALOG ILLUSTRATIONS OF FIXTURES, SIZES, ROUGH-IN DIMENSIONS, UTILITY SIZES, TRIM, AND FINISHES.

1.06 DELIVERY, STORAGE, AND HANDLING

- A. ACCEPT FIXTURES ON-SITE IN FACTORY PACKAGING. INSPECT FOR DAMAGE.
- B. PROTECT INSTALLED FIXTURES FROM DAMAGE BY SECURING AREAS AND BY LEAVING FACTORY PACKAGING IN PLACE TO PROTECT FIXTURES AND PREVENT USE.

2.01 GENERAL REQUIREMENTS

- A. POTABLE WATER SYSTEMS: PROVIDE PLUMBING FITTINGS AND FAUCETS THAT COMPLY WITH NSF 61 AND NSF 372 FOR MAXIMUM LEAD CONTENT; LABEL PIPE AND FITTINGS.

3.01 EXAMINATION

- A. VERIFY THAT WALLS AND FLOOR FINISHES ARE PREPARED AND READY FOR INSTALLATION OF FIXTURES.

3.02 INSTALLATION

- A. INSTALL EACH FIXTURE WITH TRAP, EASILY REMOVABLE FOR SERVICING AND CLEANING.

issued
PERMIT DRAWINGS
revised



THESE DRAWINGS AND SPECIFICATIONS, THE DESIGNS AND THE SERVICES REPRESENTED THEREBY ARE THE EXCLUSIVE PROPERTY OF THE OREGON GROUP ARCHITECTS, INC. NO PART OF THE DRAWINGS OR SPECIFICATIONS MAY BE REPRODUCED IN WHOLE OR IN PART, OR TO BE DISCLOSED TO ANY OTHER PERSON, WITHOUT THE EXPRESS CONSENT OF THE OREGON GROUP ARCHITECTS, INC.

OREGON GROUP ARCHITECTS
ARCHITECTURE IN FERNS CONSULTANTS
THE PERSONAL HOME
310 S. PATTERSON AVE DAYTON, OHIO 45402
937-226-1511 F 937-226-5663

office location for:
valley view board of education
6027 farmersville pike
germantown, ohio 45327
plumbing specifications

project number
251431
date
1/23/2026
drawn by
JEY
checked by
BHF

sheet
P O . 2
1785 S. METRO PARKWAY
CENTERVILLE, OH 45459
937.306.1630
800.334.1630
www.tri-tech.us
TRI-TECH
Built On Integrity
ENGINEERING AND PROJECT MANAGEMENT
TRI-TECH PROJECT #25194

issued
PERMIT DRAWINGS
revised
CODE COMMENTS
REVISIONS 2/2/2026

STATE OF OHIO
BENJAMIN HAROLD FLORKEN
2 FEB 2026
REGISTERED PROFESSIONAL ENGINEER

THESE DRAWINGS AND SPECIFICATIONS, THE DESIGNS AND DRAWINGS DISCLOSED OR REFERRED TO HEREIN, ARE THE PROPERTY OF THE OREGON GROUP ARCHITECTS, INC. THE DRAWINGS AND SPECIFICATIONS ARE THE EXCLUSIVE PROPERTY OF THE OREGON GROUP ARCHITECTS, INC. THE DRAWINGS AND SPECIFICATIONS ARE NOT TO BE REPRODUCED IN WHOLE OR IN PART, OR TO BE DISCLOSED TO ANY OTHER PERSON, WITHOUT THE EXPRESS CONSENT OF THE OREGON GROUP ARCHITECTS, INC. © 2001.

O REGON G ROUP A CHITECTS
ARCHITECTURE IN FERIOR CONSULTANTS

THE PERSONAL HOUSE
310 S. PATERSON BLVD. DAYTON, OHIO 45402
937-226-1511 F 937-226-5663

office renovation for:
valley view board of education
6027 farmersville pike
germantown, ohio 45327
plumbing demolition plan


project number
251431
date
1/23/2026
drawn by
JEW
checked by
BHF

sheet

P1.1

DEMOLITION NOTES:

1. DEMO EXISTING PLUMBING FIXTURE. NEW FIXTURE GOING BACK IN APPROXIMATELY THE SAME LOCATION. VERIFY DIMENSIONS WITH ARCHITECTURAL SET. REMOVE PIPE WITHIN WALL TO ACCOMMODATE THE NEW WALL CONSTRUCTION AND LOCATION. CUT AND PATCH FLOOR AS NECESSARY TO MODIFY DRAIN CONNECTION AND FIXTURE CARRIER LOCATION. REFER TO FLOOR PATCHING DETAIL IN ARCHITECTURAL SET.
2. DEMO EXISTING PLUMBING FIXTURE. NEW FIXTURE WILL BE IN A NEW LOCATION. VERIFY DIMENSIONS WITH ARCHITECTURAL SET. REMOVE PIPE WITHIN WALL. SHAVE OUT FLOOR AND REVERSE EXISTING ROUTING AS NECESSARY TO ACCOMMODATE NEW FIXTURE LOCATION. REFER TO FLOOR PATCHING DETAIL IN ARCHITECTURAL SET. COORDINATE WITH OTHERS IF MODIFICATIONS CAN BE MADE ABOVE FLOOR WITHIN WALLS AND CABINETS.
3. DEMO EXISTING PLUMBING FIXTURE. REMOVE AND CAP SUPPLY AND DRAIN BACK TO MAINS.
4. EXISTING DRAIN PIPE IN CEILING SERVES PLUMBING FIXTURES ABOVE. PIPE TO REMAIN UNLESS OTHERWISE NOTED. LOCATIONS SHOWN ARE APPROXIMATE BASED ON ORIGINAL BUILDING DRAWINGS AND LIMITED SITE VISITS. EXACT LOCATIONS MAY VARY.
5. EXISTING CONDENSATE DRAIN SERVES UNIT VENTILATOR ABOVE. LOCATIONS SHOWN ARE APPROXIMATE BASED ON ORIGINAL BUILDING DRAWINGS AND LIMITED SITE VISITS. EXACT LOCATIONS MAY VARY.
6. EXISTING DRINKING FOUNTAIN TO REMAIN.
7. EXISTING MANHOLE COVER LEADS TO WHAT IS AN ACID NEUTRALIZATION TANK. INDICATED IN THE 1968 BUILDING DRAWINGS. ITS PURPOSE IS TO TREAT THE WASTE WATER FROM THE CHEMISTRY LABORATORIES ABOVE. WHILE THE ROOMS REMAIN TODAY, THEY ARE NO LONGER BEING USED FOR CHEMISTRY ACTIVITIES. THE PIT SHALL REMAIN IN PLACE. VERIFY IN THE FIELD THE PRECISE LOCATION OF THE PIT AND NOTIFY THE ARCHITECT AND ENGINEER OF RECORD IF THE LID WILL BE OBSTRUCTED BY THE NEW WALL.

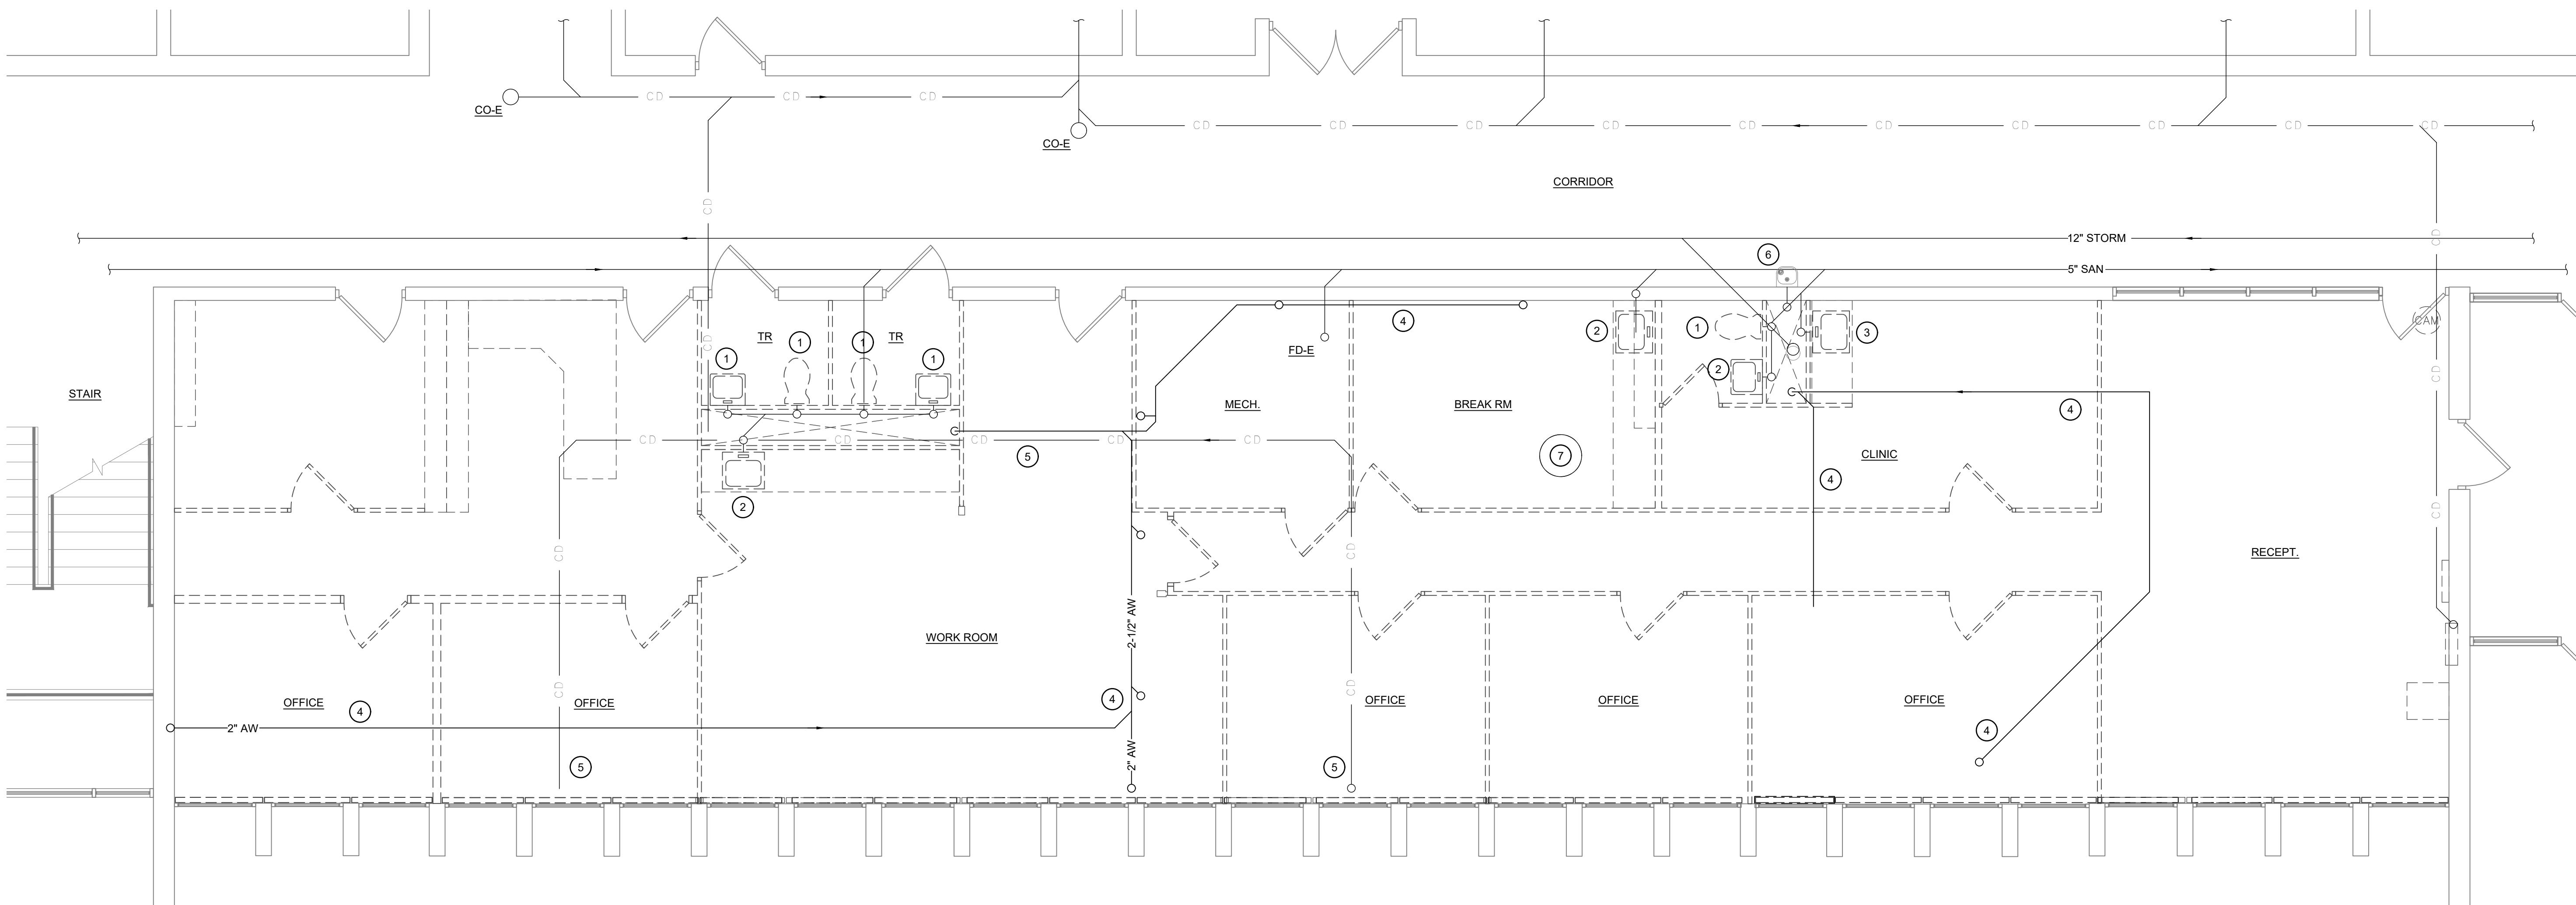

DEMOLITION FLOOR PLAN
SCALE: 1/4"=1'-0"

issued
PERMIT DRAWINGS
revised
CODE COMMENTS
REVISIONS 2/2/2026

STATE OF OHIO
BENJAMIN HAROLD FLORKEY
E-79700
2 FEB 2026
REGISTERED PROFESSIONAL ENGINEER

THESE DRAWINGS AND SPECIFICATIONS, THE DESIGNS DISCLOSED THEREIN, AND THE SERVICES REPRESENTED THEREBY ARE THE EXCLUSIVE PROPERTY OF THE OREGON GROUP ARCHITECTS, INC. NO PART OF THE PROJECTS USE THEREIN MAY BE REPRODUCED IN WHOLE OR IN PART, OR TO BE DISCLOSED TO ANY OTHER PERSON, WITHOUT THE EXPRESS CONSENT OF THE ARCHITECTS, INC. - 2001.

OREGON GROUP ARCHITECTS
ARCHITECTURE IN FERNS CONSULTANTS
THE PERSONAL HOUSE
310 S. PATERSON BLVD. DAYTON, OHIO 45402
937-226-1511 F 937-226-5663

office renovation for:
valley view board of education
6027 farmersville pike
germantown, ohio 45327
plumbing new work plan


project number
251431
date
1/23/2026
drawn by
JEY
checked by
BHF










 



sheet

P2.1

INSTALLATION NOTES:

1. PROVIDE NEW PLUMBING FIXTURE IN APPROXIMATELY THE SAME LOCATION AS THE EXISTING FIXTURE. REPLACE PIPE WITHIN WALL, PATCH FLOOR AS NECESSARY. REFER TO FLOOR PATCHING DETAIL IN ARCHITECTURAL SET. PROVIDE NEW FIXTURE CARRIER (WHERE APPLICABLE).
2. PROVIDE NEW PLUMBING FIXTURE IN NEW LOCATION. EXTEND PIPE IN WALL AND FLOOR BACK TO NEAREST TIE-IN POINT. PATCH FLOOR AS NECESSARY. REFER TO FLOOR PATCHING DETAIL IN ARCHITECTURAL SET. PROVIDE NEW FIXTURE CARRIER (WHERE APPLICABLE).
3. PROVIDE RO SYSTEM IN CABINET ADJACENT TO SINK. (SYSTEM NOT SHOWN.) PROVIDE COLD WATER LINE TO RO SYSTEM, DISCHARGE LINE TO SINK TAIL PIECE, AND FILTERED WATER SUPPLY TO SPOUT MOUNTED IN COUNTER NEXT TO SINK.
4. EXISTING MAN-HOLE COVER AND BASIN TO REMAIN. GENERAL CONTRACTOR TO COVER WITH FLOORING. DRAIN SYSTEM NO LONGER BEING USED FOR CHEMISTRY LABORATORIES AND WILL NOT REQUIRE REGULAR MAINTENANCE AS IT IS NO LONGER PROVIDING NEUTRALIZATION.

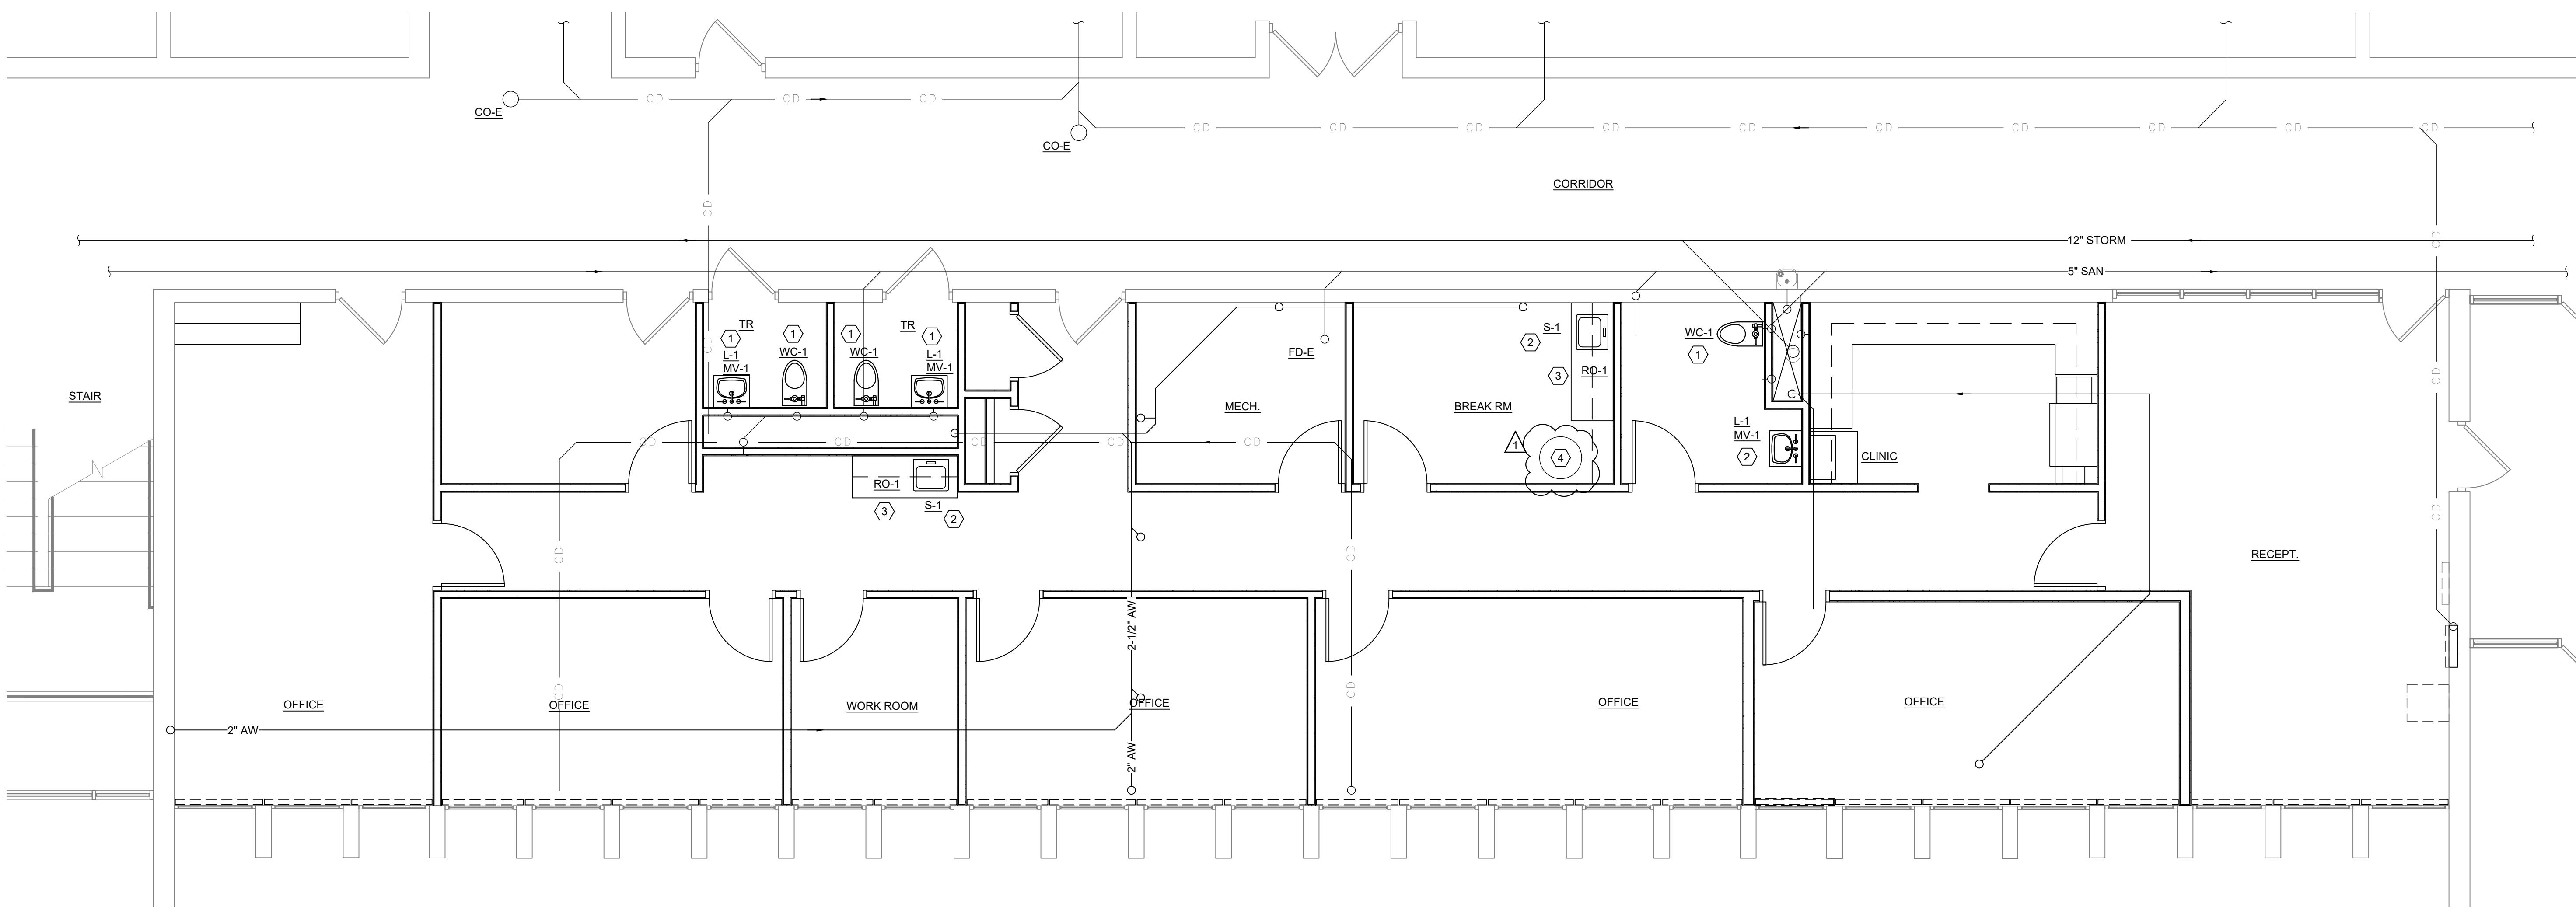

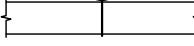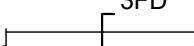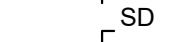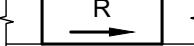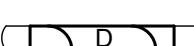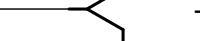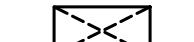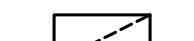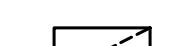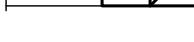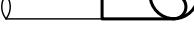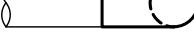SINGLE LINE DUCTWORK SYMBOLS		DOUBLE LINE DUCTWORK SYMBOLS		PIPING SYMBOLS		GENERAL MECHANICAL NOTES:		<p>issued PERMIT DRAWINGS revised _____</p> <p> BENJAMIN HAROLD FLORKEY E-79700 2 FEB 2026 REGISTERED PROFESSIONAL ENGINEER</p> <p>THESE DRAWINGS AND SPECIFICATIONS, THE DESIGNS AND SERVICES REPRESENTED THEREIN, ARE THE EXCLUSIVE PROPERTY OF THE OREGON GROUP, INC. THEY ARE TO BE RETURNED TO THE ARCHITECT AND ENGINEER AND NOT COPIED IN WHOLE OR IN PART, OR TO BE DISCLOSED TO ANYONE ELSE WITHOUT THE EXPRESS CONSENT OF THE ARCHITECTS, THE OREGON GROUP ARCHITECTS, INC. © 2001.</p> <p>OREGON GROUP ARCHITECTS ARCHITECTURE INTERIORS CONSULTANTS THE PANTAGE HOUSE 300 S. PATTERSON BLVD., DAYTON, OHIO 45402 937-228-1511 F 937-228-1669</p>																																																																																																																		
12x6	- RECTANGULAR DUCT (FIRST FIGURE IS FOR SIDE SHOWN, SECOND FIGURE IS FOR SIDE NOT SHOWN)	12x6	- RECTANGULAR DUCT (FIRST FIGURE IS FOR SIDE SHOWN, SECOND FIGURE IS FOR SIDE NOT SHOWN)	PA	- PIPE ANCHOR	1. UNLESS NOTED OTHERWISE, THIS CONTRACTOR SHALL PROVIDE AND INSTALL THE HVAC SYSTEMS, EXHAUST SYSTEMS, AND RADIANT HEATING SYSTEM COMPLETE. THE INSTALLATION SHALL INCLUDE, BUT NOT LIMITED TO, ALL DUCTWORK AND FITTINGS, EQUIPMENT, DIFFUSERS, SMOKE DETECTORS, THERMOSTATS AND 24 VAC WIRING, ROOF AND/OR WALL PENETRATIONS, TESTING AND BALANCING, ETC. CONTRACTOR SHALL COORDINATE PROVISIONS FOR PENETRATIONS IN BLOCK WALLS (I.E. SLEEVES, LINTELS, ETC.) WITH THE GENERAL CONTRACTOR.																																																																																																																				
8"Ø	- ROUND DUCT	12"Ø	- ROUND DUCT	PG	- PIPE GUIDE	2. THIS CONTRACTOR SHALL SECURE AND PAY FOR ALL NECESSARY PERMITS AND INSPECTIONS. ALL WORK SHALL BE PERFORMED IN ACCORDANCE WITH FEDERAL, STATE, AND LOCAL CODES.																																																																																																																				
36x18Ø	- FLAT OVAL DUCT (FIRST FIGURE IS FOR SIDE SHOWN, SECOND FIGURE IS FOR SIDE NOT SHOWN)	12x6Ø	- FLAT OVAL DUCT (FIRST FIGURE IS FOR SIDE SHOWN, SECOND FIGURE IS FOR SIDE NOT SHOWN)	EJ	- EXPANSION JOINT	3. IT IS INTENDED THAT WORK COVERED BY SPECIFICATIONS AND DRAWINGS INCLUDES EVERYTHING REQUISITE AND NECESSARY TO MAKE VARIOUS SYSTEMS COMPLETE AND OPERATIVE, IRRESPECTIVE OF WHETHER OR NOT EVERY ITEM IS SPECIFICALLY NOTED. OMISSION OF DIRECT REFERENCE TO ANY ESSENTIAL ITEM SHALL NOT EXCUSE CONTRACTOR FROM COMPLYING WITH ABOVE INTENT.																																																																																																																				
	- FLEXIBLE ROUND DUCT		- FLEXIBLE DUCT CONNECTION	V	- VENTURI	4. CONSULT THE ARCHITECTURAL, PLUMBING, AND ELECTRICAL DRAWINGS TO AVOID INTERFERENCES AND CONFLICTS WITH OTHER TRADES. THIS CONTRACTOR WILL BE EXPECTED TO COVER ALL REWORK COSTS DUE TO LACK OF COORDINATION.																																																																																																																				
	- FLEXIBLE DUCT CONNECTION		- VOLUME DAMPER	GV	- VALVE (GENERIC; BALL VALVE U.N.O.)	5. IN GENERAL, THE DRAWINGS SHOW THE DESIRED DUCT ROUTING LOCATION PLUS FITTINGS AND CONNECTIONS. THE DUCT AND ASSOCIATED EQUIPMENT CAN BE LOWERED OR RAISED AS NECESSARY TO ACCOMMODATE MINOR FIELD CONDITIONS. THE CONTRACTOR SHALL NOTE ALL CHANGES ON DRAWINGS AND RETURN MARKED UP DRAWINGS TO THE OWNER.																																																																																																																				
	- MOTORIZED DAMPER		- MOTORIZED DAMPER	GD	- GLOBE VALVE	6. FIELD VERIFY EXISTING CONDITIONS AND MAKE ADJUSTMENTS AS NECESSARY BEFORE BEGINNING WORK.																																																																																																																				
BDD	- BACK DRAFT DAMPER		- BACK DRAFT DAMPER	GV	- GATE VALVE	7. CONDUCT OPERATIONS IN STRICT ACCORDANCE WITH SAFETY REQUIREMENTS IMPOSED BY THE OWNER AND OSHA.																																																																																																																				
FD	- FIRE DAMPER, 1 1/2 HOUR FIRE RATED		- FIRE DAMPER, 1 1/2 HOUR FIRE RATED	NV	- NEEDLE VALVE	8. KEEP WORK AREA CLEAN, REMOVE DEBRIS FROM THE OWNER'S PROPERTY, AND DISPOSE OF SAME ACCORDING TO LOCAL REGULATIONS.																																																																																																																				
3FD	- FIRE DAMPER, 3 HOUR FIRE RATED		- COMBINATION FIRE/SMOKE DAMPER	HVC	- HOSE VALVE WITH CAP	9. INSTALL WORK SO AS TO BE READILY ACCESSIBLE FOR OPERATION, MAINTENANCE, AND REPAIR; MINOR DEVIATIONS FROM DRAWINGS MAY BE MADE TO ACCOMPLISH THIS. CHANGES SHALL NOT BE MADE WITHOUT APPROVAL OF THE OWNER.																																																																																																																				
FSD	- FIRE DAMPER, 3 HOUR FIRE RATED		- COMBINATION FIRE/SMOKE DAMPER	BFV	- BUTTERFLY VALVE	10. DEMONSTRATE OPERATION OF SYSTEMS AND EQUIPMENT TO THE OWNER. THE OPERATING AND SERVICE MANUALS FOR ALL EQUIPMENT SHALL BE FURNISHED TO THE OWNER.																																																																																																																				
SD	- SMOKE DAMPER		- SMOKE DAMPER	CV	- CHECK VALVE	11. DUCT SHALL BE CONSTRUCTED AND INSTALLED MEETING THE REQUIREMENTS OF THE SMACNA HVAC DUCT CONSTRUCTION STANDARDS, METAL AND FLEXIBLE, LATEST EDITION, AND AS DESCRIBED BELOW.																																																																																																																				
	- DUCT TRANSITION		- DUCT TRANSITION, RECTANGULAR TO ROUND OR FLAT OVAL	BV	- BACKFLOW PREVENTER	A. HANGERS SHALL BE PROVIDED A MAXIMUM OF EVERY 8'-0". AT ROOF PENETRATIONS AND AT ALL ELBOWS. ALL DUCTS SHALL BE SELF-SUPPORTING AND NOT REQUIRE CONNECTING EQUIPMENT FOR SUPPORT.																																																																																																																				
	- INCLINED RISE WITH RESPECT TO AIR FLOW, RECTANGULAR		- INCLINED RISE WITH RESPECT TO AIR FLOW, RECTANGULAR	BV	- BALANCING VALVE	B. ALIGN, ADJUST, AND LEVEL ALL DUCT FOR SATISFACTORY OPERATION. IF A SLOPE IS SPECIFIED, ALIGN AND ADJUST TO MEET STATED REQUIREMENTS.																																																																																																																				
	- INCLINED DROP WITH RESPECT TO AIR FLOW, RECTANGULAR		- INCLINED DROP WITH RESPECT TO AIR FLOW, RECTANGULAR	PV	- PLUG VALVE	C. REINFORCE ALL DUCTS TO PREVENT BREATHING, VIBRATING, BUCKLING, OR UNNECESSARY NOISE AS REQUIRED TO SATISFY PROJECT REQUIREMENTS.																																																																																																																				
	- INCLINED RISE WITH RESPECT TO AIR FLOW, ROUND OR FLAT OVAL		- INCLINED RISE WITH RESPECT TO AIR FLOW, ROUND OR FLAT OVAL	SV	- SOLENOID VALVE	D. DUCT AND PLENUM SIZES SHOWN ARE INSIDE CLEAR DIMENSIONS, UNLESS NOTED OTHERWISE. IT IS ACCEPTABLE TO CHANGE DUCT SIZES WHEN THE CROSS-SECTIONAL AREA IS MAINTAINED.																																																																																																																				
	- INCLINED DROP WITH RESPECT TO AIR FLOW, ROUND OR FLAT OVAL		- INCLINED DROP WITH RESPECT TO AIR FLOW, ROUND OR FLAT OVAL	SPRV	- SAFETY / PRESSURE RELIEF, ANGLE VALVE																																																																																																																					
	- 90° ELBOW (SMOOTH OR 5 PIECE ELBOW)		- 90° ELBOW (SMOOTH OR 5 PIECE ELBOW)	SPRV	- SAFETY / PRESSURE RELIEF, STRAIGHT THRU VALVE																																																																																																																					
	- 45° ELBOW (SMOOTH OR 3 PIECE ELBOW)		- 45° ELBOW (SMOOTH OR 3 PIECE ELBOW)	PRV	- PRESSURE REGULATING VALVE																																																																																																																					
	- DIVIDED FLOW FITTING, RECTANGULAR		- TAP-IN BRANCH, RECTANGULAR	ACV	- AUTOMATIC CONTROL VALVE, 2 WAY																																																																																																																					
	- RECTANGULAR TAP-IN BRANCH OR ROUND OR FLAT OVAL CONICAL TEE		- BRANCH DUCT, CONICAL LATERAL FITTING, ROUND OR FLAT OVAL	LY	- AUTOMATIC CONTROL VALVE, 3 WAY																																																																																																																					
	- INCLINED CONICAL TAKE-OFF, ROUND OR FLAT OVAL		- BRANCH DUCT, CONICAL TEE FITTING, ROUND OR FLAT OVAL	C	- LATERAL Y																																																																																																																					
	- "Y" FITTING, ROUND OR FLAT OVAL		- BRANCH DUCT, "Y" FITTING, ROUND OR FLAT OVAL	E90	- CAP																																																																																																																					
	- 90° ELBOW TURNED UP, RECTANGULAR		- BRANCH DUCT, "Y" FITTING, ROUND OR FLAT OVAL	E90	- ELBOW, 90°																																																																																																																					
	- 90° ELBOW TURNED DOWN, RECTANGULAR		- BRANCH DUCT, "Y" FITTING, ROUND OR FLAT OVAL	E90	- ELBOW, 90° TURNED UP																																																																																																																					
	- 90° ELBOW TURNED UP, ROUND; FLAT OVAL SIMILAR		- BRANCH DUCT, "Y" FITTING, ROUND OR FLAT OVAL	E90	- ELBOW, 90° TURNED DOWN																																																																																																																					
	- 90° ELBOW TURNED DOWN, ROUND; FLAT OVAL SIMILAR		- BRANCH DUCT, "Y" FITTING, ROUND OR FLAT OVAL	E45	- ELBOW, 45°																																																																																																																					
	- STATIC PRESSURE SENSOR		- 90° ELBOW TURNED UP, RECTANGULAR	TEE																																																																																																																						
	- END OF DUCT RUN		- 90° ELBOW TURNED DOWN, RECTANGULAR	TEETURNEDUP																																																																																																																						
	- THERMOSTAT		- 90° ELBOW TURNED UP, ROUND; FLAT OVAL SIMILAR	TEETURNEDDOWN																																																																																																																						
	- TERMINAL REHEAT BOX		- 90° ELBOW TURNED DOWN, ROUND; FLAT OVAL SIMILAR	REDUCERCONCENTRIC																																																																																																																						
	- EXISTING PIPING TO REMAIN		- UNION																																																																																																																							
	- EXISTING PIPING TO BE REMOVED		- STRAINER																																																																																																																							
	- REFRIGERANT SUPPLY PIPING		- METER																																																																																																																							
	- REFRIGERANT RETURN PIPING		- REGULATOR																																																																																																																							
	- HOT WATER SUPPLY PIPING																																																																																																																									
	- HOT WATER RETURN PIPING																																																																																																																									
	- CHILLED WATER SUPPLY PIPING																																																																																																																									
	- CHILLED WATER RETURN PIPING																																																																																																																									
	- GAS PIPING																																																																																																																									
	- POINT OF CONNECTION																																																																																																																									
	- POINT OF REMOVAL																																																																																																																									
<p>office renovation for: valley view board of education 6027 farmersville pike germantown, ohio 45327 mechanical general notes and legends</p> <p>project number 251431 date 1/23/2026 drawn by JEY checked by BHF</p> <p>sheet</p> <p>TRI-TECH Built On Integrity ENGINEERING AND PROJECT MANAGEMENT 1785 S. METRO PARKWAY CENTERVILLE, OH 45459 WWW.TRITECHJUS 937.306.1690 800.334.1630 TRI-TECH PROJECT #25194</p> <p>M.O. 1</p>																																																																																																																										
<p>DUCT INSULATION SCHEDULE</p> <table border="1"> <thead> <tr> <th rowspan="3">DUCTWORK SERVICE</th> <th colspan="3">EXPOSED IN OCCUPIED SPACE</th> <th colspan="3">ABOVE CEILING / CONDITIONED ATTIC</th> <th colspan="3">NON-CONDITIONED ATTIC</th> <th colspan="3">OUTSIDE BUILDING</th> <th rowspan="3">NOTES</th> </tr> <tr> <th rowspan="2">MINIMUM R-VALUE</th> <th rowspan="2">INSULATION LOCATION</th> <th rowspan="2">JACKET</th> </tr> <tr> <th>WRAP</th> <th>DBL WALL - SOLID</th> <th>DBL WALL - PERF.</th> <th>WRAP</th> <th>DBL WALL - SOLID</th> <th>DBL WALL - PERF.</th> <th>WRAP</th> <th>DBL WALL - SOLID</th> <th>DBL WALL - PERF.</th> <th>WRAP</th> <th>DBL WALL - SOLID</th> <th>DBL WALL - PERF.</th> </tr> </thead> <tbody> <tr> <td>N/A</td><td>R6</td><td>R12</td><td>N/A</td><td>LINING</td><td>WRAP</td><td>N/A</td><td>PVC</td><td>ALUMINUM</td><td>N/A</td><td>PVC</td><td>ALUMINUM</td><td>N/A</td> </tr> <tr> <td>R6</td><td>R12</td><td>R12</td><td>N/A</td><td>WRAP</td><td>DBL WALL - SOLID</td><td>N/A</td><td>WRAP</td><td>DBL WALL - SOLID</td><td>N/A</td><td>WRAP</td><td>DBL WALL - SOLID</td><td>N/A</td> </tr> <tr> <td>R12</td><td>R12</td><td>R12</td><td>N/A</td><td>DBL WALL - PERF.</td><td>DBL WALL - PERF.</td><td>N/A</td><td>DBL WALL - PERF.</td><td>DBL WALL - PERF.</td><td>N/A</td><td>DBL WALL - PERF.</td><td>DBL WALL - PERF.</td><td>N/A</td> </tr> <tr> <td></td><td></td><td></td><td></td><td></td><td></td><td></td><td></td><td></td><td></td><td></td><td></td><td></td> </tr> <tr> <td>SUPPLY</td><td>●</td><td>●</td><td>●</td><td>●</td><td>●</td><td>●</td><td>●</td><td>●</td><td>●</td><td>●</td><td>●</td><td>●</td> </tr> <tr> <td>RETURN</td><td>●</td><td>●</td><td>●</td><td>●</td><td>●</td><td>●</td><td>●</td><td>●</td><td>●</td><td>●</td><td>●</td><td>●</td> </tr> <tr> <td>EXHAUST</td><td>●</td><td>●</td><td>●</td><td>●</td><td></td></tr></tbody></table>	DUCTWORK SERVICE	EXPOSED IN OCCUPIED SPACE			ABOVE CEILING / CONDITIONED ATTIC			NON-CONDITIONED ATTIC			OUTSIDE BUILDING			NOTES	MINIMUM R-VALUE	INSULATION LOCATION	JACKET	MINIMUM R-VALUE	INSULATION LOCATION	JACKET	MINIMUM R-VALUE	INSULATION LOCATION	JACKET	MINIMUM R-VALUE	INSULATION LOCATION	JACKET	WRAP	DBL WALL - SOLID	DBL WALL - PERF.	WRAP	DBL WALL - SOLID	DBL WALL - PERF.	WRAP	DBL WALL - SOLID	DBL WALL - PERF.	WRAP	DBL WALL - SOLID	DBL WALL - PERF.	N/A	R6	R12	N/A	LINING	WRAP	N/A	PVC	ALUMINUM	N/A	PVC	ALUMINUM	N/A	R6	R12	R12	N/A	WRAP	DBL WALL - SOLID	N/A	WRAP	DBL WALL - SOLID	N/A	WRAP	DBL WALL - SOLID	N/A	R12	R12	R12	N/A	DBL WALL - PERF.	DBL WALL - PERF.	N/A	DBL WALL - PERF.	DBL WALL - PERF.	N/A	DBL WALL - PERF.	DBL WALL - PERF.	N/A														SUPPLY	●	●	●	●	●	●	●	●	●	●	●	●	RETURN	●	●	●	●	●	●	●	●	●	●	●	●	EXHAUST	●	●	●	●	
DUCTWORK SERVICE		EXPOSED IN OCCUPIED SPACE			ABOVE CEILING / CONDITIONED ATTIC			NON-CONDITIONED ATTIC			OUTSIDE BUILDING																NOTES																																																																																															
		MINIMUM R-VALUE	INSULATION LOCATION	JACKET	MINIMUM R-VALUE	INSULATION LOCATION	JACKET	MINIMUM R-VALUE	INSULATION LOCATION	JACKET	MINIMUM R-VALUE	INSULATION LOCATION	JACKET																																																																																																													
	WRAP													DBL WALL - SOLID	DBL WALL - PERF.	WRAP	DBL WALL - SOLID	DBL WALL - PERF.	WRAP	DBL WALL - SOLID	DBL WALL - PERF.	WRAP	DBL WALL - SOLID	DBL WALL - PERF.																																																																																																		
N/A	R6	R12	N/A	LINING	WRAP	N/A	PVC	ALUMINUM	N/A	PVC	ALUMINUM	N/A																																																																																																														
R6	R12	R12	N/A	WRAP	DBL WALL - SOLID	N/A	WRAP	DBL WALL - SOLID	N/A	WRAP	DBL WALL - SOLID	N/A																																																																																																														
R12	R12	R12	N/A	DBL WALL - PERF.	DBL WALL - PERF.	N/A	DBL WALL - PERF.	DBL WALL - PERF.	N/A	DBL WALL - PERF.	DBL WALL - PERF.	N/A																																																																																																														
SUPPLY	●	●	●	●	●	●	●	●	●	●	●	●																																																																																																														
RETURN	●	●	●	●	●	●	●	●	●	●	●	●																																																																																																														
EXHAUST	●	●	●	●																																																																																																																						

MECHANICAL SPECIFICATIONS:

SECTION 23053 IDENTIFICATION FOR HVAC PIPING AND EQUIPMENT

1.0 IDENTIFICATION APPLICATIONS

- A. AIR HANDLING UNITS: NAMEPLATES.
- B. HOT WATER COILS: TAGS.
- C. VALVES: TAGS

2.1 NAMEPLATES

- A. LETTER COLOR: WHITE.
- B. LETTER HEIGHT: 1/4 INCH (6 MM).
- C. BACKGROUND COLOR: BLACK.
- D. PLASTIC: COMPLY WITH ASTM D709.

2.2 TAGS

- A. PLASTIC TAGS: LAMINATED THREE-LAYER PLASTIC WITH ENGRAVED BLACK LETTERS ON LIGHT CONTRASTING BACKGROUND COLOR. TAG SIZE MINIMUM 1-1/2 INCH (40 MM) DIAMETER.

3.01 INSTALLATION

- A. INSTALL NAMEPLATES WITH CORROSIVE-RESISTANT MECHANICAL FASTENERS, OR ADHESIVE. APPLY WITH SUFFICIENT ADHESIVE TO ENSURE PERMANENT ADHESION AND SEAL WITH CLEAR LACQUER.
- B. INSTALL TAGS WITH CORROSION RESISTANT CHAIN.

SECTION 230593 TESTING, ADJUSTING, AND BALANCING FOR HVAC

1.03 SUBMITTALS

- A. FINAL REPORT: INDICATE DEFICIENCIES IN SYSTEMS THAT WOULD PREVENT PROPER TESTING, ADJUSTING, AND BALANCING OF SYSTEMS AND EQUIPMENT TO ACHIEVE SPECIFIED PERFORMANCE.
- 1. REVISE TAB PLAN TO REFLECT ACTUAL PROCEDURES AND SUBMIT AS PART OF FINAL REPORT.
- 2. SUBMIT DRAFT COPIES OF REPORT FOR REVIEW PRIOR TO FINAL ACCEPTANCE OF PROJECT. PROVIDE FINAL COPIES FOR ARCHITECT AND FOR INCLUSION IN OPERATING AND MAINTENANCE MANUALS.
- 3. INCLUDE ACTUAL INSTRUMENT LIST, WITH MANUFACTURER NAME, SERIAL NUMBER, AND DATE OF CALIBRATION.
- 4. FORM OF TEST REPORTS: WHERE THE TAB STANDARD BEING FOLLOWED RECOMMENDS A REPORT FORMAT USE THAT; OTHERWISE, FOLLOW ASHRAE STD 111.
- 5. UNITS OF MEASURE: REPORT DATA IN BOTH I-P (INCH-POUND) AND SI (METRIC) UNITS.

3.02 EXAMINATION

- A. VERIFY THAT SYSTEMS ARE COMPLETE AND OPERABLE BEFORE COMMENCING WORK. ENSURE THE FOLLOWING CONDITIONS:

 1. SYSTEMS ARE STARTED AND OPERATING IN A SAFE AND NORMAL CONDITION.
 2. TEMPERATURE CONTROL SYSTEMS ARE INSTALLED COMPLETE AND OPERABLE.
 3. PROPER THERMAL OVERLOAD PROTECTION IS IN PLACE FOR ELECTRICAL EQUIPMENT.
 4. FINAL FILTERS ARE CLEAN AND IN PLACE. IF REQUIRED, INSTALL TEMPORARY MEDIA IN ADDITION TO FINAL FILTERS.
 5. DUCT SYSTEMS ARE CLEAN OF DEBRIS.
 6. FANS ARE ROTATING CORRECTLY.
 7. FIRE AND VOLUME DAMPERS ARE IN PLACE AND OPEN.
 8. AIR COIL FINS ARE CLEANED AND COMBED.
 9. AIR OUTLETS ARE INSTALLED AND CONNECTED.
 10. DUCT SYSTEM LEAKAGE IS MINIMIZED.

3.04 ADJUSTMENT TOLERANCES

- A. AIR HANDLING SYSTEMS: ADJUST TO WITHIN PLUS OR MINUS 5 PERCENT OF DESIGN FOR SUPPLY SYSTEMS AND PLUS OR MINUS 10 PERCENT OF DESIGN FOR RETURN AND EXHAUST SYSTEMS.
- B. AIR OUTLETS AND INLETS: ADJUST TOTAL TO WITHIN PLUS 10 PERCENT AND MINUS 5 PERCENT OF DESIGN TO SPACE. ADJUST OUTLETS AND INLETS IN SPACE TO WITHIN PLUS OR MINUS 10 PERCENT OF DESIGN.
- C. WATER FLOW: ADJUST TO WITHIN PLUS OR MINUS 10 PERCENT OF DESIGN.

3.07 SCOPE

- A. TEST, ADJUST, AND BALANCE THE FOLLOWING:

 1. SPLIT SYSTEM AIR HANDLING UNIT.
 2. IN-DUCT HOT WATER COILS.
 3. FIN TUBE.
 4. AIR INLETS AND OUTLETS.

SECTION 230713 DUCT INSULATION

1.04 SUBMITTALS

- A. PRODUCT DATA: PROVIDE PRODUCT DESCRIPTION, THERMAL CHARACTERISTICS, LIST OF MATERIALS AND THICKNESS FOR EACH SERVICE, AND LOCATIONS.

2.01 REGULATORY REQUIREMENTS

- A. SURFACE BURNING CHARACTERISTICS: FLAME SPREAD INDEX/SMOKE DEVELOPED INDEX OF 25/60, MAXIMUM, WHEN TESTED IN ACCORDANCE WITH ASTM E84 OR UL 723.

2.02 GLASS FIBER, FLEXIBLE

- A. INSULATION ASTM C553; FLEXIBLE, NONCOMBUSTIBLE BLANKET.

 1. MAXIMUM SERVICE TEMPERATURE: 1,200 DEGREES F (649 DEGREES C).
 2. MAXIMUM WATER VAPOR ABSORPTION: 5.0 PERCENT BY WEIGHT.

- B. VAPOR BARRIER JACKET:

 1. KRAFT PAPER WITH GLASS FIBER YARN AND BONDED TO ALUMINIZED FILM.
 2. MOISTURE VAPOR PERMEABILITY: 0.02 PERM INCH (0.029 NG/(PA S M)), WHEN TESTED IN ACCORDANCE WITH ASTM E96/E96M.
 3. SECURE WITH PRESSURE-SENSITIVE TAPE.

3.01 EXAMINATION

- A. TEST DUCTWORK FOR DESIGN PRESSURE PRIOR TO APPLYING INSULATION MATERIALS.
- B. VERIFY THAT SURFACES ARE CLEAN, FOREIGN MATERIAL REMOVED, AND DRY.

3.02 INSTALLATION

- A. INSTALL IN ACCORDANCE WITH MANUFACTURER'S INSTRUCTIONS.
- B. INSULATED DUCTS CONVEYING AIR BELOW AMBIENT TEMPERATURE:
 1. PROVIDE INSULATION WITH VAPOR BARRIER JACKETS.
 2. FINISH WITH TAPE AND VAPOR BARRIER JACKET.
 3. CONTINUE INSULATION THROUGH WALLS, SLEEVES, HANGERS, AND OTHER DUCT PENETRATIONS.
 4. INSULATE ENTIRE SYSTEM, INCLUDING FITTINGS, JOINTS, FLANGES, FIRE DAMPERS, FLEXIBLE CONNECTIONS, AND EXPANSION JOINTS.

SECTION 230923 DIRECT DIGITAL CONTROL SYSTEM FOR HVAC

1.0 SYSTEM DESCRIPTION

- A. EXISTING SYSTEM TO BE INTEGRATED INTO
 - A.A. SYSTEM PLATFORM: TRIDIUM NIAGARA
 - A.B. OWNER'S CONTROLS CONTRACTOR: POINT TO POINT SYSTEMS 1-800-685-2082
- B. AUTOMATIC TEMPERATURE CONTROL FIELD MONITORING AND CONTROL SYSTEM USING FIELD PROGRAMMABLE MICRO-PROCESSOR BASED UNITS.
- C. BASE SYSTEM ON DISTRIBUTED SYSTEM OF FULLY INTELLIGENT, STAND-ALONE CONTROLLERS, OPERATING IN A MULTI-TASKING, MULTI-USER ENVIRONMENT ON TOKEN PASSING NETWORK, WITH LOCAL AND REMOTE HARDWARE, SOFTWARE, AND INTERCONNECTING WIRE AND CONDUIT.
- D. INCLUDE OPERATOR INPUT / OUTPUT DEVICES, CONTROL UNITS, LOCAL AREA NETWORKS, SENSORS, CONTROL DEVICES, ACTUATORS.
- E. CONTROLS FOR RADIATION, REHEAT COILS, FAN COILS, AND THE LIKE WHEN DIRECTLY CONNECTED TO THE CONTROL UNITS.
- F. PROVIDE CONTROL SYSTEMS CONSISTING OF THERMOSTATS, CONTROL VALVES, DAMPERS AND ACTUATORS, INDICATING DEVICES, INTERFACE EQUIPMENT AND OTHER APPARATUS AND ACCESSORIES REQUIRED TO OPERATE MECHANICAL SYSTEMS. AND TO PERFORM FUNCTIONS SPECIFIED.
- G. INCLUDE INSTALLATION AND CALIBRATION, SUPERVISION, ADJUSTMENTS, AND FINE TUNING NECESSARY FOR COMPLETE AND FULLY OPERATIONAL SYSTEM.

2.0 EXECUTION

2.01 EXAMINATION

- A. VERIFY EXISTING CONDITIONS BEFORE STARTING WORK
- B. VERIFY THAT CONDITIONAL POWER SUPPLY IS AVAILABLE TO THE CONTROL. VERIFY THAT FIELD END DEVICES, AND WIRING IS INSTALLED PRIOR TO INSTALLATION PROCEEDING.

2.02 INSTALLATION

- A. INSTALL CONTROL UNITS AND OTHER HARDWARE IN POSITION ON PERMANENT WALLS WHERE NOT SUBJECT TO EXCESSIVE VIBRATION.
- B. PROVIDE CONDUIT AND ELECTRICAL WIRING IN ACCORDANCE WITH SECTION 260583. ELECTRICAL MATERIALS AND INSTALLATION SHALL BE IN ACCORDANCE WITH APPROPRIATE REQUIREMENTS.

2.03 DEMONSTRATION AND INSTRUCTIONS

- A. DEMONSTRATE COMPLETE AND OPERATING SYSTEM TO OWNER.

SECTION 232113 HYDRONIC PIPING

1.01 SUBMITTALS

- A. INCLUDE DATA ON PIPE MATERIAL, FITTINGS, VALVES, AND ACCESSORIES.

2.01 HYDRONIC SYSTEM REQUIREMENTS

- A. PIPING: PROVIDE PIPING, FITTINGS, HANGERS, AND SUPPORTS AS REQUIRED, AS INDICATED, AND AS FOLLOWS:
 - A.A. WHERE MORE THAN ONE PIPING SYSTEM MATERIAL IS SPECIFIED, PROVIDE JOINING FITTINGS THAT ARE COMPATIBLE WITH PIPING MATERIALS AND ENSURE THAT THE INTEGRITY OF THE SYSTEM IS NOT JEOPARDIZED.
 - A.B. USE NON-CONDUCTING DIELECTRIC CONNECTIONS WHERE JOINING DISSIMILAR METALS.
- B. PIPE-TO-VALVE AND PIPE-TO-EQUIPMENT CONNECTIONS: USE FLANGES OR UNIONS TO ALLOW DISCONNECTION OF COMPONENTS FOR SERVICING; DO NOT USE DIRECT WELDED, SOLDERED, OR THREADED CONNECTIONS.

2.02 HEATING WATER PIPING, ABOVE GRADE

- A. STEEL PIPE: ASTM A53/A53M, SCHEDULE 40, BLACK, THREADED OR WELDED JOINTS.
- B. COPPER TUBE: ASTM B88, TYPE K, DRAWN, USING MECHANICAL PRESS SEALED FITTINGS.

3.01 PREPARATION

- A. REAM PIPE AND TUBE ENDS. REMOVE BURRS. BEVEL PLAIN END FERROUS PIPE.
- B. REMOVE SCALE AND DIRT ON INSIDE AND OUTSIDE BEFORE ASSEMBLY.
- C. AFTER COMPLETION, FILL, CLEAN, AND TREAT SYSTEM.

3.02 INSTALLATION

- A. INSTALL IN ACCORDANCE WITH MANUFACTURER'S INSTALLATIONS.
- B. ROUTE PIPING IN ORDERLY MANNER, PARALLEL TO BUILDING STRUCTURE, AND MAINTAIN GRADIENT.
- C. INSTALL PIPING TO CONSERVE BUILDING SPACE AND TO AVOID INTERFERENCE WITH USE OF SPACE.
- D. GROUP PIPING WHENEVER PRACTICAL AT COMMON ELEVATIONS.
- E. SLOPE PIPING AND ARRANGE TO DRAIN AT LOW POINTS.

SECTION 232300 REFRIGERANT PIPING

1.01 PIPING

- A. COPPER TUBE: ASTM B280, H58 HARD DRAWN OR O60 SOFT ANNEALED.

2.01 INSTALLATION

- A. INSTALL REFRIGERATION SPECIALTIES IN ACCORDANCE WITH MANUFACTURER'S INSTRUCTIONS.
- B. ROUTE PIPING IN ORDERLY MANNER, WITH PLUMBING PARALLEL TO BUILDING STRUCTURE, AND MAINTAIN GRADIENT.
- C. INSTALL PIPING TO CONSERVE BUILDING SPACE AND AVOID INTERFERENCE WITH USE OF SPACE.
- D. INSTALL PIPING TO ALLOW FOR EXPANSION AND CONTRACTION WITHOUT STRESSING PIPE, JOINTS, OR CONNECTED EQUIPMENT.

E. PIPE HANGERS AND SUPPORTS:

- 1. INSTALL IN ACCORDANCE WITH ASME B31.5.
- 2. INSTALL HANGERS TO PROVIDE MINIMUM 1/2 INCH (13 MM) SPACE BETWEEN FINISHED COVERING AND ADJACENT WORK.
- 3. PLACE HANGERS WITHIN 12 INCHES (300 MM) OF EACH HORIZONTAL ELBOW.

SECTION 233100 HVAC DUCTS AND CASINGS

2.01 GENERAL REQUIREMENTS

- A. PROVIDE UL CLASS 1 DUCTWORK, FITTINGS, HANGERS, SUPPORTS, AND APPURTENANCES IN ACCORDANCE WITH NFPA 90A AND SMACNA (DCS) GUIDELINES UNLESS STATED OTHERWISE.
- B. PROVIDE METAL DUCT UNLESS OTHERWISE INDICATED. FIBROUS GLASS DUCT CAN BE SUBSTITUTED AT THE CONTRACTOR'S OPTION.

- C. ACOUSTICAL TREATMENT: PROVIDE SOUND-ABSORBING LINERS AND SECTIONAL SILENCERS FOR METAL-BASED DUCTS IN COMPLIANCE WITH SECTION 23319.

D. DUCT SHAPE AND MATERIAL IN ACCORDANCE WITH ALLOWED STATIC PRESSURE RANGE:

- 1. ROUND: PLUS OR MINUS 2 IN-WC (500 PA) OF GALVANIZED STEEL.
- 2. RECTANGULAR: PLUS OR MINUS 2 IN-WC (500 PA) OF GALVANIZED STEEL.

E. DUCT SEALING AND LEAKAGE IN ACCORDANCE WITH STATIC PRESSURE CLASS:

- 1. DUCT PRESSURE CLASS AND MATERIAL FOR COMMON MECHANICAL VENTILATION APPLICATIONS:
 - a. SUPPLY AIR: 1 IN-WC (250 PA) PRESSURE CLASS, GALVANIZED STEEL.
 - b. RETURN AND RELIEF AIR: 1/2 IN-WC (125 PA) PRESSURE CLASS, GALVANIZED STEEL.
 - c. GENERAL EXHAUST AIR: 1/2 IN-WC (125 PA) PRESSURE CLASS, GALVANIZED STEEL.

F. DUCT FABRICATION REQUIREMENTS:

- 1. DUCT AND FITTING FABRICATION AND SUPPORT: SMACNA (DCS) INCLUDING SPECIFICATIONS FOR CONTINUOUSLY WELDED ROUND AND OVAL DUCT FITTINGS.
- 2. USE REINFORCED AND SEALED SHEET-METAL MATERIALS AT RECOMMENDED GAUGES FOR INDICATED OPERATING PRESSURES OR PRESSURE CLASS.
- 3. CONSTRUCT TEES, BENDS, AND ELBOWS WITH RADIUS OF NOT LESS THAN 1-1/2 TIMES WIDTH OF DUCT ON CENTERLINE, WHERE NOT POSSIBLE AND WHERE RECTANGULAR ELBOWS MUST BE USED, PROVIDE AIRFOIL TURNING VANES OF PERFORATED METAL WITH GLASS FIBER INSULATION.
- 4. PROVIDE TURNING VANES OF PERFORATED METAL WITH GLASS FIBER INSULATION WHEN ACOUSTICAL LINING IS INDICATED.
- 5. INCREASE DUCT SIZES GRADUALLY, NOT EXCEEDING 15 DEGREES DIVERGENCE WHEREVER POSSIBLE; MAXIMUM 30 DEGREES DIVERGENCE UPSTREAM OF EQUIPMENT AND 45 DEGREES CONVERGENCE DOWNSTREAM.
- 6. PROVIDE TURNING VANES OF PERFORATED METAL WITH GLASS FIBER INSULATION WHEN AN ACOUSTICAL LINING IS REQUIRED.
- 7. WHERE DUCTS ARE CONNECTED TO EXTERIOR WALL LOUVERS AND DUCT OUTLET IS SMALLER THAN LOUVER FRAME, PROVIDE BLANK-OUT PANELS SEALING LOUVER AREA AROUND DUCT. USE SAME MATERIAL AS DUCT, PAINTED BLACK ON EXTERIOR SIDE; SEAL TO LOUVER FRAME AND DUCT.

2.02 METAL DUCTS

A. MATERIAL REQUIREMENTS:

- 1. GALVANIZED STEEL: HOT-DIPPED GALVANIZED STEEL SHEET, ASTM A653/A653M FS TYPE B, WITH G60/Z180 COATING.

B. ROUND METAL DUCTS:

- 1. ROUND CONNECTION SYSTEM: INTERLOCKING DUCT CONNECTION SYSTEM IN ACCORDANCE WITH SMACNA (DCS).

C. ROUND SPIRAL DUCT:

- 1. ROUND SPIRAL LOCK SEAM DUCT WITH GALVANIZED STEEL OUTER WALL.

2.03 FLEXIBLE DUCTS

- A. FLEXIBLE DUCTS: UL 181, CLASS 1, POLYETHYLENE FILM, MECHANICALLY FASTENED AND ROLLED USING GALVANIZED STEEL TO FORM SPIRAL HELIX.
 - 1. INSULATION: R6 INSULATION WITH POLYETHYLENE VAPOR BARRIER FILM.
 - 2. PRESSURE RATING: 10 IN-WC (2.50 KPA) POSITIVE AND 5 IN-WC (1.25 KPA) NEGATIVE.
 - 3. MAXIMUM VELOCITY: 5500 FPM (27.9 M/SEC).
 - 4. TEMPERATURE RANGE: MINUS 20 DEGREES F TO 250 DEGREES F (MINUS 28 DEGREES C TO 121 DEGREES C).

3.01 INSTALLATION

- A. INSTALL, SUPPORT, AND SEAL DUCTS IN ACCORDANCE WITH SMACNA (DCS).
- B. COMPLY WITH SAFETY STANDARDS NFPA 90A AND NFPA 90B.
- C. DURING CONSTRUCTION, PROVIDE TEMPORARY CLOSURES OF METAL OR TAPE POLYETHYLENE ON OPEN DUCTWORK TO PREVENT CONSTRUCTION DUST FROM ENTERING THE DUCTWORK SYSTEM.
- D. INCREASE DUCT SIZES GRADUALLY, NOT EXCEEDING 15 DEGREES DIVERGENCE WHEREVER POSSIBLE; MAXIMUM 30 DEGREES DIVERGENCE UPSTREAM OF EQUIPMENT AND 45 DEGREES CONVERGENCE DOWNSTREAM.
- E. DUCT SIZES INDICATED ARE PRECISE INSIDE DIMENSIONS. FOR LINED DUCTS, MAINTAIN SIZES INSIDE LINING.
- F. PROVIDE OPENINGS IN DUCTWORK AS INDICATED TO ACCOMMODATE THERMOMETERS

AND CONTROLLERS. PROVIDE PILOT TUBE OPENINGS AS INDICATED FOR TESTING OF SYSTEMS. COMPLETE WITH METAL CAN WITH SPRING DEVICE OR SCREW TO INSURE AGAINST AIR LEAKAGE. FOR OPENINGS, INSULATE DUCTWORK AND INSTALL INSULATION MATERIAL INSIDE A METAL RING.


G. LOCATE DUCTS WITH SUFFICIENT SPACE AROUND EQUIPMENT TO ALLOW NORMAL OPERATING AND MAINTENANCE ACTIVITIES.

SECTION 233700 AIR OUTLETS AND INLETS

DEMOLITION NOTES:

1. DEMO EXISTING AIR HANDLING UNIT. REMOVE ALL PNEUMATIC CONTROLS ASSOCIATED. REMOVE PORTION OF SUPPLY AND OUTSIDE AIR DUCT AS NECESSARY FOR INSTALLATION OF NEW AIR HANDLING UNIT.
2. EXISTING HOT WATER REHEAT COIL TO BE RE-USED. RELOCATE AS NECESSARY FOR NEW DUCT LAYOUT. REMOVE CONTROL VALVE AND ASSOCIATED PNEUMATIC CONTROLS TO ACCOMMODATE NEW DDC CONTROLS. REMOVE THE EXISTING ELECTRIC HEATER COILS (NOT SHOWN) THAT WERE PREVIOUSLY ABANDONED IN PLACE ALONG WITH THEIR SUNDRIES. REPAIR DUCTWORK ACCORDINGLY.
3. EXISTING CONDENSING UNIT LOCATED ON ROOF (NOT SHOWN) TO REMAIN. STORE REFRIGERANT AND TEMPORARILY SEAL REFRIGERANT PIPES DURING CONSTRUCTION AS NECESSARY SO THAT CONDENSING UNIT MAY BE RE-USED. CLEAN COILS AND VERIFY FUNCTION OF UNIT PRIOR TO ANY DEMO WORK OF THE AIR HANDLING UNIT. REPORT ANY DEFICIENCIES OF THE CONDENSING UNIT PRIOR TO PROCEEDING.
4. DEMO EXISTING AIR DEVICE. REWORK BRANCH DUCT AS NECESSARY TO ACCOMMODATE NEW LAYOUT.
5. MAIN SUPPLY DUCT TO REMAIN UNLESS NOTED OTHERWISE.
6. FAN COIL UNIT SERVING CORRIDOR LOCATED IN CEILING TO REMAIN. SUPPLY AND RETURN DUCTWORK ASSOCIATED WITH THE UNIT TO REMAIN.
7. EXISTING FIN-TUBE HEATER TO REMAIN. DEMO CONTROL VALVE AND ASSOCIATED THERMOSTAT TO REPLACE WITH NEW DDC CONTROLS. CLEAN FIN TUBE AFTER MAJOR DEMOLITION, AND AGAIN AFTER DRYWALL FINISHING.
8. DEMO EXISTING THERMOSTAT.
9. DEMO EXHAUST GRILL. MAIN EXHAUST DUCT AND FAN SHALL REMAIN. REWORK LOCAL EXHAUST DUCT AS NECESSARY TO ACCOMMODATE NEW LAYOUT. EXHAUST FAN LOCATED ON ROOF, NOT SHOWN.
10. EXISTING HYDRONIC HEATING PIPE TO REMAIN UNLESS NOTED OTHERWISE.
11. REMOVE THE DAMAGED PIPE INSULATION WITHIN THE MECHANICAL ROOM. PIPE INSULATION BEYOND THE MECHANICAL ROOM TO REMAIN.

issued
PERMIT DRAWINGS
revised

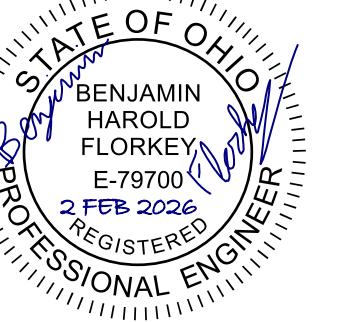

THESE DRAWINGS AND SPECIFICATIONS, THE DESIGNS AND DRAWINGS CONTAINED THEREIN, AND THE SERVICES REPRESENTED THEREBY ARE THE EXCLUSIVE PROPERTY OF THE OREGON GROUP ARCHITECTS, INC. NO PART OF THE DESIGNS OR DRAWINGS, OR THE SERVICES RENDERED THEREIN, ARE TO BE REPRODUCED IN WHOLE OR IN PART, OR TO BE DISCLOSED TO ANY OTHER PERSON, WITHOUT THE EXPRESS CONSENT OF THE OREGON GROUP ARCHITECTS, INC. - 2001.


OREGON GROUP ARCHITECTS
ARCHITECTURE INTERIORS CONSULTANTS
THE PERSONAL HOUSE
310 S. PATERSON BLVD. DAYTON, OHIO 45402
937-224-1511 F 937-224-3663

office renovation for:
valley view board of education
6027 farmersville pike
germantown, ohio 45327
mechanical demolition plan

project number
251431
date
1/23/2026
drawn by
J.E.Y.
checked by
B.H.F.

sheet

M1.1

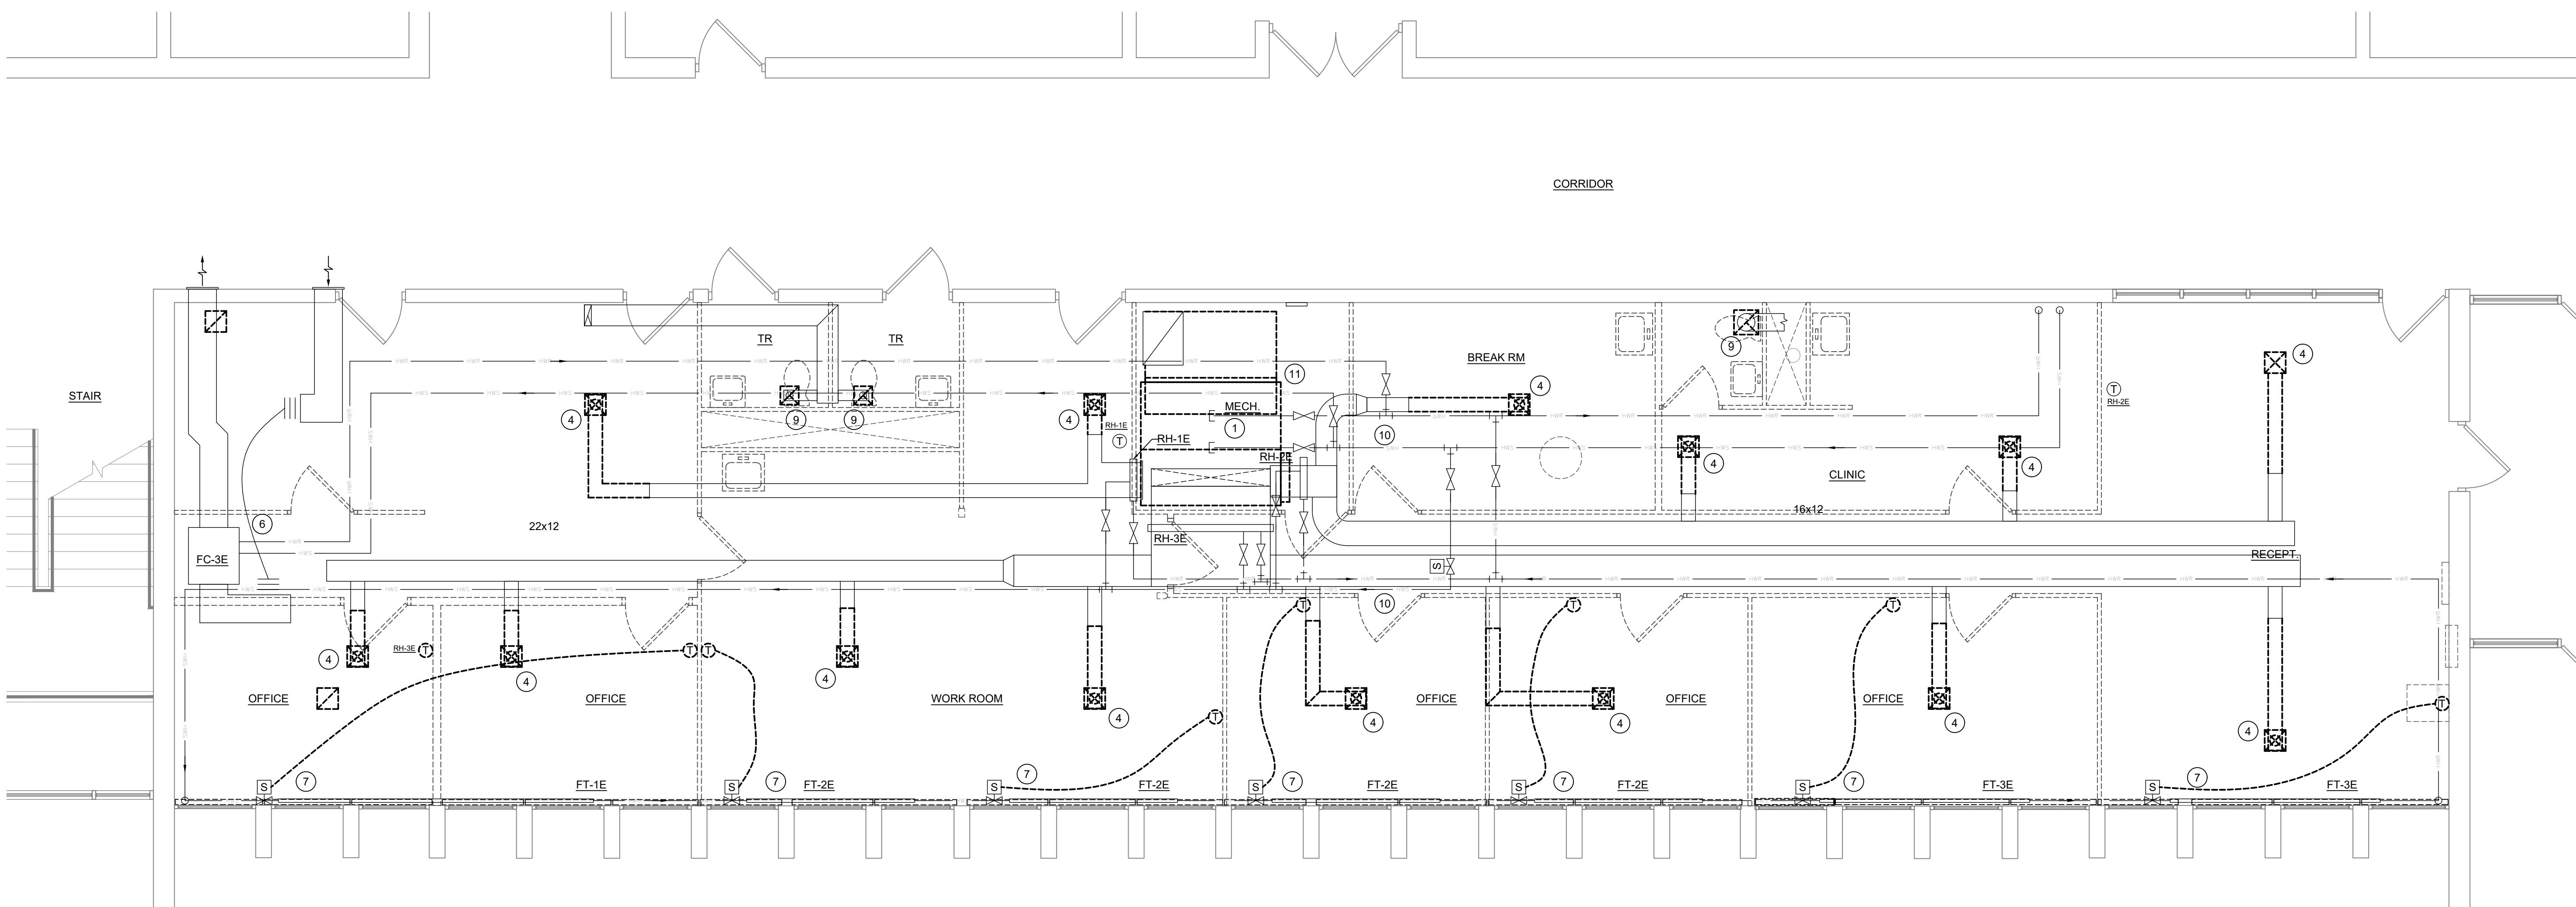

DEMOLITION FLOOR PLAN
SCALE: 1/4"=1'-0"

issued
PERMIT DRAWINGS
revised
CODE COMMENTS
REVISONS 2/2/2026

STATE OF OHIO
PROFESSIONAL ENGINEER
BENJAMIN HAROLD FLORKY E-79700
2/FEB 2026
REGISTERED

THESE DRAWINGS AND SPECIFICATIONS, THE DESIGNS AND THE SERVICES REPRESENTED THEREIN ARE THE EXCLUSIVE PROPERTY OF THE OREGON GROUP ARCHITECTS, INC. THE DRAWINGS AND SPECIFICATIONS ARE TO BE USED ONLY FOR THE PROJECT FOR WHICH THEY ARE PREPARED AND ARE NOT TO BE REPRODUCED IN WHOLE OR IN PART, OR TO BE DISCLOSED TO ANY OTHER PERSON, EXCEPT AS EXPRESSLY CONSENT OF THE OREGON GROUP ARCHITECTS, INC. - 2001.

OREGON GROUP ARCHITECTS
ARCHITECTURE INTERIORS CONSULTANTS
THE PERSONAL HOUSE
310 S. PATTERSON BLVD. DAYTON, OHIO 45402
937-226-1511 F 937-226-5663

office renovation for:
valley view board of education
6027 farmersville pike
germantown, ohio 45327
mechanical new work plan


project number
251431
date
1/23/2026
drawn by
JEWY
checked by
BHF

sheet

M2.1


INSTALLATION NOTES:

1. PROVIDE NEW AIR HANDLING UNIT. REWORK PORTION OF SUPPLY AND OUTSIDE AIR DUCT AS NECESSARY. CONNECT DX COIL TO EXISTING REFRIGERANT PIPE. CONNECT TO DDC CONTROL SYSTEM. EXTEND RETURN DUCT UP TO CEILING PLenum. NEW DUCTWORK NOT SHOWN IN PLAN VIEW FOR CLARITY. REFER TO ELEVATION VIEW ON THIS SHEET.
2. EXISTING HOT WATER REHEAT COIL TO REMAIN. RELOCATE AS NECESSARY. PROVIDE NEW CONTROL VALVE AND CONNECT TO DDC CONTROL SYSTEM.
3. EXISTING CONDENSING UNIT LOCATED ON ROOF (NOT SHOWN). EXTEND REFRIGERANT LINESETS TO THE NEW DX COIL IN THE NEW AIR HANDLING UNIT. RECHARGE SYSTEM WITH NEW OR STORED REFRIGERANT.
4. PROVIDE NEW AIR DEVICE. EXTEND DUCTWORK TO NEW LOCATION. BALANCE TO NEW AIRFLOW. REFER TO AIR DEVICE SCHEDULE ON SHEET M5.1.
5. MAIN SUPPLY DUCT TO REMAIN UNLESS NOTED OTHERWISE.
6. FAN COIL UNIT SERVING CORRIDOR LOCATED IN CEILING TO REMAIN. SUPPLY AND RETURN DUCTWORK ASSOCIATED WITH THE UNIT TO REMAIN.
7. EXISTING FIN-TUBE HEATER TO REMAIN. REPLACE CONTROL VALVE WITH NEW. PROVIDE NEW THERMOSTAT AND CONTROL WIRING.
8. PROVIDE NEW THERMOSTAT. TIE INTO DDC CONTROL SYSTEM.
9. PROVIDE NEW EXHAUST GRILL IN NEW CEILING. EXTEND DUCTWORK TO NEW DEVICE AS NECESSARY.
10. EXISTING HYDRONIC HEATING PIPE TO REMAIN UNLESS NOTED OTHERWISE. PROVIDE NEW INSULATION ON PIPE WITHIN THE AREA OF THIS PROJECT.
11. PROVIDE RETURN AIR DEVICE WITH SOUND BOOT TO RETURN AIR INTO CEILING PLenum. REFER TO DETAIL ON SHEET M5.2.
12. AIR RETURNS TO THE AIR HANDLER THROUGH CEILING PLenum. WALLS ARE GENERALLY EXTENDED TO DECK TO REDUCE SOUND TRANSFER. PROVIDE BOOTED AIR TRANSFER PATH ABOVE CEILING. REFER TO DETAIL ON SHEET M5.2.
13. ALL NEW CONTROLS ARE TO TIE INTO THE BUILDING'S EXISTING DDC SYSTEM. THE DETAILS AND COMPONENTS REQUIRED SHALL BE SUBMITTED AS A SHOP DRAWING FOR REVIEW PRIOR TO ORDERING EQUIPMENT FOR THE PURPOSE OF BIDDING. ASSUME THAT A REMOTE PANEL WILL BE LOCATED IN THE MECHANICAL ROOM 115 TO ACCEPT ALL INPUT / OUTPUT POINTS IN THIS AREA WITH A SINGLE DATA CABLE RUNNING BACK TO THE BUILDING'S MAIN DDC CONTROL PANEL.
14. PROVIDE PIPE INSULATION TO REPLACE THE DAMAGED INSULATION WITHIN THE MECHANICAL ROOM. PIPE INSULATION BEYOND THE MECHANICAL ROOM TO REMAIN.
15. CEILING IN IT CLOSET TO BE LEFT OPEN TO RETURN AIR PLenum.
16. THE SOUTH AND EAST WALL OF THE MECHANICAL ROOM WILL HAVE OPEN STUD BAYS ABOVE THE CEILING LEVEL TO ALLOW FOR AIR MOVEMENT FROM THE AIR PLenum TO THE MECHANICAL ROOM. TRANSFER DUCT NOT REQUIRED HERE.

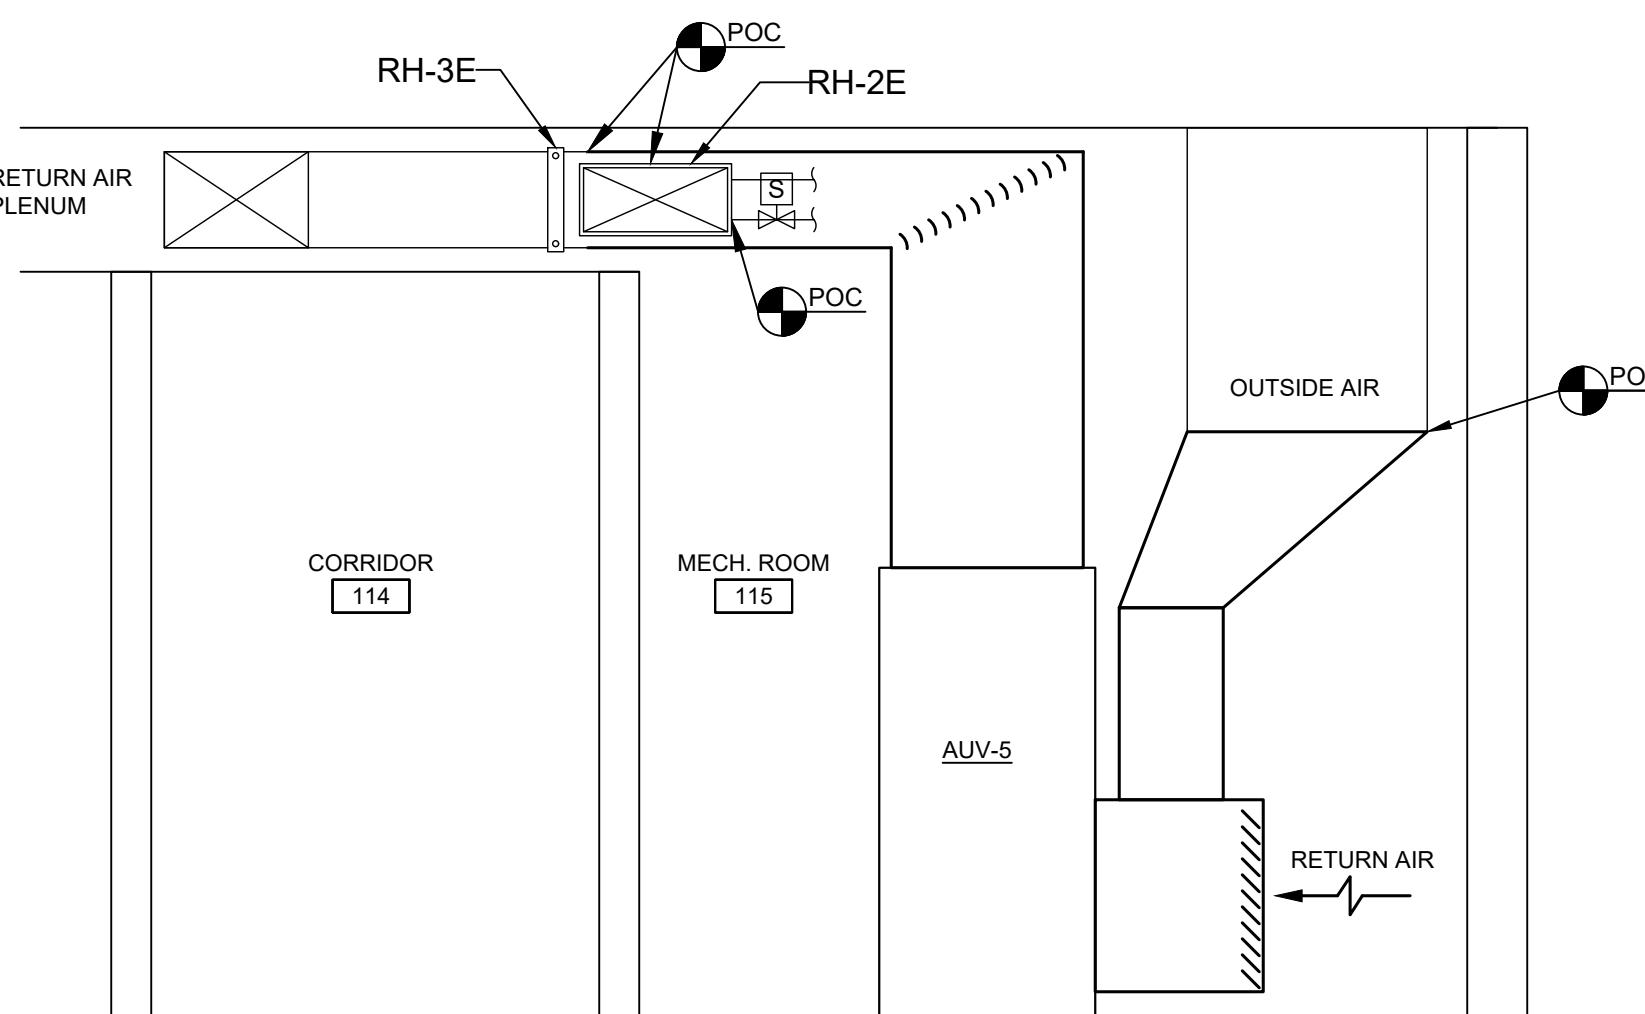

MECH. ROOM SECTION

SCALE: 1/2"=1'-0"

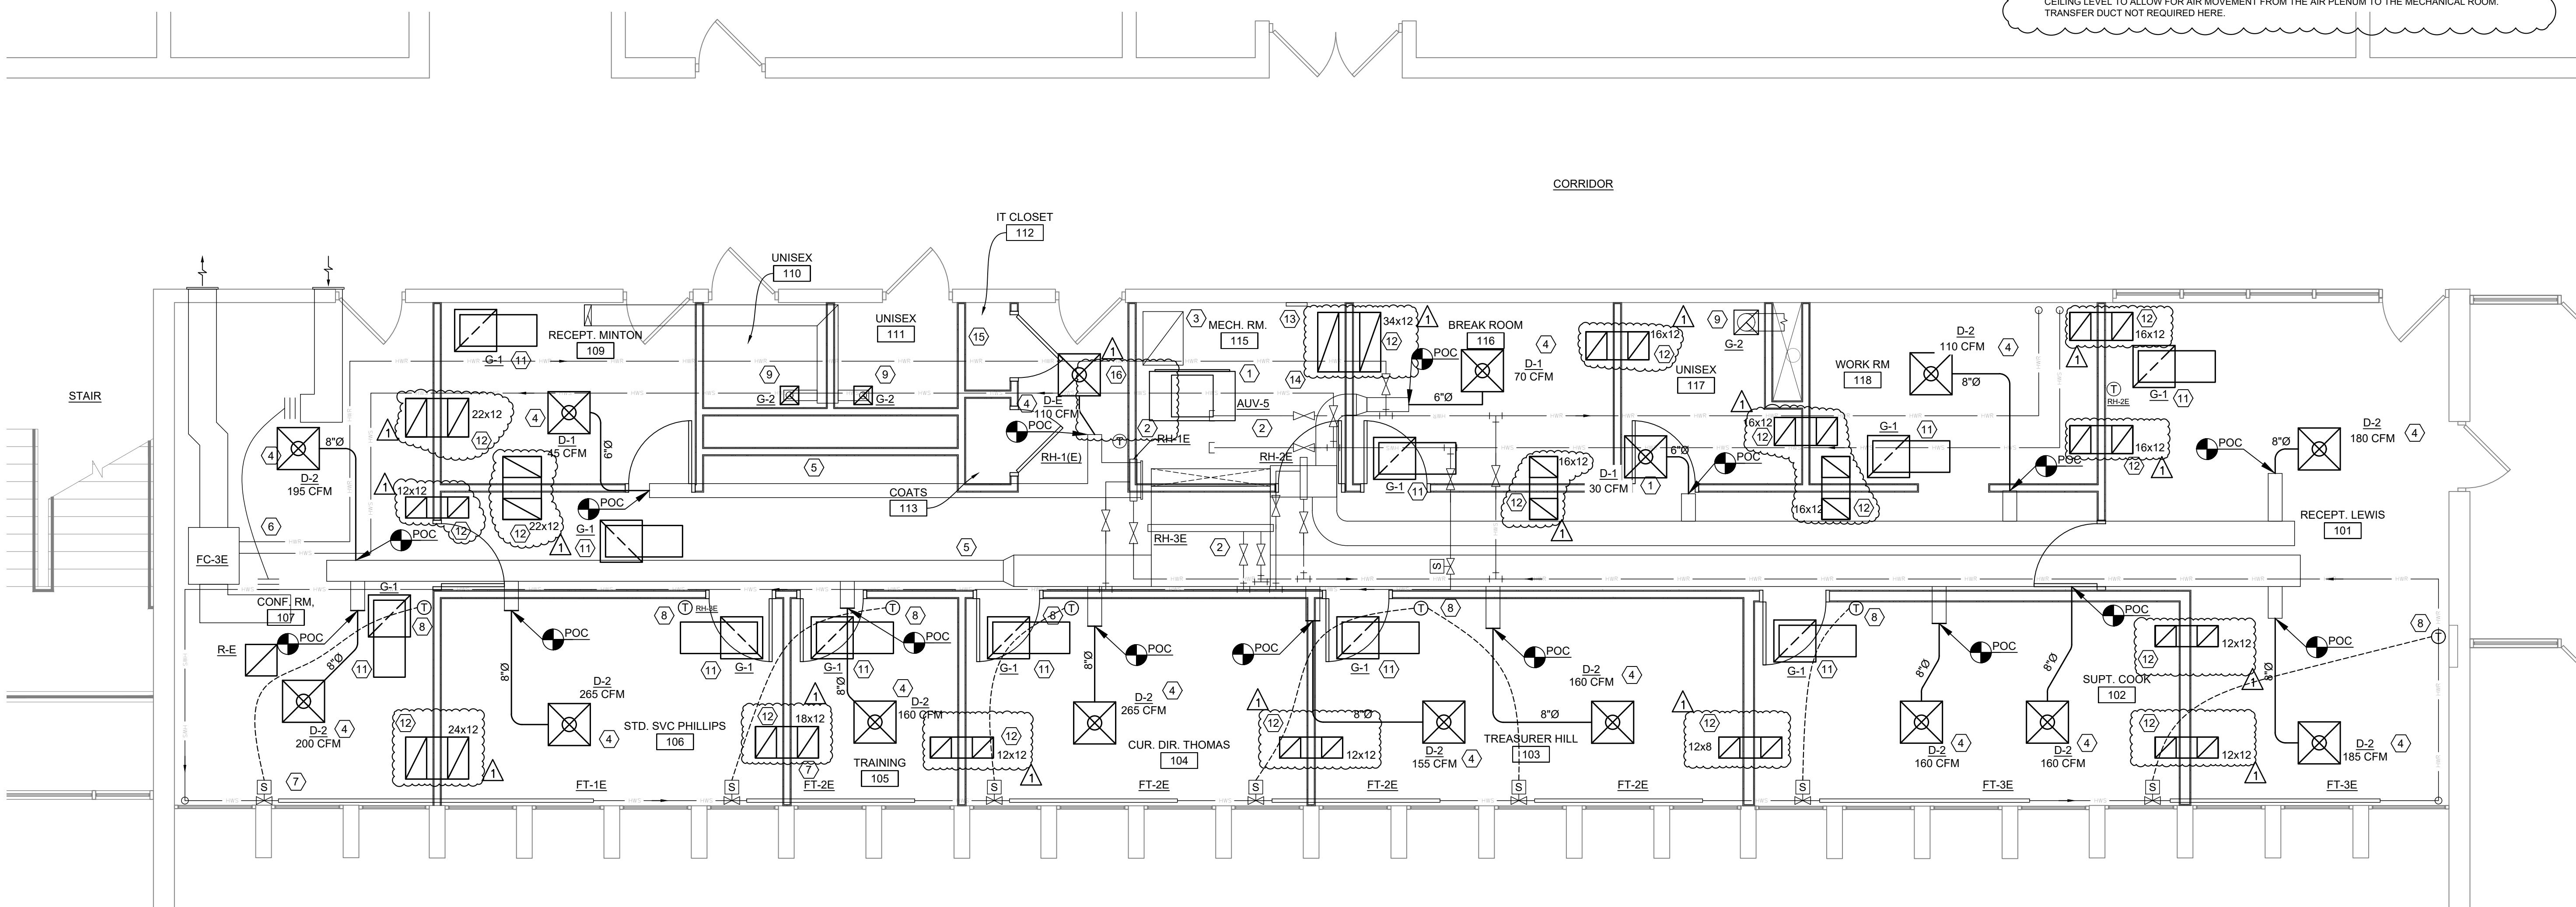

NEW WORK FLOOR PLAN

SCALE: 1/4"=1'-0"


AIR DEVICE RUNOUT CONNECTION DETAIL

SCALE: NONE

GENERAL NOTES	
A. PROVIDE HANGERS REQUIRED TO LIMIT FLEXIBLE DUCT SAG TO 2"	
# DETAIL NOTES	
1. MAIN DUCT 2. SPIN-IN FITTING W/ DAMPER & VOLUME EXTRACTOR 3. WIRE HANGER, TYP. 4. FLEXIBLE DUCT, SAME SIZE AS DIFFUSER NECK 5. INSULATED ROUND SHEET METAL AS REQUIRED, SAME SIZE AS DIFFUSER NECK 6. 1/2" WIDE SHEET METAL STRAP 7. BOTTOM OF BUILDING STRUCTURE 8. PROVIDE SHEETMETAL CONNECTION ELBOW, EXTERNALLY INSULATE 9. RADIUS NO LESS THAN DUCT DIAMETER 10. CEILING DIFFUSER	

RETURN AIR SOUND TRAP DETAIL


SCALE: NONE

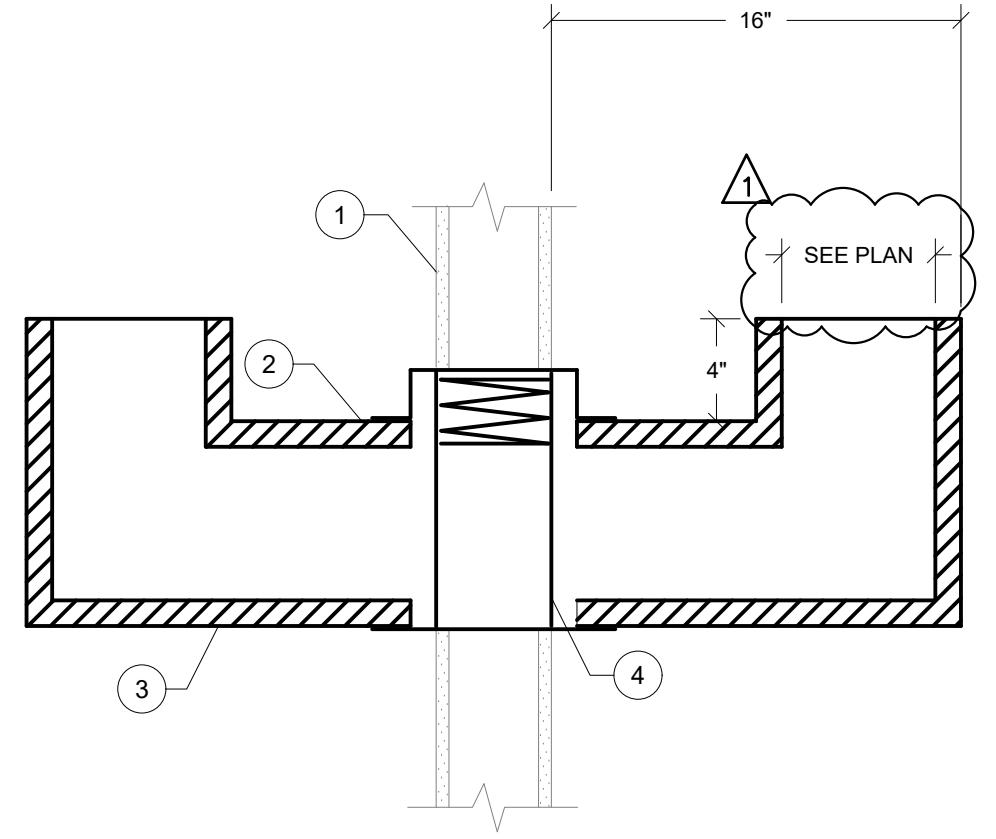

# DETAIL NOTES	
1. FIRE RATED PARTITION	
2. SEE PLANS FOR DUCT SIZE AND ELEVATION	
3. ACOUSTICALLY LINED DUCTWORK FOR SOUND ABSORPTION	
4. FIRE DAMPER WHERE REQUIRED, SEE PLANS. CARRY DUCT THROUGH NON-RATED WALL AND SEAL OPENING	


SOUND BOOT DETAIL

SCALE: NONE

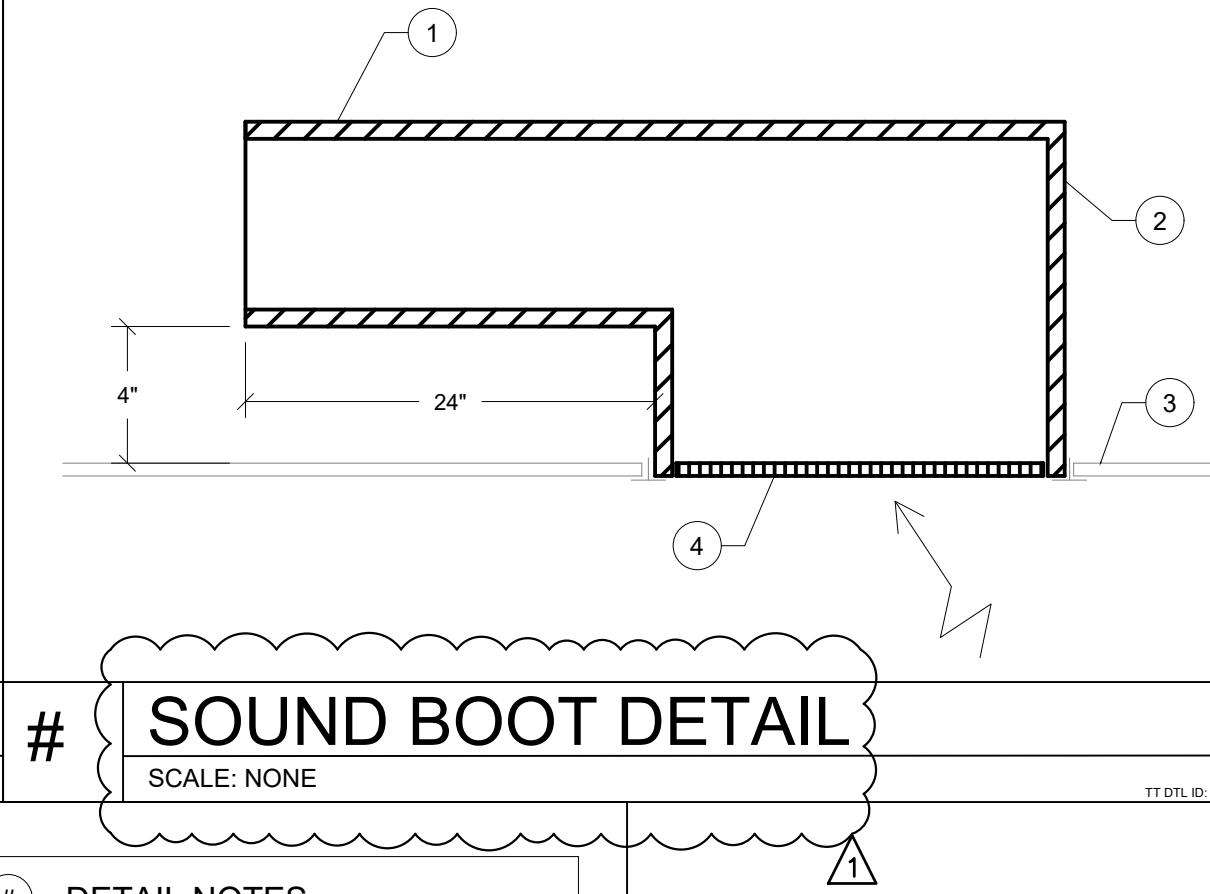

HOT WATER COIL PIPING DETAIL


SCALE: NONE

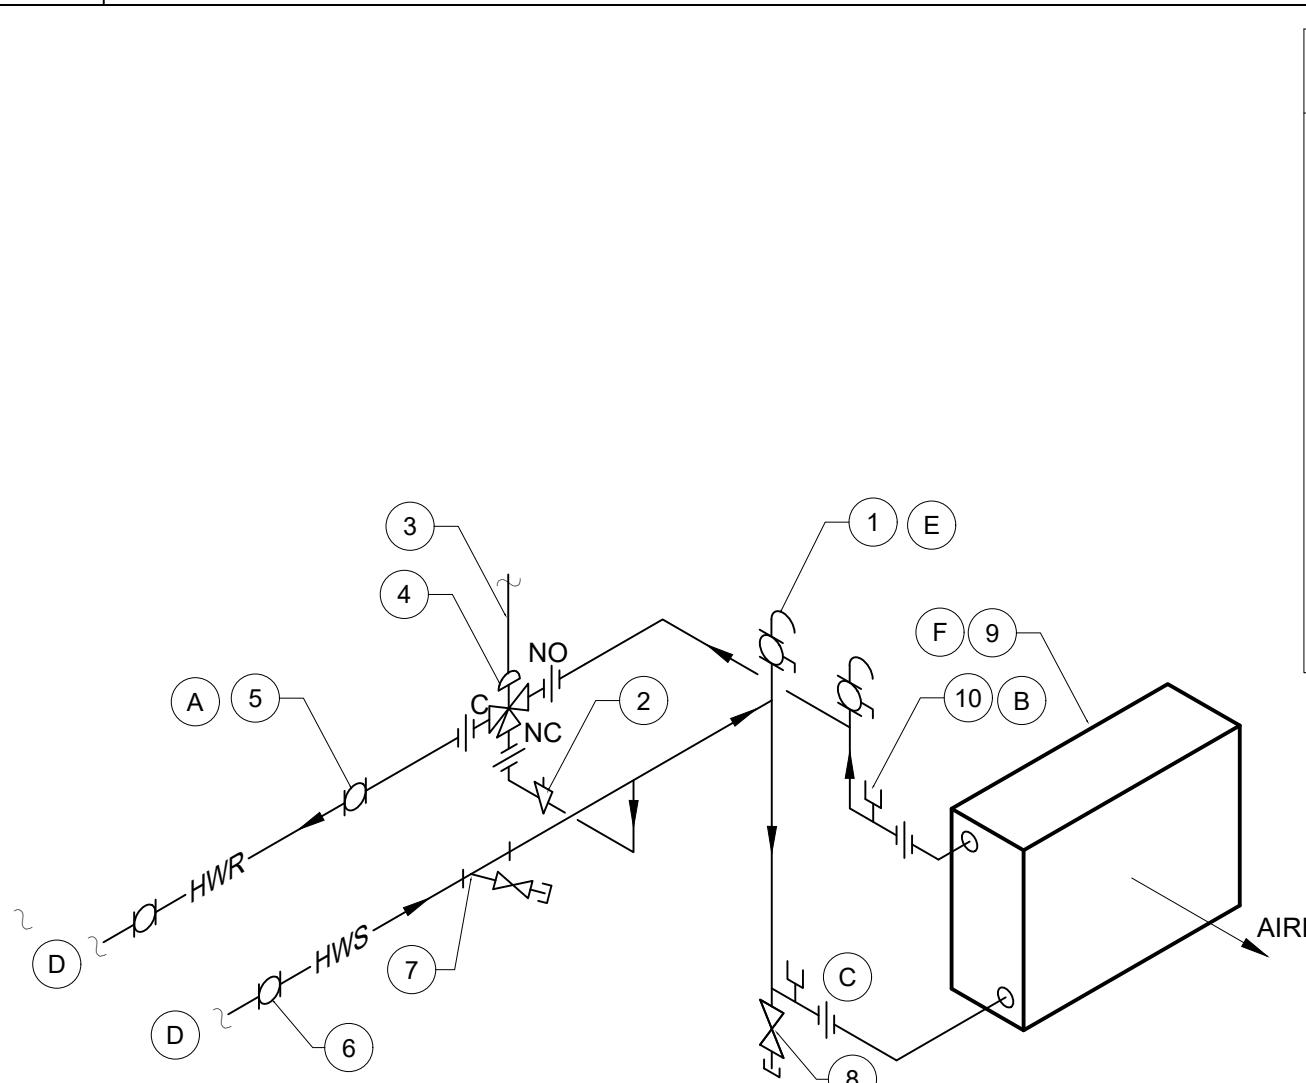

# DETAIL NOTES	
1. MANBAL VENT, 3/8" BALL VALVE (TYP.) 2. PLUG VALVE, ADJUST TO EQUAL GPM THRU COIL AT DESIGN FLOW 3. DIRECT ACTING SIGNAL 4. MIXING VALVE 5. BALANCING VALVE 6. SHUT-OFF VALVE (TYP.) 7. STRAINER WITH BLOW-OFF VALVE 8. 1/2" DRAIN VALVE 9. COIL 10. TEST PLUG (TYP.)	
GENERAL NOTES	

TYPICAL HOT WATER BASEBOARD CONVECTOR PIPING

SCALE: NONE

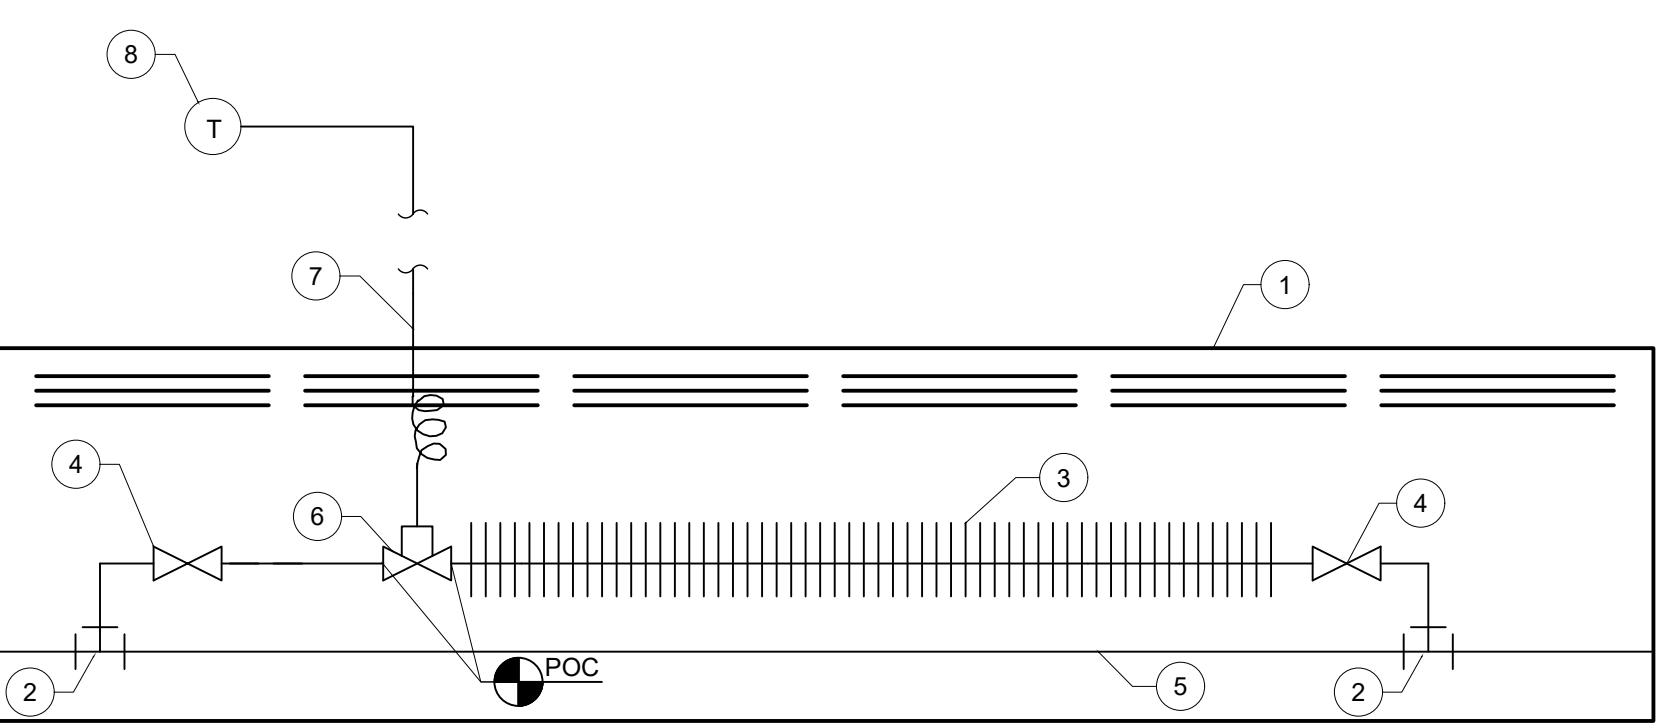

OREGON GROUP ARCHITECTS
ARCHITECTURE INFERIORS CONSULTANTS
THE PERSONAL HOME
310 S. PATERSON BLVD. DAYTON, OHIO 45402
937-226-1511 F 937-226-5663

valley view board of education
6027 farmersville pike
germantown, ohio 45327
mechanical details

project number
251431
date
1/23/2026
drawn by
JEY
checked by
BHF

sheet

M 5.2

ELECTRICAL SPECIFICATIONS:

26 05 00 - COMMON WORK RESULTS FOR ELECTRICAL

- ELECTRICAL CONTRACTOR SHALL SECURE ALL ELECTRICAL PERMITS AS REQUIRED AND MAKE ALL NECESSARY APPLICATIONS AND COORDINATE WORK FOR A COMPLETE ELECTRICAL INSTALLATION. ELECTRICAL CONTRACTOR SHALL BE RESPONSIBLE FOR ALL PERMIT AND INSPECTION FEES APPLICABLE TO THE WORK IN THE DRAWINGS AND SPECIFICATIONS.
- PROVIDE WORK IN COMPLIANCE WITH ALL LOCAL, STATE, AND NATIONAL CODES AND STANDARDS INCLUDING BUT NOT LIMITED TO THE FOLLOWING:
2024 OHIO BUILDING CODE.
2023 NATIONAL ELECTRICAL CODE (NFPA 70).
2021 IEC 60364-4-46 ASHRAE 90.1.
2022 NFPA 70.
LOCAL ELECTRICAL CODES.
WHERE THERE IS A CONFLICT, THE MOST STRINGENT SHALL APPLY.
- "PROVIDE" MEANS "FURNISH AND INSTALL".
- ELECTRICAL CONTRACTOR SHALL VISIT SITE AND FAMILIARIZE THEMSELVES WITH THE EXISTING CONDITIONS AND WORK TO BE DONE. ELECTRICAL CONTRACTOR SHALL CAREFULLY CHECK PLANS OF ALL DISCIPLINES; THESE ELECTRICAL DRAWINGS ARE TO BE USED AS A GUIDE AND ARE SCHEMATIC IN NATURE. ELECTRICAL CONTRACTOR SHALL ASSUME RESPONSIBILITY FOR A COMPLETE AND FUNCTIONING SYSTEM, INCLUDING VERIFICATION OF DIMENSIONS, SEQUENCING, ETC.
- ALL ITEMS SHALL BE NEW UNLESS OTHERWISE NOTED. PROVIDE PRODUCTS LISTED AND LABELED BY UNDERWRITERS LABORATORIES INC. AS SUITABLE FOR THE PURPOSE INDICATED.
- INSTALL ALL EQUIPMENT IN ACCORDANCE WITH MANUFACTURER'S SPECIFICATIONS, DETAILS AND DESIGN. EQUIPMENT CALLED OUT BY CERTAIN MANUFACTURERS IS INTENDED TO CREATE A STANDARD. EQUIPMENT WILL BE ACCEPTED UPON APPROVAL.
- THE CONTRACTOR SHALL PREPARE OR OBTAIN FROM THE MANUFACTURER SHOP DRAWINGS OF ALL ITEMS OF EQUIPMENT TO BE FURNISHED AND SUBMIT ELECTRONIC COPIES TO THE ARCHITECT AND/OR ENGINEER FOR APPROVAL BEFORE PROCEEDING WITH INSTALLATION OR CONSTRUCTION. THESE DRAWINGS SHALL BE COMPLETE IN EVERY RESPECT SHOWING PERTINENT DETAILS OF SIZE, CAPACITIES, ARRANGEMENTS, FITTINGS, PIPING, KINDS AND THICKNESS OF MATERIALS, WEIGHT, LOADING REQUIRED, CLEARANCES FOR SERVICE, MAINTENANCE, ETC. AS A MINIMUM, THE SHOP DRAWINGS EXPECTED ARE AS FOLLOWS:
7.1. LIGHT FIXTURES.
7.2. DISTRIBUTION EQUIPMENT.
7.3. LIGHTING CONTROLS.
7.4. FIRE ALARM.
- PROVIDE AND INSTALL ELECTRICAL DISCONNECTS, CIRCUIT BREAKERS, ETC. SPECIFIED OR REQUIRED.
- COORDINATE LOCATIONS OF LIGHTING FIXTURES WITH MECHANICAL DUCTS, SPRINKLER PIPES AND HEADS BEFORE ROUGH-IN TO PREVENT CONFLICTS. VERIFY EXACT LOCATION OF ALL LIGHTING FIXTURES WITH REFLECTED CEILING PLAN AND/OR ARCHITECT PRIOR TO ROUGH-IN.
- PROVIDE THE FOLLOWING CLOSEOUT ACTIVITIES
10.1. TEST ALL WORK AND EQUIPMENT. CORRECT ALL DEFICIENCIES. DEMONSTRATE THAT THE ELECTRICAL SYSTEM IS OPERATING TO THE SATISFACTION OF THE OWNER.
10.2. PROVIDE AN AS-BUILT SET OF DRAWINGS SHOWING ALL CORRECTIONS TO THE OWNER.
10.3. PROVIDE EQUIPMENT OPERATING AND MAINTENANCE MANUALS TO THE OWNER. PROVIDE THE NAMES AND ADDRESSES OF WHERE THE EQUIPMENT WAS PURCHASED FROM.
- REFER TO THE ARCHITECTURAL CONSTRUCTION PHASING SHEET FOR WORK THAT IS REQUIRED TO BE PERFORMED "AFTER HOURS."
- PROVIDE TEMPORARY LIGHTING/EXIT SIGNS AS REQUIRED MAINTAINING EGRESS FOR AREAS INSIDE AND OUTSIDE THE TEMPORARY PARTITION WALLS.
- 26 05 05 - SELECTIVE DEMOLITION
1. EXISTING ELECTRICAL OR COMMUNICATIONS EQUIPMENT, DEVICES AND CABLING THAT HAVE BEEN ABANDONED SHALL BE DISCONNECTED AND REMOVED BY THE ELECTRICAL CONTRACTOR. REMOVE ABANDONED CABLING ABOVE LAY-IN CEILINGS. ANY ABANDONED CONDUITS/WIRING SHALL BE REMOVED BACK TO UPSTREAM AND ACTIVE SOURCE.
2. REVIEW DRAWINGS FOR ALL TRADES. REMOVE POWER TO EQUIPMENT REMOVED BY OTHER TRADES. REMOVE AND RECONNECT EQUIPMENT RELOCATED BY OTHER TRADES.
3. EXTEND CONDUIT, WIRING, ETC. AS REQUIRED, TO ACCOMMODATE NEW OR RELOCATED ELECTRICAL WORK.
4. COORDINATE DISPOSAL REQUIREMENTS WITH THE OWNER PRIOR TO DEMOLITION. ITEMS TO BE SALVAGED FOR THE OWNER SHALL BE REMOVED (UNDAMAGED) AND TURNED OVER TO OWNER. DISCONNECT (NOT JUST CUT) ALL WIRING & "WHIPS" FROM EQUIPMENT TERMINAL POINTS AND CAREFULLY TRANSPORT TO AND NEATLY STORE AT AN ON-SITE STORAGE LOCATION AS DIRECTED IN THE FIELD.
5. ELECTRICAL CONTRACTOR SHALL DEMO, PATCH AND REPAIR EXISTING WALLS AS REQUIRED FOR ELECTRICAL BOXES, CONDUIT, WALL PENETRATIONS, ETC.
5.1. ALL PENETRATIONS IN FIRE BARRIERS SHALL BE SEALED WITH FIRE CAULK IN CONJUNCTION WITH FIRE SAFING INSULATING MATERIALS AS REQUIRED PER THE OHIO BUILDING CODE. SEALANT SHALL MAINTAIN OR EXCEED THE INTEGRITY OF THE FIRE RATING OF THESE CEILINGS, FLOORS OR WALLS.
5.2. FIRESTOP ASSEMBLIES SHALL BE APPROVED AND TESTED IN ACCORDANCE WITH ASTM E119 AND ASTM E814.
5.3. PATCH WEATHER-TIGHT ALL NEW PENETRATIONS IN EXTERIOR WALLS, ROOFS, FLOORS, ETC.
5.4. ALL PATCHING SHALL BE PERFORMED BY TRADES QUALIFIED IN PATCHING AT THE ELECTRICAL CONTRACTOR'S EXPENSE.
6. ALL WORK AND SYSTEM SHUTDOWNS SHALL BE CAREFULLY COORDINATED IN ADVANCE WITH THE OWNER'S REPRESENTATIVE.
- 26 05 19 - CONDUCTORS:
1. COORDINATE SIZES OF RACEWAYS, BOXES, AND EQUIPMENT ENCLOSURES WITH THE ACTUAL CONDUCTORS TO BE INSTALLED, INCLUDING ADJUSTMENTS FOR CONDUCTOR SIZES INCREASED FOR VOLTAGE DROP, AMBIENT TEMPERATURE, MORE THAN (3) CURRENT-CARRYING CONDUCTORS IN A CONDUIT.
2. WHERE OVER-SIZED CONDUCTORS ARE LARGER THAN THE EQUIPMENT TERMINATIONS CAN ACCOMMODATE, PROVIDE CONNECTORS SUITABLE FOR REDUCING TO APPROPRIATE SIZE, BUT NOT LESS THAN REQUIRED FOR THE RATING OF THE OVERCURRENT PROTECTIVE DEVICE. IT IS ACCEPTABLE TO UTILIZE UL-LISTED REDUCER KITS OR POWER DISTRIBUTION BLOCKS TO CONNECT TO TERMINAL LUGS. CONTRACTOR IS RESPONSIBLE TO ENSURE THAT TERMINAL LUGS ARE RATED OR LISTED TO ACCEPT THE REDUCER KIT UTILIZED.
3. UNLESS DIMENSIONED, CIRCUIT ROUTING INDICATED IS DIAGRAMMATIC. WHEN CIRCUIT DESTINATION IS INDICATED AND ROUTING IS NOT SHOWN, DETERMINE EXACT ROUTING REQUIRED.
4. SECURE AND SUPPORT CONDUCTORS AND CABLES IN ACCORDANCE WITH NFPA 70 USING SUITABLE SUPPORTS AND METHODS APPROVED BY THE AUTHORITY HAVING JURISDICTION. PROVIDE INDEPENDENT SUPPORT FROM BUILDING STRUCTURE. DO NOT PROVIDE SUPPORT FROM RACEWAYS, PIPING, DUCTWORK, OR OTHER SYSTEMS.
5. UNLESS SPECIFICALLY INDICATED TO BE EXCLUDED, PROVIDE FINAL CONNECTIONS TO ALL EQUIPMENT AND DEVICES, INCLUDING THOSE FURNISHED BY OTHERS, AS REQUIRED FOR A COMPLETE OPERATING SYSTEM.
6. PROVIDE COPPER CONDUCTORS.
7. MINIMUM CONDUCTOR SIZE FOR BRANCH CIRCUITS IS #12 AWG.
- 7.1. EXCEPTIONS:
7.1.1. 20 A, 120 V CIRCUITS LONGER THAN 75 FEET (23 M): #10 AWG, FOR VOLTAGE DROP.
7.1.2. 20 A, 120 V CIRCUITS LONGER THAN 150 FEET (46 M): #8 AWG, FOR VOLTAGE DROP.
7.1.3. 20 A, 277 V CIRCUITS LONGER THAN 150 FEET (46 M): #10 AWG, FOR VOLTAGE DROP.
8. WHERE CONDUCTOR SIZE IS NOT INDICATED, SIZE TO COMPLY WITH NFPA 70 BUT NOT LESS THAN APPLICABLE MINIMUM SIZE REQUIREMENTS SPECIFIED.
9. COLOR CODE CONDUCTORS AS INDICATED UNLESS OTHERWISE REQUIRED BY THE AUTHORITY HAVING JURISDICTION. MAINTAIN CONSISTENT COLOR CODING THROUGHOUT PROJECT.
- 9.1. COLOR CODE:
9.1.1. 208Y/120 V, 3 PHASE, 4 WIRE SYSTEM:
9.1.2. PHASE A: BLACK.
9.1.3. PHASE B: RED.
9.1.4. PHASE C: BLUE.
9.1.5. NEUTRAL/GROUNDED: WHITE.
9.1.6. 480Y/277 V, 3 PHASE, 4 WIRE SYSTEM:
9.1.7. PHASE A: BROWN.
9.1.8. PHASE B: ORANGE.
9.1.9. PHASE C: YELLOW.
9.1.10. NEUTRAL/GROUNDED: GRAY.
9.1.11. EQUIPMENT GROUND, ALL SYSTEMS: GREEN.
9.1.12. FOR MODIFICATIONS OR ADDITIONS TO EXISTING WIRING SYSTEMS, COMPLY WITH EXISTING COLOR CODE WHEN EXISTING CODE COMPLIES WITH NFPA 70 AND IS APPROVED BY THE AUTHORITY HAVING JURISDICTION.
10. PROVIDE A DEDICATED NEUTRAL FOR EACH CIRCUIT.
11. INSULATION:
11.1. COPPER WIRE: TYPE THHN/THWN OR THHN/THWN-2, EXCEPT AS INDICATED BELOW.
11.1.1. SIZE 4 AWG AND LARGER: TYPE XHHW-2.
- 26 05 26 - GROUNDING:
1. CONFORM TO REQUIREMENTS OF NFPA 70.
2. UNLESS SPECIFICALLY INDICATED TO BE EXCLUDED, PROVIDE ALL REQUIRED COMPONENTS, CONDUCTORS, CONNECTORS, CONDUIT, BOXES, FITTINGS, SUPPORTS, ACCESSORIES, ETC. AS NECESSARY FOR A COMPLETE GROUNDING AND BONDING SYSTEM.
3. WHERE CONDUCTOR SIZE IS NOT INDICATED, SIZE TO COMPLY WITH NFPA 70 BUT NOT LESS THAN APPLICABLE MINIMUM SIZE REQUIREMENTS SPECIFIED.
4. PROVIDE BONDING FOR EQUIPMENT GROUNDING CONDUCTORS, EQUIPMENT GROUND BUSSES, METALLIC EQUIPMENT ENCLOSURES, METALLIC RACEWAYS AND BOXES, DEVICE GROUNDING TERMINALS, AND OTHER NORMALLY NON-CURRENT-CARRYING CONDUCTIVE MATERIALS ENCLOSING ELECTRICAL CONDUCTORS/EQUIPMENT OR LIKELY TO BECOME ENERGIZED AS INDICATED AND IN ACCORDANCE WITH NFPA 70.
5. PROVIDE INSULATED EQUIPMENT GROUNDING CONDUCTOR IN EACH FEEDER AND BRANCH CIRCUIT RACEWAY. DO NOT USE RACEWAYS AS SOLE EQUIPMENT GROUNDING CONDUCTOR.
6. WHERE CIRCUIT CONDUCTOR SIZES ARE INCREASED FOR VOLTAGE DROP OR OTHER REASONS, INCREASE SIZE OF EQUIPMENT GROUNDING CONDUCTOR PROPORTIONALLY IN ACCORDANCE WITH NFPA 70.
7. TERMINATE BRANCH CIRCUIT EQUIPMENT GROUNDING CONDUCTORS ON SOLIDLY BONDED EQUIPMENT GROUND BUS ONLY. DO NOT TERMINATE ON NEUTRAL (GROUNDED) OR ISOLATED/INSULATED GROUND BUS.
8. UNLESS OTHERWISE INDICATED, USE EXOTHERMIC WELDED CONNECTIONS FOR CONCEALED AND OTHER INACCESSIBLE CONNECTIONS.
8.1. EXOTHERMIC WELDS: MAKE CONNECTIONS USING MOLDS AND WELD MATERIAL SUITABLE FOR THE ITEMS TO BE CONNECTED IN ACCORDANCE WITH MANUFACTURER'S RECOMMENDATIONS.
9. UNLESS OTHERWISE INDICATED, USE MECHANICAL CONNECTORS, COMPRESSION CONNECTORS, OR EXOTHERMIC WELDED CONNECTIONS FOR ACCESSIBLE CONNECTIONS.
9.1. MECHANICAL CONNECTORS: SECURE CONNECTIONS ACCORDING TO MANUFACTURER'S RECOMMENDED TORQUE SETTINGS.
9.2. COMPRESSION CONNECTORS: SECURE CONNECTIONS USING MANUFACTURER'S RECOMMENDED TOOLS AND DIES.
- 26 05 29 - HANGERS AND SUPPORTS:
1. SECURE AND SUPPORT CONDUIT IN ACCORDANCE WITH NFPA 70 USING SUITABLE SUPPORTS AND METHODS APPROVED BY THE AUTHORITY HAVING JURISDICTION. PROVIDE INDEPENDENT SUPPORT FROM BUILDING STRUCTURE. DO NOT PROVIDE SUPPORT FROM RACEWAYS, PIPING, DUCTWORK, OR OTHER SYSTEMS.
2. DO NOT USE CONDUIT AND ASSOCIATED FITTINGS FOR APPLICATIONS OTHER THAN AS PERMITTED BY NFPA 70 AND PRODUCT LISTING.
3. UNLESS OTHERWISE INDICATED AND WHERE NOT OTHERWISE RESTRICTED, USE THE CONDUIT TYPES INDICATED FOR THE SPECIFIED APPLICATIONS.
- 3.1. INTERIOR DRY LOCATIONS, CONCEALED: USE ELECTRICAL METALLIC TUBING (EMT). TYPE MC CABLE IS ACCEPTABLE WHERE APPROVED BY THE OWNER AND PERMITTED BY THE NATIONAL ELECTRICAL CODE. HOME RUN SHALL BE IN CONDUIT.
- 3.2. CONNECTIONS TO VIBRATING EQUIPMENT: USE LIQUIDTIGHT FLEXIBLE METAL CONDUIT.
- 3.3. INTERIOR, DAMP OR WET LOCATIONS: USE INTERMEDIATE METAL CONDUIT (IMC).
4. ALL NEW CONDUITS SHALL BE 3/4" TRADE SIZE MINIMUM.
5. UNLESS DIMENSIONED, CONDUIT ROUTING IS DIAGRAMMATIC.
6. CONCEAL ALL CONDUITS UNLESS SPECIFICALLY INDICATED TO BE EXPOSED.
7. RUN ALL CONDUIT AND WIRE TIGHT TO BUILDING STRUCTURE WHERE POSSIBLE. ALL RUNS SHALL BE SQUARE AND TRUE WITH BUILDING LINES.
8. PROVIDE FULLY RATED NEUTRAL BUS, WITH A SUITABLE LUG FOR EACH FEEDER OR BRANCH CIRCUIT REQUIRING A NEUTRAL CONNECTION.
9. PROVIDE SOLIDLY BONDED EQUIPMENT GROUND BUS IN EACH PANELBOARD, WITH A SUITABLE LUG FOR EACH FEEDER AND BRANCH CIRCUIT EQUIPMENT GROUNDING CONDUCTOR.
10. LOCKABLE DOORS: ALL LOCKS KEYED ALIKE UNLESS OTHERWISE INDICATED.
11. LOAD CENTERS ARE NOT ACCEPTABLE.
12. PROVIDE THE FOLLOWING FEATURES AND ACCESSORIES WHERE INDICATED OR WHERE REQUIRED TO COMPLETE INSTALLATION:
12.1. FEED-THROUGH LUGS.
12.2. SUB-FEED LUGS.
- 26 27 26 - WIRING DEVICES:
1. ALL RECEPTACLE AND LIGHTING CIRCUITS SHALL BE 20A UNLESS OTHERWISE SPECIFIED.
1.1. ALL RESTROOM AND KITCHEN RECEPTACLES SHALL HAVE GROUND FAULT CIRCUIT INTERRUPTER (GFCI) PROTECTION.
2. WIRING DEVICES (RECEPTACLES, SWITCHES, ETC.) SHALL BE INDUSTRIAL GRADE.
- 2.1. WIRING DEVICE AND WALL PLATE COLORS SHALL BE SELECTED BY THE ARCHITECT FROM WIRING DEVICE MANUFACTURER'S STANDARD COLORS.
- 2.2. CEILING MOUNTED DEVICES SHALL MATCH CEILING COLOR.
3. WHERE SHOWN ON NEW WALLS, WIRING DEVICES (RECEPTACLES, SWITCHES, DATA OUTLETS ETC.) SHALL BE RECESSED UNLESS NOTED OTHERWISE ON THE DRAWINGS.
4. INSTALL RECEPTACLE WITH GROUND PIN IN THE UP POSITION.
5. WIRING DEVICES SHALL BE HORIZONTALLY AND VERTICALLY ALIGNED WITH EACH OTHER. REFER TO THE MOUNTING HEIGHT ELEVATION DETAIL.
6. GROUP POWER AND TECHNOLOGY WIRING DEVICES TOGETHER WHERE SHOWN ADJACENT TO EACH OTHER.
7. LABEL EACH WIRING DEVICE WITH PANEL NUMBER AND CIRCUIT. LABEL SHALL BE SELF ADHESIVE WITH A CLEAR BACKGROUND AND BLACK FONT.
- 28 46 13 - FIRE ALARM:
1. PROVIDE FIRE ALARM SYSTEM DESIGN PERMIT DRAWINGS. DRAWINGS SHALL BE COMPLETED AND SEALED BY A CERTIFIED FIRE ALARM SYSTEM CONTRACTOR. PROVIDE FEES AND ACCEPTANCE TESTING THAT SHALL BE WITNESSED BY THE AUTHORITY HAVING JURISDICTION. PROVIDE EQUIPMENT AND WIRING. PROVIDE PROGRAMMING, COMMISSIONING AND OWNER INSTRUCTION.
2. ALL NEW FIRE ALARM DEVICES SHALL BE COMPATIBLE WITH THE EXISTING SILENT KNIGHT FIRE ALARM SYSTEM. THE ELECTRICAL CONTRACTOR SHALL SUBCONTRACT WITH THE BUILDING FIRE ALARM VENDOR. WORK PROVIDED BY THE FIRE ALARM VENDOR SHALL BE PROVIDED AS PART OF THE ELECTRICAL BASE BID CONTRACT.
3. UPGRADE THE EXISTING FIRE ALARM CONTROL PANEL AS REQUIRED PER THE FIRE ALARM VENDOR'S RECOMMENDATIONS.
4. THIS CONTRACTOR SHALL PERFORM BATTERY CALCULATIONS, UPDATE FIRE ALARM SYSTEM RISER DIAGRAM AND PLAN, AND SECURE THE FIRE ALARM PERMIT.
5. ALL FIRE ALARM VISUAL ANNUNCIATING DEVICES SHALL BE SYNCHRONIZED PER NFPA 72. PROVIDE NEW OR REPLACE EXISTING NAC EXTENDER PANELS WHERE NECESSARY TO ACCOMPLISH SYNCHRONIZATION. PROVIDE ADDITIONAL BRANCH CIRCUITS AS REQUIRED. EACH NAC PANEL SHALL HAVE A SMOKE DETECTOR IN THE SAME ROOM.
6. ALL FIRE ALARM WIRING MUST BE SOLID COPPER WIRING. STRANDED WIRING MUST NOT BE USED. MATCH EXISTING FIRE ALARM WIRING STANDARD (CLASS AND STYLE ETC.).
7. ALL FIRE ALARM WIRING MUST BE INSTALLED IN CONDUIT. CONDUIT MUST BE RIGID METAL OR ELECTRICAL METALLIC TUBING, WITH A MINIMUM INSIDE DIAMETER OF 19 MM (3/4 INCH) THAT UTILIZES COMPRESSION TYPE FITTINGS AND COUPLINGS.
8. PROVIDE ALL PROGRAMMING AND INTEGRATION WITH THE EXISTING FIRE ALARM SYSTEM.

LEGEND:

issued
PERMIT DRAWINGS
revised

A1-12
GFCI
WAP
MS
M
W
WAP
MS
M
F
FQ
OSD
EO.1

NEW ITEM TO BE INSTALLED.
EXISTING ITEM TO REMAIN.
EXISTING ITEM TO BE REMOVED.
WIRING.
UNDERGROUND WIRING.
CIRCUIT HOME RUN, LABEL INDICATES PANEL AND CIRCUIT NUMBER.
SPECIAL RECEPTACLE, COORDINATE EXACT TYPE AND NEMA CONFIGURATION.
NEMA 5-20R, 20A, 125V AC STRAIGHT BLADE DUPLEX RECEPTACLE.
NEMA 5-20R, 20A, 125V AC STRAIGHT BLADE DUPLEX.
NEMA 5-20R, 20A, 125V AC STRAIGHT BLADE DUPLEX RECEPTACLE WITH GROUND FAULT CIRCUIT INTERRUPTER (GFCI) PROTECTION.
NEMA 5-20R, 20A, 125V AC STRAIGHT BLADE DOUBLE DUPLEX RECEPTACLE.
FLOOR MOUNTED NEMA 5-20R, 20A, 125V AC STRAIGHT BLADE DUPLEX RECEPTACLE.
JUNCTION BOX.
ELECTRIC MOTOR.
MANUAL STARTER SWITCH.
HEAVY DUTY, NON-FUSIBLE DISCONNECT SWITCH, NEMA 1 600V. SURFACE MOUNTED.
HEAVY DUTY, FUSED DISCONNECT SWITCH, NEMA 1 600V. SURFACE MOUNTED.
PANELBOARD, SURFACE MOUNTED.
PANELBOARD, FLUSH MOUNTED.
DATA WALL OUTLET (ROUGH-IN ONLY). 4" SQUARE BOX WITH SINGLE GANG PLASTER RING AND BLANK COVERPLATE. PROVIDE 1' EMT FROM BOX TO ABOVE ACCESSIBLE CEILING, WITH BUSHING ON END AND PULLSTRING.
TELEPHONE WALL OUTLET (ROUGH-IN ONLY). 4" SQUARE BOX WITH SINGLE GANG PLASTER RING AND BLANK COVERPLATE. PROVIDE 1' EMT FROM BOX TO ABOVE ACCESSIBLE CEILING, WITH BUSHING ON END AND PULLSTRING.
FLOOR MOUNTED DATA OUTLET (ROUGH-IN ONLY). PROVIDE 1' EMT FROM FLOOR BOX TO ABOVE ACCESSIBLE CEILING, WITH BUSHING ON END AND PULLSTRING.
WIRELESS ACCESS POINT, CEILING MOUNTED.
SPEAKER.
CEILING MOUNTED CAMERA.
WALL MOUNTED CAMERA.
PUSH BUTTON.
ELECTRIC DOOR LOCK/STRIKE (ROUGH-IN ONLY). STRIKE IS MOUNTED INTO THE SIDE OF THE DOOR. 3/4" CONDUIT STUB TAAC, SWEEP FITTING, INSULATED BUSHING AND PULL STRING.
DOOR STATUS CONTACT(S) (ROUGH-IN ONLY). SWITCH IS RECESSED INTO THE DOOR FRAME. 3/4" CONDUIT STUB TAAC, SWEEP FITTING, INSULATED BUSHING AND PULL STRING.
KEY PAD.
CARD READER, (ROUGH-IN ONLY). 1-GANG BOX, 3/4" CONDUIT STUB TAAC, SWEEP FITTING, INSULATED BUSHING AND PULL STRING.
MOTION SENSOR.
MANUAL FIRE ALARM PULL STATION.
FIRE ALARM STROBE, MINIMUM CANDELA RATING INDICATED.
FIRE ALARM SPEAKER/STROBE, 85dB MINIMUM AT 10'.
FIRE ALARM PHOTOELECTRIC SMOKE DETECTOR.
FIRE ALARM DUCT SMOKE DETECTOR.
CAPITAL LETTER DENOTES LIGHT FIXTURE TYPE, SEE FIXTURE SCHEDULE.
SINGLE-POLE TOGGLE SWITCH, 120/277V, 20A, WITH WALL PLATE.
3-WAY TOGGLE SWITCH, 120/277V, 20A, WITH WALL PLATE.
DIMMER SWITCH.
LOW VOLTAGE SWITCH.
HP-RATED SWITCH WITH PILOT LIGHT.
WALL MOUNTED OCCUPANCY SENSOR, WATTSTOPPER #DSW-301 OR APPROVED EQUAL, DUAL TECHNOLOGY, LINE VOLTAGE SENSOR. SENSORS TO OPERATE IN "MANUAL ON" MODE. PROVIDE SENSOR WITH INTEGRAL " OVERRIDE" SWITCH.
WALL MOUNTED OCCUPANCY SENSOR WITH DIMMER, WATTSTOPPER #DW-311 OR APPROVED EQUAL, DUAL TECHNOLOGY, LINE VOLTAGE SENSOR. SENSORS TO OPERATE IN "MANUAL ON" MODE. 0-10VDC DIMMER. UP AND DOWN BUTTON.
CEILING MOUNTED OCCUPANCY SENSOR FOR CEILINGS BETWEEN 8-12 FEET A.F.F. WATTSTOPPER #DT-300 OR APPROVED EQUAL, DUAL TECHNOLOGY, LOW VOLTAGE SENSOR, WITH ALL ASSOCIATED POWER PACKS TO ACHIEVE CONTROL AS INDICATED. SENSOR TO OPERATE IN "MANUAL ON" MODE WHEN SHOWN WITH LOW-VOLTAGE SWITCHING.

THESE DRAWINGS AND SPECIFICATIONS, AND THE DESIGN, DRAWINGS, AND THE SERVICES REPRESENTED THEREIN, ARE THE EXCLUSIVE PROPERTY OF THE OREGON GROUP ARCHITECTS, INC. NO PART OF THESE DRAWINGS AND SPECIFICATIONS, OR THE SERVICES PROVIDED THEREIN, MAY BE REPRODUCED IN WHOLE OR IN PART, OR OTHERWISE UTILIZED, IN WHOLE OR IN PART, IN ANY OTHER DRAWINGS, SPECIFICATIONS, OR DESIGN, DRAWINGS, AND THE SERVICES PROVIDED THEREIN, OR IN ANY OTHER WORK, WITHOUT THE WRITTEN CONSENT OF THE OREGON GROUP ARCHITECTS, INC. THIS AGREEMENT IS MADE AND ENTERED INTO IN THE CITY OF DAYTON, OHIO, ON THIS 23RD DAY OF JANUARY, 2026.


THE OREGON GROUP ARCHITECTS
ARCHITECTURE IN FINEST CRAFTSMANSHIP
310 S. PATTERN AVE., DAYTON, OHIO 45402
937-224-1511 F 937-224-5663

office location for:
Valley view board of education
6027 Farmersville pike
germantown, ohio 45327
electrical general notes, legend, and specifications

project number
251431
date
1/23/2026
drawn by
EGM
checked by
SLC
sheet
TRI-TECH
Built On Integrity
ENGINEERING AND PROJECT MANAGEMENT
1785 S. METRO PARKWAY
CENTERVILLE, OH 45459
937.306.1630
800.334.1630
www.tri-tech.us
TRI-TECH PROJECT #25194

ABBREVIATIONS:

A.F.F. — ABOVE FINISHED FLOOR
A.H.J. — AUTHORITY HAVING JURISDICTION
CU — COPPER WIRING
E.C. — ELECTRICAL CONTRACTOR
E/R — EXISTING RELOCATED
FACP — FIRE ALARM CONTROL PANEL
GFCI — GROUND FAULT CIRCUIT INTERRUPTER
GND — GROUND
HP — HORSEPOWER
ID — INTERIOR DIAMETER
M.C. — MECHANICAL CONTRACTOR
NEC — NATIONAL ELECTRICAL CODE
NL — NIGHT LIGHT, WHERE FIXTURE IS DESIGNATED AS A NIGHT LIGHT, WIRE TO LOCAL LIGHTING CIRCUIT AHEAD OF ALL LOCAL SWITCHING.
P.C. — PLUMBING CONTRACTOR
SUR — SURFACE MOUNTED
TAAC — TO ABOVE ACCESSIBLE CEILING
TYP. — TYPICAL
VFD — VARIABLE FREQUENCY DRIVE

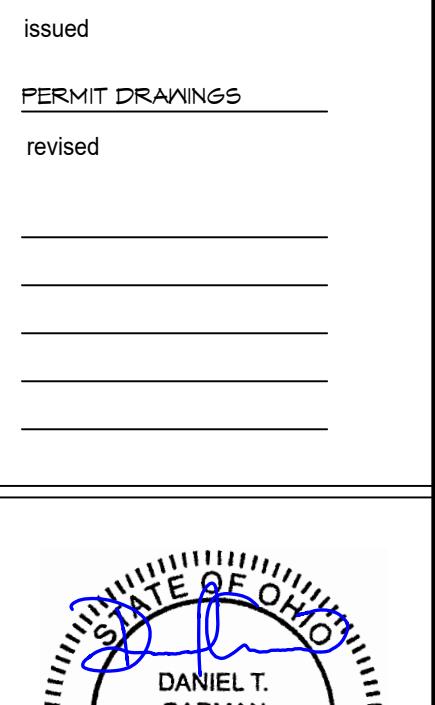


THESE DRAWINGS AND SPECIFICATIONS, AND THE DESIGN, DRAWINGS, AND THE SERVICES REPRESENTED THEREIN, ARE THE EXCLUSIVE PROPERTY OF THE OREGON GROUP ARCHITECTS, INC. NO PART OF THESE DRAWINGS AND SPECIFICATIONS, OR THE SERVICES PROVIDED THEREIN, MAY BE REPRODUCED IN WHOLE OR IN PART, OR OTHERWISE UTILIZED, IN WHOLE OR IN PART, IN ANY OTHER DRAWINGS, SPECIFICATIONS, OR DESIGN, DRAWINGS, AND THE SERVICES PROVIDED THEREIN, OR IN ANY OTHER WORK, WITHOUT THE WRITTEN CONSENT OF THE OREGON GROUP ARCHITECTS, INC. THIS AGREEMENT IS MADE AND ENTERED INTO IN THE CITY OF DAYTON, OHIO, ON THIS 23RD DAY OF JANUARY, 2026.


THE OREGON GROUP ARCHITECTS
ARCHITECTURE IN FINEST CRAFTSMANSHIP
310 S. PATTERN AVE., DAYTON, OHIO 45402
937-224-1511 F 937-224-5663

office location for:
Valley view board of education
6027 Farmersville pike
germantown, ohio 45327
electrical general notes, legend, and specifications

project number
251431
date
1/23/2026
drawn by
EGM
checked by
SLC
sheet
TRI-TECH
Built On Integrity
ENGINEERING AND PROJECT MANAGEMENT
1785 S. METRO PARKWAY
CENTERVILLE, OH 45459
937.306.1630
800.334.1630
www.tri-tech.us
TRI-TECH PROJECT #25194

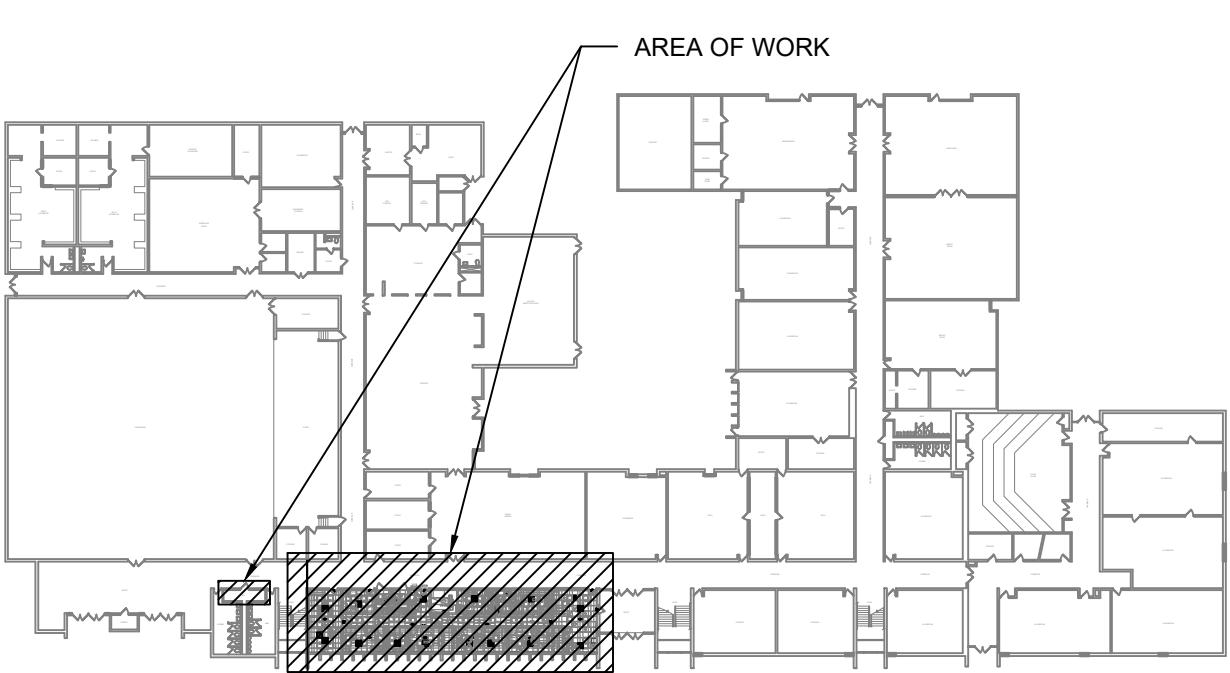

 **KEY PLAN**
SCALE: NONE

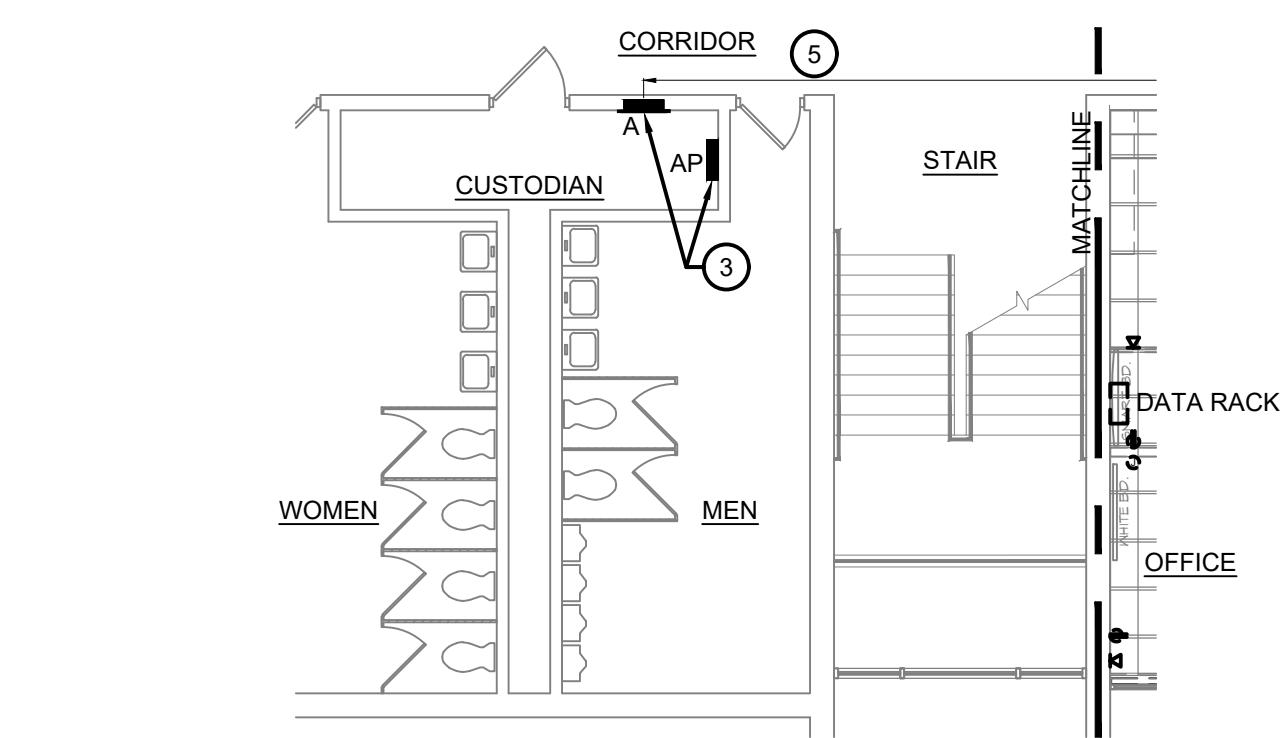



ELECTRICAL DEMOLITION PLAN

SCALE: 1/8"=1'-0"

DEMOLITION GENERAL NOTES:

- A. EXISTING CONDITIONS SHOWN ON THIS DRAWING ARE TAKEN FROM ORIGINAL DRAWINGS AND FIELD INVESTIGATION. ALL EXISTING CONDITIONS MUST BE VERIFIED PRIOR TO BID. FIELD CONDITIONS SHALL GOVERN.
- B. ALL CONDUITS AND/OR WIRING SERVING OTHER SPACES OR FLOORS, THAT RUN THROUGH THE PROJECT AREA SHALL REMAIN ACTIVE DURING CONSTRUCTION SO AS NOT TO CAUSE ANY DISRUPTION TO THESE OTHER SPACES.
- C. ALL CEILING MOUNTED DEVICES NOT SPECIFICALLY INDICATED IN THE PROJECT AREA SHALL BE REMOVED AND REINSTALLED TO FACILITATE INSTALLATION OF NEW CEILINGS/LIGHT FIXTURES.
- D. REMOVE AND REINSTALL EXISTING TO REMAIN WIRING DEVICES AND EQUIPMENT AS REQUIRED TO FACILITATE NEW WALL PAINTING.
- E. ALL CONDUIT, WIRING, BOXES, AND RACEWAY THAT IS NOT BEING REUSED SHALL BE REMOVED BACK TO PANEL FROM WHERE IT ORIGINATES.

○ DEMOLITION NOTES:

1. MAINTAIN EXISTING RECESSED BOX FOR NEW WIRING DEVICE. REFER TO THE NEW WORK PLANS.
2. REMOVE FLOOR OUTLET. INFILL WITH CONCRETE. GRIND FLUSH WITH THE FINISHED FLOOR.
3. EXISTING PANELBOARD SHALL REMAIN.
4. RELOCATE CAMERA, FIRE ALARM DEVICES, SECURITY EQUIPMENT, WI-FI EQUIPMENT ETC... DENOTED WITH AN "E/R". REFER TO THE NEW WORK PLANS FOR LOCATION. EXTEND EXISTING CIRCUITS AS REQUIRED.
5. REMOVE AND REINSTALL CEILING MOUNTED EQUIPMENT, LIGHTING AND OTHER DEVICES TO FACILITATE THE INSTALLATION OF NEW CONDUITS IN THIS ROOM.
6. RELOCATE DOOR RELEASE PUSHBUTTON TO THE NEW DESK AS SHOWN ON THE NEW WORK PLAN. EXTEND EXISTING CIRCUIT AS REQUIRED.
7. EXISTING WALL MOUNTED DATA RACK SHALL BE RELOCATED BY THE OWNER. RACK WILL BE MOVING TO ROOM 112 - IT CLOSET AS SHOWN ON THE NEW WORK PLAN.
8. REMOVE BUILDING CLOCK SYSTEM AND ASSOCIATED WIRING.
9. REMOVE DUKANE INTERCOM SYSTEM CABINET AND TURN EQUIPMENT OVER TO THE OWNER. RELOCATE AUDIO CABLES PENETRATING WALL TO A LOCATION ABOVE THE GRID CEILING. BUNDLE CABLES AND PROVIDE A TAG THAT THESE CABLES ARE FOR THE DUKANE INTERCOM SYSTEM. COORDINATE WITH THE OWNER PRIOR TO DEMOLITION. PATCH BRICK WALL.
10. REMOVE SECURITY PANELS, MOTION DETECTORS AND ASSOCIATED WIRING. COORDINATE WITH THE OWNER PRIOR TO DEMOLITION.
11. REMOVE ABANDONED WALL MOUNTED EQUIPMENT AS REQUIRED TO FACILITATE NEW ARCHITECTURAL WORK ON THE WALL. REMOVE ALL INCLUSIONS, ANCHORS, SCREWS, ETC. PATCH MASONRY. COORDINATE DEMOLITION WITH THE ARCHITECT PRIOR TO ROUGH-IN.
12. REMOVE COVERPLATE, BOX AND WIRING ABOVE AND BELOW INTERCOM. PATCH BRICK WALL.
13. REMOVE SPEAKER AND THERMOSTAT.
14. REMOVE MOTION DETECTOR AND WIRING. REMOVE JUNCTION BOX IF ABANDONED.
15. REPLACE IVORY BLANK COVERPLATE WITH BROWN.
16. RELOCATE DUCT DETECTOR AS REQUIRED TO FACILITATE THE REPLACEMENT OF THE MECHANICAL UNIT. COORDINATE WITH THE MECHANICAL CONTRACTOR PRIOR TO DEMOLITION.


The logo for Oregon Group Architects. It features a large, bold, black-outlined letter 'O' on the left. To the right of the 'O', the word 'OREGON' is stacked vertically in a large, serif font. To the right of 'OREGON', the word 'GROUP' is stacked vertically in a smaller, serif font. To the right of 'GROUP', the word 'ARCHITECTS' is stacked vertically in a large, serif font. Below 'ARCHITECTS', the words 'ARCHITECTURE', 'INTERIORS', and 'CODE CONSULTANTS' are stacked vertically in a smaller, serif font.

alley view board of education
6027 farmersville pike
germantown, ohio 45327

office renovation for:
electrical demolition plan

project number
251431
date
1/23/2026
drawn by
EGM
checked by
SLG

sheet

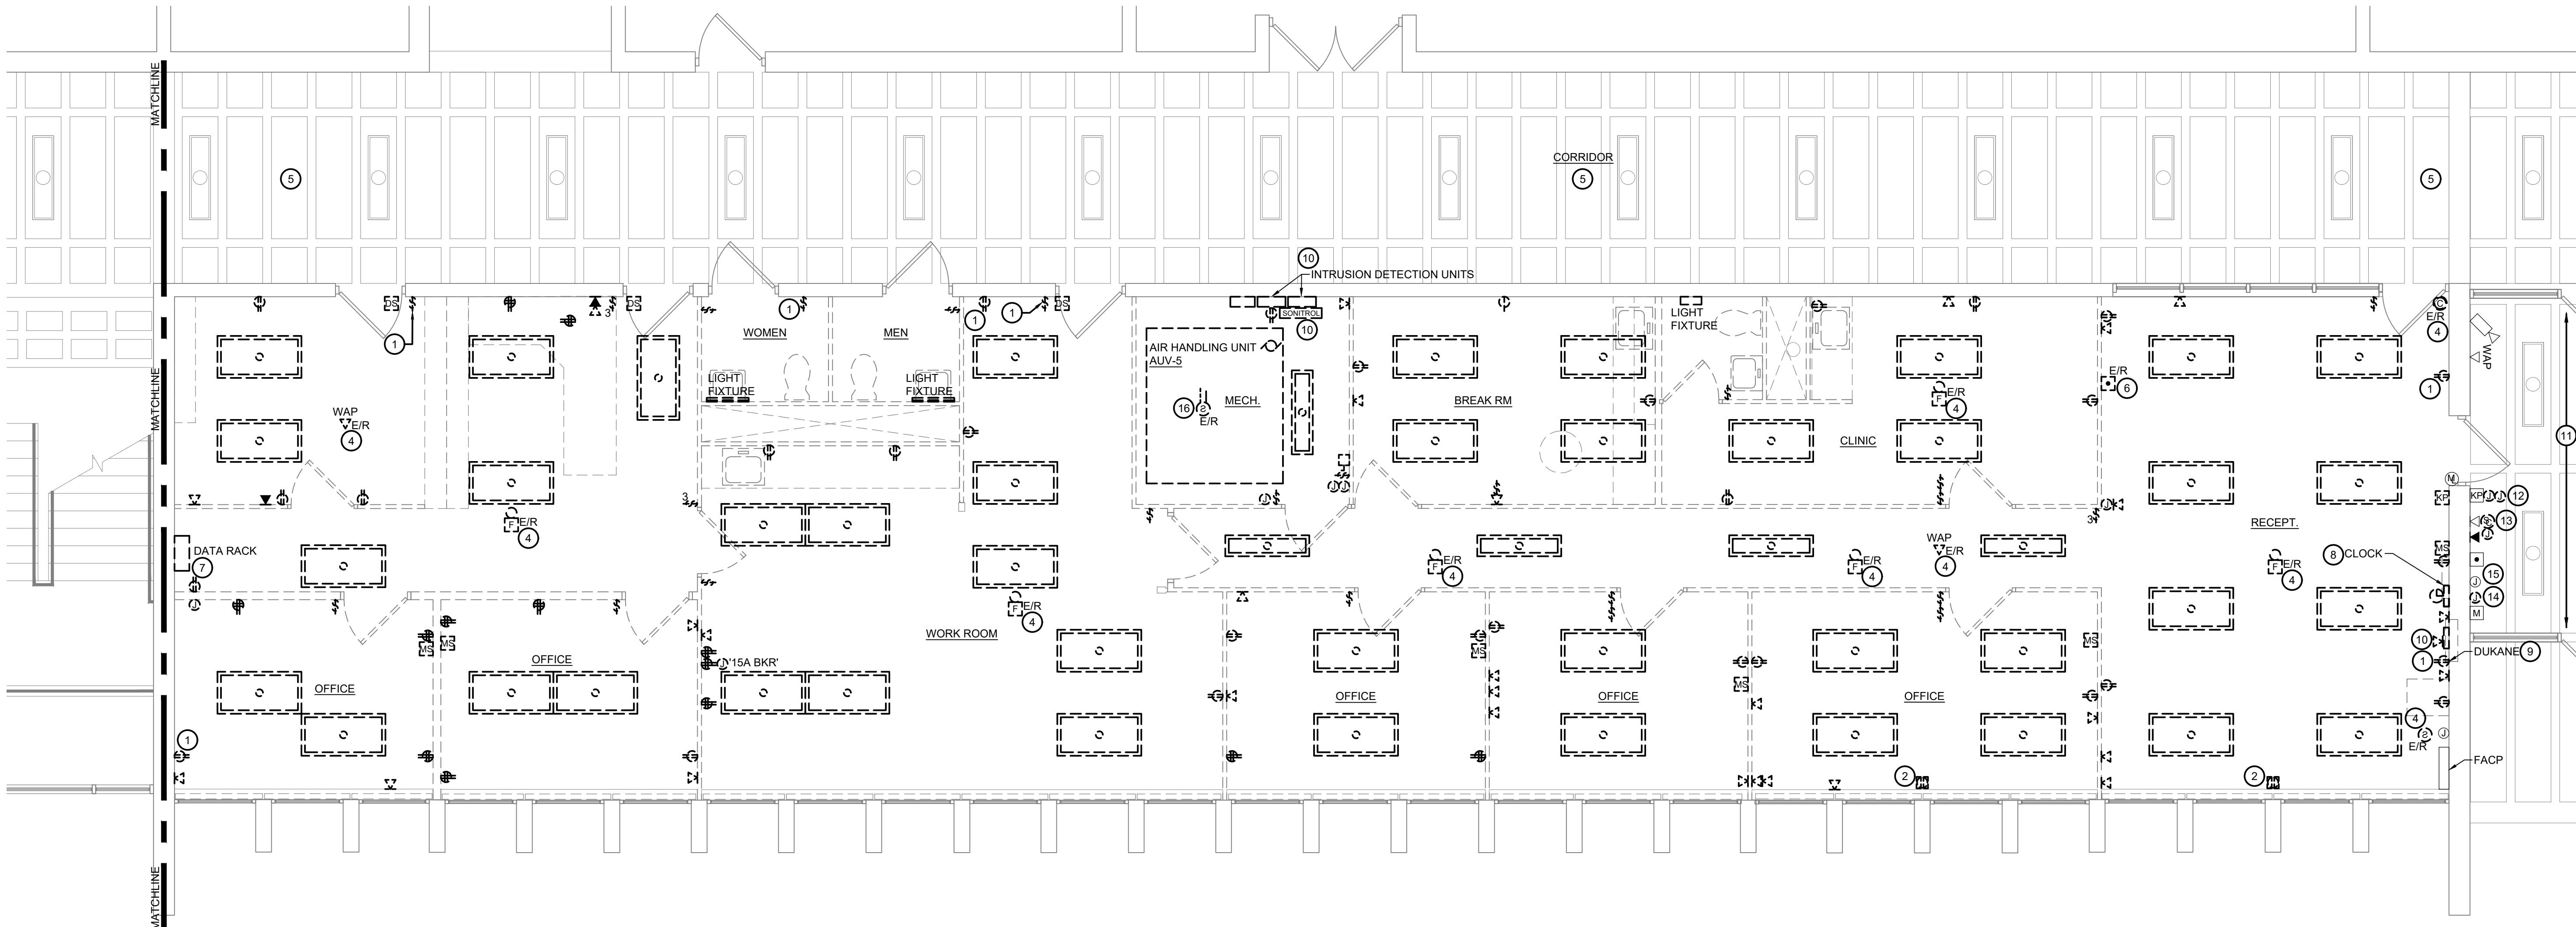



ELECTRICAL DEMOLITION PLAN


SCALE: 1/4"=1'-0"



1785 S. METRO PARKWAY
CENTERVILLE, OH 45459
WWW.TRFTECH.US 937.306.1630
800.334.1630


RI-TECH PROJECT #25194

E1.1

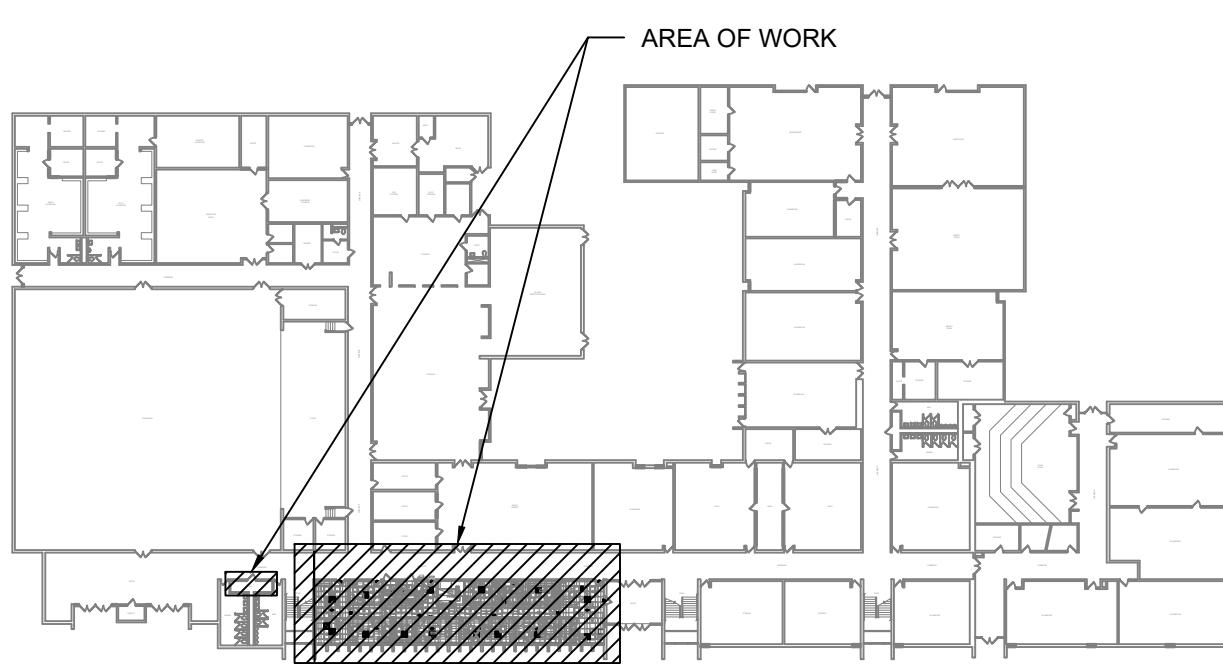

KEY PLAN

SCALE: NONE

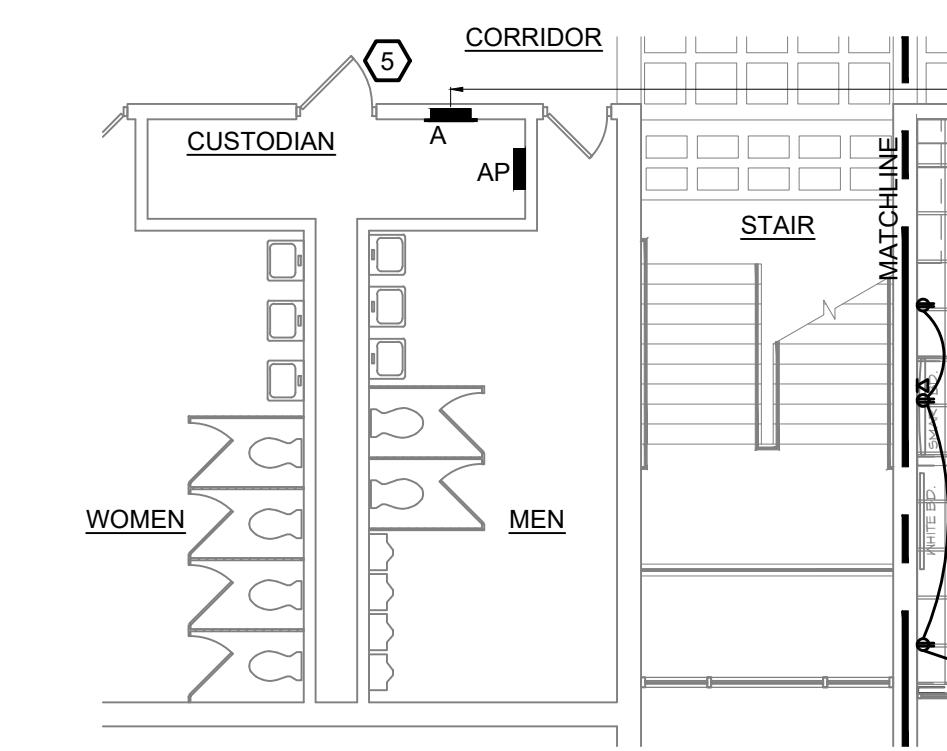

LIGHTING NEW WORK PLAN

SCALE: 1/8"=1'-0"

NEW WORK GENERAL NOTES:

- A. THE SPACE ABOVE THE CEILING IS A RETURN AIR PLENUM. CABLING ABOVE THE CEILING SHALL BE PLENUM RATED OR INSTALLED IN CONDUIT.
- B. ANY ROOF PENETRATIONS TO BE COORDINATED WITH ROOF MANUFACTURER'S REQUIREMENTS (TO ENSURE EXISTING WARRANTY REMAINS) AND ROOF REMAINS IN WATERPROOF CONDITION. ALTERATIONS TO ROOF SHALL BE PERFORMED BY A ROOFING CONTRACTOR CERTIFIED BY THE ROOFING MANUFACTURER TO MAKE ALTERATIONS AND MAINTAIN WARRANTY.
- C. CIRCUIT EMERGENCY AND EXIT LUMINAIRES AHEAD OF LOCAL SWITCHING PER LOCAL AND NATIONAL ELECTRICAL CODES.
- D. LOCATE OCCUPANCY SENSORS AT LEAST 6'-0" FROM HVAC SUPPLY AND RETURN DIFFUSERS.
- E. NEW WALLS WILL GO TO DECK. REMOVE AND REINSTALL EXISTING CONDUITS, CABLING, EQUIPMENT AND OTHER ABOVE CEILING ELECTRICAL WORK TO FACILITATE THE INSTALLATION OF NEW WALLS. PROVIDE FIRESTOPPING AS REQUIRED.


INSTALLATION NOTES:

1. INSTALL WIRING DEVICE IN EXISTING RECESSED BOX.
2. LIGHTING CONTROL SEQUENCE OF OPERATION SHALL BE AS FOLLOWS: AUTOMATIC ON VIA OCCUPANCY SENSOR. AUTOMATIC OFF AFTER 20 MINUTES OF INACTIVITY. WALL SWITCHES SHALL NOT BE CAPABLE OF DIMMING.
3. LIGHTING CONTROL SEQUENCE OF OPERATION SHALL BE AS FOLLOWS: AUTOMATIC ON VIA OCCUPANCY SENSOR. AUTOMATIC OFF AFTER 20 MINUTES OF INACTIVITY. WALL SWITCHES SHALL BE CAPABLE OF DIMMING.
4. LIGHTING CONTROL SEQUENCE OF OPERATION SHALL BE AS FOLLOWS: MANUAL ON VIA WALL SWITCHES. AUTOMATIC OFF AFTER 20 MINUTES OF INACTIVITY. WALL SWITCHES SHALL BE CAPABLE OF DIMMING.
5. REMOVE AND REINSTALL CEILING MOUNTED EQUIPMENT, LIGHTING AND OTHER DEVICES TO FACILITATE THE INSTALLATION OF NEW CONDUITS IN THIS ROOM.

issued
PERMIT DRAWINGS
revised


DANIEL T. GARMAN
E-74339
23 Jan 2026

THESE DRAWINGS AND
SPECIFICATIONS, THE DESCRIPTIONS, AND THE
DRAWINGS AND SPECIFICATIONS THEREIN, AND THE
SERVICES REPRESENTED THEREBY, ARE THE EXCLUSIVE PROPERTY OF
THE OREGON GROUP ARCHITECTS INC.,
THEIR ASSOCIATES, AND THEIR SUBCONTRACTORS.
THESE DRAWINGS AND SPECIFICATIONS ARE
NOT TO BE COPIED, REPRODUCED, IN WHOLE OR IN
PART, OR TO BE DISCLOSED, IN WHOLE OR IN
PART, TO ANY OTHER PERSON, OR TO BE USED
FOR ANY OTHER PURPOSE, WITHOUT THE
CONSENT OF THE ARCHITECTS, THE
OREGON GROUP ARCHITECTS INC., ©
2020.

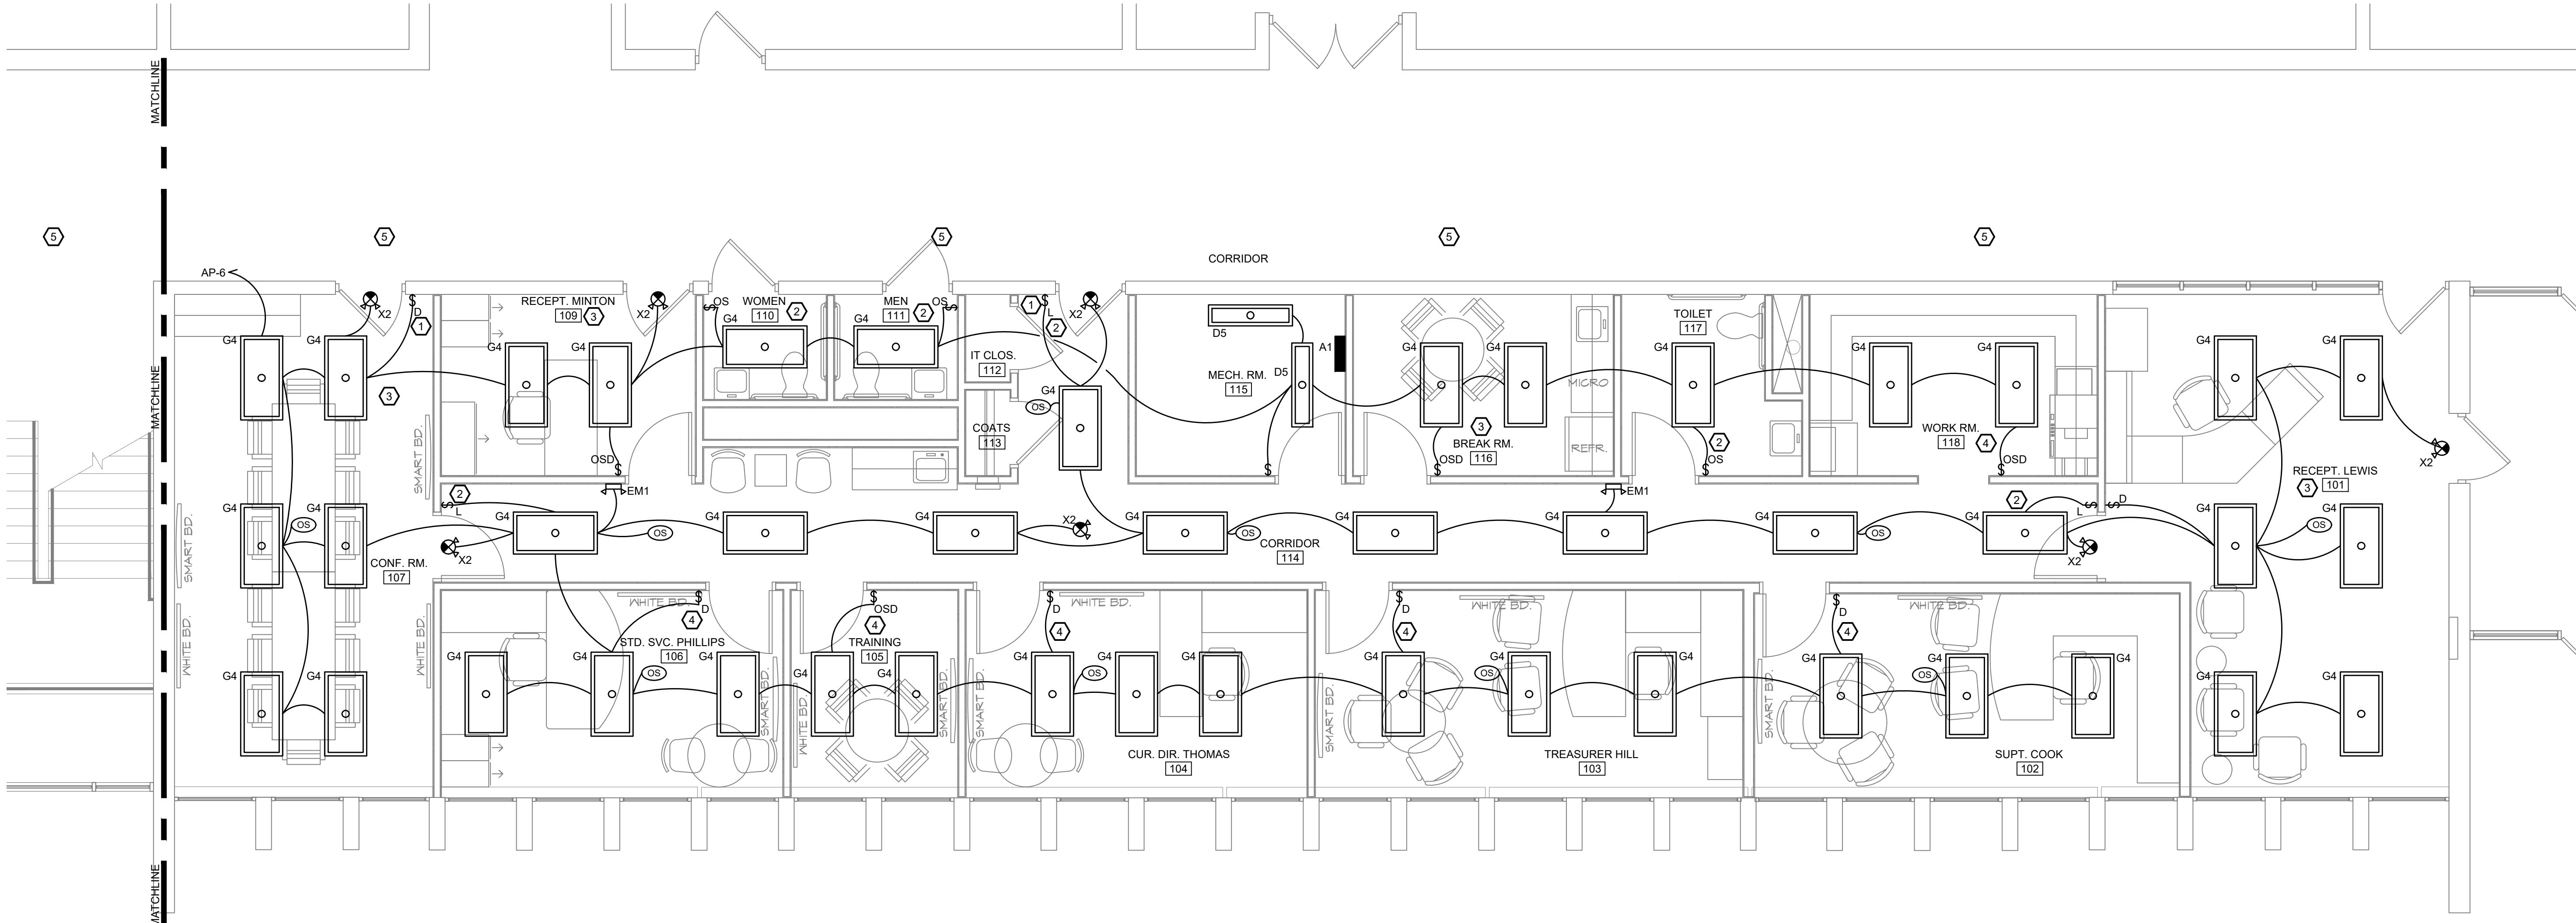

LIGHTING NEW WORK PLAN

SCALE: 1/4"=1'-0"



OREGON GROUP ARCHITECTS
ARCHITECTURE IN FERROUS CONSULTANTS
THE PARSONAGE HOUSE
310 S. PATERSON BLVD. DAYTON, OHIO 45402
937-223-1511 F 937-223-5663

office view board of education
valley view board of education
6027 farmersville pike
germantown, ohio 45327
lighting new work plan

project number
251941
date
1/23/2026
drawn by
EGM
checked by
SLC


sheet

E2.1

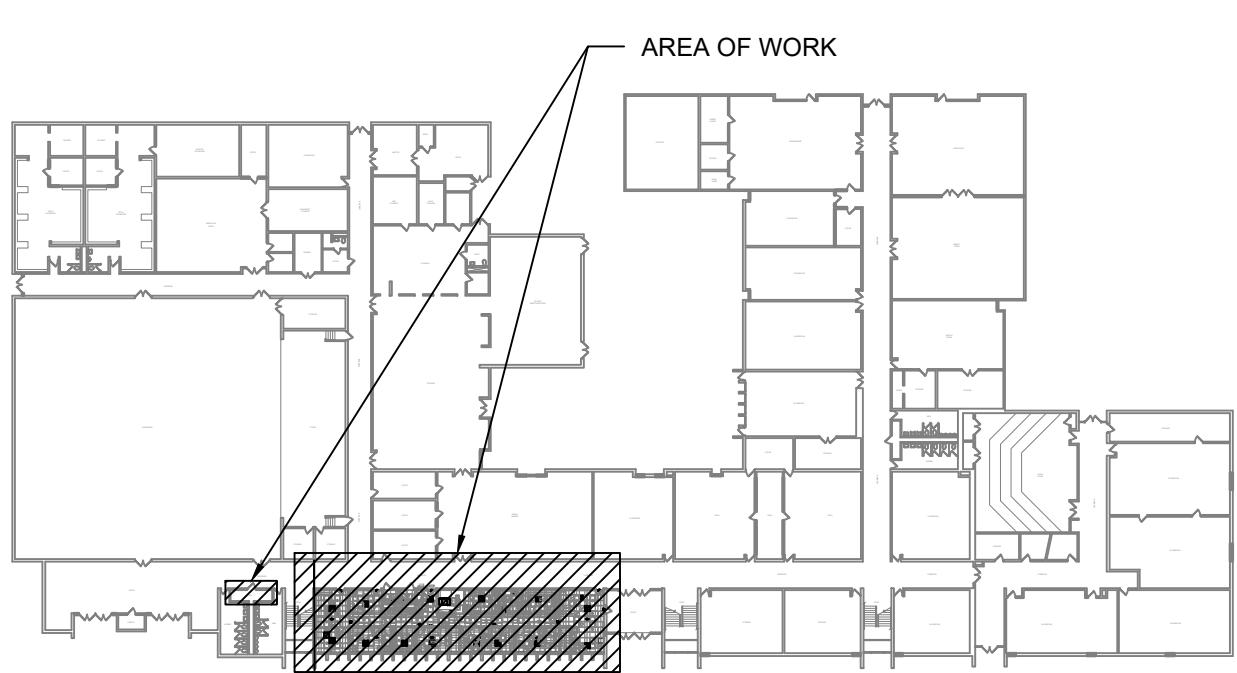


KEY PLAN

SCALE: NONE

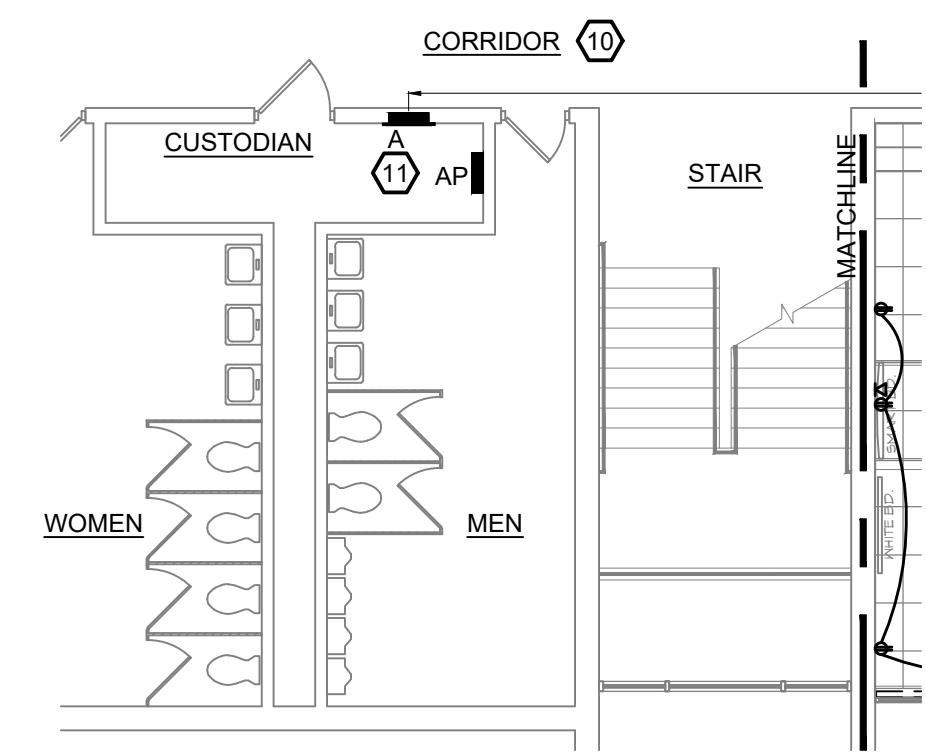

POWER NEW WORK PLAN

SCALE: 1/8"=1'-0"

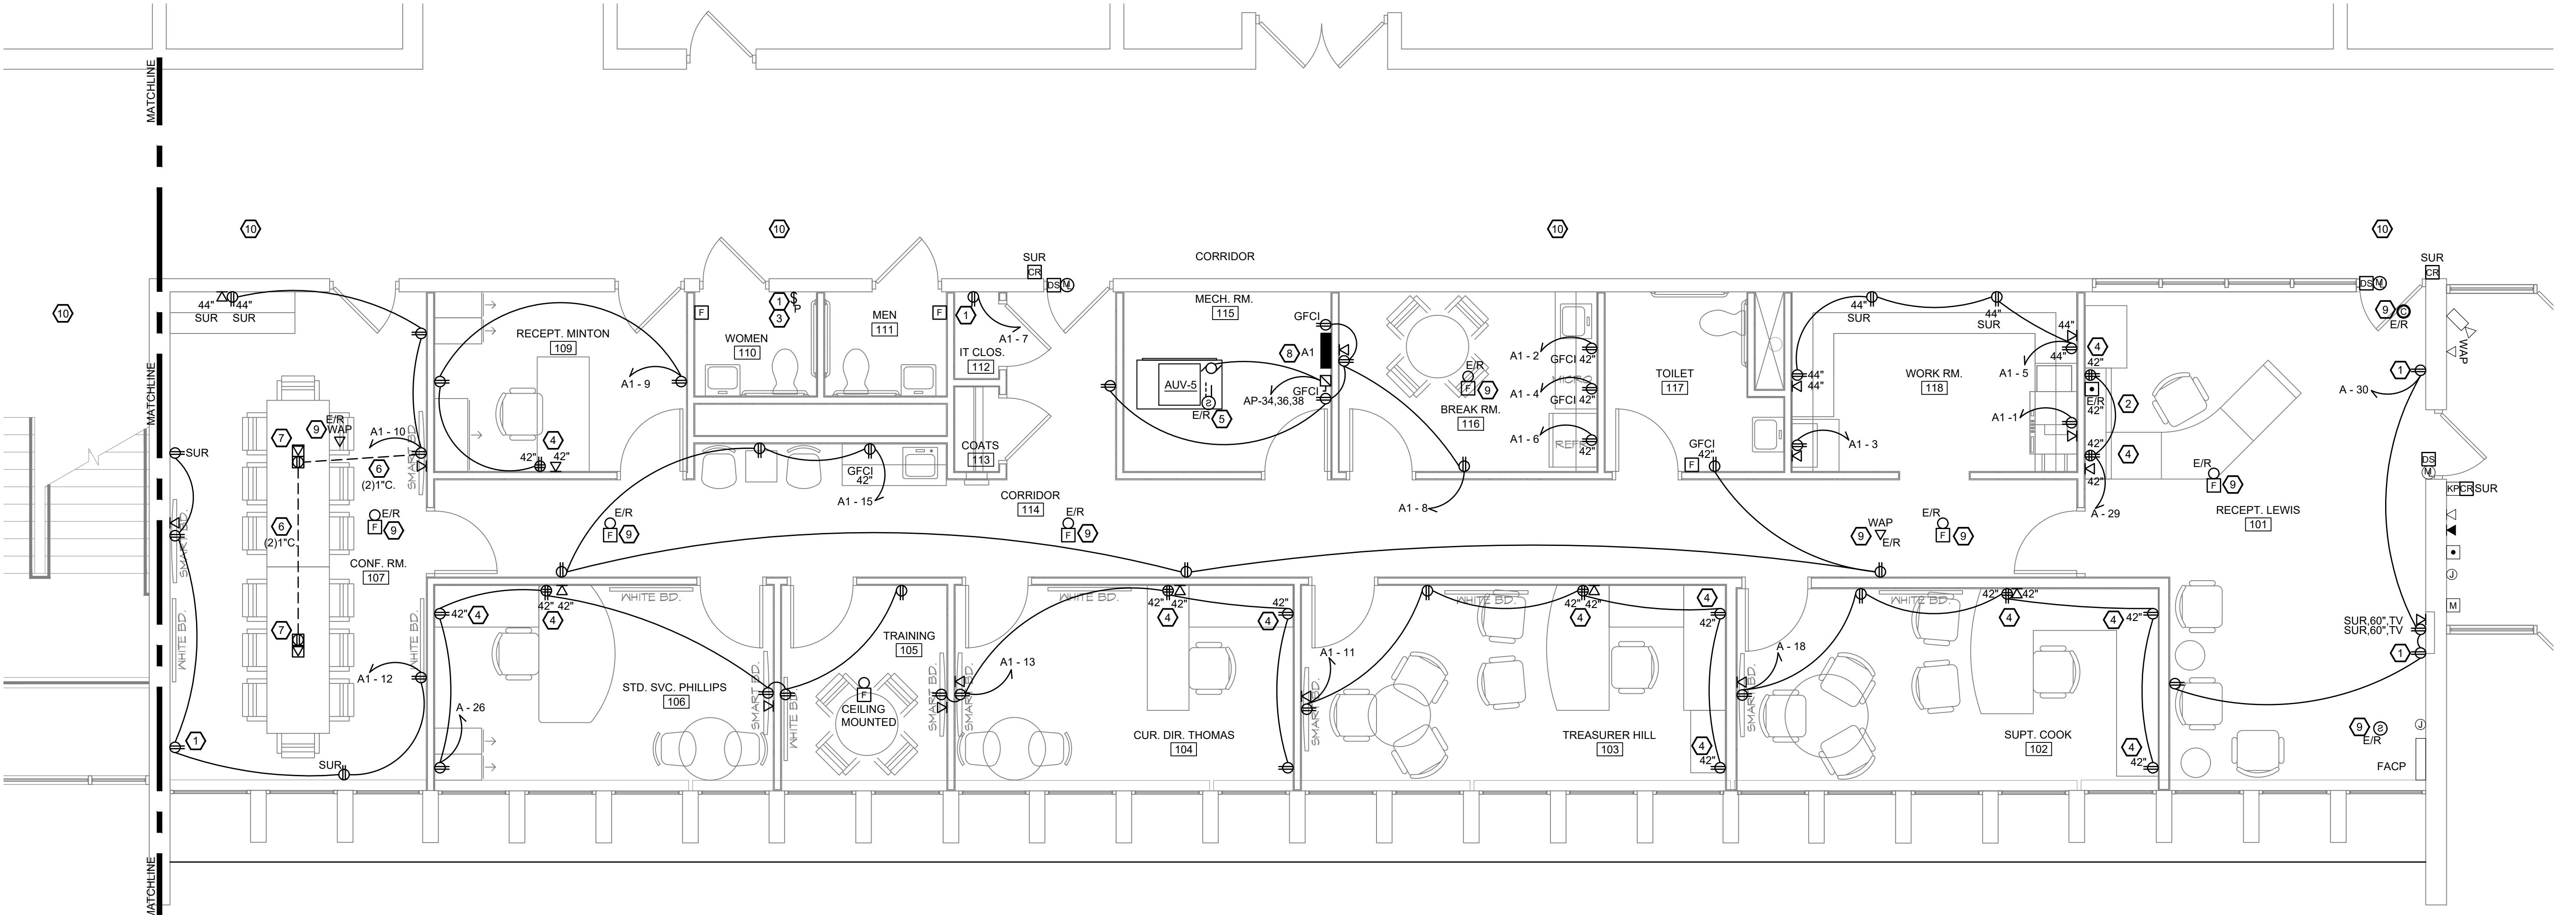

POWER NEW WORK PLAN

SCALE: 1/4"=1'-0"

NEW WORK GENERAL NOTES:

- A. THE SPACE ABOVE THE CEILING IS A RETURN AIR PLenum. CABLING ABOVE THE CEILING SHALL BE PLenum RATED OR INSTALLED IN CONDUIT.
- B. ANY ROOF PENETRATIONS TO BE COORDINATED WITH ROOF MANUFACTURER'S REQUIREMENTS (TO ENSURE EXISTING WARRANTY REMAINS) AND ROOF REMAINS IN WATERTIGHT CONDITION. ALTERATIONS TO ROOF SHALL BE PERFORMED BY A ROOFING CONTRACTOR CERTIFIED BY THE ROOFING MANUFACTURER TO MAKE ALTERATIONS AND MAINTAIN WARRANTY.
- C. CIRCUIT EMERGENCY AND EXIT LUMINAIRES AHEAD OF LOCAL SWITCHING PER LOCAL AND NATIONAL ELECTRICAL CODES.
- D. LOCATE OCCUPANCY SENSORS AT LEAST 6'-0" FROM HVAC SUPPLY AND RETURN DIFFUSERS.
- E. NEW WALLS WILL GO TO DECK. REMOVE AND REINSTALL EXISTING CONDUITS, CABLING, EQUIPMENT AND OTHER ABOVE CEILING ELECTRICAL WORK TO FACILITATE THE INSTALLATION OF NEW WALLS. PROVIDE FIRESTOPPING AS REQUIRED.

GENERAL NOTES - COMMUNICATIONS TECHNOLOGY:

- A. UNLESS NOTED OTHERWISE ON THE DRAWINGS, PROVIDE ROUGH-IN FOR COMMUNICATIONS DEVICES SUCH AS VOICE/DATA OUTLETS, CAMERAS, KEYPADS, MOTION SENSORS, SECURITY AND ACCESS CONTROL. COORDINATE WORK WITH THE OWNER.
- B. RELOCATE EXISTING DEVICES AS REQUIRED TO FACILITATE THE REPLACEMENT OF WALLS AND CEILINGS. EXTEND EXISTING CABLING AS REQUIRED.
- C. CONDUIT STUBS ARE FOR LAY-IN CEILINGS ONLY. FOR DRYWALL OR HARD CEILINGS, RUN CONDUIT TO A LOCATION WHERE THE CABLING CAN BE ACCESSIBLE. PROVIDE PULL STRING.
- D. PROVIDE BLANK WALL PLATES FOR UNUSED DEVICE BOXES.

INSTALLATION NOTES:

1. INSTALL WIRING DEVICE IN EXISTING RECESSED BOX.
2. INSTALL DOOR RELEASE BUTTON SAVED FROM DEMOLITION. VERIFY LOCATION WITH THE OWNER PRIOR TO ROUGH-IN. EXTEND EXISTING CIRCUIT AS REQUIRED.
3. PROVIDE LABEL THAT PILOT LIGHT SWITCH CONTROLS THE EXISTING ROOF MOUNTED EXHAUST FAN. COORDINATE WITH MECHANICAL CONTRACTOR.
4. MOUNT DESK RECEPTACLES AND DATA OUTLETS ABOVE COUNTER. VERIFY MOUNTING HEIGHTS AND DESK LOCATIONS WITH THE OWNER PRIOR TO ROUGH-IN.
5. RELOCATE DUCT DETECTOR AS REQUIRED TO FACILITATE THE REPLACEMENT OF THE MECHANICAL UNIT. COORDINATE WITH THE MECHANICAL CONTRACTOR PRIOR TO DEMOLITION.
6. PROVIDE SAWCUT, CONDUITS, CONDUCTORS, BACKFILL AND FLOOR FINISHING FOR FLOOR BOXES.
7. PROVIDE MULTI-COMPARTMENT FLOOR BOX. FLOOR BOX SHALL BE EQUAL TO WIREMOLD #880CS2-1 TWO COMPARTMENT CAST IRON FLOOR BOX, #827B BRASS CARPET FLANGE, #828DPGFTC BRASS COVER PLATE AND #808COMTC BRASS COMMUNICATION COVER PLATE. PROVIDE DUPLEX RECEPTACLE AND DATA OUTLETS. COORDINATE LOCATION, FLANGE AND COVER FINISH WITH THE ARCHITECT PRIOR TO ROUGH-IN.
8. PROVIDE NEW PANELBOARD. PROVIDE NEW FEEDER TO PANEL.
9. INSTALL CAMERA, FIRE ALARM DEVICES, SECURITY EQUIPMENT, WI-FI EQUIPMENT ETC... DENOTED WITH AN 'E/R'. EXTEND EXISTING CIRCUITS AS REQUIRED.
10. REMOVE AND REINSTALL CEILING MOUNTED EQUIPMENT, LIGHTING AND OTHER DEVICES TO FACILITATE THE INSTALLATION OF NEW CONDUITS IN THIS ROOM.
11. EXISTING PANELBOARD SHALL REMAIN.

issued
PERMIT DRAWINGS
revised


DANIEL T. GARMAN
E-74339
23 Jan 2026

THESE DRAWINGS AND SPECIFICATIONS, THE DESCRIPTIONS, AND THE DRAWINGS, WHETHER REPRODUCED OR NOT, ARE THE EXCLUSIVE PROPERTY OF THE OREGON GROUP ARCHITECTS INC. NO PART OF THESE DRAWINGS OR SPECIFICATIONS MAY BE REPRODUCED, COPIED, OR USED IN WHOLE OR IN PART, OR DISCLOSED TO ANYONE, EXCEPT AS AUTHORIZED IN THE CONTRACT DOCUMENTS. THE OREGON GROUP ARCHITECTS INC. IS NOT RESPONSIBLE FOR ANY LOSS OR DAMAGE WHICH MAY OCCUR IN THE USE OF THESE DRAWINGS AND SPECIFICATIONS.

OREGON GROUP ARCHITECTS
ARCHITECTURE IN FERNS, CONSULTANTS
310 S. PATERSON AVE., DAYTON, OHIO 45402
937-226-1511 F 937-226-5663


office renovation for:
valley view board of education
6027 farmersville pike
germantown, ohio 45327
power new work plan

project number
251941
date
1/23/2026
drawn by
EGM
checked by
SLC

sheet

MOTORS, STARTERS, DISCONNECTS, AND CONTROLS

NOTE

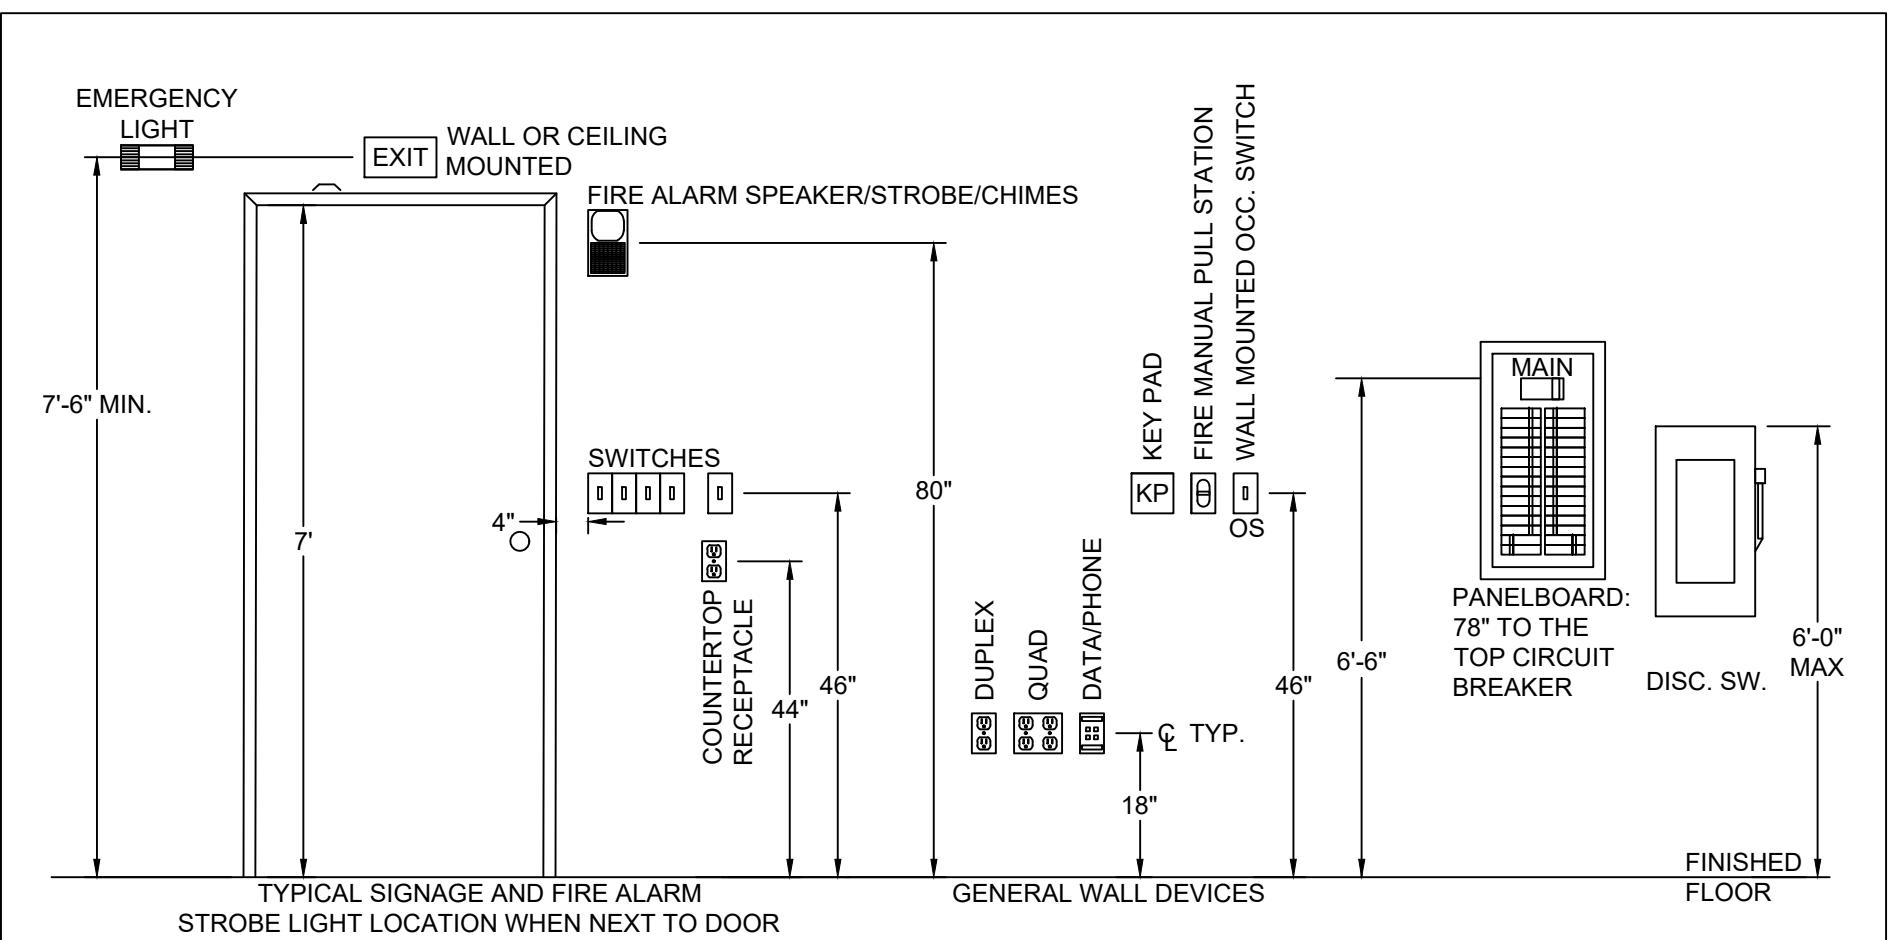

MOUNTING HEIGHT ELEVATION DETAIL






SCALE: NONE

Fixture Schedule

SYMBOL	MARK	COLOR TEMPERATURE	LED	H.I.D.	HALOGEN	RECESSED	WALL MOUNTED	SURFACE MOUNTED	PENDANT MOUNTED	VOLTAGE	INPUT WATTS	MANUFACTURER AND SERIES	DESCRIPTION	NOTES
	D5	4000K	●					●		277	41	LITHONIA #ZL1D L48 5000LM FST MVOLT 40K 80CRI WH OR EQUAL BY COLUMBIA	4' LED STRIP. 5000 LUMENS, 4000K, WHITE, MVOLT	
	G4	VARIES	●			●				277	48	LITHONIA #CPX 2X4 AL08 80CRI SWW7 SWL MVOLT OR EQUAL BY COLUMBIA	2'x4' LED FLAT PANEL. SWITCHABLE 4000/5000/6000 LUMENS AND 35/40/50K COLOR TEMP, 0-10V DIMMABLE	2
	EM1	-	●				●			277	2	LITHONIA #ELM2L M12 OR EQUAL BY DUAL-LITE	LED EMERGENCY LIGHTING UNIT WITH TWO HEADS. WALL MOUNTED, WHITE	1
	X2	-	●							277	5	LITHONIA #LHQML LED R OR EQUAL BY DUAL-LITE	LED COMBINATION EXIT SIGN / EMERGENCY LIGHT. RED LETTERS, BATTERY, UNIVERSAL MOUNTING, WHITE	1


NOTES:

1. WIRE ALL EXIT AND EMERGENCY LIGHTS TO LOCAL LIGHTING CIRCUIT AHEAD OF ALL LOCAL SWITCHING.
2. COORDINATE LIGHT FIXTURE BRIGHTNESS AND COLOR TEMPERATURE SETTING WITH THE OWNER. INITIAL SETTINGS ARE AS FOLLOWS: 5000K COLOR TEMP IN CORRIDORS, 4000K COLOR TEMP IN OFFICES, MIDDLE BRIGHTNESS SETTING.

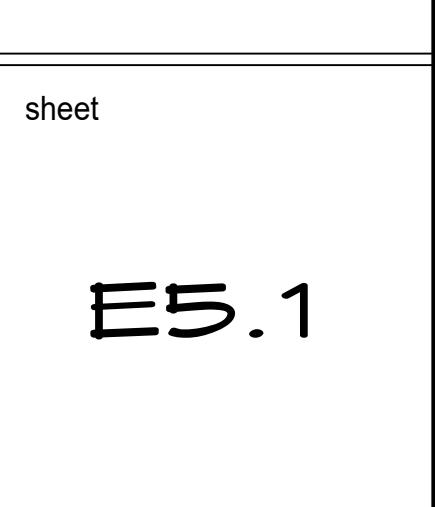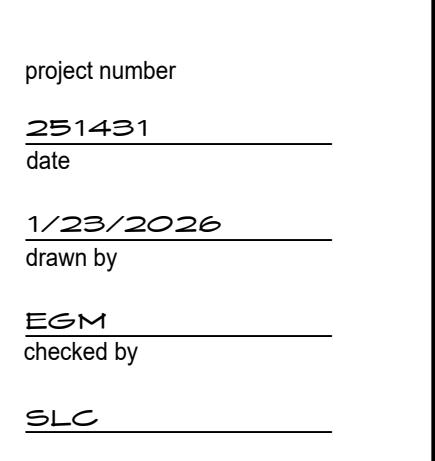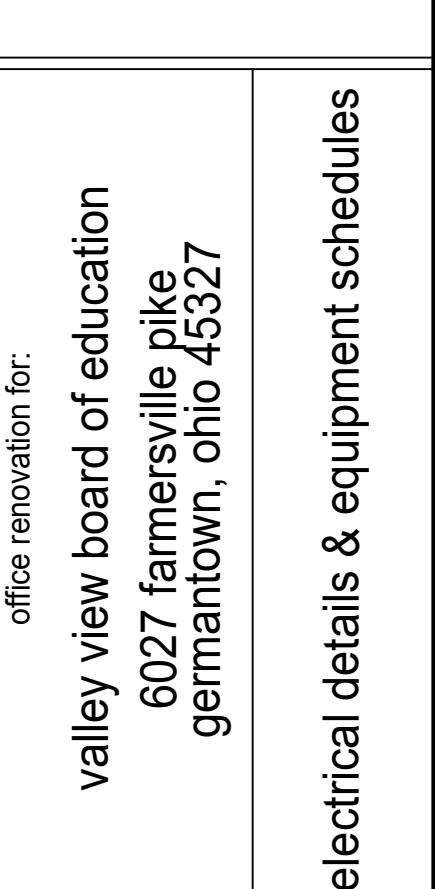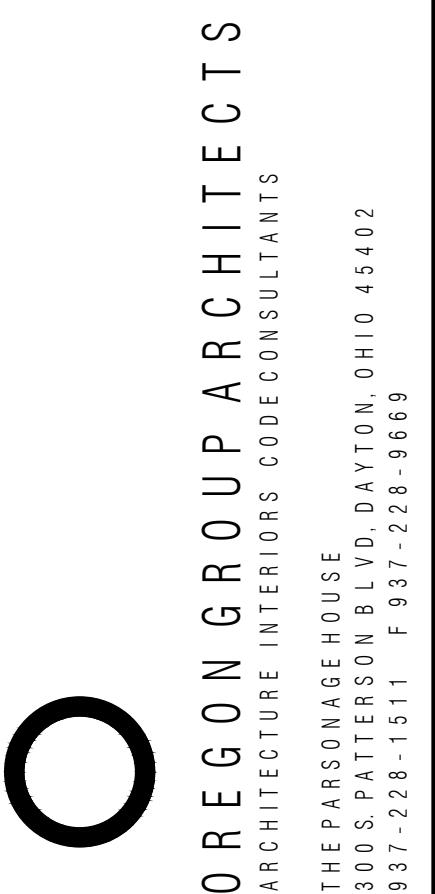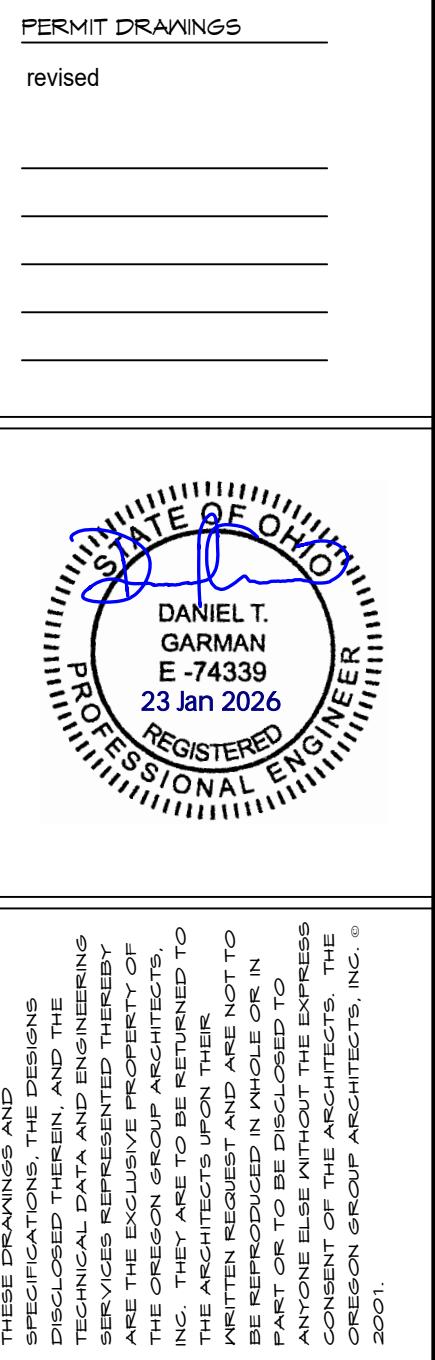

5 S. METRO PARKWAY
MONTVILLE, OH 44549 937.306.1630
800.334.1630

TRI TECH PROJECT #25194

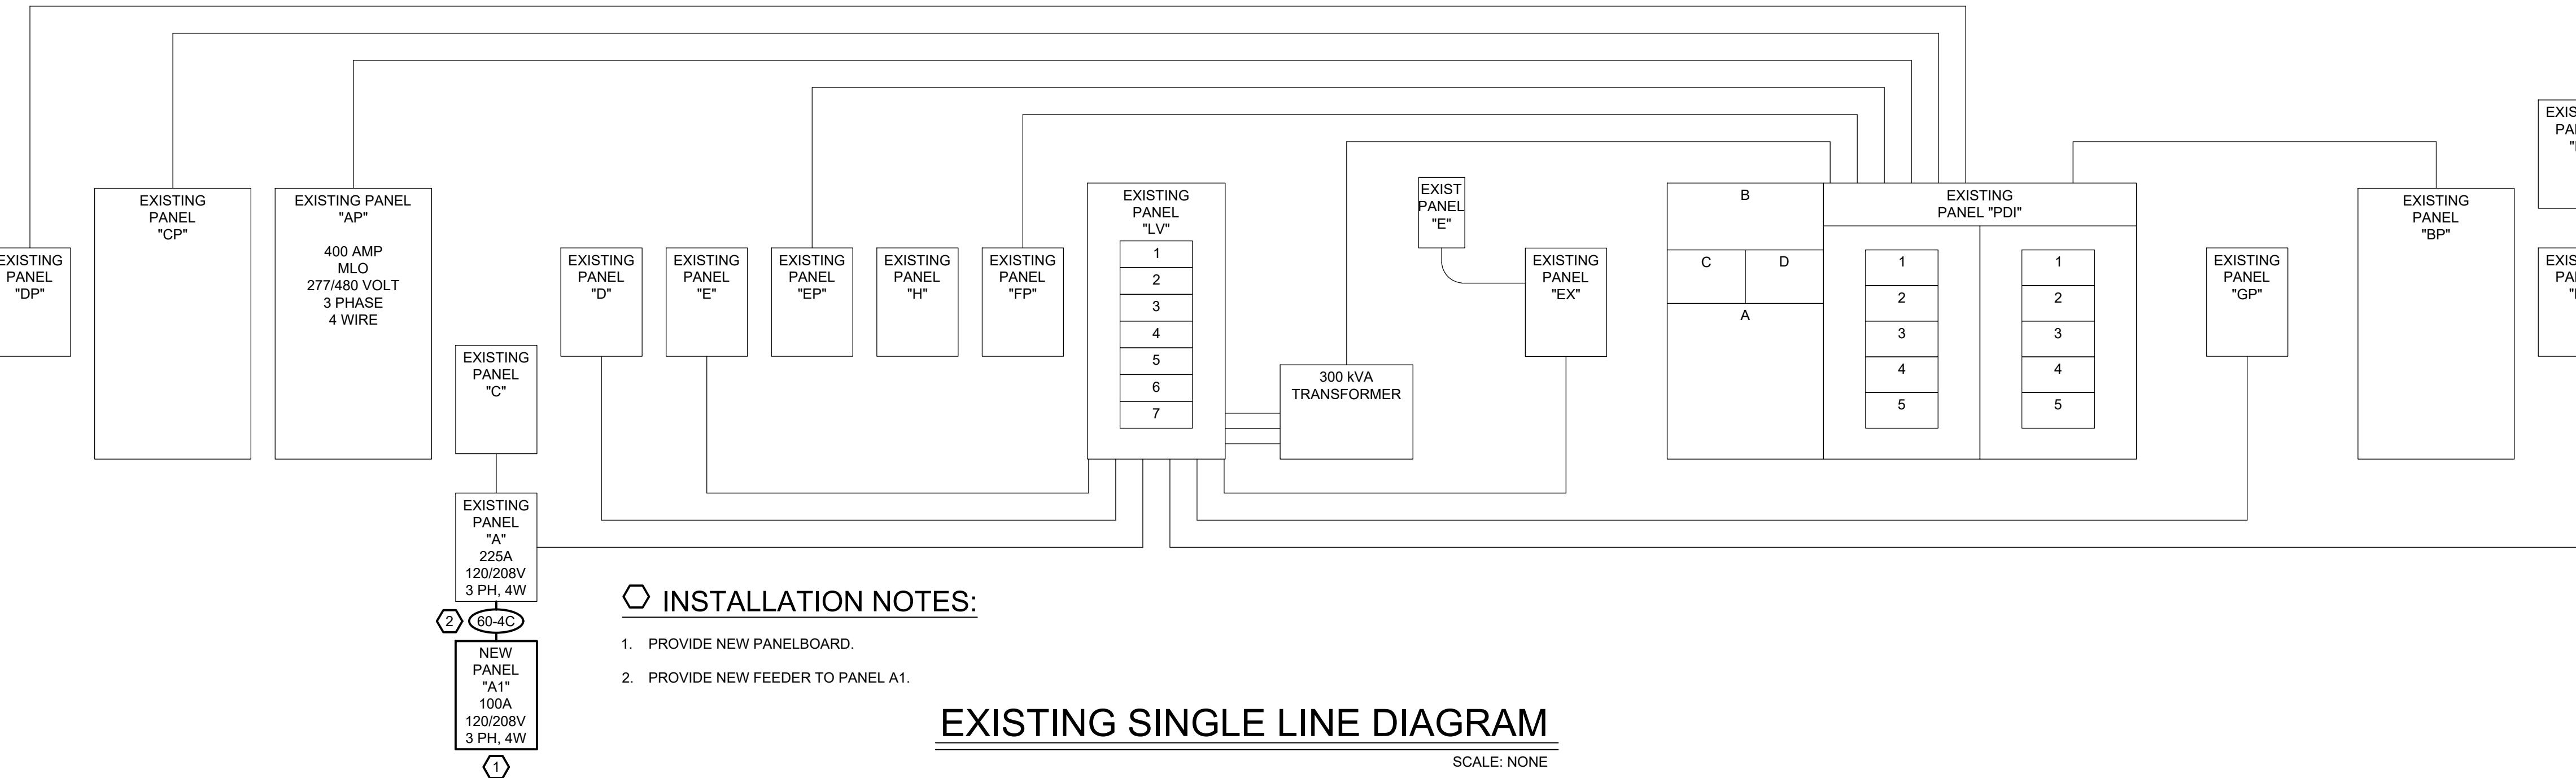

▷ INSTALLATION NOTES:

PROVIDE NEW PANELBOARD.
PROVIDE NEW FEEDER TO PANEL A1.

EXISTING SINGLE LINE DIAGRAM

CALE: NONE

Panel ID AP (EXISTING)					Panel Load	Conn. kW		Demand kW	Demand Amps		
Ampere	400A	Voltage	277/480V		Total	213.24		220.15	264.8		
MLO/MB	MLO	Phase	3		Phase A	75.53		77.65	280.3		
Amp AIC	Verify w/ Utility	Wire	4		Phase B	72.11		74.65	269.5		
					Phase C	65.61		67.85	244.9		
CB #	Brkr	Conn. kW	Factor	Demand kW	Description	CB #	Brkr	Conn. kW	Factor	Demand kW	Description
1	20/1	3.40	1.25	4.25	HALL LIGHTS	2	20/1	1.90	1.25	2.38	HALL LIGHTS
3	20/1	2.28	1.25	2.85	LIGHTS	4	20/1	2.10	1.25	2.63	HALL LIGHTS
5	20/1	1.60	1.25	2.00	RESTROOM LIGHTS	6	20/1	2.16	1.25	2.70	OFFICE LIGHTS
*	7	20/1			SPARE	8	20/1				SPARE
9	20/1	3.20	1.25	4.00	LIGHTS	10	20/1	2.60	1.25	3.25	LIGHTS
11	20/1	2.60	1.25	3.25	LIGHTS	12	20/1	2.60	1.25	3.25	LIGHTS
13	20/1	3.20	1.25	4.00	LIGHTS	14	30/1	6.60	1.00	6.60	HEAT
15	30/1	6.60	1.00	6.60	HALL	16	50/1	8.80	1.00	8.80	HEAT
17	20/1	5.06	1.00	5.06	HEAT	18	20/1	5.06	1.00	5.06	HEAT
19	50/1	10.00	1.00	10.00	35-HEAT	20	50/1	10.00	1.00	10.00	38-HEAT
21	50/1	7.00	1.00	7.00	36-HEAT	22	20/1	1.00	1.00	1.00	EXISTING
23	50/1	8.00	1.00	8.00	37-HEAT	24	-				SPACE
25	20/1	1.90	1.00	1.90	EXISTING	26	-				SPACE
27		0.83	1.00	0.83		28		0.83	1.00	0.83	
29	20/3	0.83	1.00	0.83	27-AIR HANDLER	30	20/3	0.83	1.00	0.83	28-AIR HANDLER
31		0.83	1.00	0.83		32		0.83	1.00	0.83	
33		0.83	1.00	0.83		34	20/3	1.11	1.00	1.11	# OFFICE AIR HANDLER AUV-5
35	30/3	0.83	1.00	0.83	29-AIR HANDLER	36		1.11	1.00	1.11	
37		0.83	1.00	0.83		38		1.11	1.00	1.11	
39		3.00	1.00	3.00		40	20/3	0.83	1.00	0.83	# 32-AIR HANDLER
41	20/3	3.00	1.00	3.00	22-HEAT	42		0.83	1.00	0.83	
43		3.00	1.00	3.00		44		0.83	1.00	0.83	
45	50/3				SPARE-19-33-HEATER GYM ENTR	46	30/3				SPARE-23-34-HEATER MAIN ENTR
47						48					
49						50					
51	50/3	10.40	1.00	10.40	19-HEAT	52	30/3	6.37	1.00	6.37	36-HEAT
53		10.40	1.00	10.40		54		6.37	1.00	6.37	
55		10.40	1.00	10.40		56		6.37	1.00	6.37	
57	30/3	6.00	1.00	6.00	21-HEAT	58	20/3	0.83	1.00	0.83	EXISTING
59		6.00	1.00	6.00		60		0.83	1.00	0.83	
61		6.00	1.00	6.00		62		0.83	1.00	0.83	
63	50/3	0.83	1.00	0.83	EXISTING	64	30/3	5.20	1.00	5.20	40-EXISTING
65		0.83	1.00	0.83		66		5.20	1.00	5.20	
67		0.83	1.00	0.83		68		5.20	1.00	5.20	
69	20/3	0.83	1.00	0.83	EXISTING	70	20/3	0.63	1.00	0.63	EXISTING
71		0.83	1.00	0.83		72		0.63	1.00	0.63	
73		0.83	1.00	0.83		74		0.63	1.00	0.63	

PANEL IS FED FROM A 400 AMP FUSE IN PANEL PD1

PANEL PDI LOAD SUMMARY

DESCRIPTION	CONNECTED LOAD (KVA)	N.E.C. DEMAND FACTOR	CALCULATED LOAD (KVA)												
ADDED LOAD															
LIGHTING	2.16	1.25	2.70												
HVAC	3.33	1.00	3.33												
RECEPTACLES	17.14	50%>10	13.57												
CONTINUOUS		1.25	0.00												
NONCONTINUOUS		1.00	0.00												
REMOVED LOAD															
LIGHTING	-5.06	1.00	-5.06												
HVAC	-5.49	1.00	-5.49												
RECEPTACLES	-10.80	50%>10	-10.40												
CONTINUOUS		1.25	0.00												
NONCONTINUOUS		1.00	0.00												
TOTAL			-1.35												
<table border="1" style="width: 100%; border-collapse: collapse;"> <tr> <td style="padding: 5px;">TOTAL CALCULATED LOAD</td> <td style="padding: 5px;">-1.35</td> <td style="padding: 5px;">KVA</td> </tr> <tr> <td style="padding: 5px;">VOLTAGE</td> <td style="padding: 5px;">208</td> <td style="padding: 5px;">V</td> </tr> <tr> <td style="padding: 5px;">PHASE</td> <td style="padding: 5px;">3</td> <td style="padding: 5px;">PH</td> </tr> <tr> <td style="padding: 5px;">TOTAL CALCULATED LOAD</td> <td style="padding: 5px;">-3.74</td> <td style="padding: 5px;">AMPS</td> </tr> </table>				TOTAL CALCULATED LOAD	-1.35	KVA	VOLTAGE	208	V	PHASE	3	PH	TOTAL CALCULATED LOAD	-3.74	AMPS
TOTAL CALCULATED LOAD	-1.35	KVA													
VOLTAGE	208	V													
PHASE	3	PH													
TOTAL CALCULATED LOAD	-3.74	AMPS													
<p>THE POST CONSTRUCTION CALCULATED LOAD AMPS IS LESS THAN THE PRE CONSTRUCTION CALCULATED. MORE LOAD IS BEING REMOVED THAN ADDED.</p>															

Panel ID		A (EXISTING)				Panel Load	Conn. kW		Demand kW	Demand Amps	
Ampere	225A	Voltage	120/208V				Total	57.42		159.4	
MLO/MB	MLO	Phase	3				Phase A	21.52		179.3	
Amp AIC	Verify w/	Wire	4				Phase B	19.83		165.3	
	Utility						Phase C	16.07		133.9	
CB #	Brkr	Conn. kW	Factor	Demand kW	Description	CB #	Brkr	Conn. kW	Factor	Demand kW	Description
1	30/2	2.52	1.00	2.52	HEATERS LIBRARY WORK ROOM PANEL A1	2	20/2	0.09	1.00	0.09	REC. MAIN CORRIDOR
3	/	2.52	1.00	2.52		4	/	0.09	1.00	0.09	
5	60/3	3.70		3.70		6	20/2	0.27	1.00	0.27	REC. GYM ENTRANCE
7		3.78		3.78		8	/	0.27	1.00	0.27	
9		4.98		4.98		10	20/1	0.90	1.00	0.90	REC. GYM ENTRANCE
11	20/1	0.72	1.00	0.72	REC. GYM ENTRANCE	12	20/1	0.40	1.00	0.40	WATER COOLER MAIN CORRIDOR
13	20/1	1.00	1.00	1.00	REC. GYM SCOREBOARD	14	20/1				SPARE
15	20/1	0.54	1.00	0.54	REC. GYM	16	20/1				SPARE
17	20/1	0.54	1.00	0.54	REC. STAGE	18	20/1	1.08	1.00	1.08	REC. OFFICE 102
19	20/1	0.72	1.00	0.72	REC. STAGE	20	20/1	0.40	1.00	0.40	REC. LIBRARY
21	20/1	0.72	1.00	0.72	REC. LIBRARY WORK ROOM	22	20/1	0.72	1.00	0.72	REC. 105
23	20/1	0.72	1.00	0.72	REC. LIBRARY WORK ROOM	24	20/1	0.40	1.00	0.40	REC. LIBRARY
25	20/1	0.72	1.00	0.72	REC. TEACHERS LOUNGE	26	20/1	1.26	1.00	1.26	REC. OFFICE 106
27	20/1	0.72	1.00	0.72	REC. TEACHERS LOUNGE	28	20/1	0.36	1.00	0.36	REC. MAIN ENTRANCE
29	20/1	0.72	1.00	0.72	REC. OFFICE 101 (RECEPTION)	30	20/1	0.72	1.00	0.72	REC. RECEPTIONIST 101
31	20/1	1.50	1.00	1.50	BOYS DRYER	32	20/1	1.50	1.00	1.50	GIRLS DRYER
33	20/1	0.72	1.00	0.72	ROOM 200 COMPUTERS	34	20/1	1.20	1.00	1.20	POP MACHINE
35	20/1	0.72	1.00	0.72	ROOM 200 COMPUTERS	36	20/1				SPARE
37	20/1	0.40	1.00	0.40	EXISTING (ON)	38	20/1	0.36	1.00	0.36	LIBRARY COMPUTER
39	20/1	1.00	1.00	1.00	EXISTING (ON)	40	20/1	0.36	1.00	0.36	LIBRARY COMPUTER
41	20/1	0.72	1.00	0.72	LOUNGE OUTLETS	42	20/1	0.36	1.00	0.36	LIBRARY COMPUTER

FEEDER SCHEDULE

DESIGNATION	WIRE AND CONDUIT SIZE
60-4C	(4) #4 AWG CU & (1) #10 AWG CU GROUND IN 1.25" CONDUIT

PANEL BOARD LEGEND

PANELBOARD LEGEND	
SYMBOL	DESCRIPTION
G	PROVIDE GROUND FAULT (GFCI) CIRCUIT BREAKER
LO	PROVIDE CIRCUIT BREAKER LOCK
N	PROVIDE NEW CIRCUIT BREAKER MATCHING EXISTING AIC AND BREAKER TYPE
*	CIRCUIT MADE SPARE THROUGH DEMOLITION
#	PROVIDE NEW CIRCUIT FROM EXISTING CIRCUIT BREAKER

BRANCH CIRCUIT CONDUCTOR SCHEDULE

Panel ID	A1 (NEW)				Panel Load	Conn. kW	Demand kW	Demand Amps
Ampere	100	Voltage	120/208V		Total	12.46	12.46	34.6
MLO/MB	MLO	Phase	3		Phase A	3.78	3.78	31.5
Amp AIC	Verify w/ Utility	Wire	4		Phase B	4.98	4.98	41.5
					Phase C	3.70	3.70	30.8

PANEL IS FED FROM A 60 AMP BREAKER IN PANEL A

valley view board of education
6027 farmersville pike
germantown, ohio 45039
electrical panel schedule
single-line diagram

project number
251431
date
1/23/2026
drawn by
EGM
checked by
SLC

sheet



HI-TECH PROJECT #25194