WESTERN WAYNE SCHOOLS ADDITIONS & RENOVATIONS - BID PACKAGE #1



WESTERN WAYNE SCHOOLS

215 E. PARKWAY DRIVE CAMBRIDGE CITY, INDIANA

BIDS & CONSTRUCTION 01.06.2025 GMB PROJECT # 5-6394

GENERAL INFORMATION GENERAL NOTES DIMENSIONS AND LEGENDS **BUILDING SEPARATION PLAN** UNIT 'A' CODE COMPLIANCE PLAN UNIT 'B' CODE COMPLIANCE PLAN - (REMOVED BULL 001) UNIT 'C' CODE COMPLIANCE PLAN - (REMOVED BULL. 001) UNIT 'D' CODE COMPLIANCE PLAN - (REMOVED BULL. 001) UNIT 'E' CODE COMPLIANCE PLAN - (REMOVED BULL. 001) UNIT 'A' CODE COMPLIANCE PLAN - BUILDIING SEPERATION (ADDED BUL. 001 UNIT 'A' SECOND FLOOR CODE COMPLIANCE PLAN FIRST FLOOR PHASING PLAN CIVIL PROJECT INFORMATION SHEET SITE DEMOLITION SHEET C2.01 SITE PLAN SITE GRADING, DRAINAGE, & UTILITY PLAN C3.02 SITE UTILITY DETAILS STORMWATER POLLUTION PREVENTION PLAN STORMWATER POLLUTION PREVENTION DETAILS SITE DETAILS SITE DETAILS STRUCTURAL STRUCTURAL GENERAL INFORMATION STRUCTURAL SCHEDULES SNOW DRIFT PLAN MASONRY REINFORCING PLAN UNIT 'A' FLOOR AND LOW ROOF DEMOLITION PLAN UNIT 'A' FOUNDATION PLAN S3.1A UNIT 'A' FLOOR AND LOW ROOF FRAMING PLAN FOUNDATION DETAILS FRAMING DETAILS FRAMING DETAILS

ARCHITECTURAL UNIT 'A' FIRST FLOOR DEMOLITION PLAN UNIT 'A' FIRST FLOOR FLOOR CUTTING PLAN UNIT 'A' FIRST FLOOR PLAN UNIT 'A' SECOND FLOOR PLANS UNIT 'A' ROOF PLAN **ENLARGED PLANS ENLARGED PLANS** UNIT 'A' FIRST FLOOR REFLECTED CEILING PLAN **EXTERIOR ELEVATIONS** DOOR & FRAME SCHEDULES **BUILDING SECTIONS BUILDING SECTIONS** WALL SECTIONS WALL SECTIONS WALL SECTIONS WALL SECTIONS DOOR DETAILS A7.02 DOOR DETAILS WALL AND WINDOW DETAILS A7.04 **DETAILS DETAILS** INTERIOR ELEVATIONS INTERIOR ELEVATIONS INTERIOR ELEVATIONS A9.01 ROOM SIGNAGE UNIT 'A' FIRST FLOOR FINISH PLAN UNIT 'A' SECOND FLOOR FINISH PLAN **PLUMBING** P0.01 PLUMBING GENERAL INFORMATION UNIT 'A' PLUMBING DEMOLITION PLAN UNIT 'A' PLUMBING PLAN ENLARGED PLUMBING PLANS

MECHANICAL MECHANICAL GENERAL INFORMATION UNIT 'A' FIRST FLOOR MECHANICAL DEMOLITION PLAN UNIT 'A' FIRST FLOOR HYDRONIC PLAN MECHANICAL SECTIONS MECHANICAL DETAILS MECHANICAL & CONTROL DIAGRAMS MECHANICAL SCHEDULES

ELECTRICAL E0.01 ELECTRICAL SYMBOL LEGENDS & GENERAL NOTES E1.1A UNIT 'A' FIRST FLOOR ELECTRICAL DEMOLITION PLAN UNIT 'A' FIRST FLOOR POWER & COMMUNICATIONS PLAN UNIT 'A' FIRST FLOOR LIGHTING PLAN POWER DISTRIBUTION ONE-LINE DIAGRAMS POWER DISTRIBUTION EQUIPMENT SCHEDULES LIGHTING FIXTURE SCHEDULE ELECTRICAL DETAILS SITE ELECTRICAL PLAN



CIVIL ENGINEER

JPS CONSULTING ENGINEERS 9635 COUNSELORS ROW, SUITE 116 INDIANAPOLIS, IN 46240 P. 317.617.4240 WWW.JPSCONSULTINGENGINEERS.COM OWNER'S REPRESENTATIVE

MAZE DESIGN, INC. 2601 NATIONAL ROAD WEST RICHMOND, IN 47374 765.962.1300 DI@MAZEDESIGNINC.COM

OWNER

WESTERN WAYNE SCHOOLS 215 E. PARKWAY DRIVE ENTRANCE #33 CAMBRIDGE CITY, IN 47327 (765) 478-5375 WWW.WWAYNE.K12.IN.US

ARCHITECT + ENGINEER

GMB


38 WEST MAIN STREET CARMEL, IN 46032 P. 317.641.0674 WWW.GMB.COM



DRAWN NCB REVIEWED AGS

PROJECT NO. NO PART OF THIS DRAWING MAY BE USED OR REPRODUCED IN ANY FORM OR BY ANY MEANS, OR STORED IN A DATA BASE OR RETRIEVAL SYSTEM, WITHOUT PRIOR WRITTEN PERMISSION OF GMB COPYRIGHT © 2025 ALL RIGHTS RESERVED

GENERAL NOTES DIMENSIONS AND LEGENDS

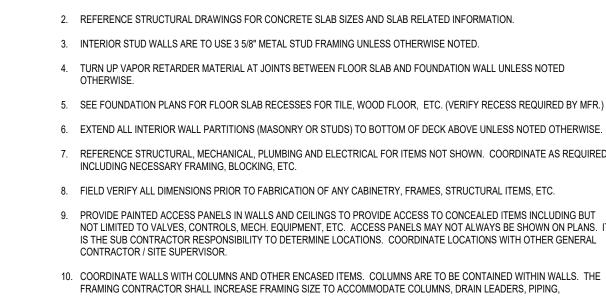

GENERAL FLOOR PLAN NOTES:

11_ WS-001			
(FRAI	MING WIDTH	SCHEDULE
i	CALLOUT	FRAMING SIZE	AISI IDENTIFICATION
!	.5	7/8"	
i	1	1 1/2"	G ED
1	2	2 1/2"	SEE COLD FORMED METAL FRAMING SCHEDULE
i	3	3 5/8"	5 5 5 E
1	4	4"	ETAL SC
; —	6	6"	S ≅
•*	8	8"	
L	NOTE: MASO	NRY SIZES TO BE L	ABELED NOMINALLY

8 = 8" = 7 5/8" CMU

INTERIOR WALL TAG

M = MASONRY

F = FURRING

WALL MAKE-UP

SCHEDULE)

WALL HEIGHT

B.O. DECK

LAY-IN CEILING

WALL CONSTRUCTION TYPE

(SEE WALL DETAILS)

(SEE FRAMING WIDTH

FRAMING SIZE OR MASONRY SIZ

(SEE WALL HEIGHT DIAGRAM)

WALL TAG & HEIGHT DIAGRAM

VERTICAL BRACED DIAGONAL BRACED

1 1/4" 362T125-30

1 1/4" 600T125-43

16 1 1/2" 600T150-54

3 5/8" 20 2 1/2" 362T250-33

7/8" | 20 | N/A | 087F125-33

1 1/2" 20 N/A 150F125-33

INTERIOR WALLS & BULKHEADS

INTERIOR WALLS & BULKHEADS

DEFLECTION TRACK

EXTERIOR WALLS

WHERE NOTED

WHERE NOTED

*DESIGN SHOWN FOR

SINGLE ROLL DISPENSER

WALL HEIGHT DIAGRAM

UNBRACED

WS-00

1. DIMENSIONS GIVEN ARE TO THE FACE OF MASONRY UNITS OR TO THE FINISHED FACE OF METAL STUD PARTITION WALLS.

- 4. TURN UP VAPOR RETARDER MATERIAL AT JOINTS BETWEEN FLOOR SLAB AND FOUNDATION WALL UNLESS NOTED
- 6. EXTEND ALL INTERIOR WALL PARTITIONS (MASONRY OR STUDS) TO BOTTOM OF DECK ABOVE UNLESS NOTED OTHERWISE.
- 7. REFERENCE STRUCTURAL, MECHANICAL, PLUMBING AND ELECTRICAL FOR ITEMS NOT SHOWN. COORDINATE AS REQUIRED
- 8. FIELD VERIFY ALL DIMENSIONS PRIOR TO FABRICATION OF ANY CABINETRY, FRAMES, STRUCTURAL ITEMS, ETC.
- 9. PROVIDE PAINTED ACCESS PANELS IN WALLS AND CEILINGS TO PROVIDE ACCESS TO CONCEALED ITEMS INCLUDING BUT NOT LIMITED TO VALVES, CONTROLS, MECH. EQUIPMENT, ETC. ACCESS PANELS MAY NOT ALWAYS BE SHOWN ON PLANS. IT IS THE SUB CONTRACTOR RESPONSIBILITY TO DETERMINE LOCATIONS. COORDINATE LOCATIONS WITH OTHER GENERAL
- FRAMING CONTRACTOR SHALL INCREASE FRAMING SIZE TO ACCOMMODATE COLUMNS, DRAIN LEADERS, PIPING, ELECTRICAL PANELS, ETC. WHERE WALLS REQUIRE EXTRA WIDTH THE ENTIRE WALL SHALL BE WIDENED UNLESS APPROVED BY ARCHITECT.
- 11. ALL GUARDRAILS AND HANDRAILS SHALL BE FABRICATED AND INSTALLED IN ACCORDANCE WITH ALL REQUIREMENTS OF THE 2015 M.B.C., ANSI ICC A117.1-2009 & AMERICANS WITH DISABILITIES ACT GUIDELINES. THE MOST STRINGENT SHALL
- 12. PROVIDE MINIMUM CLEARANCES AT ALL DOORS PER DETAILS. SEE G0.01 FOR REQUIREMENTS.
- 13. FOR ALL CABINETRY, SEE INTERIOR ELEVATIONS FOR LAYOUTS. FIELD VERIFY CLEAR WIDTHS PRIOR TO FABRICATION. 14. ALL EXTERIOR BLOCK CORNERS ARE TO BE BULLNOSE BLOCK EXCEPT CONCRETE BLOCK COLUMNS, PIERS AND WALLS TO
- RECEIVE TILE UNLESS NOTED OTHERWISE 15. CONTRACTOR TO MAINTAIN / REPAIR RATING OF EXISTING PARTITIONS AS AFFECTED BY DEMOLITION / NEW
- CONSTRUCTION. TYPICAL THROUGHOUT. 16. SEAL ALL PENETRATIONS IN FIRE RATED FLOORS AND WALLS WITH APPROVED FIRESTOPPING.
- 17. WHERE SPECIALTY BLOCK IS REQUIRED AT THE SAME HEIGHT ON BOTH SIDES OF A WALL USE (2) SPECIALTY BLOCKS BACK TO BACK TO MAINTAIN THE FINISHED WALL APPEARANCE BOTH SIDES OF THE WALL. COORDINATE WITH STRUCTURAL FOR LINTELS CONDITIONS PER SPECIFICATIONS.
- 18. WALLS TO BE PATCHED WITH LIKE MATERIALS WHERE EXISTING WALLS HAVE BEEN COMPROMISED FROM DEMOLITION. THIS SHALL INCLUDE, BUT NOT BE LIMITED TO REMOVAL AND REINSTALLATION OF CASEWORK AND WALL MOUNTED EQUIPMENT IN ORDER TO ACHIEVE SAID PATCH. IN AREAS WHERE BLOCK OR BRICK HAVE BEEN USED, NEW MASONRY TO BE TOOTHED IN AND MATCH EXISTING. AREAS AND FINISHES IN QUESTION SHALL BE COORDINATED WITH
- 19. SEE STRUCTURAL FRAMING PLANS FOR ADDITIONAL WALL REINFORCING REQUIREMENTS. MINIMUM REINFORCING (FOR ALL WALLS NOT OTHERWISE NOTED ON STRUCTURAL PLANS):
- A. ALL BEARING WALLS SHALL RECEIVE A MINIMUM REINFORCING OF R1-5-48 B. ALL EXTERIOR WALLS SHALL RECEIVE A MINIMUM REINFORCING OF R1-5-48. C. ALL INTERIOR NON-BEARING WALLS OVER 16'-0" HIGH SHALL RECEIVE A MINIMUM REINFORCING OF R1-5-48.

GENERAL PROJECT NOTES.

- 1. FINISH FLOOR ELEVATION = 942.19' = 100'-0"
- 3. DETAILS SHOWN BUT NOT CALLED OUT STILL APPLY, UNLESS OTHERWISE NOTED.
- 4. GENERAL TRADES CONTRACTOR SHALL COORDINATE ALL TRADES INCLUDING OWNER FURNISHED EQUIPMENT, INCLUDING DIMENSIONS OF SUCH AS THEY RELATE TO HIS/HER OWN WORK.

2. DRAWINGS ARE NOT TO BE SCALED WHEN A DIMENSION IS IN QUESTION, VERIFY W/ ARCHITECT.

- 5. ALL EXPOSED SURFACES SHALL BE FINISHED. CONTACT ARCHITECT FOR DIRECTION IF FINISH IS NOT LISTED.
- 6. NO UTILITIES INCLUDING BUT NOT LIMITED TO, PIPING AND CONDUIT SHALL BE EXPOSED UNLESS APPROVED BY
- 7. GYPSUM BOARD WALLS AND BULKHEADS SHALL HAVE CONTROL JOINTS AT A 20'-0" O.C. MAXIMUM AND AS SHOWN ON 8. ANY CONTRACTOR IS TO STOP WORK IMMEDIATELY IN AREA IF ABATEMENT MATERIAL(S) ARE ENCOUNTERED. NOTIFY
- GENERAL CONTRACTOR OF SUSPECTED AREA SO PROPER ABATEMENT CAN BE DONE. (UNDER A SEPARATE ABATEMENT CONTRACT AS NEGOTIATED BY OWNER.)
- 9. AT ALL AREAS OF WORK WHERE EXISTING MASONRY BLOCK AND BRICK WALLS ARE BEING MODIFIED OR CONNECTED TO NEW MASONRY AND/OR BRICK MUST BE TOOTHED, UNLESS NOTED OTHERWISE ON DRAWINGS.
- 10. CONTRACTOR SHALL VERIFY LOCATIONS OF UTILITIES PRIOR TO EXCAVATION, TRENCHING, ETC. AND SHALL REPAIR OR REPLACE ANY DAMAGED UTILITIES AS A RESULT OF CONSTRUCTION.
- 11. ALL TRADES ARE TO COORDINATE ANY DEMOLITION, CAPPING OR ABANDONMENT OF EXISTING MECHANICAL, ELECTRICAL, PLUMBING OR ARCHITECTURAL ITEMS.
- 12. ANY DEMOLITION OR CONSTRUCTION WHICH DAMAGES ADJACENT SURFACES IS TO BE REPAIRED TO MATCH THE EXISTING SURFACE DAMAGED (MATERIALS & FINISHES) AND ALL REPAIR WORK IS TO BE COORDINATED WITH NEW
- 13. CONTRACTOR IS TO PROVIDE TEMPORARY SHORING AND BRACING FOR EXISTING ROOF/FLOOR STRUCTURE AS
- REQUIRED UNTIL PERMANENT WALLS & LINTELS ARE INSTALLED. 14. SITE SECURITY AND SAFETY ARE THE CONTRACTORS RESPONSIBILITY. SITE SHALL BE SECURED (FENCED IF REQUIRED) BY CONTRACTOR.
- 15. ALL ITEMS TO BE SAVED AND/OR RELOCATED ARE TO BE STORED IN A PROPER MANNER SO NO DAMAGE WILL OCCUR TO THESE ITEMS DURING THEIR STORAGE PERIOD.
- 16. ALL CONSTRUCTION AND MATERIALS ARE TO BE INSTALLED BY THE MANUFACTURERS SPECIFICATIONS AND/OR RECOMMENDATIONS UNLESS DIRECTED OTHERWISE BY ARCHITECT.
- 17. SEE SPECIFICATIONS FOR STEEL LINTEL SIZES FOR WALL OPENINGS NOT DETAILED (e.g. HVAC DUCTS, ETC.). 18. REFER TO GENERAL INFORMATION SHEET G0.01 FOR TYPICAL BARRIER FREE AND ACCESSIBLE DIMENSIONS.
- 19. SEE FLOOR PLANS FOR WALL REINFORCING REQUIRED. (SEE WALL REINFORCING SCHEDULE) 20. FURNISH & INSTALL 2x12 HORIZONTAL WOOD BLOCKING BETWEEN STUDS WHERE REQUIRED FOR MOUNTING OF UPPER CABINETS, GRAB BARS OR OTHER EQUIPMENT AS REQUIRED FOR PROPER SUPPORT.
- 21. COORDINATE ALL CONSTRUCTION PRACTICE TOLERANCES WITH OTHER TRADES WHOSE WORK MAY BE AFFECTED, DIRECTLY OR INDIRECTLY, WITH YOUR SPECIFIC TRADE. IN ALL CASES, THE MOST STRINGENT TOLERANCE SHALL APPLY AND SHALL BE COORDINATED THRU THE GENERAL CONTRACTOR, JOB SUPERINTENDENT AND/OR CONSTRUCTION MANAGER AND FIELD OBSERVATION PERSON AS APPLICABLE.
- 22. REFER TO FLOOR PLANS, SCHEDULES AND EXTERIOR ELEVATIONS FOR WINDOW FRAME TYPES. 23. REFER TO FLOOR PLANS, SCHEDULES AND INTERIOR ELEVATIONS FOR BORROWED LITE FRAME TYPES.

NORTH ARROW, FLOOR PLAN CALLOUT

GENERAL ANNOTATION LEGEND

-PLAN NORTH

TRUE NORTH WHEN APPLICABLE

24. AT MASONRY CAVITY WALL LOCATION, PROVIDE APPROPRIATE SEPARATION IN REGARDS TO INTERIOR AIR EXFILTRATION AND EXTERIOR AIR AND WATER INFILTRATION THRU WALL. PROVIDE NECESSARY AIR AND WATER BARRIERS REQUIRED, INCLUDING DAMS, TO PREVENT WALL LEAKAGE.

CODE NOTES:

- 1. FIRE DEPARTMENT ACCESS AND WATER SUPPLY SHALL BE IN PLACE PRIOR TO COMMENCEMENT OF VERTICAL CONSTRUCTION. 2. FIRE STOP ALL INTERCONNECTIONS BETWEEN VERTICAL AND HORIZONTAL SPACES AND CONCEALED WALL SPACES
- AT THE CEILING. FLOOR. AND ROOF LEVELS. 3. INSTALL SOLID BLOCK BEHIND ALL RECESSED WALL UNITS AS REQUIRED TO MAINTAIN FIRE RATINGS.
- 4. ALL FIRE WALLS, FIRE BARRIERS, FIRE PARTITIONS, SMOKE BARRIERS, AND SMOKE PARTITIONS SHALL BE IDENTIFIED WITH STENCILING AT INTERVALS NOT TO EXCEED 30'. REFER TO CODE PLAN FOR WALLS REQUIRED TO
- 5. ALL PENETRATIONS AT SMOKE AND FIRE RATED WALLS, FLOORS, CEILINGS, ETC. SHALL BE PROTECTED, SEALED OR DAMPERED USING ONLY U.L. AND / OR I.C.B.O. APPROVED METHODS, MATERIALS AND INSTALLATION.
- 6. SEE REFLECTED CEILING PLANS AND LIGHTING PLANS FOR EXIT SIGNAGE LOCATIONS.
- 7. ALL EXITS TO BE OPENABLE FROM THE INSIDE WITHOUT THE USE OF KEY OR SPECIAL KNOWLEDGE. 8. PANIC HARDWARE TO BE PROVIDED AT EACH EXIT DOOR FROM ROOMS WITH AN OCCUPANT LOAD 50 OR MORE
- INCLUDING MAIN CORRIDOR EXIT DOORS. 9. ALL ELEVATORS SHALL COMPLY WITH A.D.A., A.D.A.G.G. AND A.N.S.I. REQUIREMENTS.
- 10. SPECIAL STRUCTURAL INSPECTIONS ARE REQUIRED. REVIEW GENERAL STRUCTURAL NOTES AND SPECIFICATIONS FOR REQUIREMENTS. 11. FIRE SPRINKLERS AND FIRE ALARM SYSTEM SHALL BE PROVIDED PER NFPA NO. 13, 70 & 72. SUBMIT ALL REQUIRED
- DRAWING AND INFORMATION TO THE AUTHORITY HAVING JURISDICTION FOR APPROVAL PRIOR TO COMMENCEMENT OF ANY RELATED WORK. OBTAIN APPROVAL OF COMPLETED SYSTEMS PRIOR TO FINAL ACCEPTANCE.

ACCESSIBILITY NOTES:

- 1. PUBLIC ENTRANCES: AT LEAST 60% SHALL BE ACCESSIBLE.
- 2. ACCESSIBLE ENTRANCES TO THE BUILDING SHALL BE IDENTIFIED BY THE INTERNATIONAL SIGN OF ACCESSIBILITY. 3. AN ACCESSIBLE ROUTE OF NOT LESS THAN 3 FT. WIDE MUST BE PROVIDED TO ALL PORTIONS OF THE BUILDING AND BETWEEN THE BUILDING AND THE PUBLIC WAY. ACCESSIBLE ROUTES SHALL HAVE A MAXIMUM SLOPE OF 1:20 AND A
- 4. ACCESSIBLE ROUTE SHALL BE WITHOUT STEPS OR CHANGES IN LEVEL GREATER THAN 1/2" WITHOUT AN APPROVED
- 5. ACCESSIBLE RAMPS THAT ARE REQUIRED BY ANSI A 117.1 SHALL NOT HAVE A SLOPE THAT EXCEEDS 1FT. IN 12 FEET. RAMPS AND GROUND SURFACES SHALL BE OF A SLIP RESISTANT SURFACE.
- 6. THRESHOLDS MUST BE 1/2" OR LESS IN HEIGHT. 7. ALL ACCESSIBLE PARKING SPACES MUST HAVE A SIGN THAT INCLUDES THE INTERNATIONAL SIGN OF ACCESSIBILITY.
- PARKING SPACE WILL BE OUTLINED IN A CONTRASTING COLOR WITH THE INTERNATIONAL SIGN OF ACCESSIBILITY PAINTED IN THE CENTER.
- 8. ALL ALARMS TO MEET ACCESSIBILITY REQUIREMENTS.

-CONCEALED SPACE

FIRE BARRIER PROTECT HIGH

ALL OPENINGS

TO FINISH CLEARANCE

B.F. TRANSFER SHOWER PLAN

TRADES TO

3' - 0"

B.F. TRANSFER SHOWER EL

STRUCTURAL NOTES:

- 1. CONSTRUCTION AND/OR CONTROL JOINTS IN CONCRETE SHALL BE ON A 12'-0" SQUARE GRID (MAX.) UNLESS OTHERWISE
- 2. PROVIDE CONTINUOUS U-BLOCK BOND BEAMS AT THE LOCATIONS INDICATED ON WALL SECTIONS OR DETAILS. FILL U-BLOCKS WITH CONCRETE AND REINFORCE WITH (2) #5 BARS CONTINUOUS UNLESS NOTED OTHERWISE ON DRAWINGS.



T.O.W. = TOP OF WALL FIN. = FINISHED TYP. = TYPICAL FLR. = FLOOR U.N.O. = UNLESS NOTED OTHERWISE F.R.T. = FIRE RETARDANT TREATED V.I.F. = VERIFY IN FIELD GA. = GAUGE


HORIZ. = HORIZONTAL

H.S.S. = HOLLOW STRUCTURAL SECTION

VERT. = VERTICAL GALV. = GALVANIZED VEST. = VESTIBULE GYP. = GYPSUM BOARD W/ = WITH H.D. = HAND DRYER

W.W.F. = WELDED WIRE FABRIC

- NOTED. ALL CONSTRUCTION JOINTS SHALL BE DOWELED W/ 1/2" SMOOTH DOWELS AT 24" O.C. SEE DETAILS.

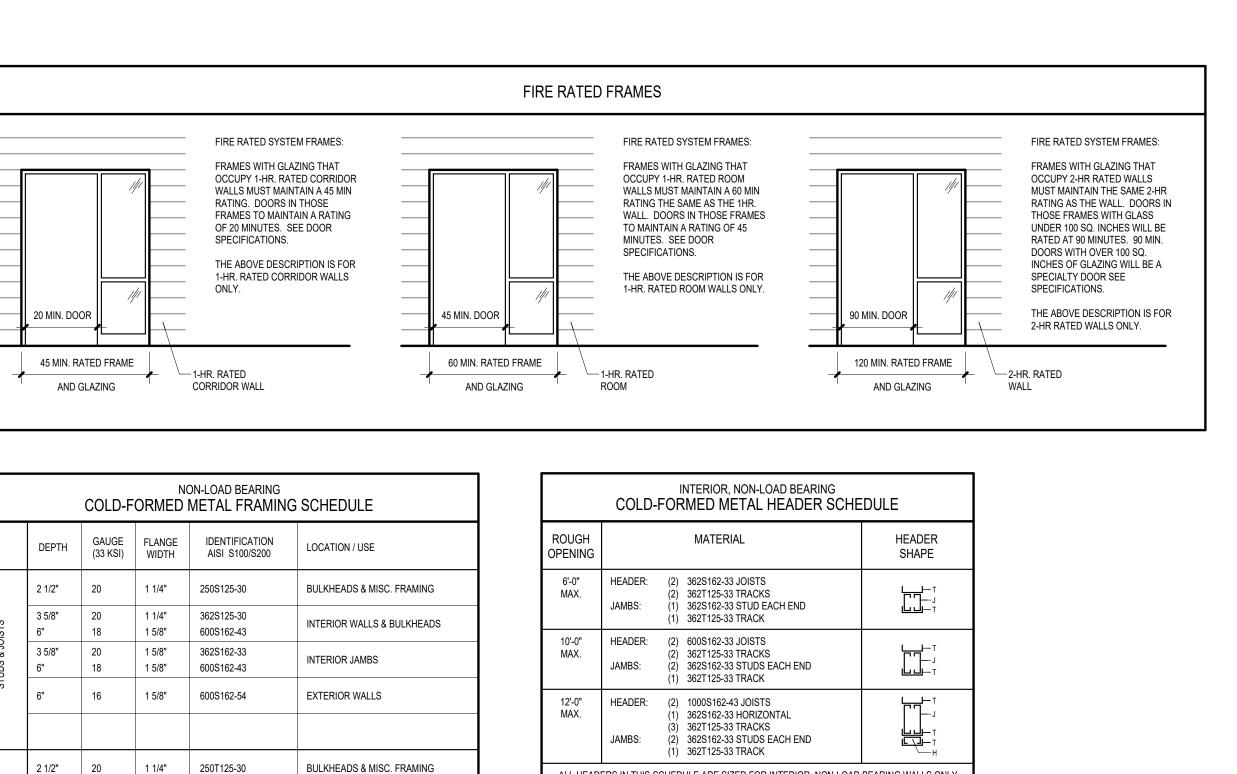


1'-6" 1'-6" 2'-6" 2'-6" MAX. MIN.

IF (6) OR MORE WATER CLOSET STALLS ARE PROVIDED.


*DESIGN SHOWN FOR


SINGLE ROLL DISPENSER

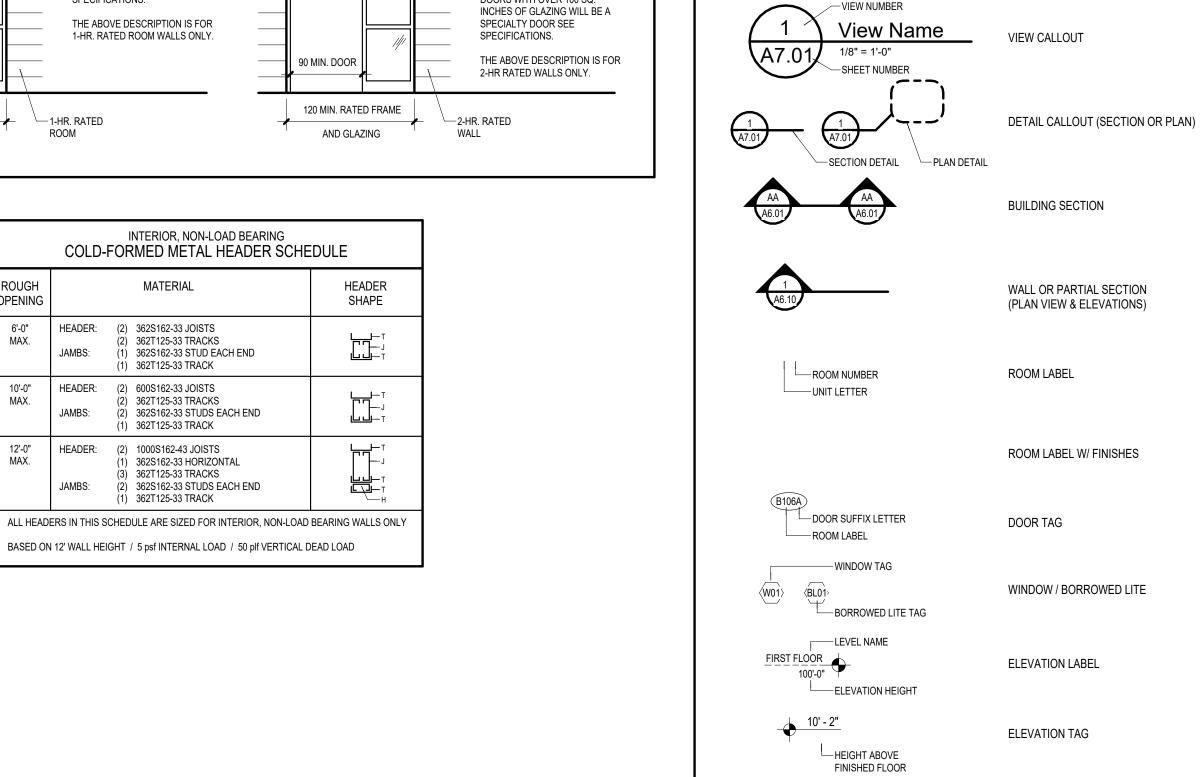

1' - 4" 1' - 4"

B.F. URINAL

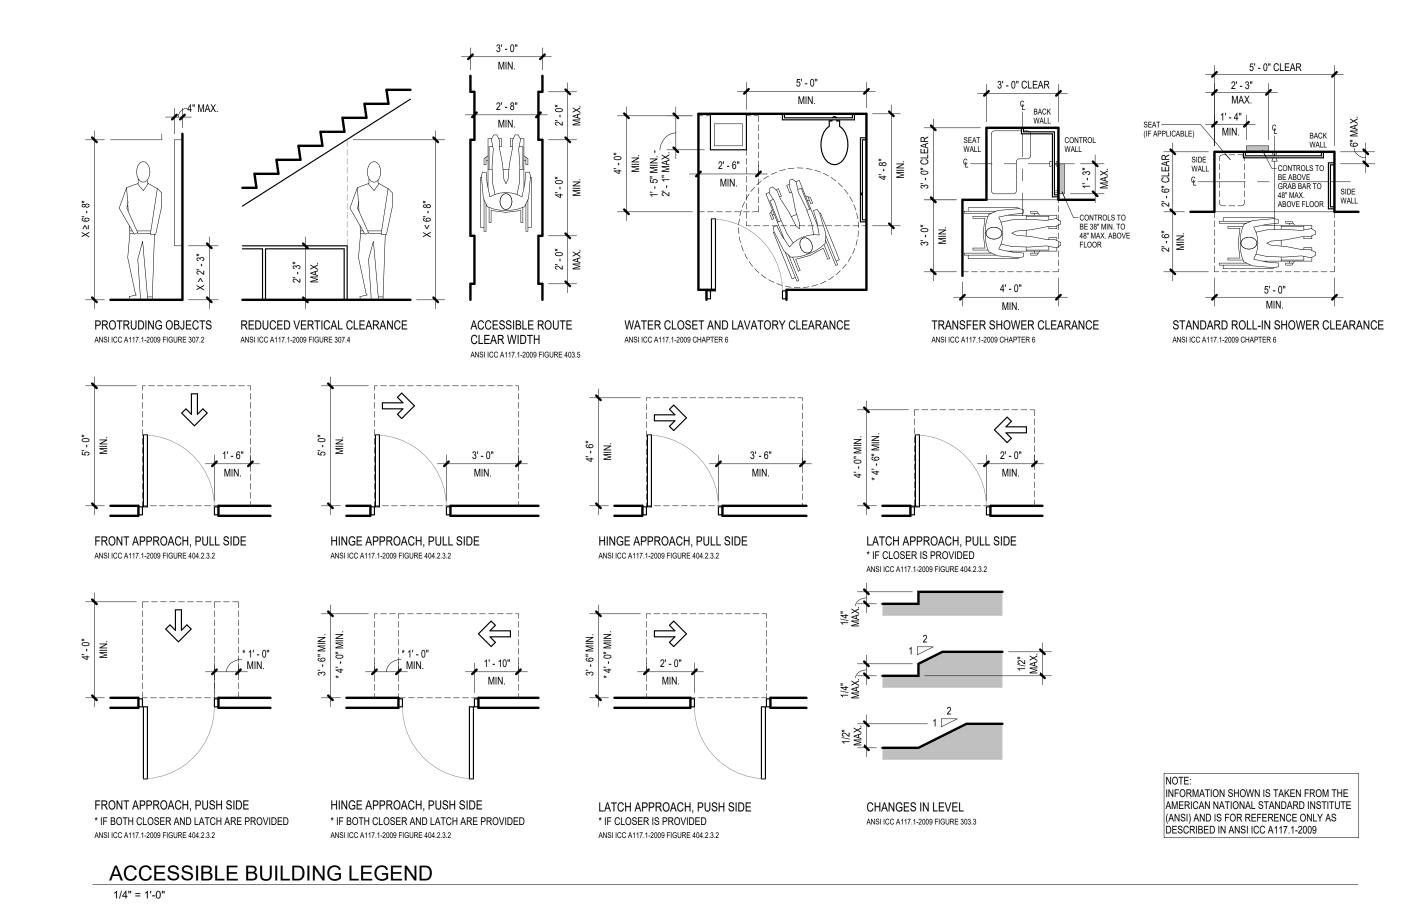

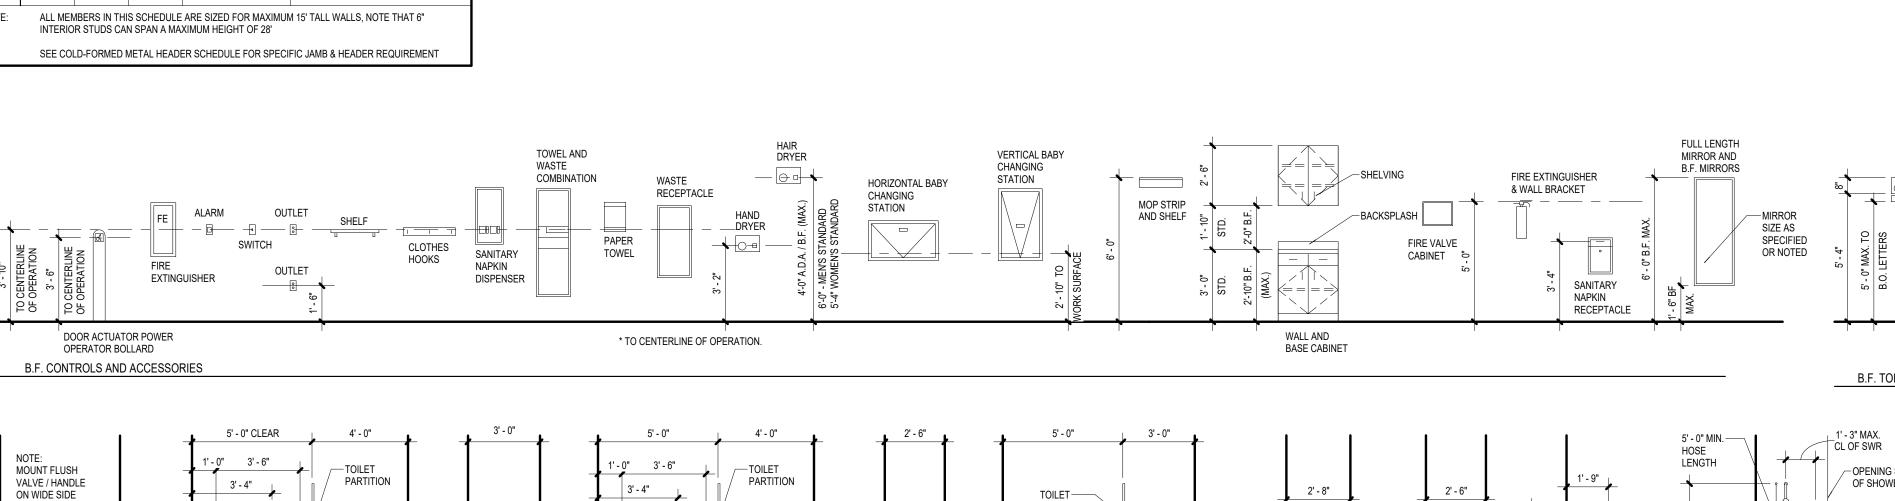


PARTITION

2' - 6" 2' - 6" 3' - 0"

MAX. MIN.

STANDARD WATER CLOSET STALLS

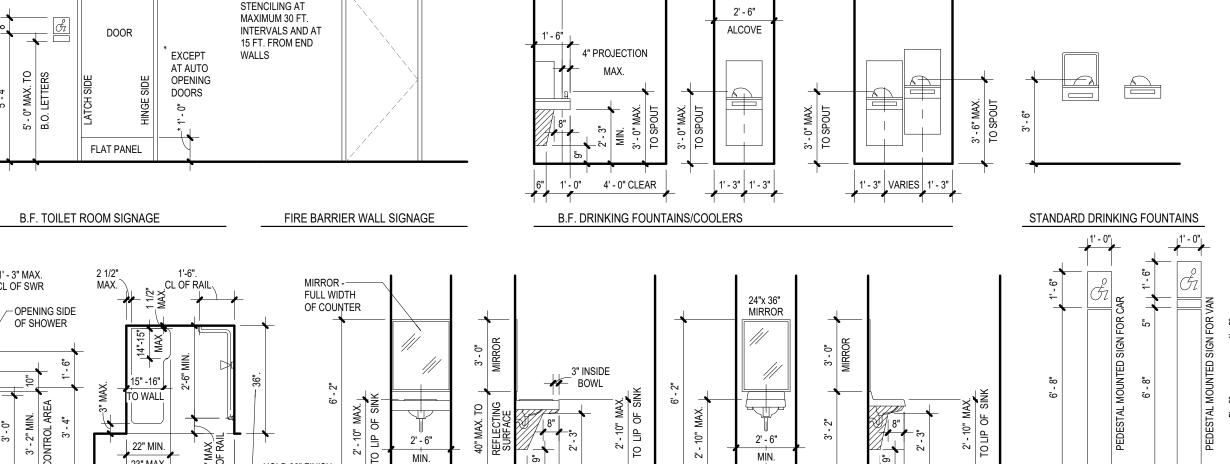

6" 1' - 4" 4' - 0" CLEAR

B.F. & STAND. SINK W/ COUNTER

6" 1'-0" 4'-0" CLEAR

B.F. SIGNAGE

B.F. & STANDARD LAVATORY

3' - 6" 1' - 6" CLEAR

G0.01

1. CODE: 2012 INDIANA BUILDING CODE 2. CONSTRUCTION TYPE: II (000)

UN-PROTECTED WITH NO AUTOMATIC FIRE SPRINKLER SYSTEM HAZARD OF CONTENTS: ORDINARY HAZARD

3. OCCUPANCY: EDUCATIONAL OCCUPANCY (SPACES SUBJECT TO "ASSEMBLY" OCCUPANCY NOTED ON PLAN)

4. AREA & HEIGHT: ALLOWABLE AREA: 14,500 SQ. FT. (REFER TO CALCULATIONS ON SHEET) ALLOWABLE HEIGHT: 1 STORY SMOKE COMPARTMENTS: MINIMUM OF 2 COMPARTMENTS, MAXIMUM OF 30,000 SQ. FT. EACH

5. SEPARATION & PROTECTION:

CORRIDORS SHALL BE 1 HR RATED. FIRE AREAS: SEPARATED W/ 2-HR FIRE SEPARATION & 90-MIN. OPENING PROTECTIVES. BOILER & FURNACE ROOMS, STORAGE AREAS, AND CUSTODIAL CLOSETS: 1-HR RATED SEPARATION & OPENING PROTECTIVES

LIFE SAFETY NOTES

6. OCCUPANT LOAD: (BASED ON FOLLOWING - SEE PLAN) ASSEMBLY (CONFERENCE, DINING, GYMNASIUM): 1/15 SF NET

BUSINESS: 1/100 SF GROSS

CLASSROOMS: 1/20 SF NET KITCHENS: 1/100 SF GROSS

LIBRARIES (READING AREAS): 1/50 SF NET

LIBRARIES (STACK AREAS): 1/100 SF GROSS

LOCKERS: 1/7 SF NET, OR 1/15 SF GROSS INCLUDING SHOWERS, TOILETS & DRYING

MECHANICAL EQUIPMENT: 1/300 SF GROSS SHOPS, LABS, VOC. ROOMS: 1/50 SF NET

STAGES: 1/15 SF NET

STORAGE: 1/300 SF GROSS

EGRESS REQUIREMENTS: A. 6'-0" MINIMUM CORRIDOR WIDTH (CORRIDOR CAPACITY = OCCUPANT LOAD/REQUIRED NUMBER OF EXITS) EGRESS WIDTHS - 0.2" PER PERSON (LEVEL OR RAMPED)

200' MAXIMUM TRAVEL DISTANCE 20' DEAD-END MAXIMUM TRAVEL IN CORRIDOR. 75' MAXIMUM COMMON PATH OF TRAVEL

(1) 2 REMOTE EXITS REQUIRED FOR EDUCATIONAL SPACES >50 PEOPLE OR >1,000 SQ. FT. IN AREA (2) MINIMUM NUMBER PER OCCUPANTS: 2 IF < 501, 3 IF < 1001, 4 IF > 1000 (3) WINDOWS FOR RESCUE REQUIRED IN BUILDINGS NOT PROTECTED BY AUTOMATIC SPRINKLER SYSTEM (4) PANIC HARDWARE AT AREAS >100 OCCUPANT LOAD IF DOOR PROVIDED WITH LATCH OR LOCK. (5) DISCHARGE: ALL EXITS SHALL TERMINATE AT A PUBLIC WAY OR AN EXTERIOR EXIT DISCHARGE

(1) SUBSTITUTED FOR NO MORE THAN ONE-HALF OF REQUIRED EXITS (2) FIRE BARRIERS SEPARATING BUILDING AREAS WITH HORIZ. EXITS BETWEEN SHALL BE 2-HOUR RATED (3) WHERE SERVING BOTH SIDES OF FIRE BARRIER ADJACENT OPENINGS REQUIRED WITH DOORS SWINGING IN OPPOSITE DIRECTIONS

H. DOORS: (1) MINIMUM CLEAR WIDTH SHALL BE 32" (2) SIDE HINGED

(3) SWING IN DIRECTION OF TRAVEL WHERE OCCUPANT LOAD IS > 50 (4) SELF-CLOSING OR AUTOMATIC-CLOSING IN FIRE BARRIERS AND HORIZONTAL EXITS

INTERIOR FINISH: A. EXITS - CLASS A.

B. ALL OTHER - CLASS A OR B. C. INTERIOR WALL & CEILING FINISH IF LESS THAN 10% OF AGGREGATE WALL & CEILING AREAS OF ANY ROOM MAY BE CLASS C.

BUILDING CONSTRUCTION - INDIANA BUILDING CODE 2012 ELECTRICAL - 2023 NFPA 70 (NEC) AS AMENDED BY MICHIGAN PART 8 RULES MECHANICAL - INDIANA MECHANICAL CODE 2014 PLUMBING - INDIANA PLUMBING CODE 2012

FIRE ALARM SYSTEM - NFPA 70 & 72 FIRE EXTINGUISHERS - NFPA 10

FIRE SPRINKLERS - NFPA 13 FIRESTOPPING REQUIREMENT

ALL OPENINGS AROUND MECHANICAL, PLUMBING, ELECTRICAL, AND STRUCTURAL PENETRATIONS THRU A FIRE RESISTIVE RATED ASSEMBLY (INCLUDING FLOORS) SHALL BE SEALED WITH FIRE RATED FIRESTOPPING IN COMPLIANCE WITH ASTM

GENERAL CODE NOTES:

A. FIRE DEPARTMENT ACCESS AND WATER SUPPLY SHALL BE IN PLACE PRIOR TO COMMENCEMENT OF VERTICAL

B. FIRE STOP ALL INTERCONNECTIONS BETWEEN VERTICAL AND HORIZONTAL SPACES AND CONCEALED WALL SPACES AT THE CEILING, FLOOR, AND ROOF LEVELS.

C. INSTALL SOLID BLOCK BEHIND ALL RECESSED WALL UNITS AS REQUIRED TO MAINTAIN FIRE RATINGS.

D. ALL FIRE WALLS, FIRE BARRIERS, FIRE PARTITIONS, SMOKE BARRIERS, AND SMOKE PARTITIONS SHALL BE IDENTIFIED WITH STENCILING AT INTERVALS NOT TO EXCEED 30'. REFER TO CODE PLAN FOR WALLS REQUIRED TO BE PROTECTED.

E. ALL PENETRATIONS AT SMOKE AND FIRE RATED WALLS, FLOORS, CEILINGS, ETC. SHALL BE PROTECTED, SEALED OR DAMPERED USING ONLY U.L. AND / OR I.C.B.O. APPROVED METHODS, MATERIALS AND INSTALLATION.

F. SEE REFLECTED CEILING PLANS AND LIGHTING PLANS FOR EXIT SIGNAGE LOCATIONS.

G. ALL EXITS TO BE OPENABLE FROM THE INSIDE WITHOUT THE USE OF KEY OR SPECIAL KNOWLEDGE.

H. ALL ELEVATORS SHALL COMPLY WITH A.D.A., A.D.A.G.G. AND A.N.S.I. REQUIREMENTS. I. SPECIAL STRUCTURAL INSPECTIONS ARE REQUIRED. REVIEW GENERAL STRUCTURAL NOTES AND SPECIFICATIONS FOR

J. FIRE SPRINKLERS AND FIRE ALARM SYSTEM SHALL BE PROVIDED PER NFPA NO. 13, 70 & 72. SUBMIT ALL REQUIRED DRAWING AND INFORMATION TO THE AUTHORITY HAVING JURISDICTION FOR APPROVAL PRIOR TO COMMENCEMENT OF

ANY RELATED WORK. OBTAIN APPROVAL OF COMPLETED SYSTEMS PRIOR TO FINAL ACCEPTANCE.

LEGEND - CODE COMPLIANCE PLAN

** ** ** ** * * * * *

FIRE WALLS (IBC SECTION 706) CREATE SEPÀRATE BUILDINGS. 2-HOUR FIRE RESISTANCE RATING, STRUCTURALLY ENGINEERED. 90-MINUTE SELF-CLOSING DOORS. GLAZING ONLY ALLOWED IF DESIGNED AND TESTED AS A WALL. GLAZED OPENINGS ARE PERMITTED IF RATED AS A WALL, PER ASTM E119 AND SECTION 716.2 (IBC) IN MAXIMUM SIZE TESTED.

OPENING SHALL BE LESS THAN 25% OF THE COMMON CORRIDOR WALL PER ROOM.

2-HR FIRE BARRIER (IBC SECTION 707 / NFPA 101 - 8.3) FIRE BARRIER (2-HOUR FIRE RESISTANCE RATING REQUIRED). INSTALL FROM FLOOR SLAB TO UNDERSIDE OF ROOF DECK ABOVE. 90-MINUTE SELF-CLOSING DOORS (100 SQUARE INCHES MAXIMUM DOOR VISION PANEL). GLAZED OPENINGS ARE PERMITTED IF 2-HOUR RATED, PER ASTM E119 AND TABLE 716.5 (IBC) AND TABLE 8.3.4.2 (NFPA 101).

1-HR FIRE BARRIER (IBC SECTION 707 / NFPA 101 - 8.3) FIRE BARRIER (1-HOUR FIRE RESISTANCE RATING REQUIRED). INSTALL FROM FLOOR SLAB TO UNDERSIDE OF ROOF DECK ABOVE. OPENING SHALL BE LESS THAN 25% OF THE WALL. OPENING PROTECTIVES DEPEND ON TYPE OF ASSEMBLY PER TABLE 716.5 (IBC) AND TABLE 8.3.4.2 (NFPA 101).

CORRIDOR WALL PER ROOM.

(CORRIDOR) FIRE BARRIER (IBC SECTION 707 / NFPA 101 - 8.3) CORRIDOR FIRE BARRIER (1-HOUR FIRE RESISTANCE RATING REQUIRED). INSTALL FROM FLOOR SLAB TO UNDERSIDE OF ROOF DECK ABOVE. 20-MINUTE SELF-CLOSING DOORS. GLAZED OPENINGS ARE PERMITTED IF 3/4-HOUR RATED, PER ASTM E119 IN THE MAXIMUM SIZE TESTED. OPENING SHALL BE LESS THAN 25% OF THE COMMON

SMOKE BARRIER (IBC SECTION 709 / NFPA 101 - 8.5) SMOKE BARRIER (1-HOUR FIRE RESISTANCE RATING REQUIRED). DIVIDE BUILDING INTO COMPARTMENTS TO RESTRICT MOVEMENT OF SMOKE. INSTALL FROM FLOOR SLAB TO UNDERSIDE OF ROOF DECK ABOVE 20-MINUTE SELE-CLOSING OR SMOKE ACTIVATED LABEL DOORS. GLAZED OPENINGS ARE PERMITTED IF 3/4-HOUR RATED, PER ASTM E119 IN THE MAXIMUM SIZE TESTED. OPENING SHALL BE LESS THAN 25% OF

SMOKE PARTITION (NO FIRE RESISTANCE RATING) FROM FLOOR SLAB TIGHT TO ROOF DECK OR SOLID CEILING ABOVE. GLAZED OPENINGS ARE PERMITTED (NO RATING REQUIRED) "PER NFPA 101 14.3.6(2)(B) SELF-CLOSING DOORS PER 8.4.3.5 ARE NOT REQUIRED FOR NORMALLY OCCUPIED CLASSROOMS"

BUILDING EXIT WITH EGRESS WIDTH OCCUPANT LOAD DENOTES FIRE RESISTANCE RATING OF OPENING PROTECTIVE (IN MINUTES) DENOTES PANIC HARDWARE DEVICE ON EACH DOOR LEAF FE FIRE EXTINGUISHER "ACCESSIBLE" ROUTE/ENTRANCE/EGRESS EGRESS WINDOW LOCATION

ISSUANCES

01.06.2025 BIDS & CONSTRUCTION 01.22.2025 ADDENDUM 002 03.13.2025 BULLETIN 001

AR11500077

STATE OF

Leidot

3.18.2025

0

0

CHU


ERN

DRAWN NCB REVIEWED AGS

PROJECT NO. NO PART OF THIS DRAWING MAY BE USED OR REPRODUCED IN ANY FORM OR BY ANY MEANS, OR STORED IN A DATA BASE OR RETRIEVAL SYSTEM, WITHOUT PRIOR WRITTEN PERMISSION OF

GMB COPYRIGHT © 2025 ALL RIGHTS RESERVED

BUILDING SEPARATION PLAN

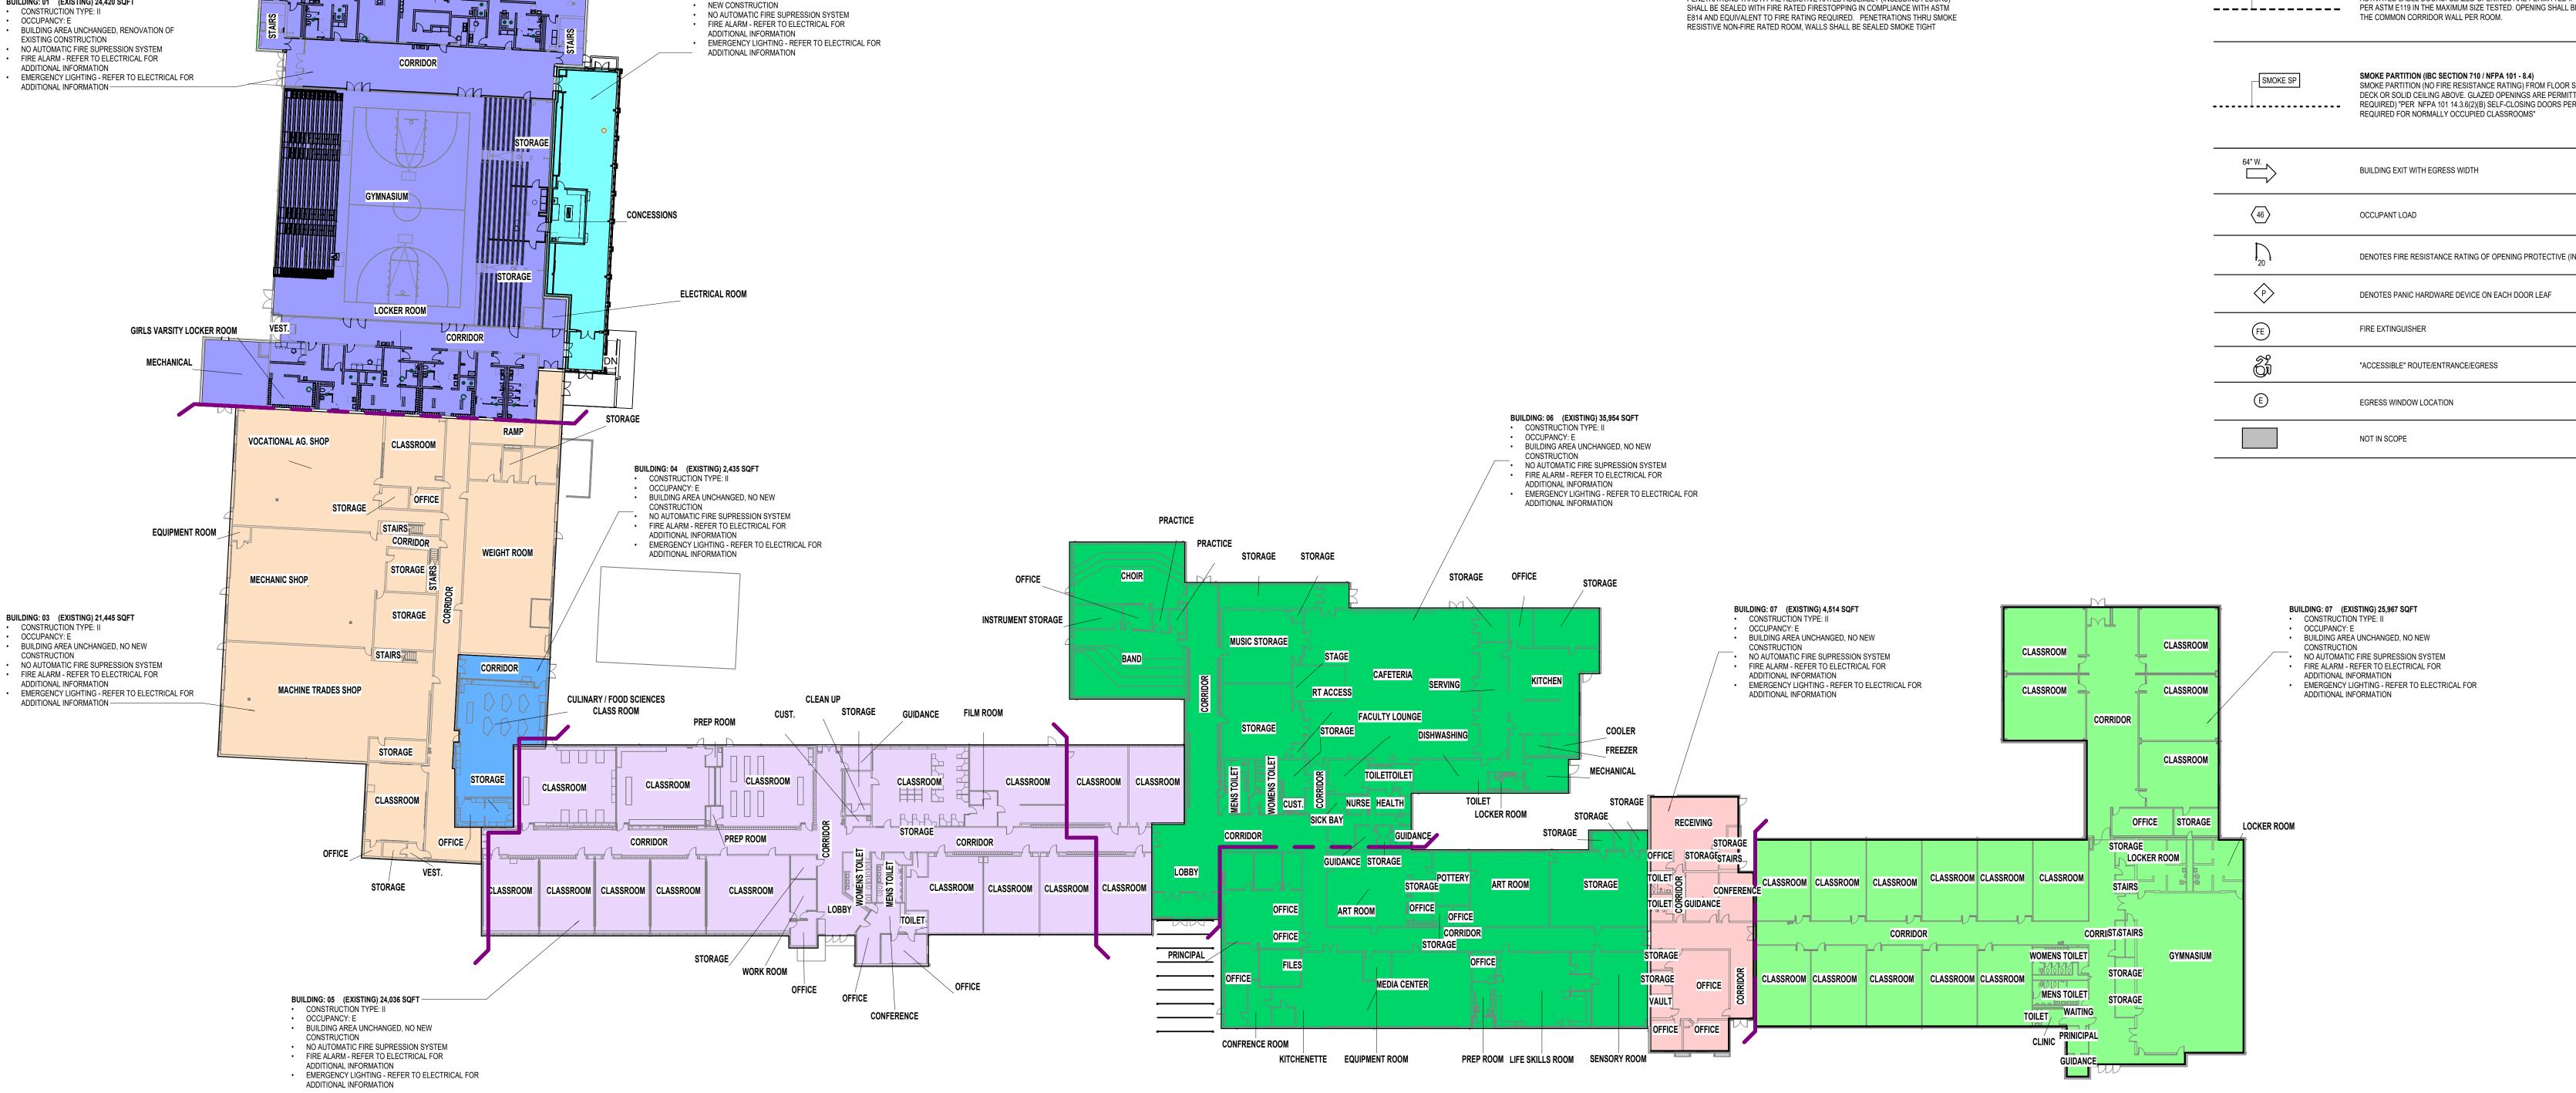

GIRLS VARSITY LOCKER ROOM

FOOTBALL LOCKER ROOM

BUILDING: 02 3,116 SQFT

OCCUPANCY: E

CONSTRUCTION TYPE: II

ALLOWABLE AREA: 14,500 SQFT

MENS BASKETBALL LOCKER

BUILDING: 01 (EXISTING) 24,420 SQFT

ROOM ATHLETIC DIRECTOR OFFICE

CODE COMPLIANCE PLAN

PLUMBING FIXTURE COUNTS

ASSEMBLY

OCCUPANTS)

EDUCATIONAL

(300 STUDENTS

30 STAFF)

NO. | CLASSIFICATION | OCCUPANCY | DESCRIPTION

WATER CLOSETS

1 PER 50

ACTUAL 7

1 PER 75

REQUIRED 12

1 PER 50

REQUIRED 4

ACTUAL 10

ACTUAL 23

SPECTATOR SEATING

FACILITIES

LAVATORIES

1 ADDITIONAL B.F. UNISEX

ACTUAL 6 ACTUAL 7

REQUIRED 4 REQUIRED 4 REQUIRED 4

MALE FEMALE FOUNTAINS OTHER

REQUIRED 4

ACTUAL X ACTUAL 1

REQUIRED 22 REQUIRED 5 REQUIRED 6 REQUIRED 2 REQUIRED 1


ACTUAL 22 ACTUAL 12 ACTUAL 11 ACTUAL 8 ACTUAL 1


1 PER 50 1 PER 50 1 PER 100


				WATER (CLOSETS	LAVA	TORIES		
NO.	CLASSIFICATION OCCUPANCY	NCY DESCRIPTION	MALE	FEMALE	MALE	FEMALE	DRINKING FOUNTAINS	OTHER	
1	ASSEMBLY	A-4	GYM WITH SPECTATOR	1 PER 75	1 PER 40	1 PER 200	1 PER 150	1 PER 1000	1 SERVICI SINK
	(1,694 OCCUPANTS)		SEATING	REQUIRED 12 ACTUAL 23	REQUIRED 22 ACTUAL 22	REQUIRED 5 ACTUAL 12	REQUIRED 6 ACTUAL 11	REQUIRED 2 ACTUAL 8	REQUIRED ACTUAL
				2 ADDITIONA	l L B.F. UNISEX	1 ADDITIONA	I IL B.F. UNISEX		
3	EDUCATIONAL	E	EDUCATIONAL	1 PER 50	1 PER 50	1 PER 50	1 PER 50	1 PER 100	1 SERVICI SINK
	(300 STUDENTS		FACILITIES	REQUIRED 4 ACTUAL 10	REQUIRED 4 ACTUAL 7	REQUIRED 4 ACTUAL 6	REQUIRED 4 ACTUAL 7	REQUIRED 4	REQUIRED
	30 STAFF)			1 ADDITIONA	L B.F. UNISEX	2 ADDITIONA	AL B.F. UNISEX	ACTUAL X	ACTUAL

GENERAL CODE NOTES:

- A. FIRE DEPARTMENT ACCESS AND WATER SUPPLY SHALL BE IN PLACE PRIOR TO COMMENCEMENT OF VERTICAL
- B. FIRE STOP ALL INTERCONNECTIONS BETWEEN VERTICAL AND HORIZONTAL SPACES AND CONCEALED WALL SPACES AT THE CEILING, FLOOR, AND ROOF LEVELS.
- C. INSTALL SOLID BLOCK BEHIND ALL RECESSED WALL UNITS AS REQUIRED TO MAINTAIN FIRE RATINGS.
- D. ALL FIRE WALLS, FIRE BARRIERS, FIRE PARTITIONS, SMOKE BARRIERS, AND SMOKE PARTITIONS SHALL BE IDENTIFIED WITH STENCILING AT INTERVALS NOT TO EXCEED 30'. REFER TO CODE PLAN FOR WALLS REQUIRED TO BE PROTECTED.
- E. ALL PENETRATIONS AT SMOKE AND FIRE RATED WALLS, FLOORS, CEILINGS, ETC. SHALL BE PROTECTED, SEALED OR DAMPERED USING ONLY U.L. AND / OR I.C.B.O. APPROVED METHODS, MATERIALS AND INSTALLATION.
- F. SEE REFLECTED CEILING PLANS AND LIGHTING PLANS FOR EXIT SIGNAGE LOCATIONS.
- G. ALL EXITS TO BE OPENABLE FROM THE INSIDE WITHOUT THE USE OF KEY OR SPECIAL KNOWLEDGE.
- H. ALL ELEVATORS SHALL COMPLY WITH A.D.A., A.D.A.G.G. AND A.N.S.I. REQUIREMENTS.
- I. SPECIAL STRUCTURAL INSPECTIONS ARE REQUIRED. REVIEW GENERAL STRUCTURAL NOTES AND SPECIFICATIONS FOR
- J. FIRE SPRINKLERS AND FIRE ALARM SYSTEM SHALL BE PROVIDED PER NFPA NO. 13, 70 & 72. SUBMIT ALL REQUIRED DRAWING AND INFORMATION TO THE AUTHORITY HAVING JURISDICTION FOR APPROVAL PRIOR TO COMMENCEMENT OF ANY RELATED WORK. OBTAIN APPROVAL OF COMPLETED SYSTEMS PRIOR TO FINAL ACCEPTANCE.

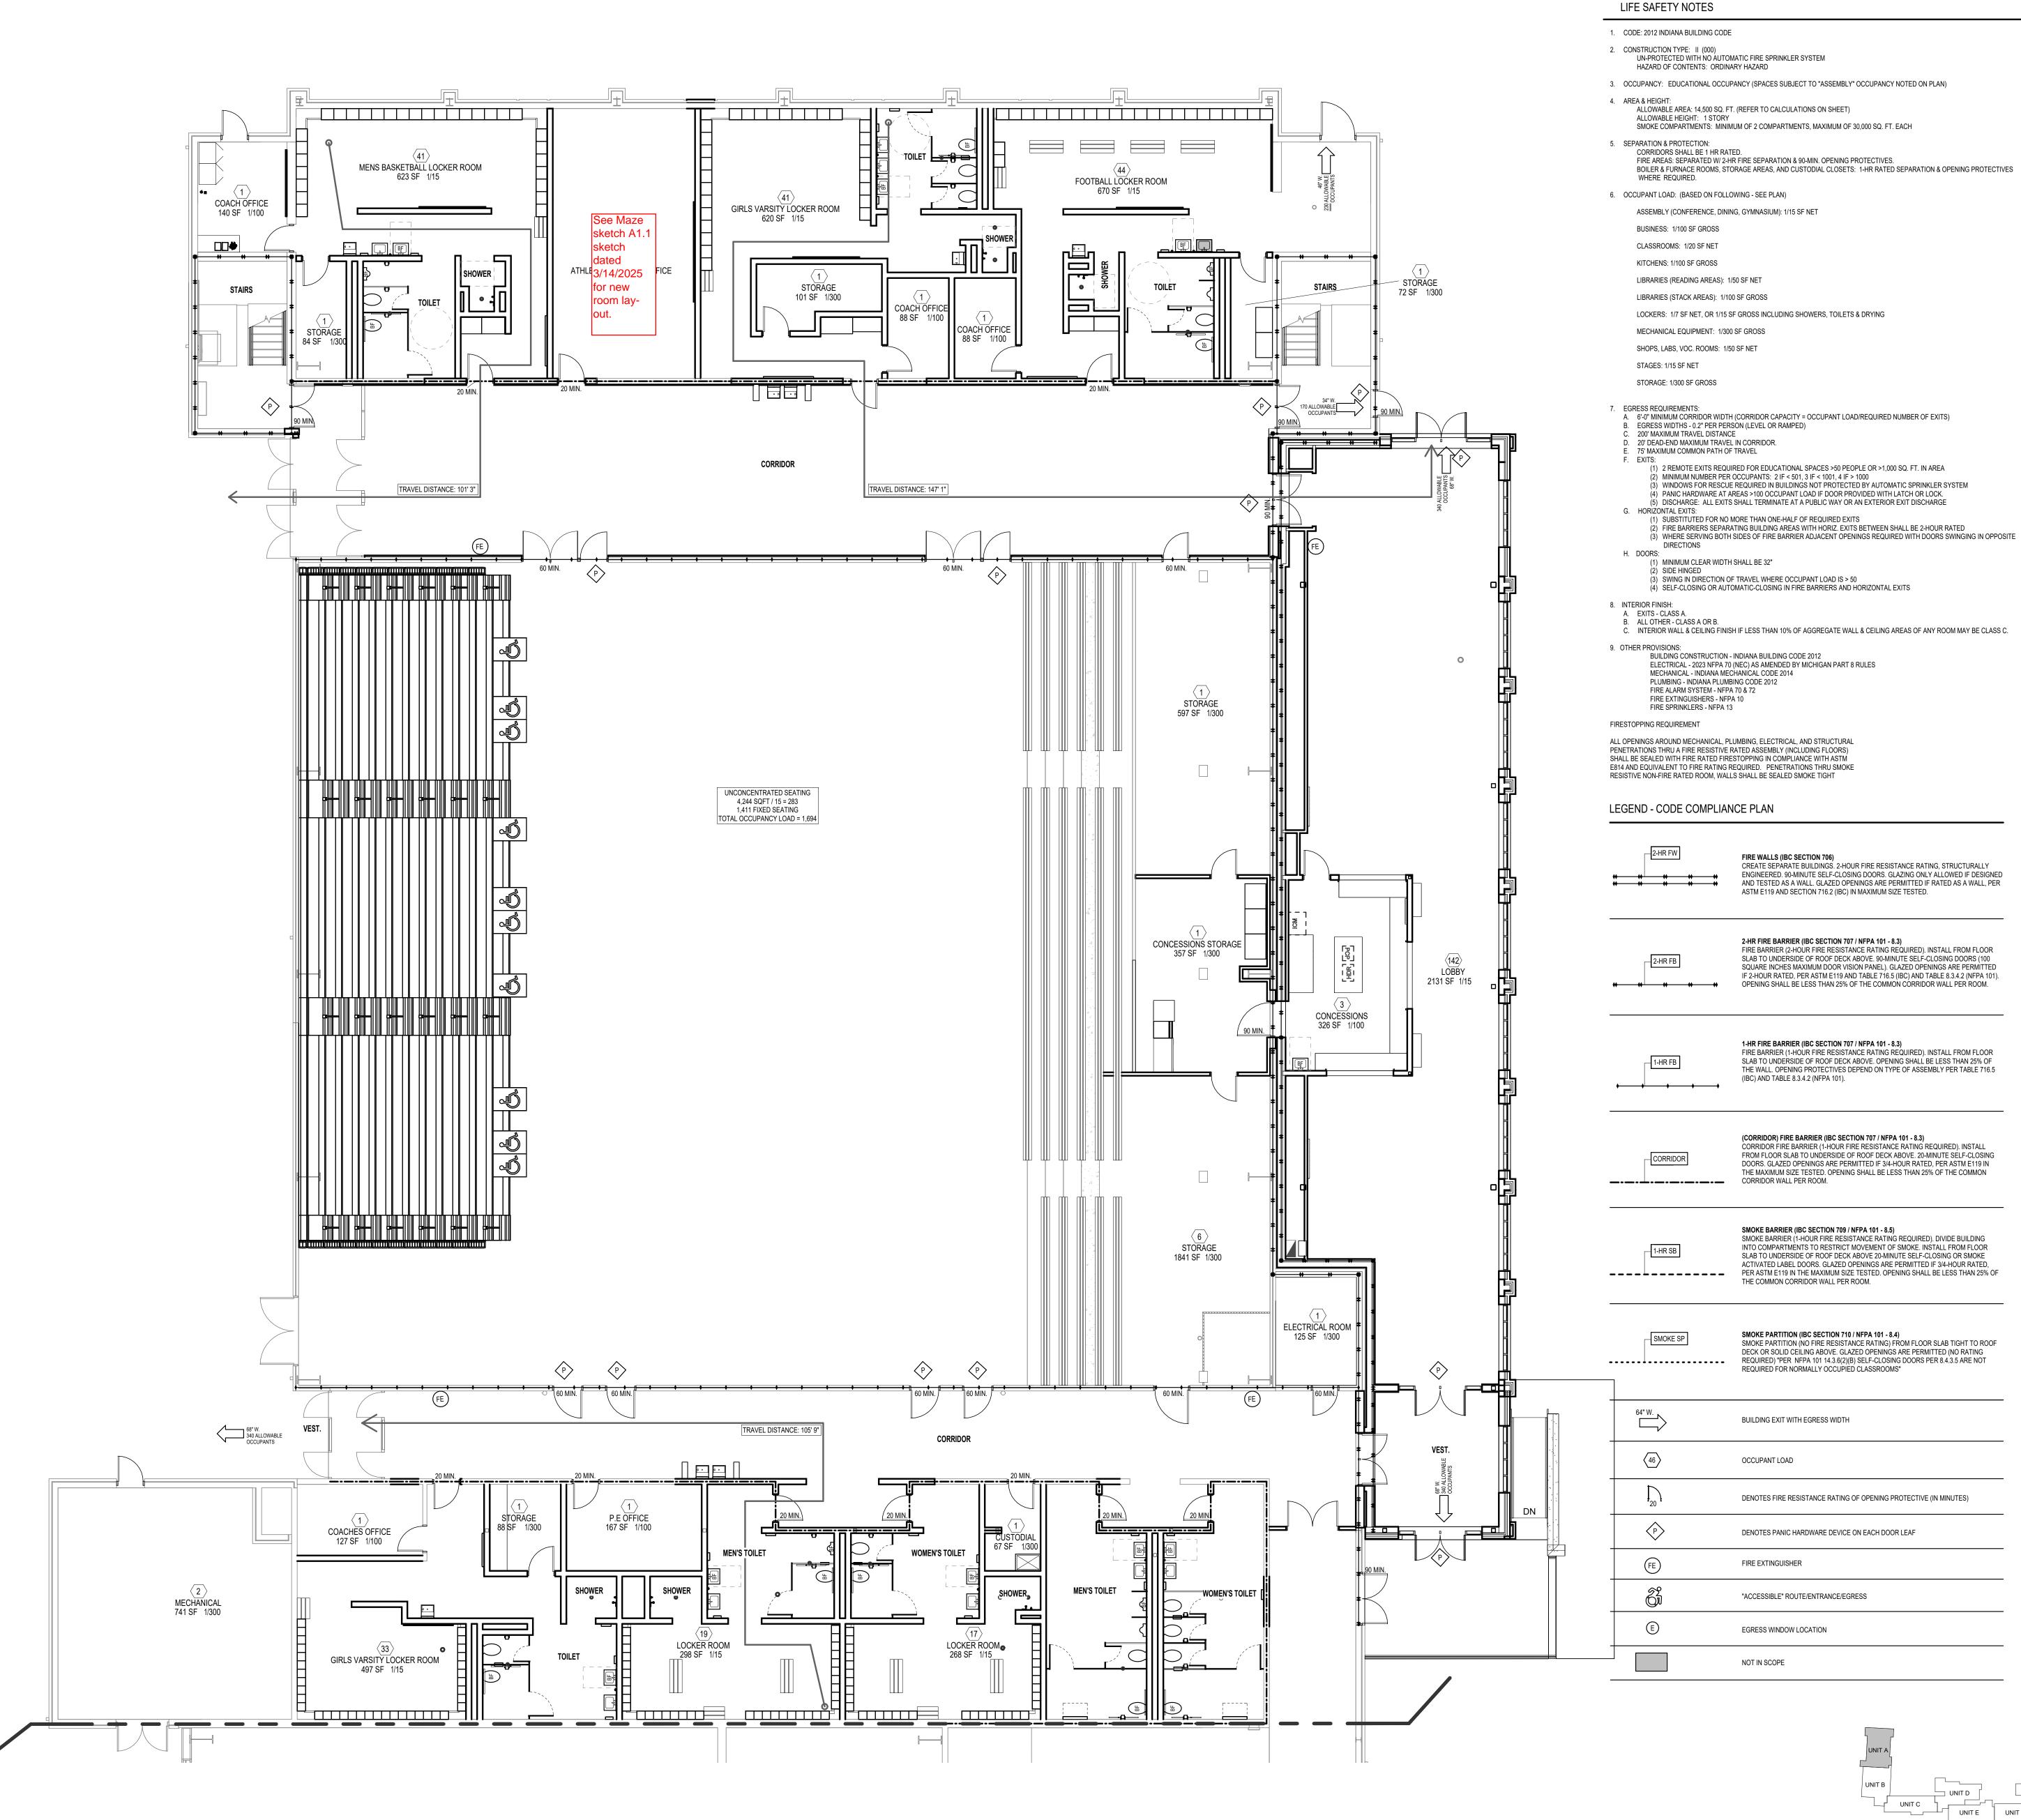

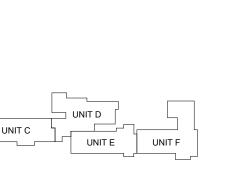

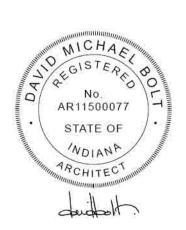

3.18.2025

ISSUANCES

01.06.2025 BIDS &

03.13.2025 BULLETIN 001

CONSTRUCTION

DRAWN NCB REVIEWED AGS

PROJECT NO. NO PART OF THIS DRAWING MAY BE USED OR REPRODUCED IN ANY FORM OR BY ANY MEANS, OR STORED IN A DATA BASE OR RETRIEVAL SYSTEM, WITHOUT PRIOR WRITTEN

GMB COPYRIGHT © 2025 ALL RIGHTS RESERVED UNIT 'A' CODE COMPLIANCE

Maze Design, Inc.

AR11500077

STATE OF

duillot.


3.18.2025

LIFE SAFETY NOTES

GMB COPYRIGHT © 2025 ALL RIGHTS RESERVED

JNIT 'A' CODE COMPLIANCE

UNIT 'A' CODE COMPLIANCE
PLAN - BUILDIING
SEPERATION (ADDED BUL.
001)

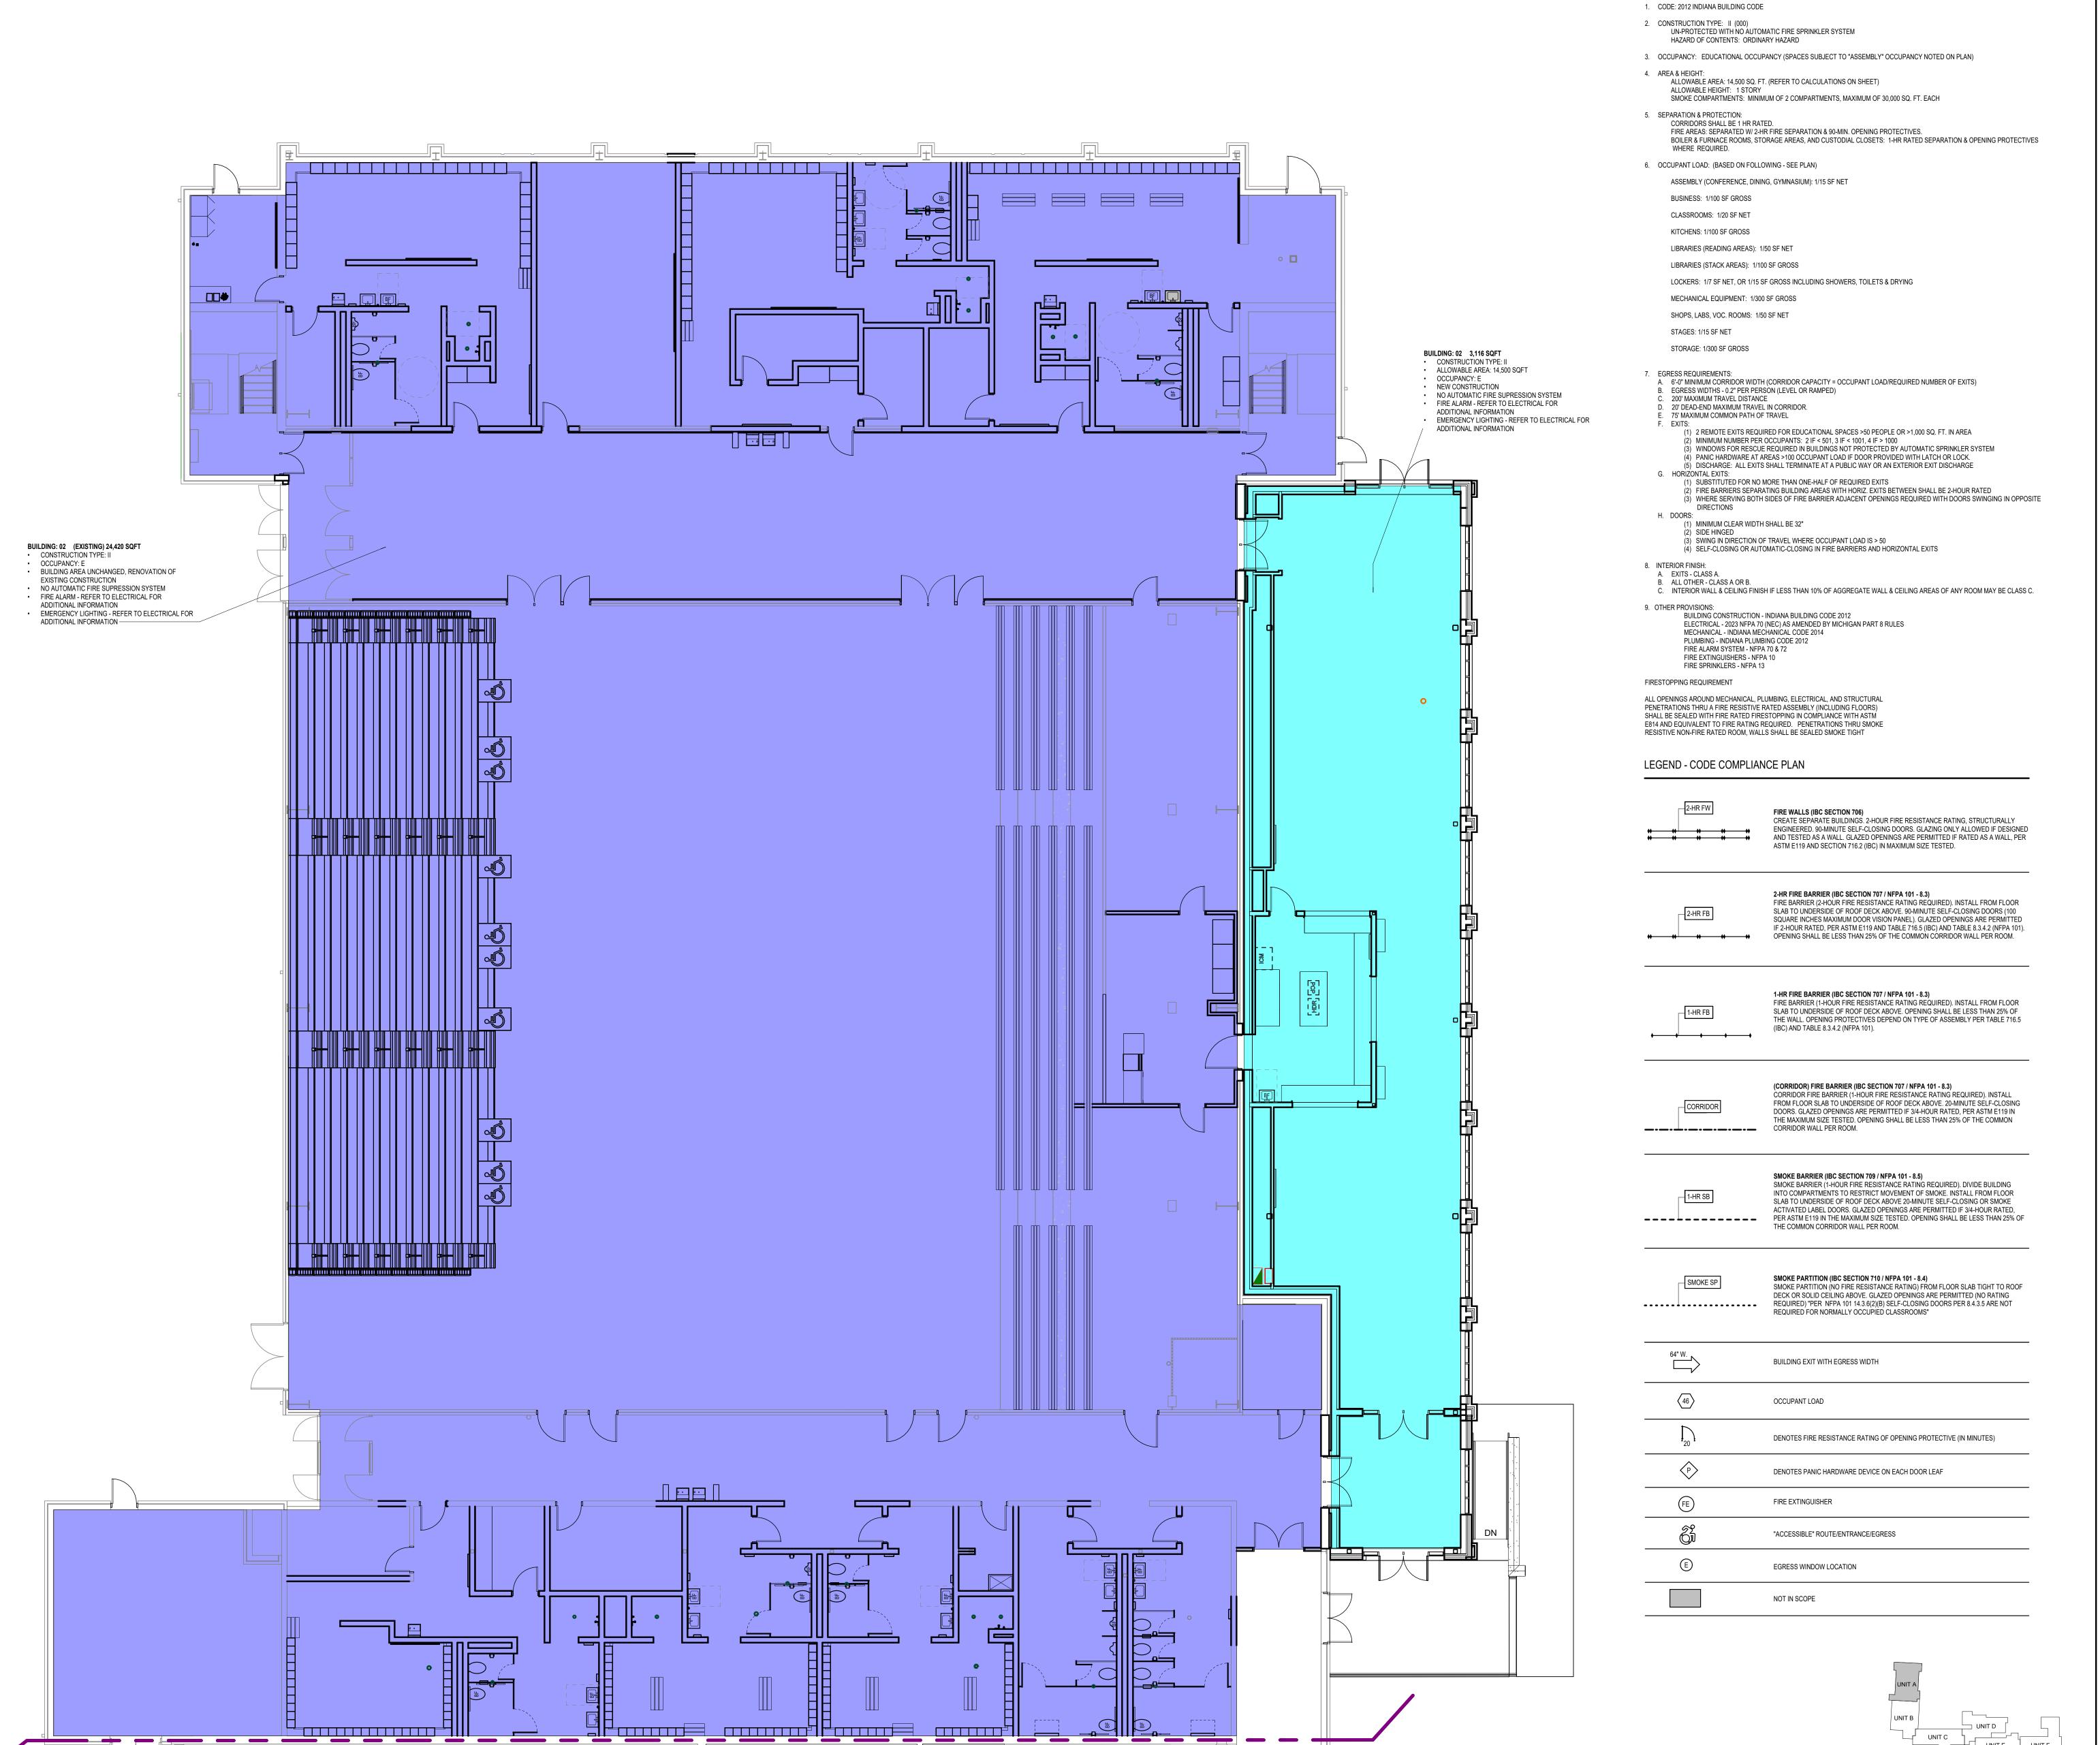

BUILDING EXIT WITH EGRESS WIDTH

DENOTES FIRE RESISTANCE RATING OF OPENING PROTECTIVE (IN MINUTES)

DENOTES PANIC HARDWARE DEVICE ON EACH DOOR LEAF

"ACCESSIBLE" ROUTE/ENTRANCE/EGRESS

EGRESS WINDOW LOCATION

NOT IN SCOPE

OCCUPANT LOAD

FIRE EXTINGUISHER


ISSUANCES

01.06.2025 BIDS & CONSTRUCTION


DRAWN NCB REVIEWED AGS

PROJECT NO. NO PART OF THIS DRAWING MAY BE USED OR REPRODUCED IN ANY FORM OR BY ANY MEANS, OR STORED IN A DATA BASE OR RETRIEVAL SYSTEM, WITHOUT PRIOR WRITTEN PERMISSION OF

ALL RIGHTS RESERVED UNIT 'A' SECOND FLOOR

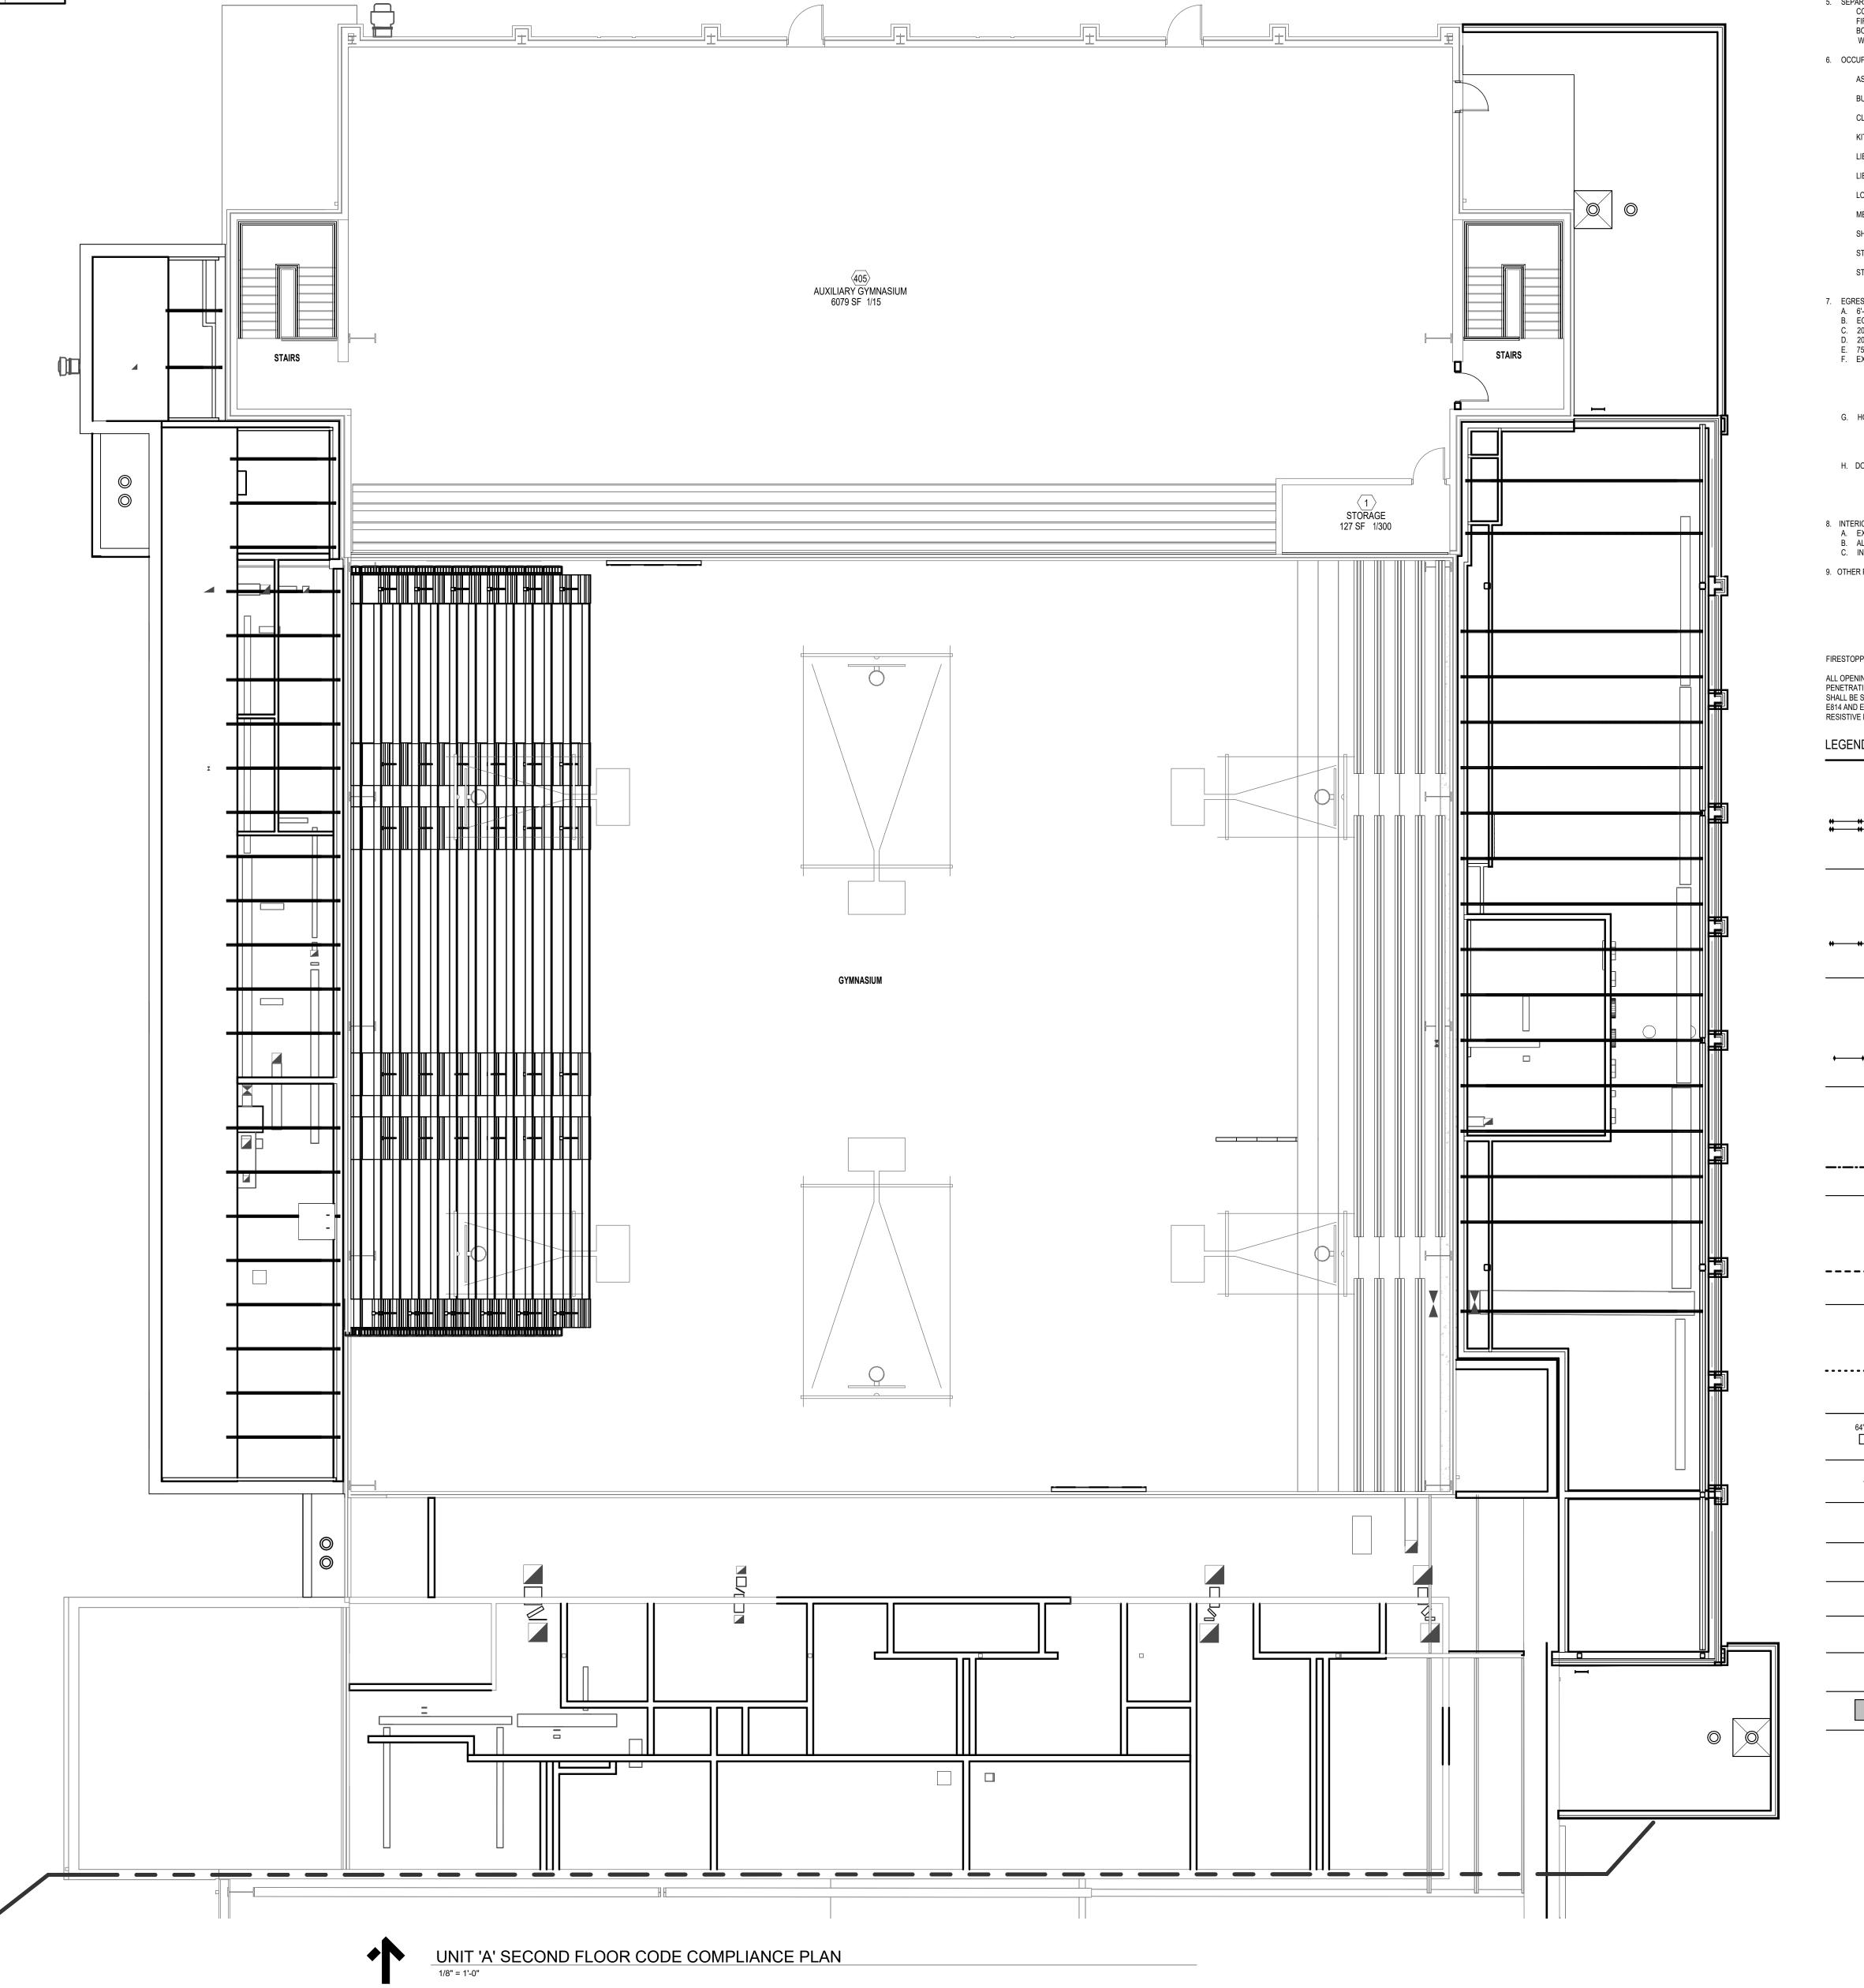

Maze Design, Inc.

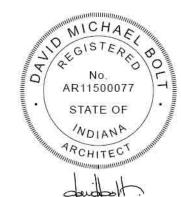

3.18.2025

SCHOOL

GMB COPYRIGHT © 2025

CODE COMPLIANCE PLAN

G2.1A

gmb

Maze Design, Inc.



3.18.2025

ATIONS - BID PACKAGE #
OLS

ESTERN WAYNE SCHOO

ISSUANCES
01.06.2025 BIDS & CONSTRUCTION

DRAWN NCB
REVIEWED AGS

PROJECT NO. 5-6394

NO PART OF THIS DRAWING MAY BE USED OR REPRODUCED IN ANY FORM OR BY ANY MEANS, OR STORED IN A DATA BASE OR RETRIEVAL SYSTEM, WITHOUT PRIOR WRITTEN PERMISSION OF


GMB COPYRIGHT © 2025 ALL RIGHTS RESERVED

FIRST FLOOR PHASING PLAN

G3.01

ALL RIGHTS RESERVED


PROJECT INFORMATION SHEET

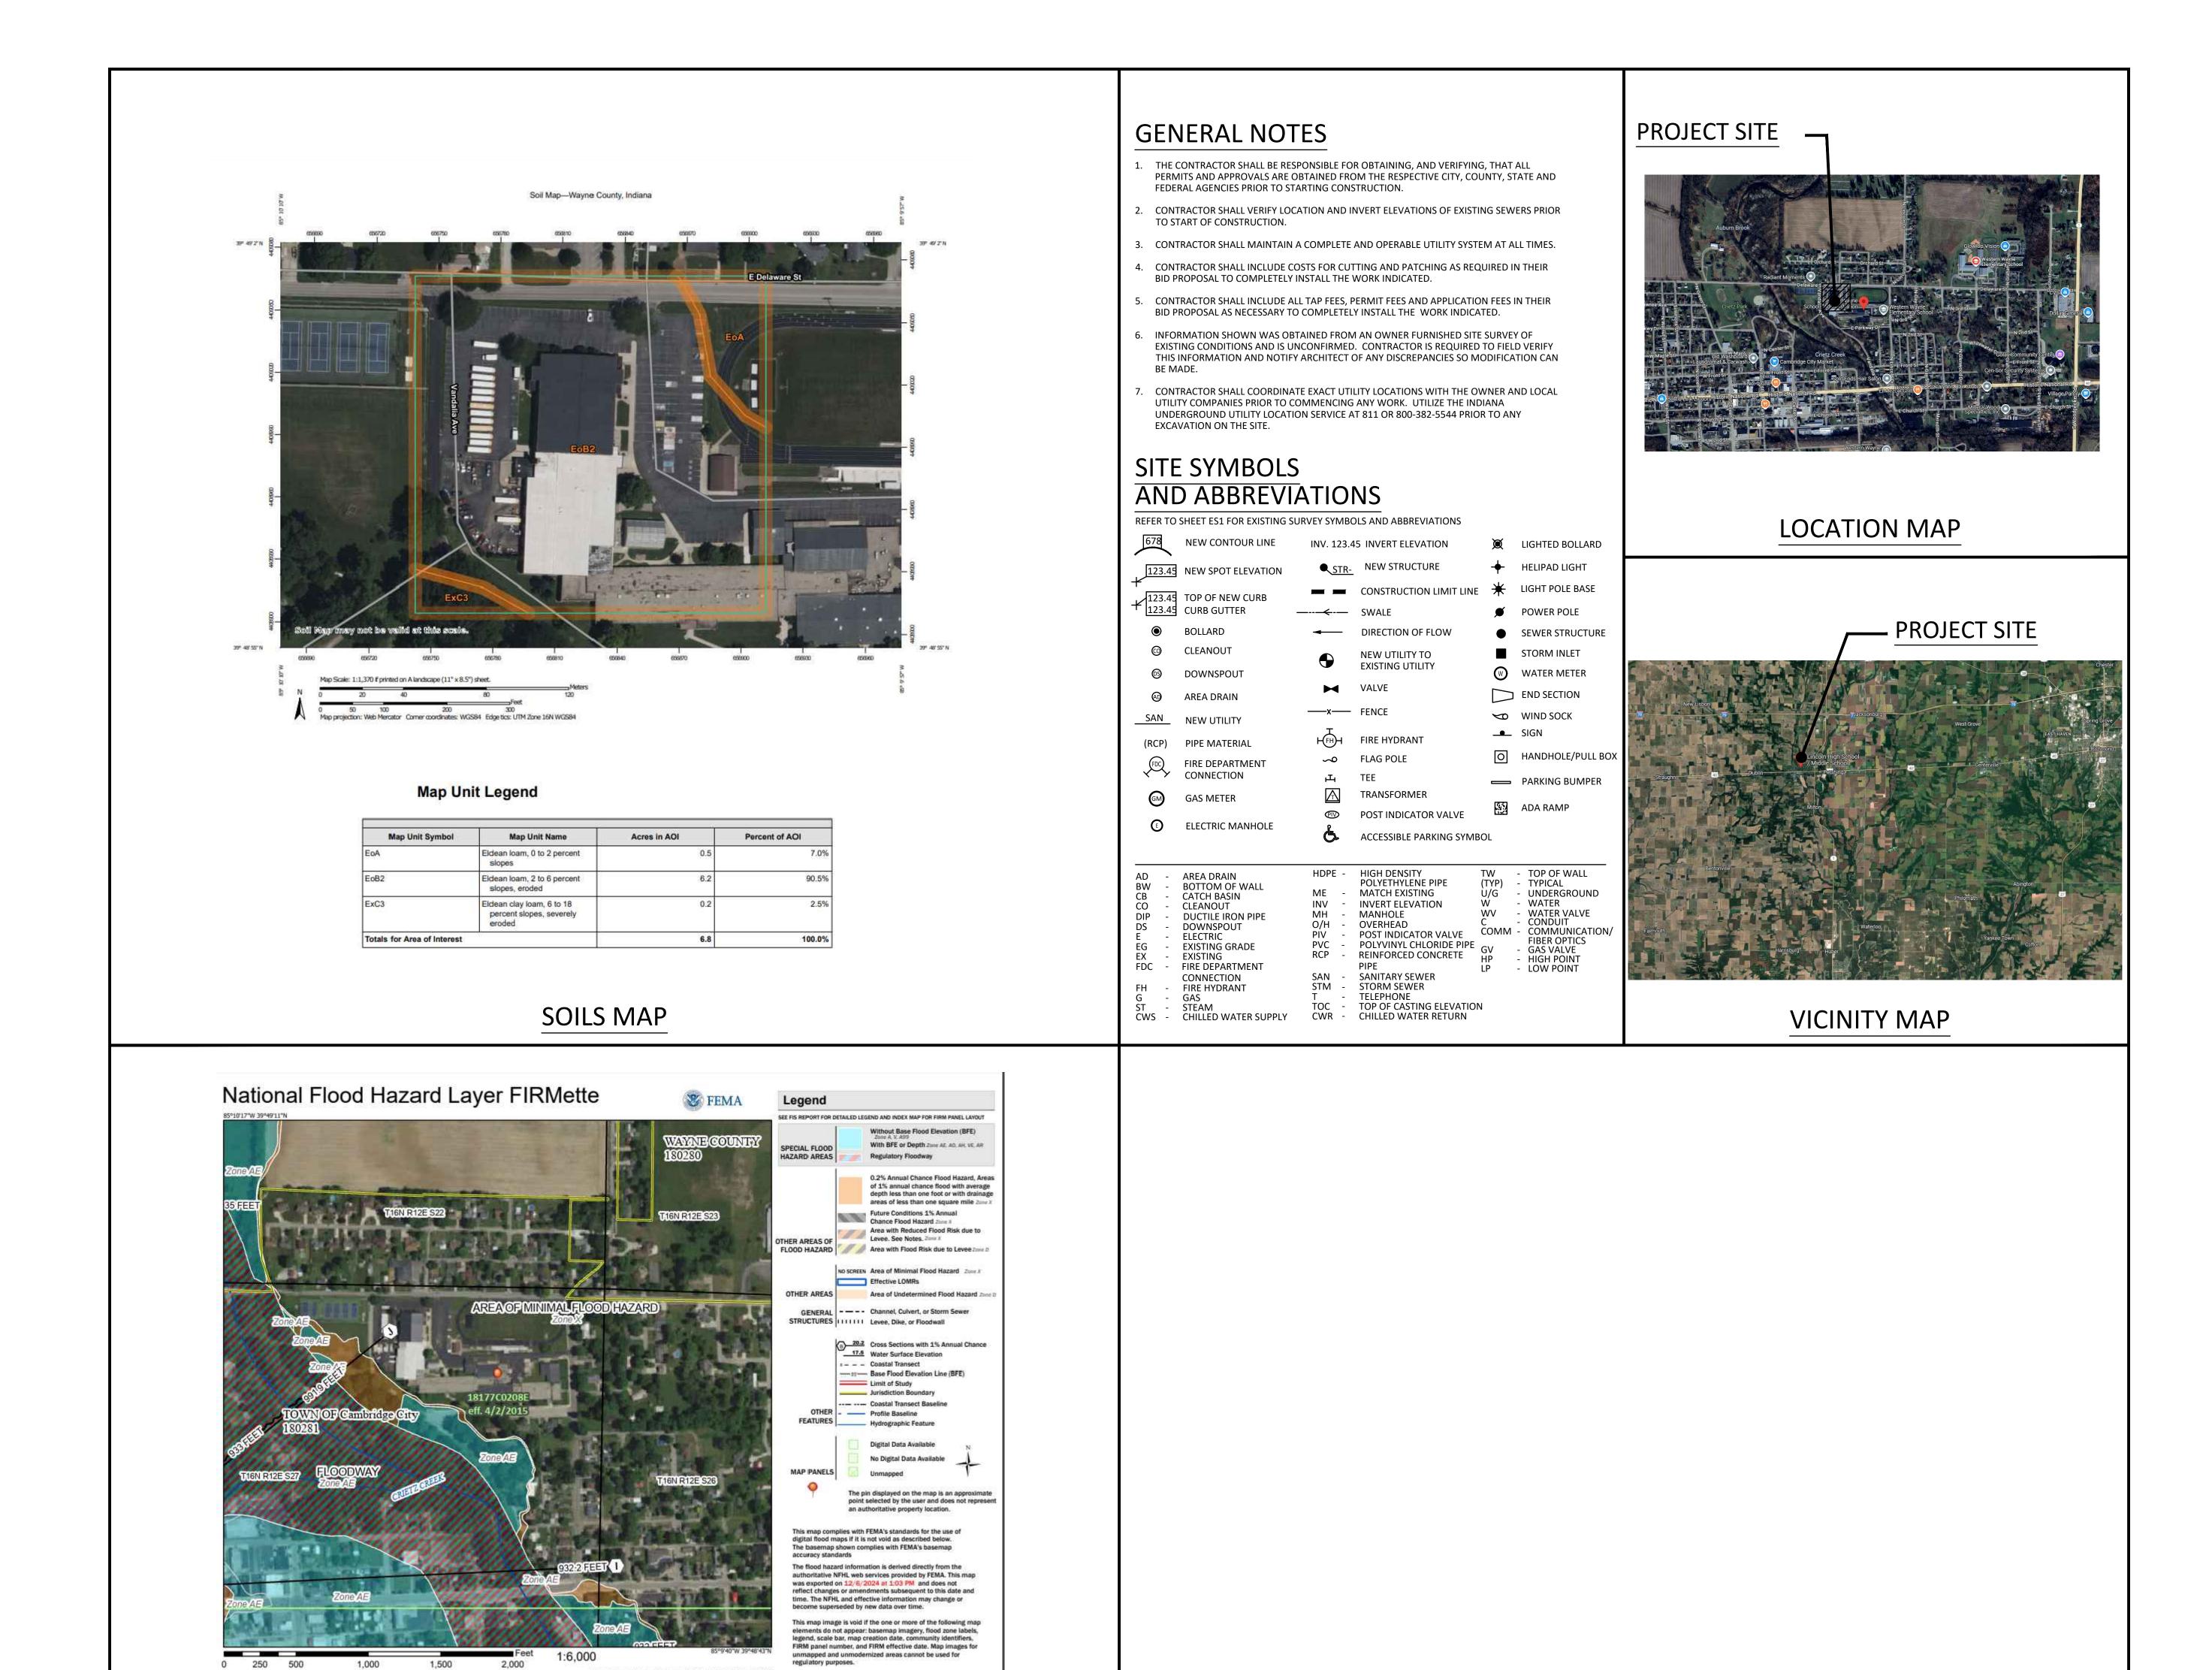


FLOOD MAP

PERMISSION OF GMB COPYRIGHT © 2025 ALL RIGHTS RESERVED

SITE DEMOLITION SHEET C1.01

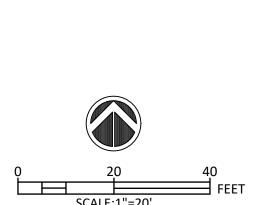

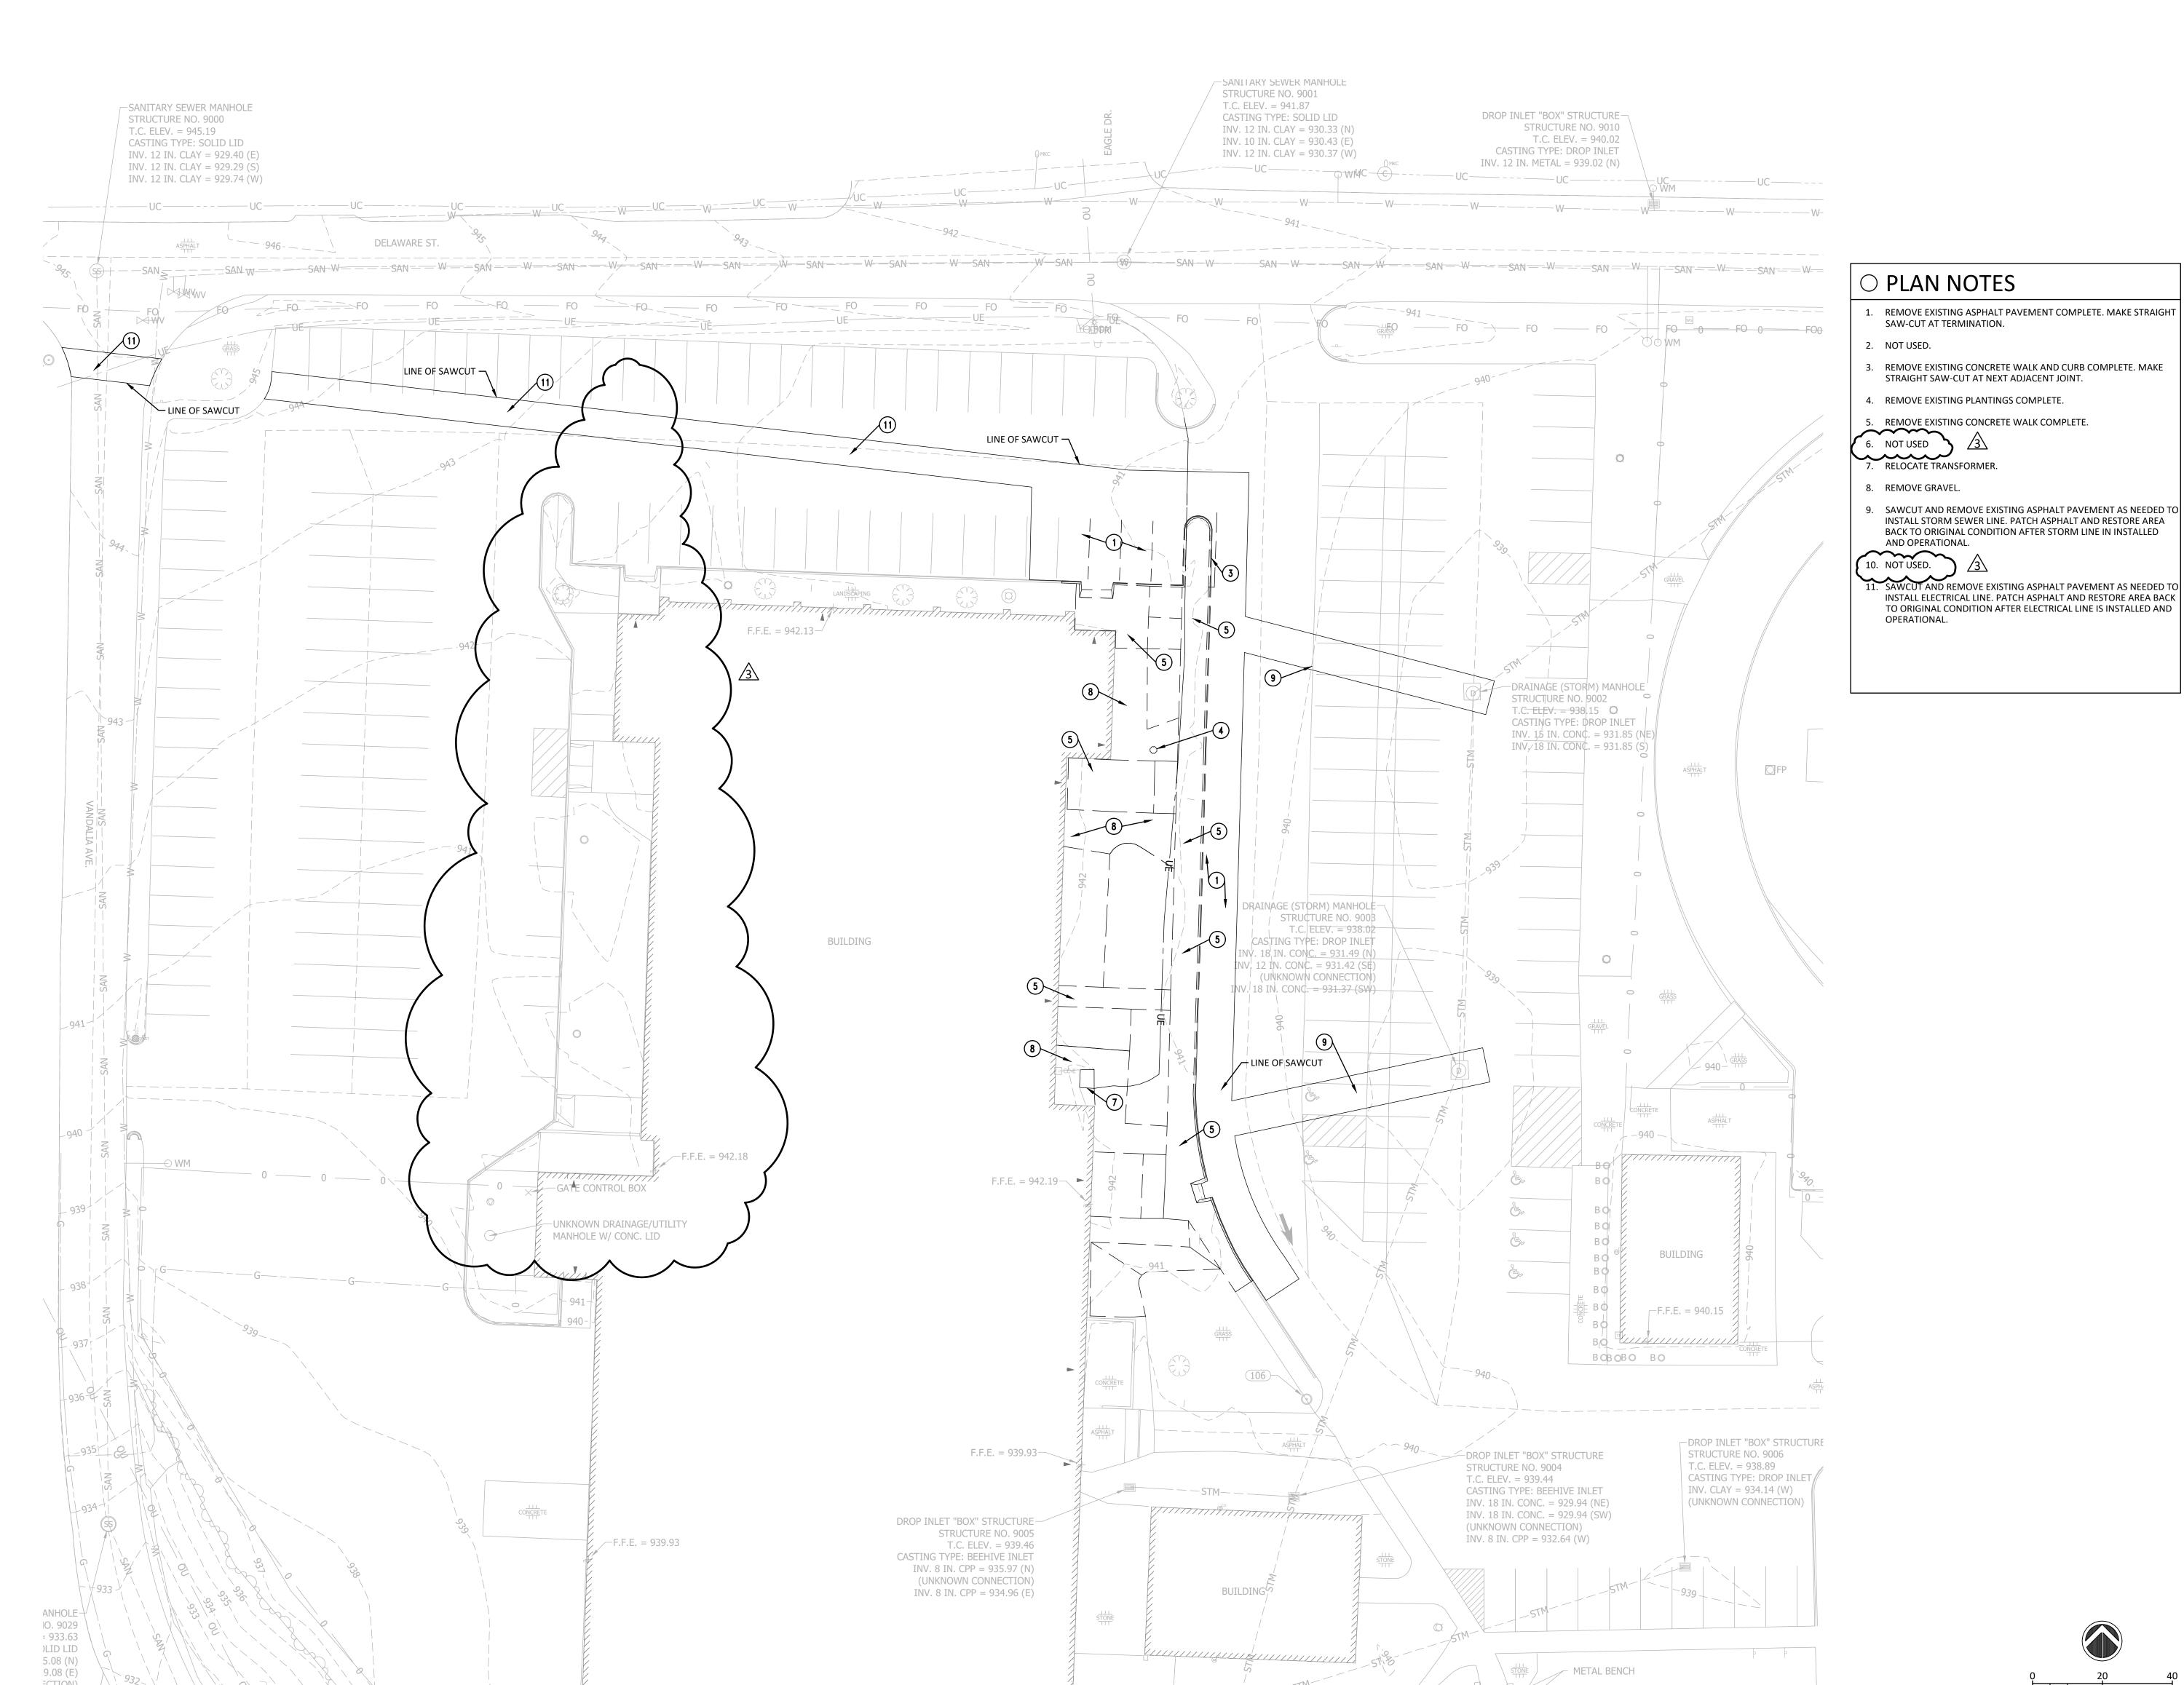

9.08 (E) ECTION)

5. CONTRACTOR SHALL BE RESPONSIBLE FOR OBTAINING NECESSARY PERMITS FOR WORK IN ROW AND ON ANY UTILITY CONNECTIONS OR ABANDONMENT PRIOR TO THE START OF CONSTRUCTION.

ANY ROOTS OF TREES BEING SAVED WHICH ARE EXPOSED DUE TO

EXPENSE OF THE CONTRACTOR RESPONSIBLE FOR THE DAMAGE.

1. DO NOT BURY ANY DEBRIS, ROOTS, TOPSOIL OR OTHER MATERIALS.

SHALL BE REPAIRED AT THE CONTRACTORS EXPENSE.

2. PROPOSED WORK TO COMPLY WITH ALL APPLICABLE REGULATIONS AND

3. PROTECT THE SITE, ADJACENT PROPERTY AND UTILITY SERVICES FROM DAMAGE OR DISRUPTION OF SERVICE/ACCESS. DAMAGE TO EXISTING STRUCTURE, SITE OR UTILITIES

4. ALL TREES TO REMAIN SHALL BE CAREFULLY PROTECTED. DO NOT DRIVE HEAVY EQUIPMENT WITHIN THE TREE'S DRIP LINE OR 12 FT OF TREE TRUNKS, WHICHEVER IS GREATER. BRANCHES WHICH ARE DAMAGED DURING DEMOLITION OF STRUCTURES AND/OR SURFACES SHALL BE CUT OUT AS DIRECTED BY THE ARCHITECT/ENGINEER.

DEMOLITION/REMOVAL SHALL BE COVERED WITHIN 6 HOURS WITH SOIL. DAMAGED TREES MAY BE REPLACED AT THE DISCRETION OF THE ARCHITECT/ENGINEER AT THE

6. CONTRACTORS TO REVIEW ALL SHEETS FOR RELATED INFORMATION. 7. LIST OF STANDARD ABBREVIATIONS -


 ABOVE FINISHED FLOOR = CENTER LINE = FINISH FLOOR ELEVATION = UNLESS NOTED OTHERWISE

GENERAL NOTES:

TRAFFIC MARKING AND SIGNAGE NOTES:

- 1. CONTRACTOR TO PROVIDE TRAFFIC MARKINGS AS SHOWN ON THIS PLAN. REFER TO SPECIFICATIONS FOR ADDITIONAL INFORMATION REGARDING MARKINGS.
- 2. ALL SIGNAGE AND MARKINGS MUST MEET MICHIGAN MANUAL OF UNIFORM TRAFFIC CONTROL DEVICES STANDARD SHAPES AND SIZES.
- 3. ALL BARRIER FREE PARKING SPACES SHALL BE PER MOST RECENT VERSION OF MICHIGAN BARRIER FREE CODE.

LAYOUT LEGEND	
SYMBOL	DESCRIPTION
	STANDARD CURB & GUTTER
	STANDARD DUTY CONCRETE
	STANDARD DUTY PAVEMENT
O	SIGN & POST

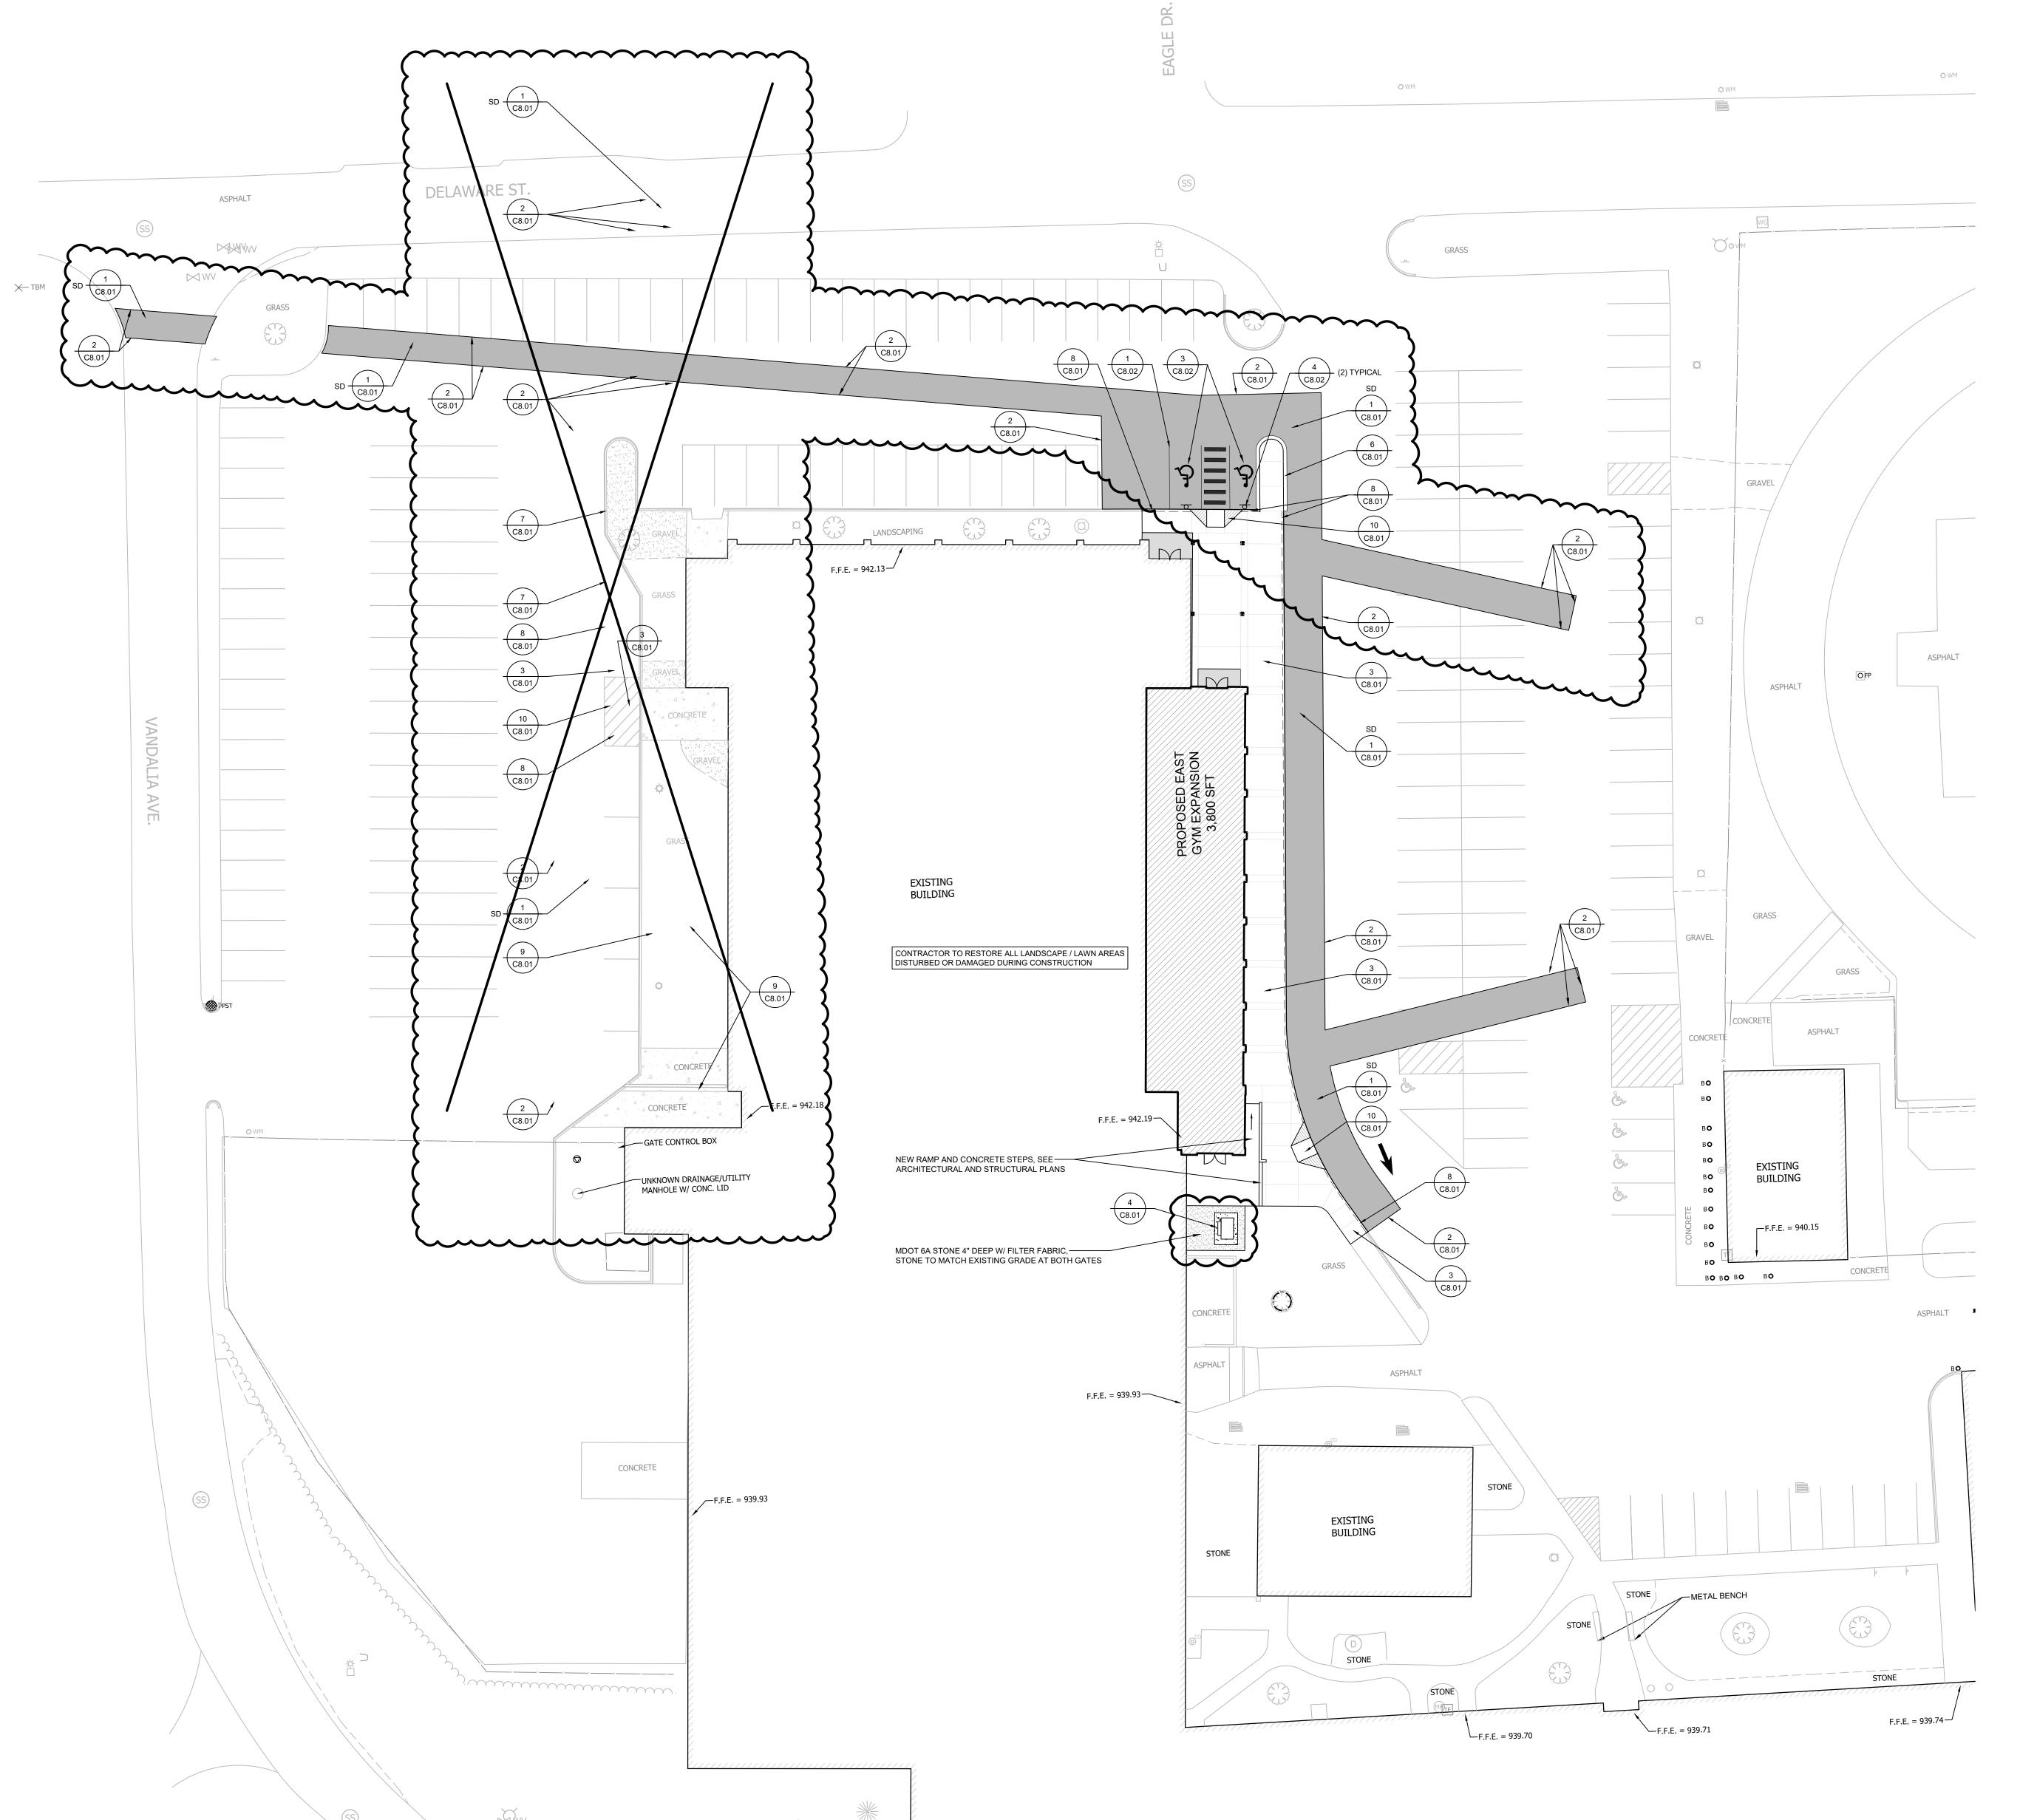

STATE OF ISSUANCES

01.06.2025 BIDS & CONSTRUCTION

03.13.2025 BULLETIN 001

DRAWN NRE REVIEWED CLM PROJECT NO. NO PART OF THIS DRAWING MAY BE USED OR REPRODUCED IN ANY FORM OR BY ANY MEANS, OR STORED IN A DATABASE OR RETRIEVAL SYSTEM, WITHOUT PRIOR WRITTEN PERMISSION OF

SITE PLAN


GMB COPYRIGHT © 2025 ALL RIGHTS RESERVED


3 03.19.2025 BULLETIN #1

PROJECT NO. NO PART OF THIS DRAWING MAY BE USED OR REPRODUCED IN ANY FORM OR BY ANY MEANS, OR STORED IN A DATABASE OR RETRIEVAL SYSTEM, WITHOUT PRIOR WRITTEN

PERMISSION OF GMB COPYRIGHT © 2025 ALL RIGHTS RESERVED

SITE GRADING, DRAINAGE, & UTILITY PLAN

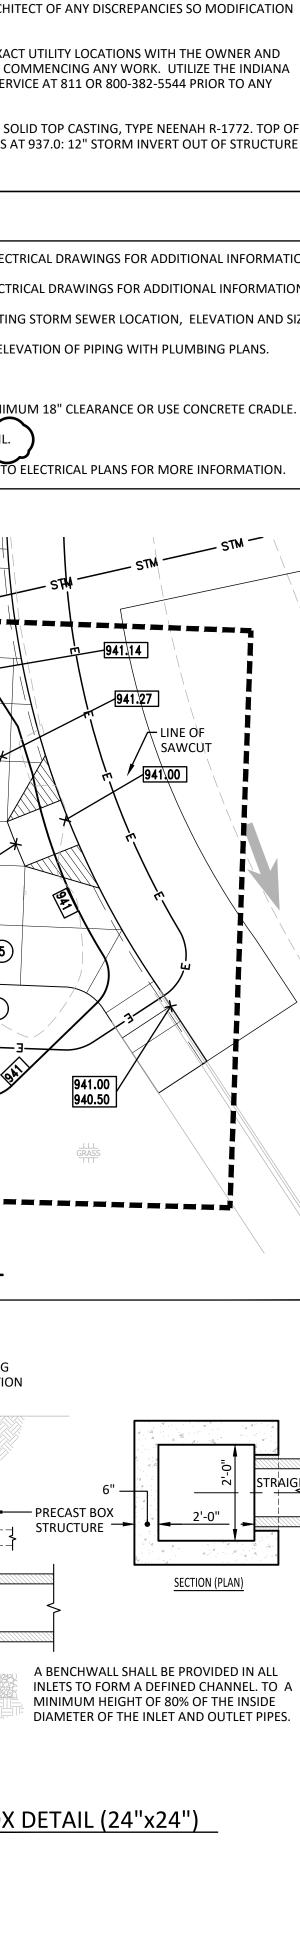

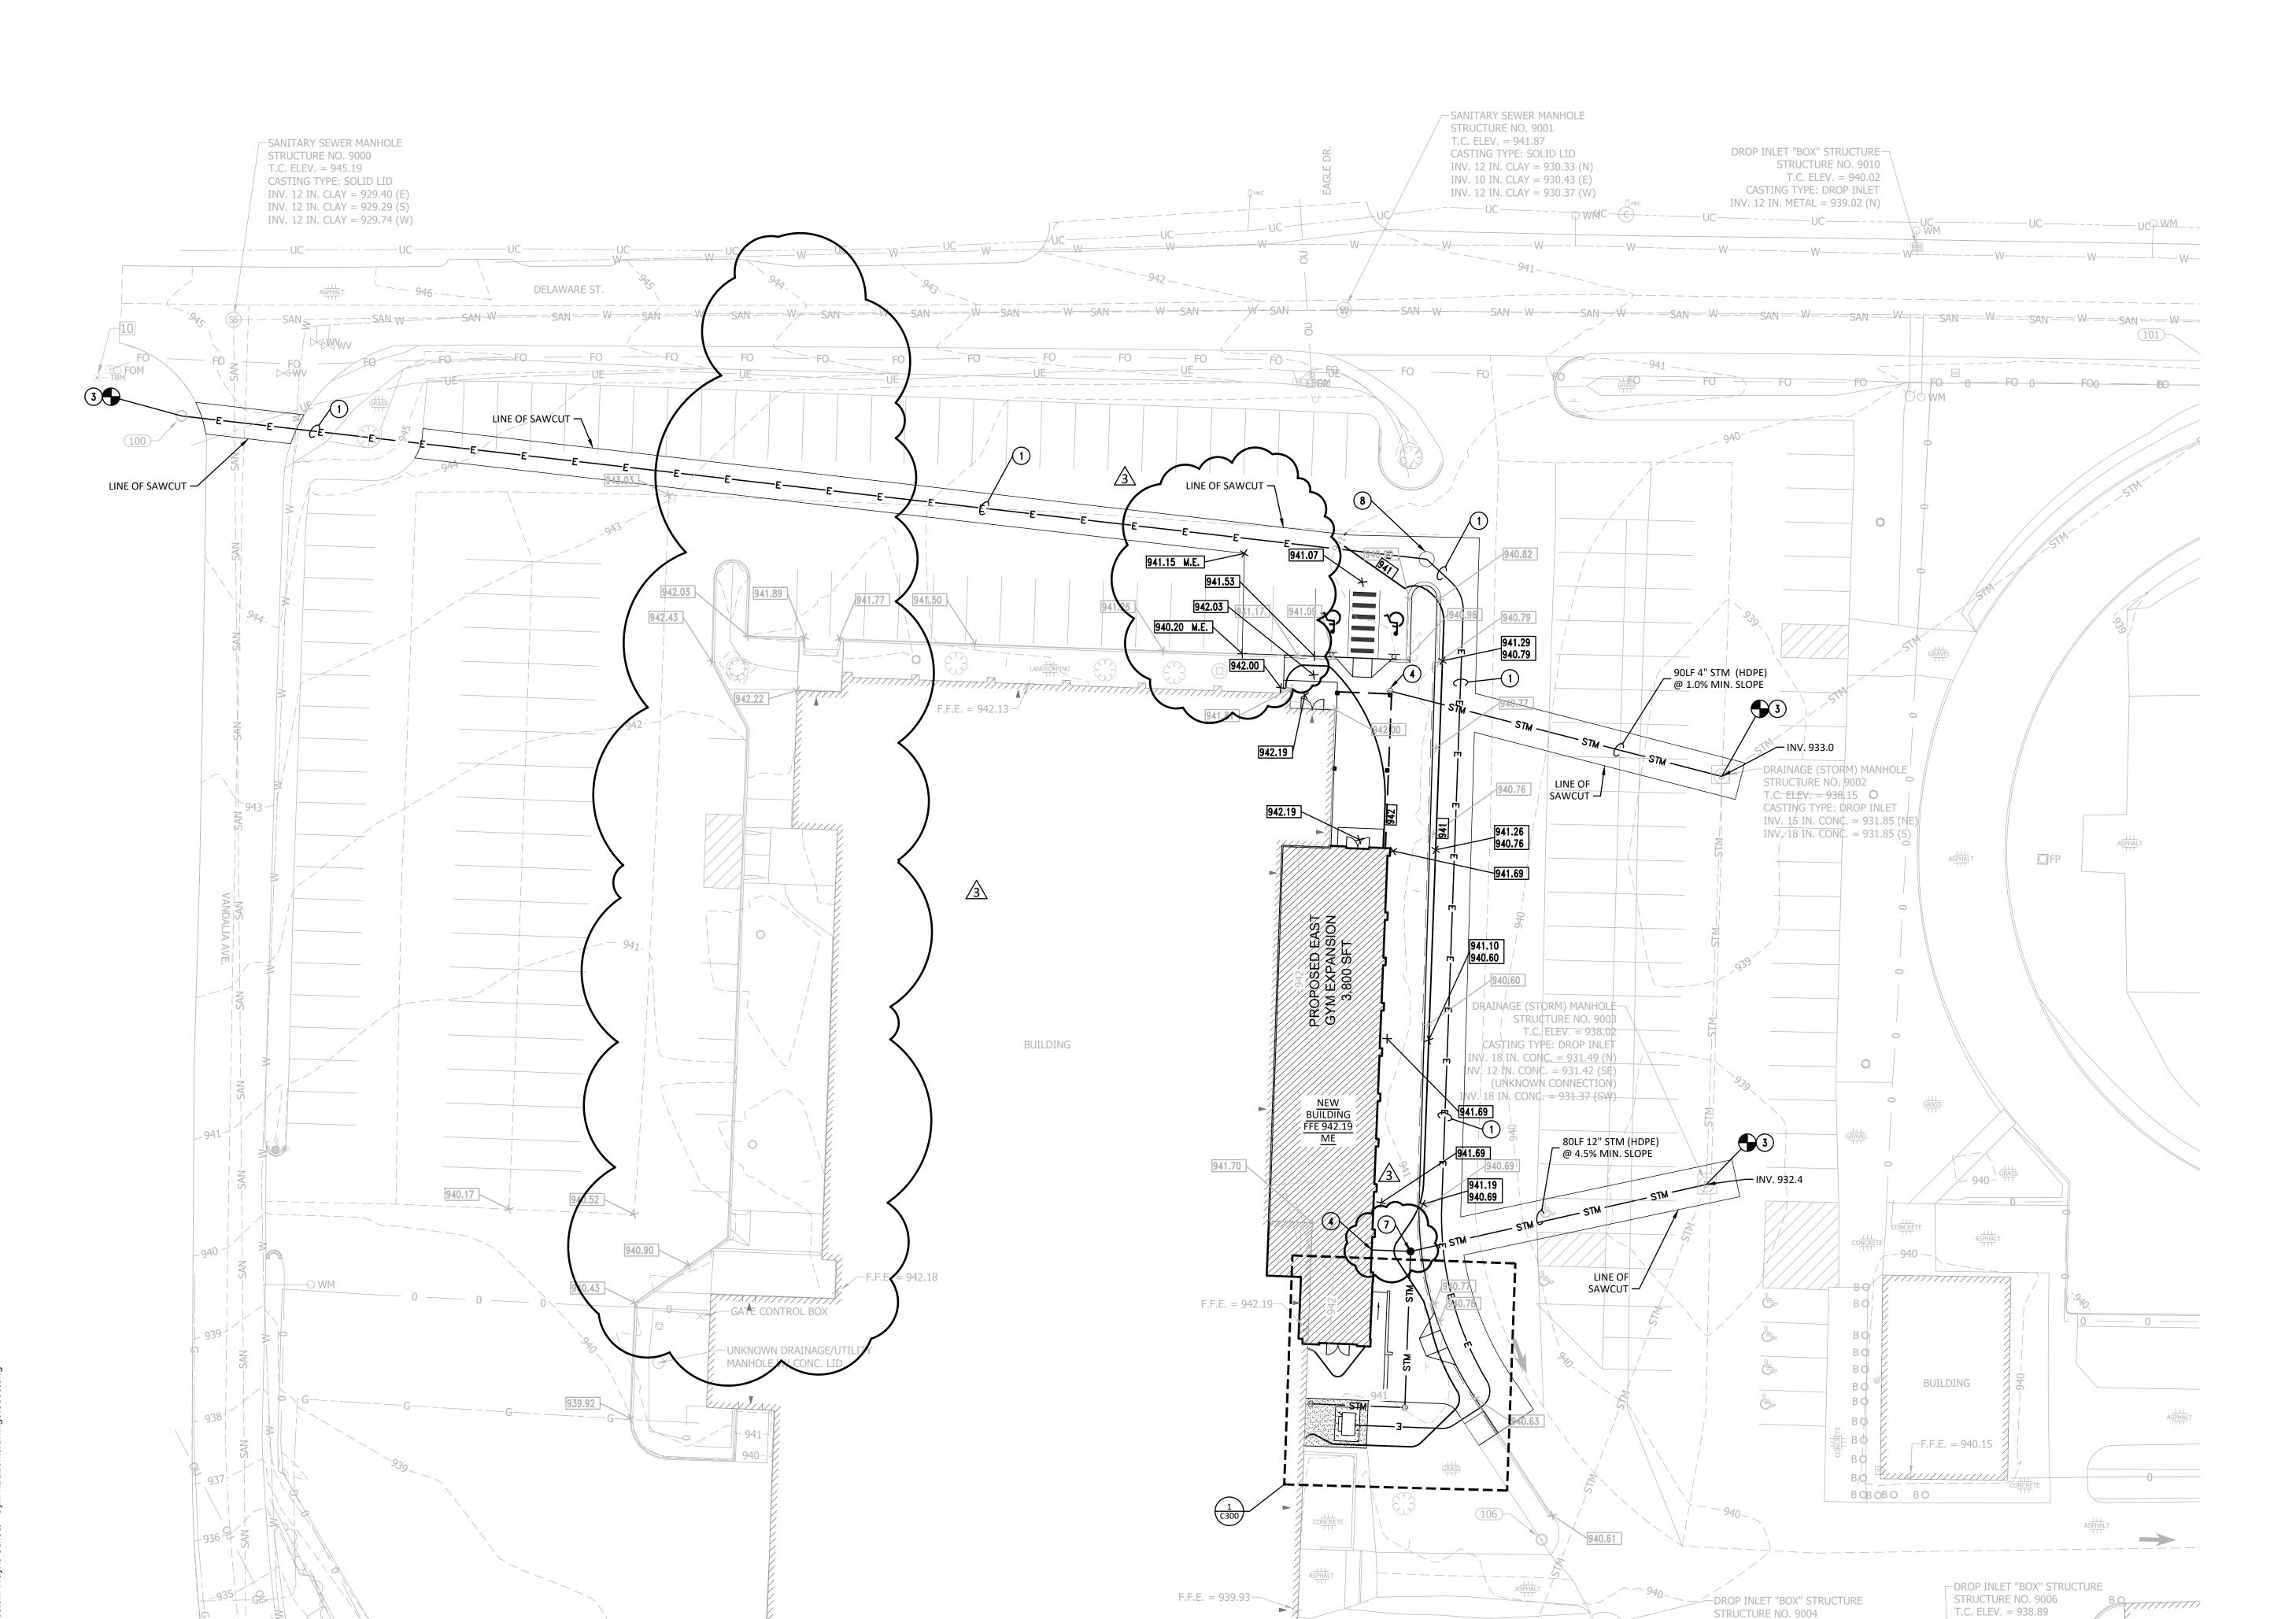

DROP INLET "BOX" STRUCTURE—

CASTING TYPE: BEEHIVE INLET INV. 8 IN. CPP = 935.97 (N)(UNKNOWN CONNECTION)

INV. 8 IN. CPP = 934.96 (E)

STRUCTURE NO. 9005

T.C. ELEV. = 939.46

BUILDING

CONCRETE


F.F.E. = 939.93

GENERAL NOTES


- A. THE CONTRACTOR SHALL BE RESPONSIBLE FOR OBTAINING, AND VERIFYING, THAT ALL PERMITS AND APPROVALS ARE OBTAINED FROM THE RESPECTIVE CITY, COUNTY, STATE AND FEDERAL AGENCIES PRIOR TO STARTING CONSTRUCTION.
- 3. CONTRACTOR SHALL VERIFY LOCATION AND INVERT ELEVATIONS OF EXISTING SEWERS PRIOR TO START OF CONSTRUCTION.
- C. CONTRACTOR SHALL MAINTAIN A COMPLETE AND OPERABLE UTILITY SYSTEM AT ALL TIMES. . CONTRACTOR SHALL INCLUDE COSTS FOR CUTTING AND PATCHING AS REQUIRED IN THEIR
- BID PROPOSAL TO COMPLETELY INSTALL THE WORK INDICATED. CONTRACTOR SHALL INCLUDE ALL TAP FEES, PERMIT FEES AND APPLICATION FEES IN THEIR BID PROPOSAL AS NECESSARY TO COMPLETELY INSTALL THE WORK INDICATED.
- INFORMATION SHOWN WAS OBTAINED FROM AN OWNER FURNISHED SITE SURVEY OF EXISTING CONDITIONS AND IS UNCONFIRMED. CONTRACTOR IS REQUIRED TO FIELD VERIFY THIS INFORMATION AND NOTIFY ARCHITECT OF ANY DISCREPANCIES SO MODIFICATION
- CONTRACTOR SHALL COORDINATE EXACT UTILITY LOCATIONS WITH THE OWNER AND LOCAL UTILITY COMPANIES PRIOR TO COMMENCING ANY WORK. UTILIZE THE INDIANA UNDERGROUND UTILITY LOCATION SERVICE AT 811 OR 800-382-5544 PRIOR TO ANY EXCAVATION ON THE SITE.
- . NEW STORM INLET REFER TO DETAIL. SOLID TOP CASTING, TYPE NEENAH R-1772. TOP OF CASTING 941.0: INVERT IN OF 8" PIPES AT 937.0: 12" STORM INVERT OUT OF STRUCTURE AT 936.0.

O PLAN NOTES

- 1. NEW ELECTRICAL LINE. REFER TO ELECTRICAL DRAWINGS FOR ADDITIONAL INFORMATION.
- 2. NEW TRANSFORMER. REFER TO ELECTRICAL DRAWINGS FOR ADDITIONAL INFORMATION.
- 3. CONTRACTOR TO FIELD VERIFY EXISTING STORM SEWER LOCATION, ELEVATION AND SIZE.
- 5. NEW EXTERIOR CLEANOUT.
- . WATER AND SEWER CROSSING, MINIMUM 18" CLEARANCE OR USE CONCRETE CRADLE. _____ NEW STORM INLET. REFER TO DETAIL. 8. NEW ELECTRICAL MANHOLE. REFER TO ELECTRICAL PLANS FOR MORE INFORMATION.

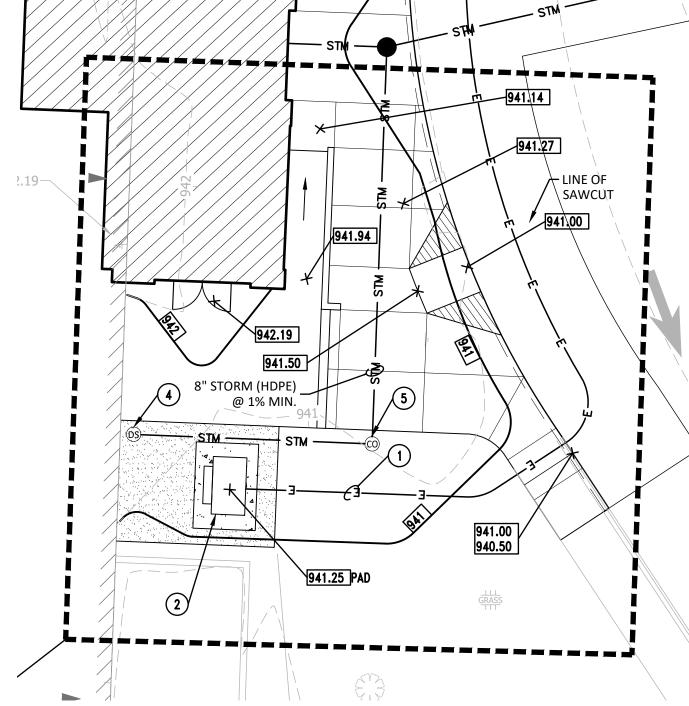



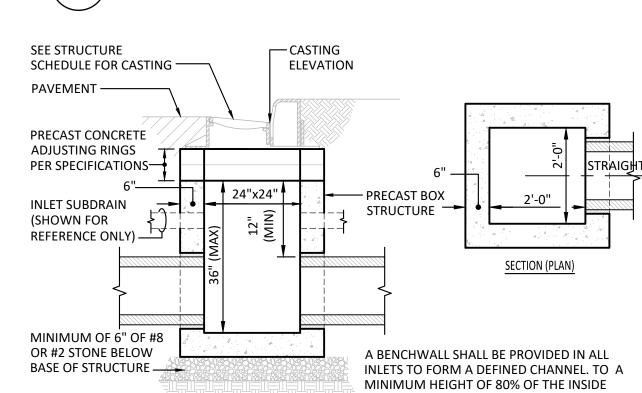

CASTING TYPE: DROP INLET

(UNKNOWN CONNECTION)

INV. CLAY = 934.14 (W)

T.C. ELEV. = 939.44

CASTING TYPE: BEEHIVE INLET

INV. 18 IN. CONC. = 929.94 (NE)

INV. 18 IN. CONC. = 929.94 (SW)

(UNKNOWN CONNECTION)

INV. 8 IN. CPP = 932.64 (W)


2 INLET BOX DETAIL (24"x24")
NO SCALE

gmb

Maze
Design, Inc.

Naze Jesign, Inc.

WESTERN WAYNE SCHOOLS

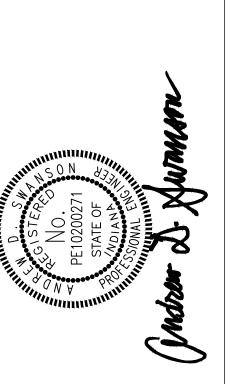

ISSUANCES

01.06.2025 BIDS & CONSTRUCTION

DRAWN CLM
REVIEWED ADS

PROJECT NO. 5-6394

NO PART OF THIS DRAWING MAY BE USED OR REPRODUCED IN ANY FORM OR BY ANY MEANS, OR STORED IN A DATABASE OR RETRIEVAL SYSTEM, WITHOUT PRIOR WRITTEN PERMISSION OF

GMB COPYRIGHT © 2025 ALL RIGHTS RESERVED

SITE UTILITY DETAILS

C3.02


PROJECT NO. 5-6394

NO PART OF THIS DRAWING MAY BE USED OR REPRODUCED IN ANY FORM OR BY ANY MEANS, OR STORED IN A DATABASE OR RETRIEVAL SYSTEM, WITHOUT PRIOR WRITTEN PERMISSION OF

PERMISSION OF


GMB COPYRIGHT © 2025
ALL RIGHTS RESERVED

STORMWATER POLLUTION PREVENTION PLAN

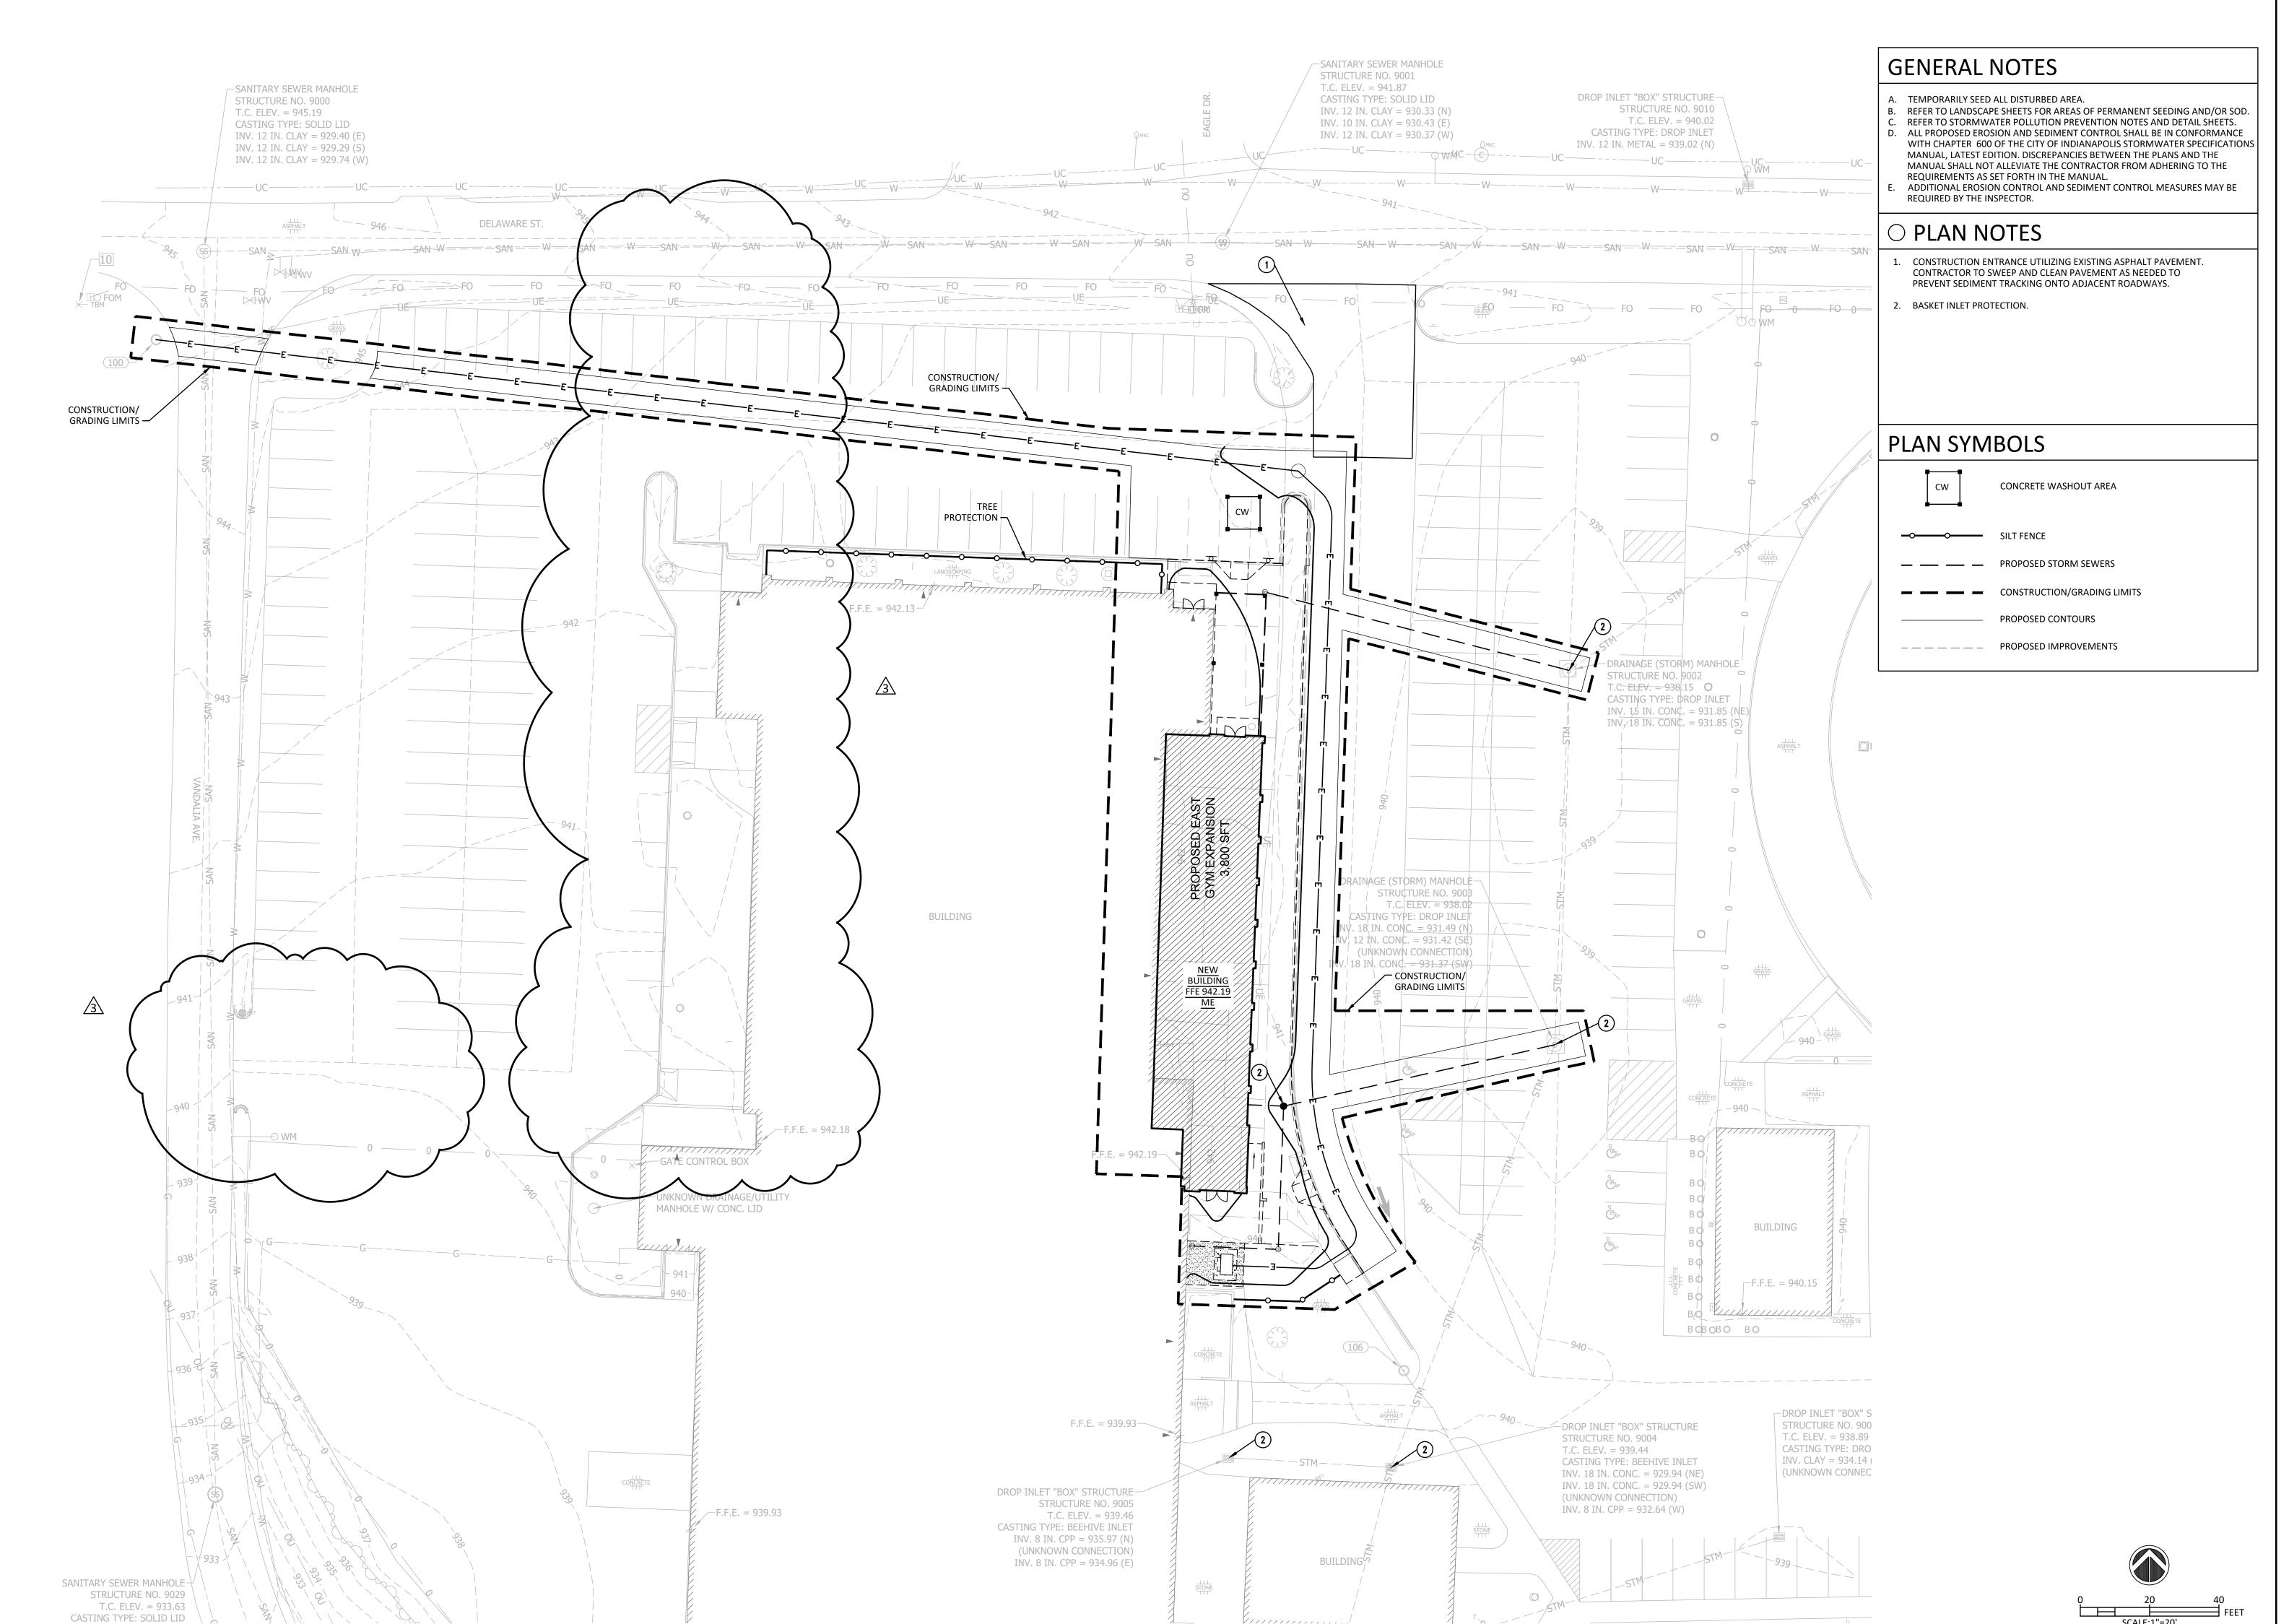

PERMISSION OF GMB COPYRIGHT © 2025 ALL RIGHTS RESERVED


stormwater pollution prevention details C7.02

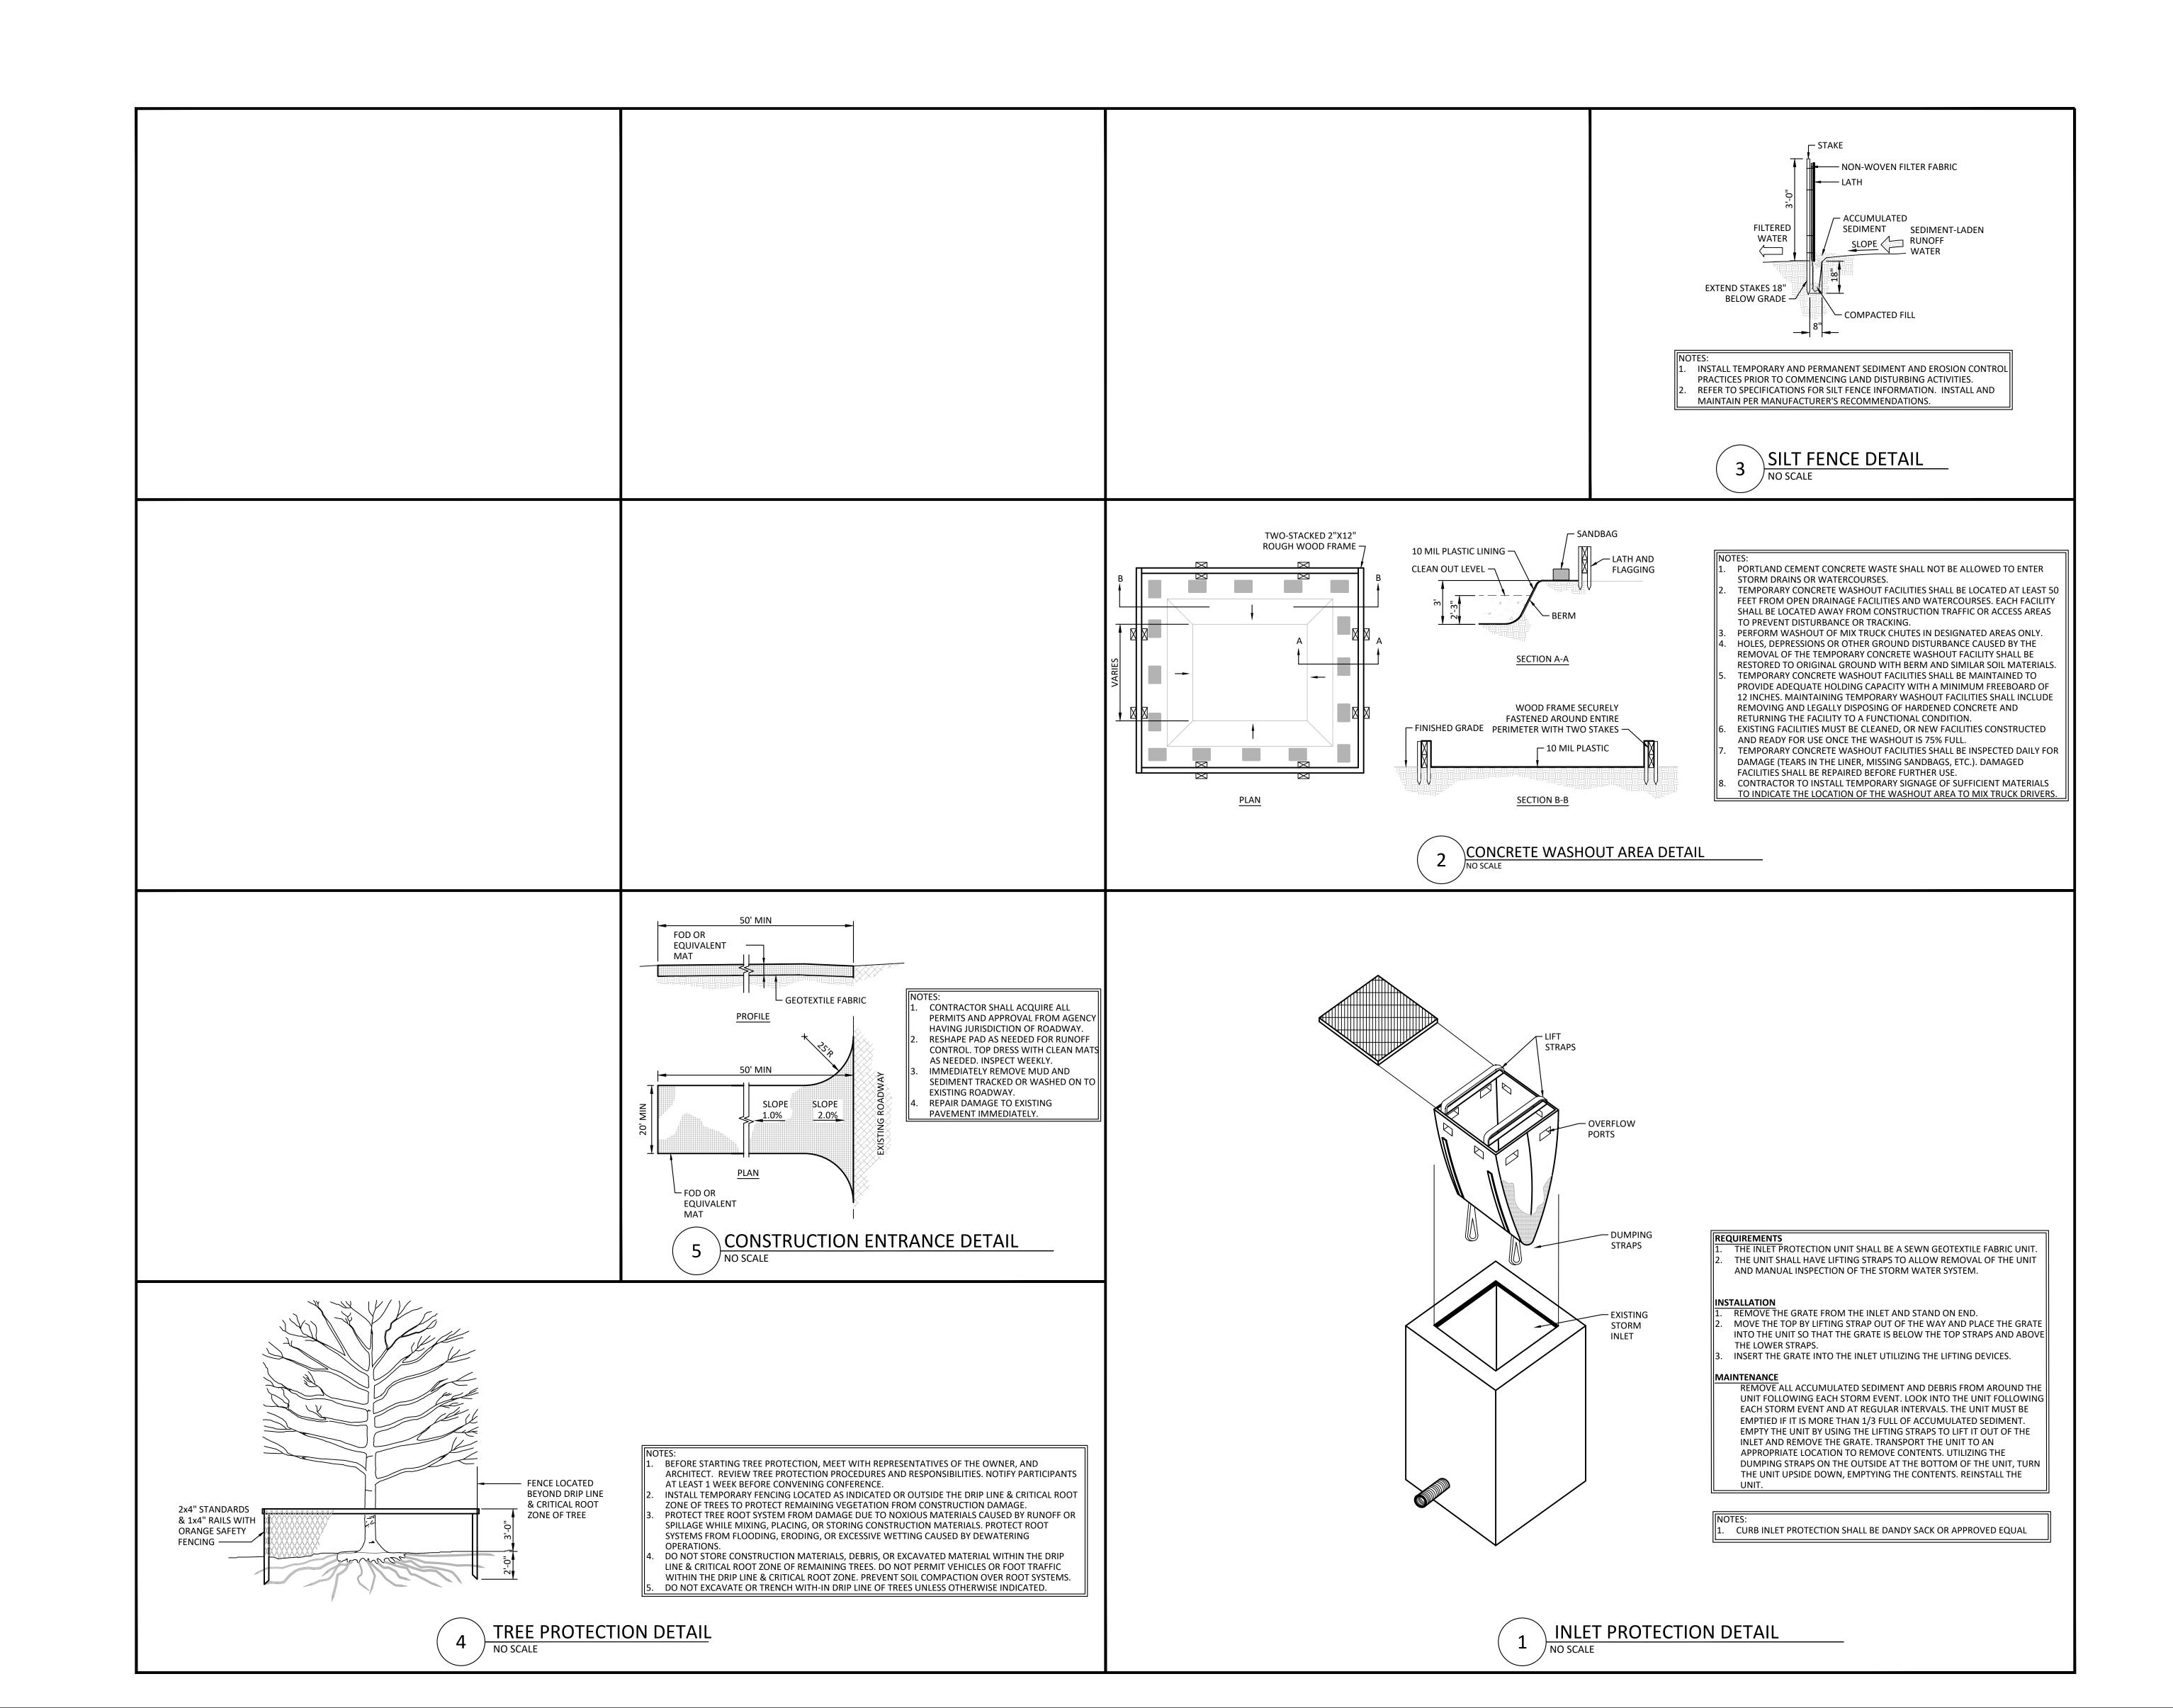


K:\Civil Projects\zuz4\z4JPSC86 Western Wayne School - Gym Addition\drawings\C 3/19/2025 12:27:15 PM


NO PART OF THIS DRAWING MAY BE USED OR REPRODUCED IN ANY FORM OR BY ANY MEANS, OR STORED IN A DATABASE OR RETRIEVAL SYSTEM, WITHOUT PRIOR WRITTEN PERMISSION OF GMB COPYRIGHT © 2025 ALL RIGHTS RESERVED

SITE DETAILS

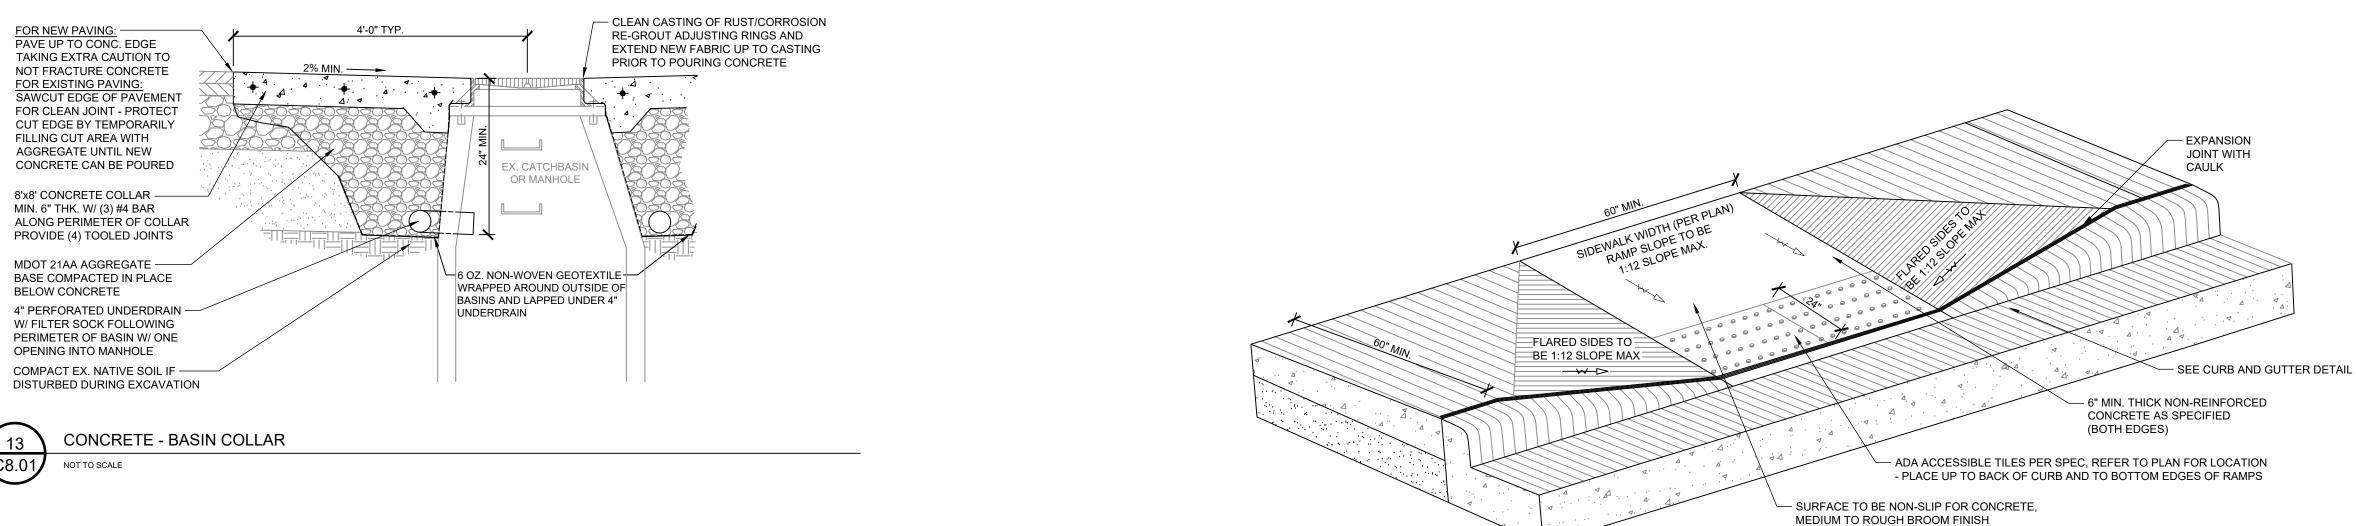


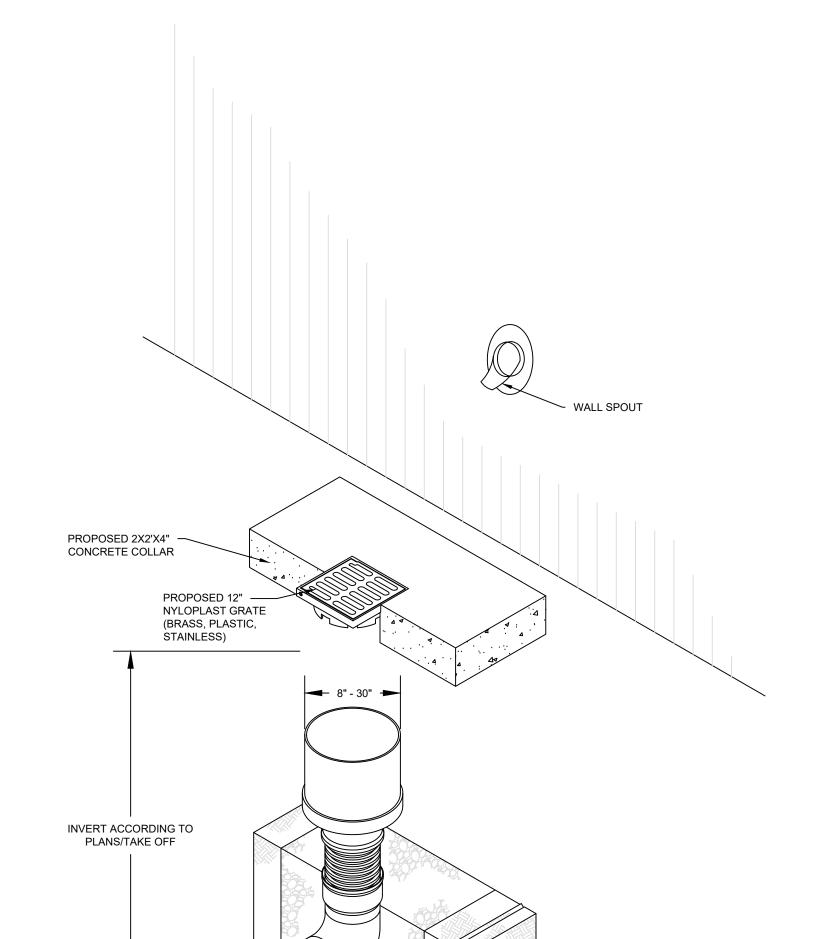

EVTEDNIAL DOOE OVEDELOW EXTERNAL ROOF OVERFLOW NYLOPLAST INLINE DRAIN WITH IRON GRATE

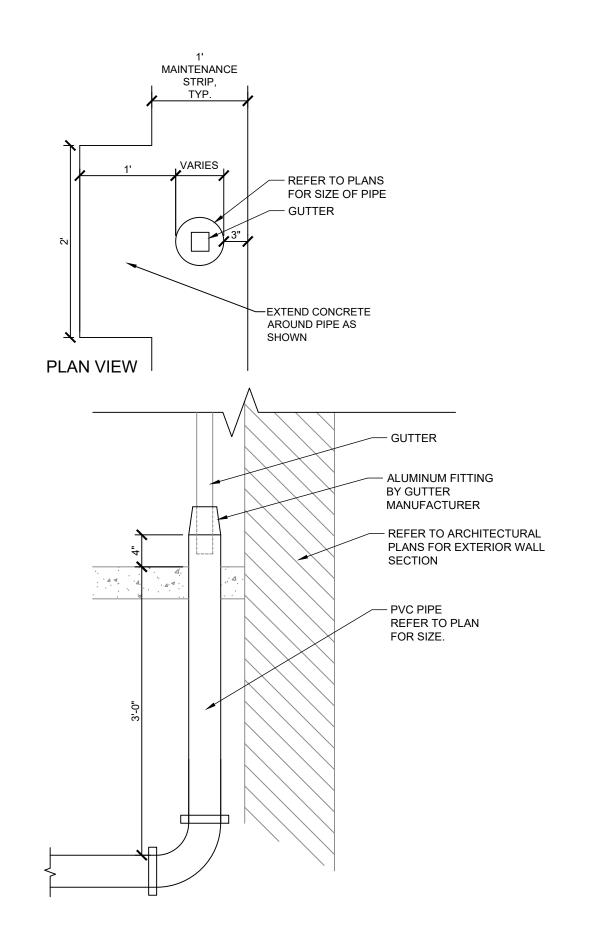



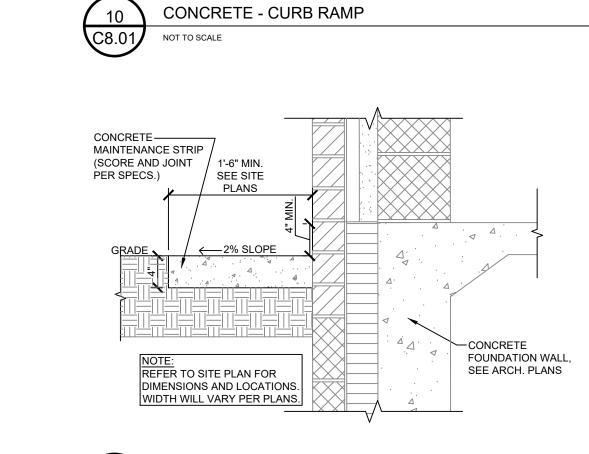





PLAN DIMENSIONS


TO FACE OF CURB


— COMPACT AGGREGATE BASE AT


EDGE OF TURNED DOWN SLAB

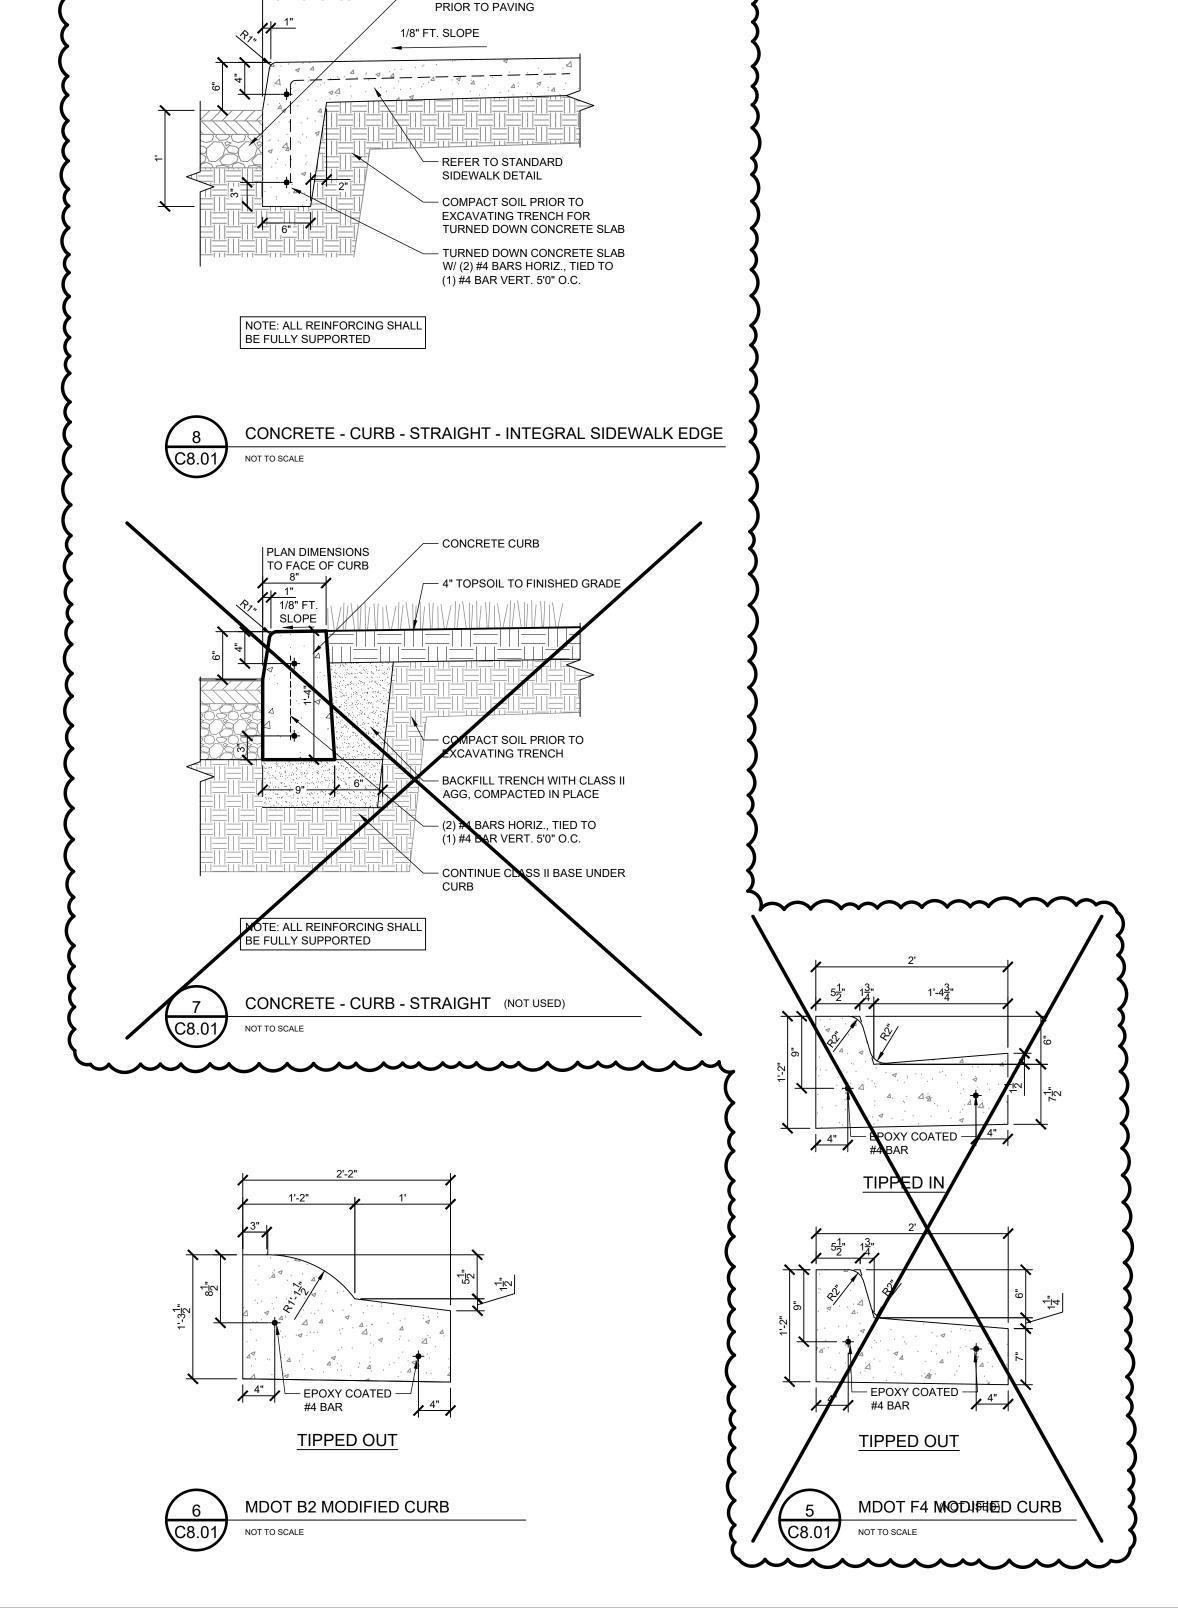


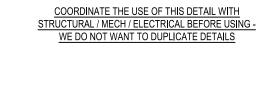

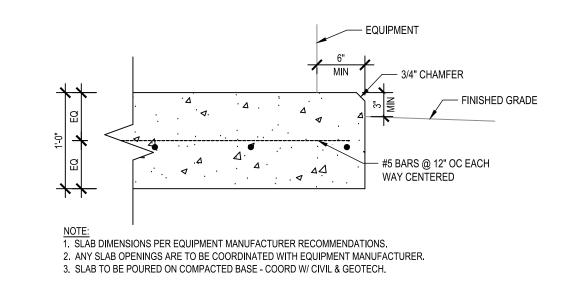

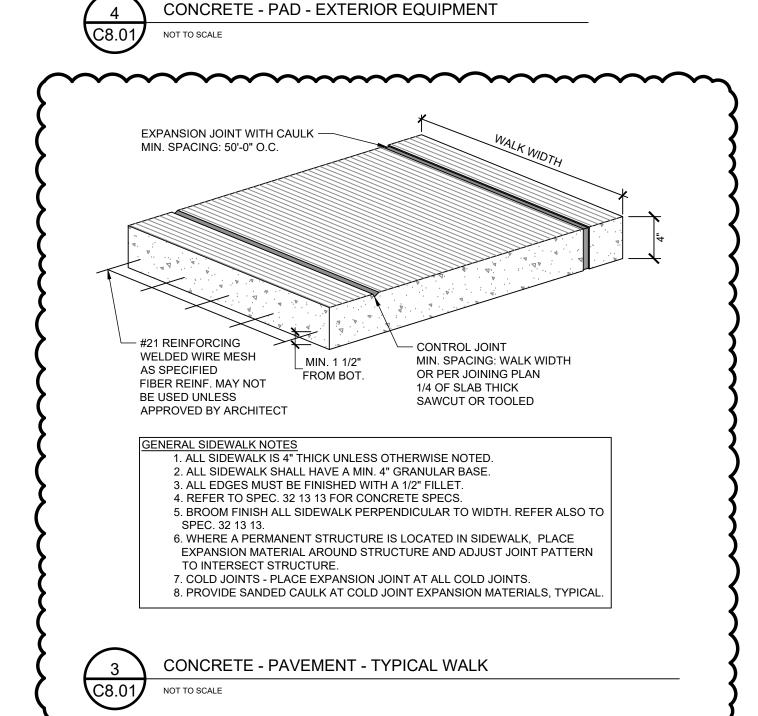

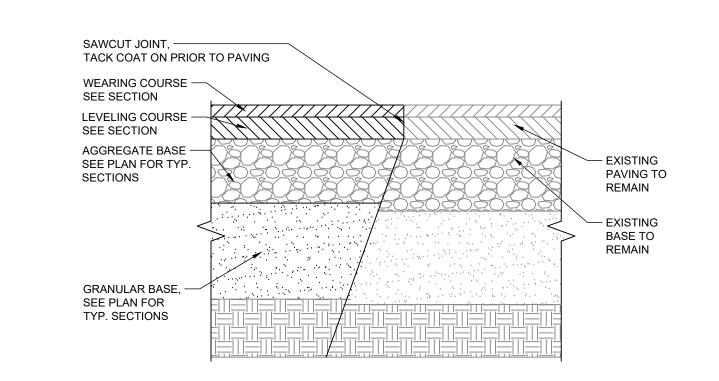

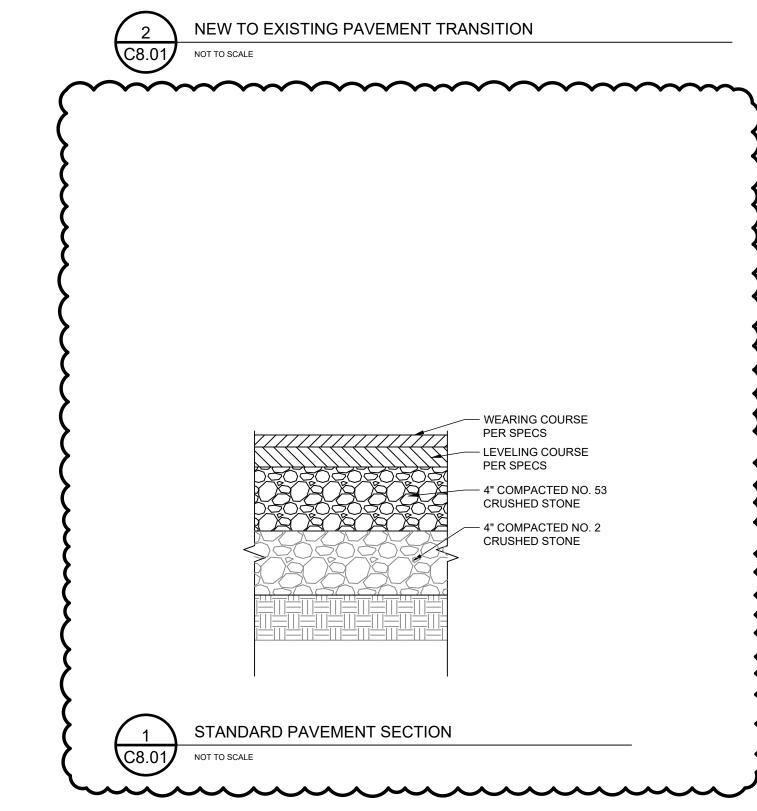

C8.01


PROJECT NO. NO PART OF THIS DRAWING MAY BE USED OR REPRODUCED IN ANY FORM OR BY ANY MEANS, OR STORED IN A DATABASE OR RETRIEVAL SYSTEM, WITHOUT PRIOR WRITTEN PERMISSION OF GMB COPYRIGHT © 2025

SITE DETAILS


ALL RIGHTS RESERVED

C8.02

Maze Design, Inc.

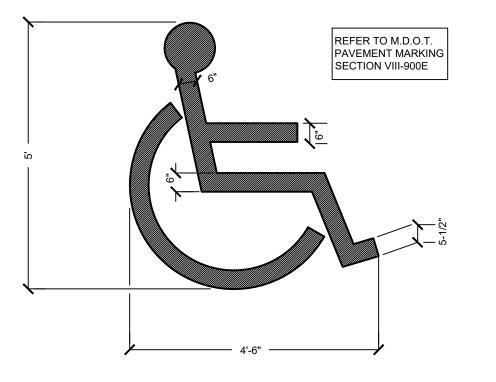




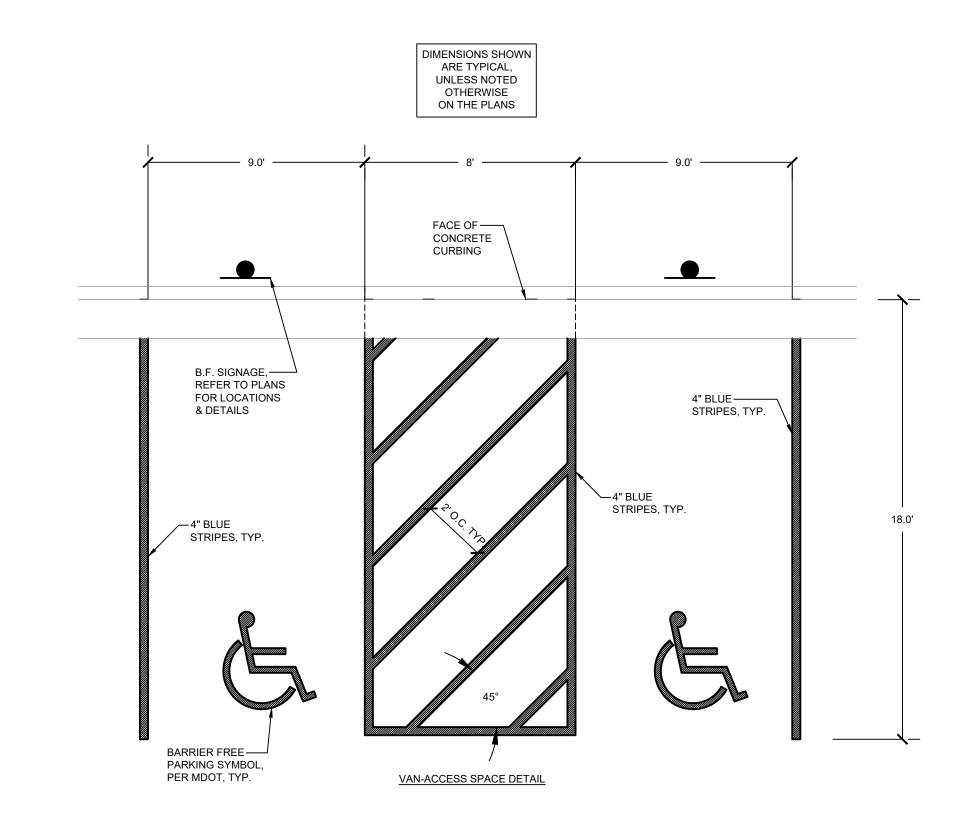



1 M1_STANDARD PARKING SPACE STRIPING

NOT TO SCALE

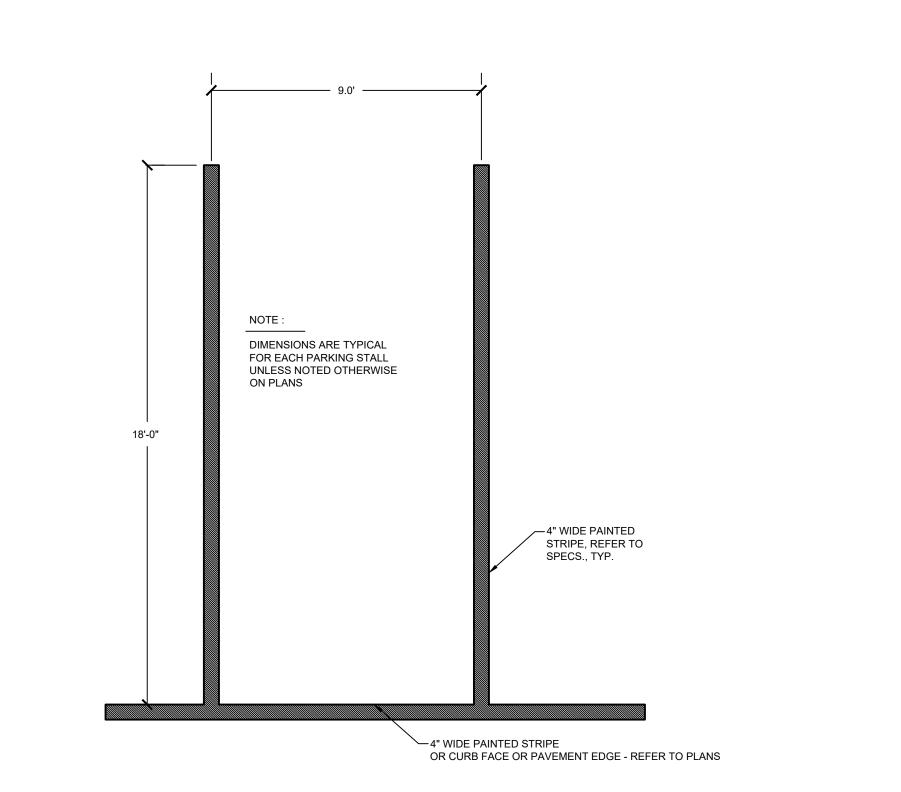



HANDICAPPED PARKING

VAN

HANDICAPPED PARKING

(VAN accessible

0.125" ALUMINUM PANEL WITH 2" RADIUS SAFETY CORNERS TO BE PAINTED TO MATCH POST

12"x18" ALUMINUM SIGN WITH

SEE PLAN FOR LOCATIONS. —12"x6" ALUMINUM SIGN WITH

2" SQUARE ALUMINUM TUBING WITH COAT PRIMER AND 2

COATS BLACK MATTE FINISH

USE BUSH CONCRETE BASE.
TYPICAL FOR SIGN LOCATIONS

IN PAVEMENT AREAS

BLUE FACE AND WHITE LETTERS.

BLUE FACE AND WHITE LETTERS. SEE PLAN FOR LOCATIONS.

BUSH CONCRETE PRODUCTS MUSKEGON, MI

─ 0.125" ALUMINUM PANEL WITH 2" RADIUS SAFETY CORNERS TO BE PAINTED TO MATCH POST

─12"x18" ALUMINUM SIGN WITH

—12"x6" ALUMINUM SIGN WITH

SEE PLAN FOR LOCATIONS.

─2" SQUARE ALUMINUM TUBING WITH COAT PRIMER AND 2

COATS BLACK MATTE FINISH

—12" DIA. CONCRETE FOUNDATION. TYPICAL FOR SIGN

LOCATIONS IN GRASS AREAS.

BLUE FACE AND WHITE LETTERS.

BLUE FACE AND WHITE LETTERS. SEE PLAN FOR LOCATIONS.

WALLS 35 psf SEISMIC DESIGN: SEISMIC IMPORTANCE FACTOR (Ie) SPECTRAL RESPONSE: SITE CLASS SEISMIC DESIGN CATEGORY SEISMIC FORCE RESISTING SYSTEM: COMBINATION OF ORDINARY REINFORCED MASONRY SHEAR WALLS AND STEEL MOMENT-RESISTING FRAMES MASONRY SHEAR WALL SEISMIC RESPONSE COEFFICIENT (Cs) STEEL MOMENT-FRAME SEISMIC RESPONSE COEFFICIENT (Cs) MASONRY SHEAR WALL RESPONSE MODIFICATION FACTOR (R)

STEEL MOMENT-FRAME RESPONSE MODIFICATION FACTOR (R)

21 psf

DESIGN BASE SHEAR: UNIT A = 258 KIPS 5. DESIGN SOIL BEARING CAPACITY (ASSUMED):

ANALYSIS PROCEDURE:

EQUIVALENT LATERAL FORCE

STRUCTURAL DESIGN DATA

GROUND SNOW LOAD (Pg)

FLAT ROOF SNOW LOAD (Pf)

FLAT ROOFS (BASED ON 20 SF)

UPLIFT INTERIOR

WALLS

UPLIFT WITHIN 16' OF CORNER

UPLIFT WITHIN 16' OF EDGE

COMPONENTS & CLADDING PRESSURE (ult):

UPLIFT WITHIN 16' OF CORNER

UPLIFT WITHIN 16' OF EDGE

FLAT ROOFS (BASED ON 20 SF)

UPLIFT INTERIOR

RISK CATEGORY

2. ROOF SNOW LOAD:


COLUMN FOOTINGS WALL FOOTINGS 2500 psf DESIGN STRESSES: CONCRETE FOOTINGS & FOUNDATIONS f'c = 4000 psi SLABS-ON-GRADE f'c = 4000 psi **ELEVATED SLABS & TOPPINGS** f'c = 4000 psi f'c = 5000 psi REINF. STEEL Fy = 60,000 psi STEEL W SHAPES Fy = 50,000 psiRECT HSS SHAPES $F_V = 50,000 \text{ psi}$ ROUND HSS & PIPE SHAPES Fv = 46.000 psiALL OTHER SHAPES Fy = 36,000 psi WELDING ELECTRODE Fy = 50,000 psi METAL DECK (FLOOR & ROOF) 2500 psi units f'm = 2200 psi GROUT f'c = 2200 psi

GENERAL STEEL FRAMING NOTES

1. SEE ARCHITECTURAL DRAWINGS FOR MISCELLANEOUS STEEL REQUIRED NOT LIMITED TO ANGLES, PLATES, CHANNELS, RAILINGS, 2. MASONRY CORES SHALL BE GROUTED FULL 3 COURSES DOWN MINIMUM BELOW ALL LINTEL, BEAM AND JOIST BEARING LOCATIONS ON BOTH NEW AND EXISTING MASONRY. POCKET WALL AS

3. ROOF DECK TO BE 1.5B 20 GA PAINTED - WELDED 36/4 PATTERN (12" OC) WITH (2) SIDE LAP FASTENERS PER SPAN UNLESS NOTED OTHERWISE. ALL CANOPY ROOF DECK TO BE GALVANIZED.

4. FURNISH & INSTALL 20 GA FLAT PLATE FILLERS & COVERS AT DECK EDGES AND AT TRANSITION LINES OF ORIENTATION CHANGES AS

5. FURNISH & INSTALL ALL JOIST BRIDGING & BRACING AS NOTED OR AS REQUIRED BY THE STEEL JOIST INSTITUTE (SJI).

6. PROVIDE FRAMES FOR ROOF SUMPS AND FOR ALL OTHER ROOF OPENINGS REQUIRED ON PLANS PER TYPICAL ROOF FRAME DETAILS.

7. STEEL MEMBERS EXPOSED TO EXTERIOR CONDITIONS (INCLUDING LINTELS) REQUIRE GALVANIZING. ALL CANOPY STEEL TO BE GALVANIZED EVEN WHERE NOT LEFT EXPOSED TO VIEW.

ANY MECHANICAL LOADS AS INDICATED ON PLANS.

10. ALL COLUMN, BASE PLATE, AND ANCHOR BOLTS BELOW GRADE MUST BE ENCASED IN CONCRETE OR COATED W/ BITUMINOUS MATERIAL.

RUNS PARALLEL TO THE CMU WALLS SUPPORTING IT.

12. COORDINATE AND FIELD VERIFY ALL MECHANICAL EQUIPMENT & OPENING LOCATIONS & SIZES FOR SUPPORTS & FRAMES. 13. UNO ON PLANS, BEAMS OR JOISTS ARE EQUALLY SPACED BETWEEN

COLUMNS OR ALONG GIRDERS. 14. IT IS THE FABRICATOR'S RESPONSIBILITY TO DESIGN AND DETAIL ALL MOMENT CONNECTIONS IN ACCORDANCE WITH CURRENT AISC STANDARDS AND SPECIFICATIONS BASED ON THE LOADS PROVIDED. SHOP DRAWINGS (THAT INDICATE ALL CONNECTION REQUIREMENTS) AND CALCULATIONS SHALL BE SEALED BY A REGISTERED ENGINEER

15. IT IS THE FABRICATOR'S RESPONSIBILITY TO DESIGN AND DETAIL ALL STEEL BEAM SPLICES (WHETHER INDICATED IN DRAWINGS OR PROVIDED FOR ERECTION REASONS) IN ACCORDANCE WITH CURRENT AISC STANDARDS AND SPECIFICATIONS BASED ON THE LOADS PROVIDED. SHOP DRAWINGS AND CALCULATIONS SHALL BE SEALED BY A REGISTERED ENGINEER IN THE STATE OF MICHIGAN AND SUBMITTED FOR REVIEW. SEE SPEC FOR ADDITIONAL INFO.

ISSUANCES 01.06.2025 BIDS &

DRAWN SFG

CONSTRUCTION

0

C

REVIEWED AND 5-6394 PROJECT NO. NO PART OF THIS DRAWING MAY BE USED OR REPRODUCED IN ANY FORM OR BY ANY MEANS, OR STORED IN A DATA BASE OR RETRIEVAL SYSTEM, WITHOUT PRIOR WRITTEN PERMISSION OF

STRUCTURAL GENERAL INFORMATION

GMB COPYRIGHT © 2025 ALL RIGHTS RESERVED

ABBREVIATIONS A/E ARCHITECT / ENGINEER HORIZ HORIZONTAL HEIGHT AFF ABOVE FINISHED FLOOR INSIDE DIAMETER INSIDE FACE AESS ARCHITECTURALLY EXPOSED INT INTERIOR LLH LONG LEG HORIZONTAL STRUCTURAL STEEL LONG LEG VERTICAL LONG WAY BFF BELOW FINISHED FLOOR MAX MAXIMUM MBC MICHIGAN BUILDING CODE MFR MANUFACTURER MIN MINIMUM MISC MISCELLANEOUS NOT IN CONTRACT NOM NOMINAL NTS NOT TO SCALE

BLDG BUILDING BLW BELOW BEARING PLATE CENTER-TO-CENTER CANT CANTILEVER CBP COLUMN BASE PLATE CAST-IN-PLACE CONTROL JOINT CJP COMPLETE JOINT ON CENTER PENETRATION WELD OUTSIDE DIAMETER CENTERLINE OUTSIDE FACE CEILING OPP OPPOSITE HAND CLR CLEAR COL COLUMN PAR PARALLEL PEMB PRE-ENGINEERED CONC CONCRETE CONN CONNECTION METAL BUILDING PERP PERPENDICULAR CONT CONTINUOUS PLATE COORD COORDINATE DECK ANGLE DBE DECK BEARING ELEVATION DIAMETER DIMENSION DECK PLATE EACH FACE

ABV ABOVE

ALT ALTERNATE

ARCH ARCHITECT

B.O. BOTTOM OF

REQ'D REQUIRED REINF REINFORCE RD ROOF DRAIN RXN REACTION SLIP CRITICAL STEP FOOTING SIMILAR SOG SLAB ON GRADE ENGINEER OF RECORD SPEC SPECIFICATION STANDARD STEEL SHORT WAY TOP OF TOP AND BOTTOM UNO UNLESS NOTED

VERT VERTICAL VIF VERIFY IN FIELD WITH W/O WITHOUT WWF WELDED WIRE FABRIC HD HOLD DOWN ANCHOR

MASONRY NOTES

ELEVATION

EACH SIDE

EACH WAY

EXISTING

EXPANSION

EXTERIOR

FLOOR DRAIN

FOUNDATION

FINISH FLOOR

FLOOR

FTG FOOTING

GALV GALVANIZED

GYP GYPSUM BOARD

GA GAUGE

FOUNDATION AND EXTEND INTO THE CONTINUOUS BOND BEAM AT

BLOCK CORE, IT SHALL NOT BE SLOPED MORE THAN ONE CELL ADJACENT TO THE VERTICAL WALL REINFORCING.

4. CONTROL JOINTS SHALL BE LOCATED AT 24'-0" OC MAX. SEE S0.02 FOR ADDITIONAL DETAILS. 5. ALL BAR LAPS TO BE PER "MINIMUM MASONRY REINFORCEMENT LAP LENGTH" SCHEDULE.

VIBRATION WITHIN CORES. 7. 16" CMU MASONRY WALL MUST BE SINGLE WYTHE NOT (2) 8" WYTHES.

9. CELL FOAM FILL ALL BLOCK WALLS AT TOILET ROOMS DIRECTLY ADJACENT TO CLASSROOMS. SEE ARCHITECTURE FOR REQUIREMENTS.

11. ALL TEMPORARY BRACING DURING CONSTRUCTION AS REQUIRED BY THE GOVERNING BUILDING CODE FOR LATERAL LOADING IS THE

13. LINTELS AT NON LOAD BEARING WALL OPENINGS ARE NOT SHOWN ON PLAN. CONTRACTOR TO COORDINATE OPENING LOCATIONS WITH

ARCHITECTURAL AND MECHANICAL DRAWINGS. PROVIDE LINTELS

MINIMUM BELOW ALL LINTEL, BEAM AND JOIST BEARING LOCATIONS ON BOTH NEW AND EXISTING MASONRY POCKET WALL AS

1. VERTICAL REINFORCING BARS SHALL HAVE DOWELS INTO THE

THE TOP OF THE WALL. 2. WHEN A FOUNDATION DOWEL DOES NOT LINE UP WITH A VERTICAL HORIZONTAL IN SIX VERTICAL. DOWELS MAY BE GROUTED INTO A

3. CONTINUOUS BOND BEAMS TO HAVE (2) #5 BARS IN 8" WALLS & (3) #5 BARS IN 12" WALLS, TYP.

6. CORES WITH VERTICAL REINFORCING SHALL BE GROUTED SOLID FOR FULL HEIGHT OF WALL. ALL GROUT SHALL BE CONSOLIDATED BY

8. FULL HEIGHT VERTICAL REINFORCING SHALL BE REQUIRED ON BOTH SIDES OF ALL BEARING WALL OPENINGS.

10. ALL CORNERS & INTERSECTIONS (INTERIOR, EXTERIOR, BEARING & NON-BEARING WALLS) TO HAVE RIGID ANCHORS CONNECTING THE WALLS AT 32" OC VERTICALLY UNLESS MASONRY BLOCK IS TOOTHED TOGETHER A MINIMUM OF 4".

RESPONSIBILITY OF THE CONTRACTOR. 12. LINTELS SHALL OCCUR AT ALL OPENINGS GREATER THAN 2'-0".

PER THE NON LOAD BEARING LINTEL SCHEDULE. 14. MASONRY CORES SHALL BE GROUTED FULL 3 COURSES DOWN NECESSARY, GROUT, AND PATCH WALL TO MATCH ADJACENT

FRAMING LEGEND

U8 / L1 DENOTES LINTEL TYPE (SEE SCHEDULE) DENOTES BEARING PLATE TYPE (SEE SCHEDULE)

CBP1 DENOTES COLUMN BASE PLATE TYPE (SEE SCHEDULE) W16x36 (S) DENOTES BEAM WITH STUDS ON TOP FLANGE (MINIMUM 3/4" DIA.)

TOS DENOTES TOP OF STEEL ELEVATION DENOTES BOTTOM OF STEEL ELEVATION DENOTES BOTTOM OF DECK ELEVATION MOMENT CONNECTION

EOD EDGE OF DECK TOP CHORD EXTENSION

BCX BOTTOM CHORD EXTENSION

ST. SLOPE DENOTES STRUCTURE SLOPES DOWN EX W16x36 THE "EX" DENOTES EXISTING STEEL TO REMAIN

(ALL OTHER MEMBERS NOT NOTED WITH AN "EX." SHALL BE NEW & FURNISHED AS PART OF THIS CONTRACT)

VIF VERIFY IN FIELD T-1 DENOTES ENGINEERED WOOD TRUSS TYPE (SEE SCHEDULE)

FOUNDATION LEGEND

TOW DENOTES TOP OF WALL ELEVATION TOP DENOTES TOP OF PIER ELEVATION DENOTES TOP OF LEDGE ELEVATION

TOF DENOTES TOP OF FOOTING ELEVATION DENOTES TOP OF SLAB / FINISH FLOOR ELEVATION

STEP FOOTING (SEE TYP DETAIL) F3x3 (96'-0") FOOTING MARK (TOF ELEV) -

P2 (99'-4") PIER MARK (TOP ELEV) SEE SCHEDULE FOR SIZE & REINFORCING CONCRETE FOUNDATION WALL & FOOTING ====

MASONRY WALL & CONCRETE FOOTING

SEE SCHEDULE FOR SIZE & REINFORCING

METAL DECK ATTACHMENT

USE THE FOLLOWING GUIDELINES FOR SECURING THE METAL ROOF DECK TO ITS SUPPORTING STRUCTURE.

1. ALL 1.5 B DECK - USE 5/8" PUDDLE WELDS ON 36/4 PATTERN WITH #10 SCREW SIDELAP FASTENERS MINIMUM 2 PER SPAN, OR USE HILTI FASTENERS PER 05 31 00 ON 36/4 PATTERN WITH #10 SCREW SIDELAP FASTENERS MIN. 2 PER SPAN EXCEPT AT AUDITORIUM AND STAGE ROOF USE 36/7 PATTERN WITH SIDELAP FASTENERS AT 24" OC.

FLOOR & ROOF LEGEND

1 1/2" WIDE RIB DECK - ## INDICATES GAUGE

_____1.5BA## 1 1/2" WID RIB ACOUSTICAL DECK - ## INDICATES GAUGE

GENERAL FOUNDATION NOTES

1. PLAN ELEVATION 100'-0" = SITE DATUM PER CIVIL 2. FOUNDATIONS WILL BE PLACED IN BOTH THE NATIVE SOIL AND NEW SAND FILL. PRIOR TO PLACING CONCRETE THE BEARING SURFACE SHALL BE COMPACTED TO A DENSITY OF 95.0 PERCENT OF ITS SOILS REPORT FOUND IN THE SPECIFICATIONS FOR ADDITIONAL

MAXIMUM DENSITY AS DETERMINED BY ASTM D1557. REFERENCE THE RECOMMENDATIONS. 3. ON SITE EXCAVATED SOILS MAY BE USED FOR BACKFILLING OF FOUNDATIONS EXCEPT AT RETAINING WALLS WHERE CLEAN SAND MEETING MOOT CLASS II STANDARDS SHALL BE USED. THE WATER CONTENT OF ALL CLAY MATERIALS BEING PLACED SHALL BE 15.0

PERCENT OR LESS. FOLLOW THE RECOMMENDED INSTALLATION AND COMPACTION PROCEDURES FOR FILL AS OUTLINED IN THE SPECIFICATIONS AND SOILS REPORT. 4. STEP FOOTINGS AT A MINIMUM 3 UNITS HORIZONTAL TO ONE (1) UNIT

VERTICAL, WITH MAXIMUM 24" VERTICAL STEP. SEE TYP STEPPED FOOTING DETAIL.

5. LAP CONTINUOUS REINFORCING PER SCHEDULE. PROVIDE CORNER

BARS FOR HORIZONTAL REINFORCING OF SAME SIZE. 6. SET FOUNDATION SLEEVES ON TOP OF FOOTING UNLESS NOTED

7. INSTALL UNDERGROUND DRAINAGE AROUND PERIMETER FOUNDATIONS AS SHOWN IN TYPICAL FOUNDATION DRAIN DETAIL. PROVIDE POSITIVE

DRAINAGE OUTLET TO SITE STORM SYSTEM. 8. ON SITE WITH CLAY SOIL CONDITIONS, PROVIDE PVC WEEP HOLE SLEEVES THRU BOTTOM OF FOUNDATION WALL AT APPROXIMATELY 50 FOOT CENTERS TO DRAIN INTERIOR FILL.

9. CONTRACTOR SHALL REFER TO ARCHITECTURAL, MECHANICAL, PLUMBING AND ELECTRICAL DRAWINGS FOR LOCATIONS OF OPENINGS, EQUIPMENT PADS, EMBEDDED ITEMS, RECESSES, DRAINS, PIPE SLEEVES, ELECTRICAL CONDUITS, ETC BEFORE POURING CONCRETE. CONTRACTOR SHALL BE AWARE AND VERIFY THE LOCATIONS OF ALL UNDERGROUND TANKS, UTILITIES, ETC. DO NOT DAMAGE EXISTING UTILITIES DURING EXCAVATION.

10. REFER TO FOUNDATION PLANS FOR LOCATED FOOTING STEPS. FIELD CONDITIONS, PENETRATIONS OR OTHER EQUIPMENT MAY DICTATE FURTHER FOOTING STEPS. CONTRACTOR SHALL REFER TO MECHANICAL, PLUMBING, AND CIVIL DRAWINGS FOR UTILITY LOCATIONS AND LOCATE OTHER STEPPED FOOTINGS AS REQUIRED.

GENERAL SLAB NOTES

1. FLOOR SLABS ON GRADE SHALL BE MINIMUM 4" THICK CONCRETE WITH SYNTHETIC FIBER REINFORCEMENT PER SPECIFICATIONS. SLABS AT RADIANT FLOORS, AT GYMNASIUM, THE COMMONS AREAS, AND STAGE SHALL BE MINIMUM 5" THICK. SEE PLANS FOR WHERE WWF IS

2. ALL FLOOR SLABS ON GRADE SHALL BE PLACED ON 10 MIL VAPOR BARRIER OVER MINIMUM 8" COMPACTED CLEAN SAND FILL MEETING MDOT CLASS IT STANDARDS PLACED ON COMPACTED SUITABLE SUB

GRADE (UNO IN GEOTECHNICAL REPORT FOR THE SPECIFIC PROJECT). 3. INSTALL CONSTRUCTION AND/OR CONTROL JOINTS FOR SLABS ON GRADE ON A MAXIMUM "3 X THICKNESS" SQUARE GRID (EG - 12'-0" FOR 4" SLAB) OR AS SHOWN ON THE FLOOR FINISH PLANS. REFERENCE TYP CONSTRUCTION AND CONTROL JOINT DETAILS. FLOOR SLABS AT GYMNASIUM, WEIGHT ROOM, AND STAGE SHALL BE MONOLITHIC POURS

4. SLAB EDGE DETAIL: PROVIDE BOND BREAKER AT ALL SLAB TO WALL LOCATIONS. SEE SPECIFICATION.

FOUNDATION ELEVATIONS

WITHOUT ANY JOINTS.

(UNLESS OTHERWISE NOTED ON PLANS) TOP OF FOUNDATION WALLS = EL 102' - 5 7/8" TOP OF CONCRETE PIERS = EL 101' - 9 7/8" TOP OF EXTERIOR FOOTINGS = EL 98' - 9 7/8"

TOP OF INTERIOR FOOTINGS = EL 101' - 9 7/8"

GENERAL STRUCTURAL NOTES

1. FIELD VERIFY ALL EXISTING CONDITIONS AND DIMENSIONS PRIOR TO FABRICATION AND INSTALLATION, AND WITH THE ARCHITECT'S APPROVAL MAKE ANY AND ALL NECESSARY MODIFICATIONS TO ENSURE A PROPER FIT.

TRADES AND WITH THE REQUIREMENTS FOUND IN THE

2. COORDINATE ALL WORK INCLUDING DEMOLITION WITH ALL OTHER

CONSTRUCTION DOCUMENTS. 3. THE EXISTING STRUCTURAL PLANS ARE DIAGRAMMATIC AND ARE

BASED ON EXISTING OWNER DOCUMENTS AND LIMITED FIELD

INVESTIGATION, VARYING & HIDDEN CONDITIONS MAY EXIST. IF

DISCREPANCIES ARE FOUND, NOTIFY THE ARCHITECT & ENGINEER

FOR DIRECTION / RESOLUTION BEFORE CONTINUING WORK IN THOSE

NECESSARY, GROUT, AND PATCH WALL TO MATCH ADJACENT

8. DESIGN JOISTS FOR A NET WIND UPLIFT FORCE OF 25 PSF AND FOR

9. DESIGN JOIST SEATS FOR A MINIMUM ROLLOVER FORCE OF 2000 LBS.

11. PROVIDE BEARING PLATE WITH SLOTTED HOLES PER LINTEL SCHEDULE AT ONE END OF ALL STEEL BEAMS WHERE THE BEAM

IN THE STATE OF MICHIGAN AND SUBMITTED FOR REVIEW.

16. UNO, DESIGN FOR MIN 10K SHEAR REACTION

FOOTING SCHEDULE

30" CONT. 12" (2) #5 BARS CONT

36" CONT. 12" (3) #5 BARS CONT

3'-0" 3'-0" 12" (3) #5 BARS EACH WAY

4'-0" 4'-0" 14" (5) #5 BARS EACH WAY

4'-0" 6'-0" 16" (3) #3 BANS LONG WAY

6'-0" 6'-0" 16" (7) #6 BARS EACH WAY

UNLESS NOTED OTHERWISE, SEE TYPICAL WALL FOOTING AND TYPICAL COLUMN FOOTING DETAILS FOR ADDITIONAL INFORMATION. THICKENED SLAB REQUIRED UNDER ALL NEW NON-BEARING CMU WALLS (8" OR LARGER BLOCK).

PIER SCHEDULE

P1 | 18" | 18" | VARIES | A | (4) #6 BARS VERTICAL & #3 TIES

P2 22" VARIES A (4) #7 BARS VERTICAL & #3 TIES

P3 24" 24" VARIES A (4) #8 BARS VERTICAL & #3 TIES

P6 24" 48" VARIES C (8) #8 BARS VERTICAL & #3 TIES

TIES PER SCHEDULE

(TOP 3 @ 2" OC)

PER SCHEDULE

TIES PER SCHEDULE

(TOP 3 @ 2" OC)

(2) #5 BARS CONTINUOUS (SEE TYP THICKENED SLAB DETAIL)

REINFORCING

60" CONT. 14" #5 BARS @ 12" OC SHORT WAY

F36

F3x3

F4x4

REINFORCING

01.06.2025 BIDS & CONSTRUCTION


03.13.2025 BULLETIN 001


PROJECT NO. NO PART OF THIS DRAWING MAY BE USED OR REPRODUCED IN ANY FORM OR BY ANY MEANS, OR STORED IN A DATA BASE OR RETRIEVAL SYSTEM, WITHOUT PRIOR WRITTEN PERMISSION OF GMB COPYRIGHT © 2025 ALL RIGHTS RESERVED

STRUCTURAL SCHEDULES

MINIMUM MASONRY REINFORCEMENT LAP LENGTHS VERTICAL BARS IN TENSION-VERTICAL BARS IN TENSION-SINGLE BARS IN CORE DOUBLE BARS IN CORE SINGLE BAR DOUBLE BAR DOUBLE BAR SINGLE BAR 25" 38" 25" 50" 28" 72" 54"

 MECHANICAL SPLICES MAY BE USED IN LIEU OF LAPPED SPLICES. MECHANICAL SPLICE MUST DEVELOP 125% OF BAR TENSION STRENGTH

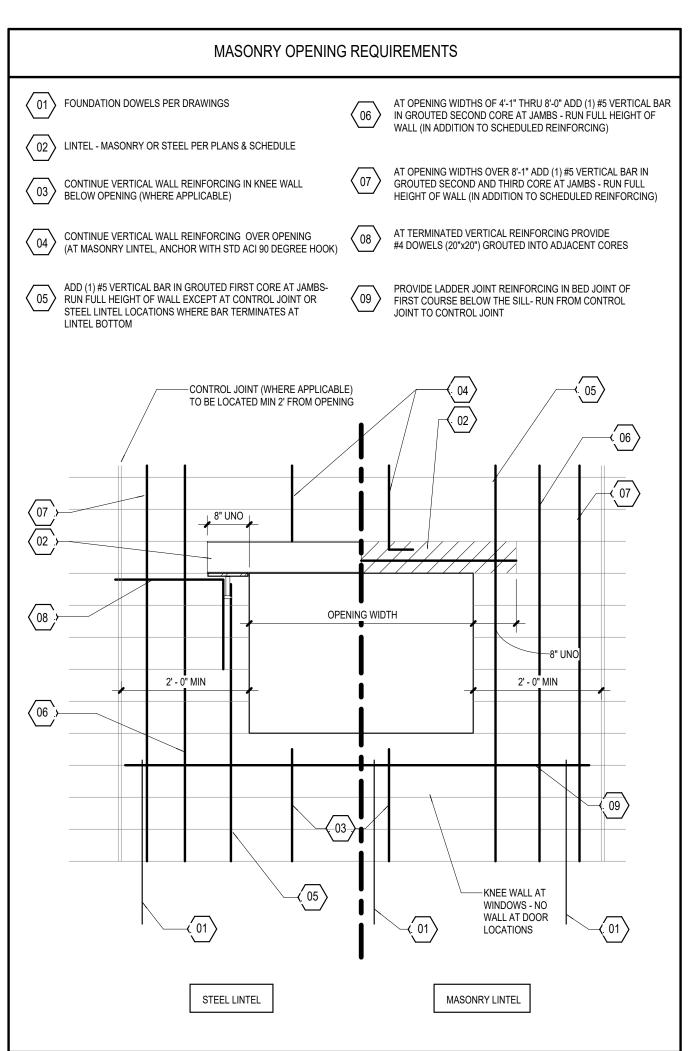

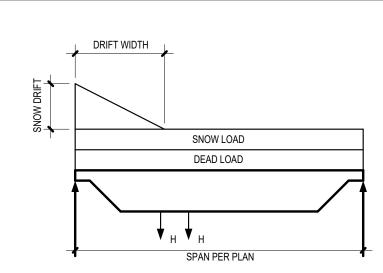


	JO	IST LOADIN	G SCHEDUL	.E	
JOIST / DIST GIRDER	UNIFORM DEAD LOAD (psf)	UNIFORM SNOW LOAD (psf)	MAX SNOW DRIFT LOAD (psf)	WIDTH OF SNOW DRIFT (ft)	HANGER LOAD "H" (lb)
12KSP1	20	25	63	10	-
14KSP1	20	25	63	10	-
14KSP2	20	25	66	11	-
18KSP1	20	25	63	10	-

NOTES:
1. SEE PLAN FOR TRIBUTARY WIDTH OF EACH JOIST. 2. * ON PLAN INDICATES JOIST OR JOIST GIRDER THAT IS PART OF A MOMENT FRAME. REFER TO DETAIL & MOMENT CONNECTION SCHEDULE FOR ADDITIONAL INFO. 3. ALL JOISTS & JOIST GIRDERS TO BE DESIGNED FOR MAX LIVE LOAD DEFLECTION OF SPAN/360.

	LINTEL SCHEDULE		
MARK	MATERIAL	SH	HAPE
U8	(1) COURSE MASONRY LINTEL (MATCH WALL THICKNESS) W/ (2) #5 BARS AND CONCRETE FILL		• •
U16	(2) COURSE MASONRY LINTEL (MATCH WALL THICKNESS) W/ (2) #5 BARS AND CONCRETE FILL		**
U24	(3) COURSE MASONRY LINTEL (MATCH WALL THICKNESS) W/ (2) #5 BARS AND CONCRETE FILL.		
L1	L3 1/2" x 3 1/2" x 5/16" (ONE FOR EACH 4" OF MASONRY)	JL	8" V
L2	L5" x 3 1/2" x 5/16" LLV (ONE FOR EACH 4" OF MASONRY)		12"
L3	W8x10 + 3/8" BOT PLATE		エ
L4	W8x18 + 3/8" BOT PLATE	工	ユ
L5	W8x24 + 3/8" BOT PLATE	I	_I
L6	W16x26 + 3/8" BOT PLATE	エ	_ <u>_</u> _
L7	W16x36 + 3/8" BOT PLATE (NO PL REQ'D FOR 8" WALL)	I	ユ
L8	HSS8x4x1/4 + 3/8" BOT PLATE		<u></u>
L9	HSS16x4x5/16 + 3/8" BOT PLATE		<u>]</u>
ALL ST	EEL LINTELS IN EXTERIOR WALLS SHALL BE GALVANIZED.		
	SONRY LINTELS ARE TO HAVE THEIR ENTIRE DEPTH FILLED IN A OINTS).	SINGLE PO	UR (NO
COPE E	BOT FLANGE OF LINTEL TO 6" WIDTH WHERE REQ TO FIT ON BEAF	RING PLATE	
SEE DE	TAIL BELOW FOR ADDITIONAL REQUIREMENTS.		
	VATOR SHAFTS, LINTEL TO EXTEND ACROSS ENTIRE LENGTH OF DOR OPENING ITSELF).	: Wall (not	JUST
	OR LARGER, PROVIDE WELD ON VENEER ANCHORS & ADJUSTA FACES).	BLE TIES A	T 16" O
	PENINGS NOT SHOWN, PROVIDE L1 FOR OPENINGS UP TO 4'-0" AN 6'-6". CONTACT ARCH / EGR FOR LARGER OPENINGS.	ND L2 FOR (PENIN
	WELDED TO BEARING PLATE WITH BEARIN	JM 8" OR LE NG PLATE IF END WALL)	

BEAM FLANGE FOR BOLTING DOWN

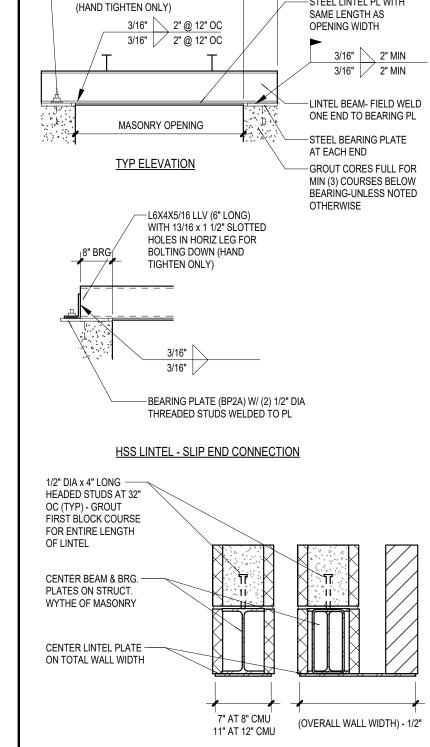


NON LO	AD BEARING LINTEL S	CHEDULE
MASONRY OPENING	WALL TYPE	LINTEL
01.01. TO 41.01.	4" BRICK	L1
0'-0" TO 4'-0"	6" / 8" / 10" / 12" CMU	U8 or L1
	4" BRICK	L2
41 OII TO CLOII	6" CMU	L5 x 5 x 5/16
4'-0" TO 6'-6"	8" CMU	L2
	10" / 12" CMU	L3
	4" BRICK	L6 x 3 1/2 x 1/2 LLV
6'-6" TO 10'-0"	6" CMU	L3
	8" / 10" / 12" CMU	L4
401.011.70.441.011	4" BRICK	-
10'-0" TO 14'-0"	6" / 8" / 10" / 12" CMU	L4


<u>SECTION</u>

FOR OPENINGS UNDER 4'-0", CM TO COORDINATE WHETHER STEEL OR MASONRY LINTELS WILL BE UTILIZED ON THE PROJECT.

	CONCRETE RE	EINFORCEMEN	NT LAP SCHED	ULE
	VERTICAL BARS & HORIZON HORIZON		HORIZONTAI	L TOP BARS
BAR SIZE	DEVELOPMENT LENGTH	SPLICE LENGTH	DEVELOPMENT LENGTH	SPLICE LENGTH
#3	15"	19"	19"	25"
#4	19"	25"	25"	33"
#5	24"	31"	31"	41"
#6	29"	37"	37"	49"
#7	42"	54"	54"	71"
	NTAL BOTTOM BARS AR	E THOSE PLACED WI	TH 12" OR LESS OF FR	ESH CONCRETE

CAST BELOW THE BAR. HORIZONTAL TOP BARS ARE THOSE PLACED WITH MORE THAN 12" OF FRESH CONCRETE CAST BELOW THE BAR.

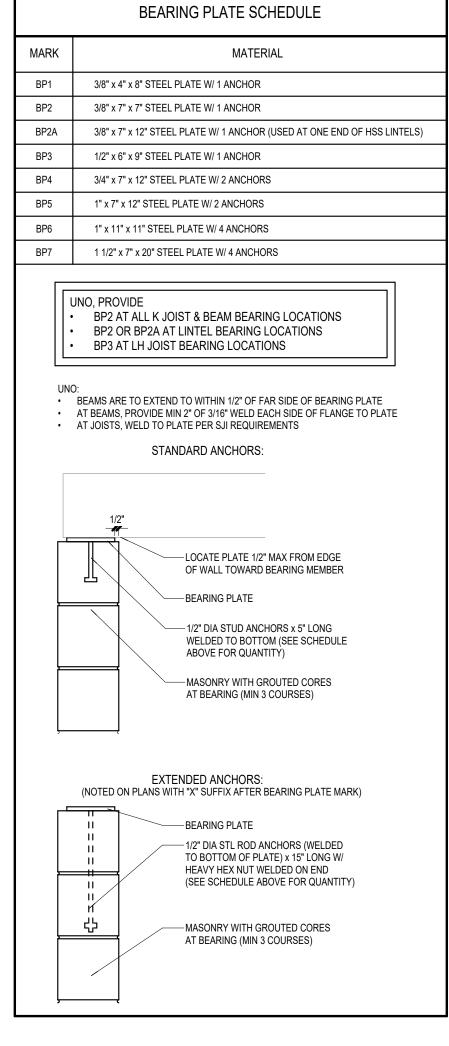

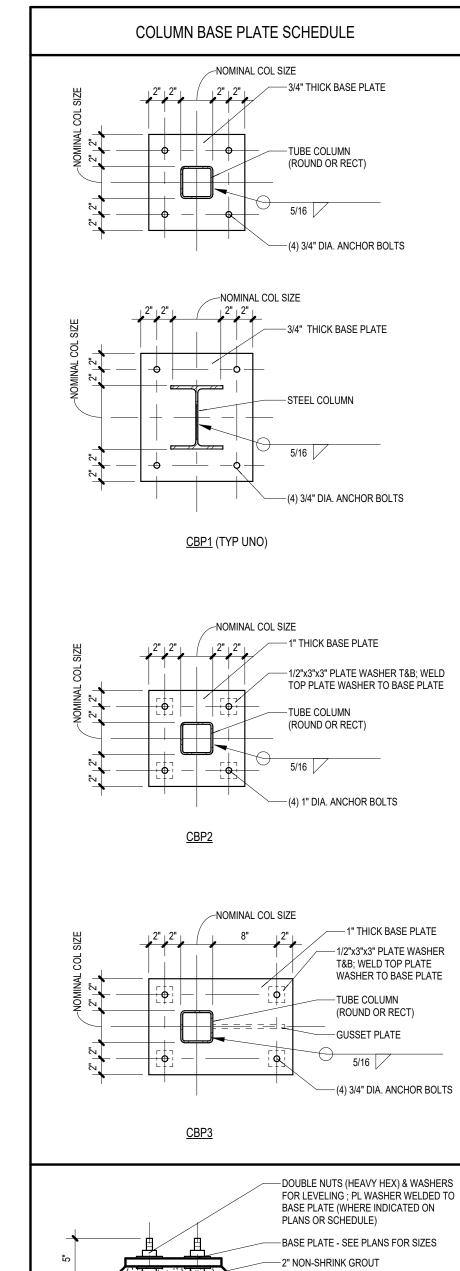


—TOP OF FOUNDATION


ANCHORAGE (WELD ON)


ALTERNATE: 1/4" LEVELING PLATE MAY BE USED IN LIEU OF DOUBLE NUTS


THREADED STEEL ANCHOR

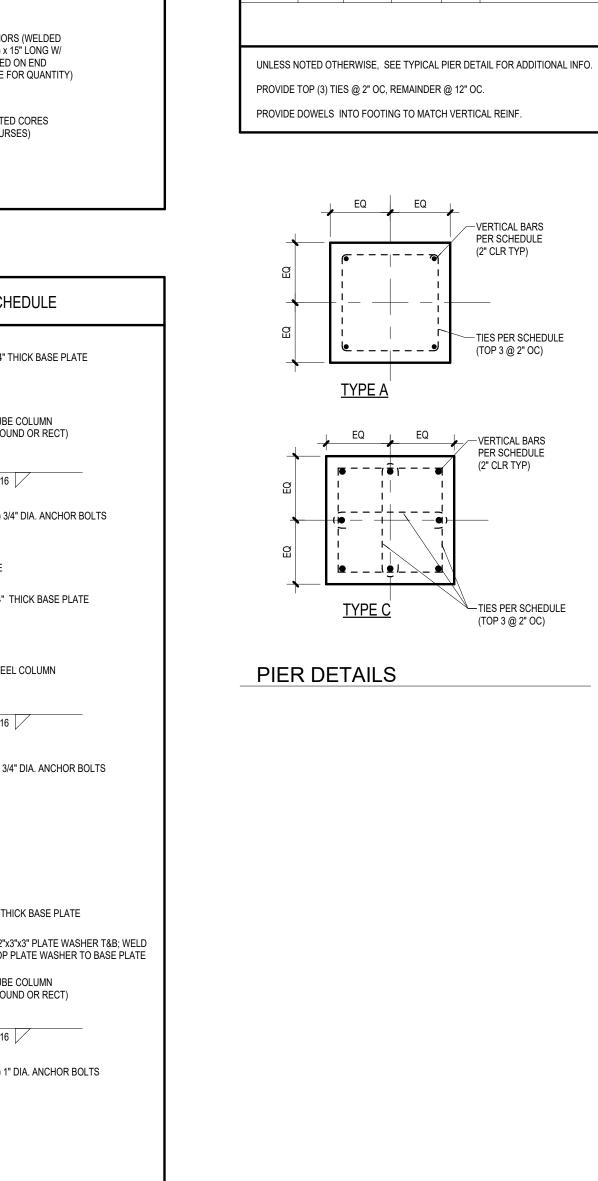

SNOW DRIFT PLAN

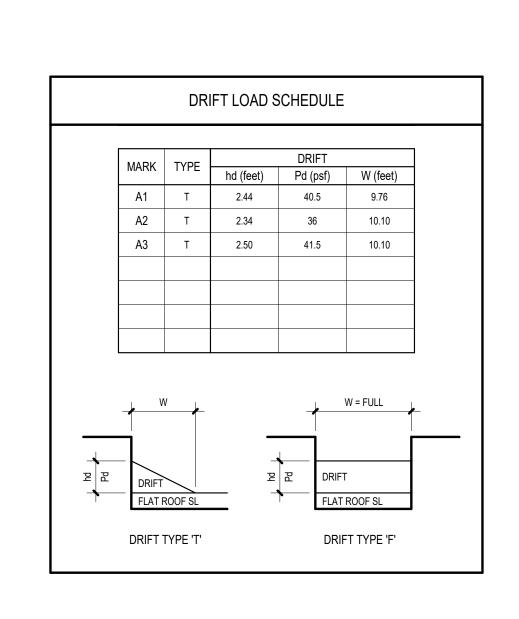

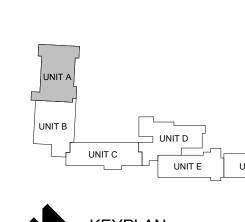

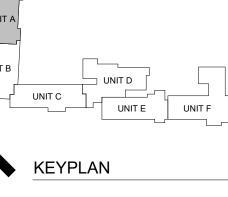

gmb

Design, Inc.

PAMELA
GORYL
ENGINEER
No.
6201067463 03/17/2025

ISSUANCES 01.06.2025 BIDS & CONSTRUCTION 03.13.2025 BULLETIN 001

DRAWN SFG REVIEWED AND PROJECT NO.

NO PART OF THIS DRAWING MAY BE USED OR REPRODUCED IN ANY FORM OR BY ANY MEANS, OR STORED IN A
DATA BASE OR RETRIEVAL SYSTEM,
WITHOUT PRIOR WRITTEN GMB COPYRIGHT © 2025 ALL RIGHTS RESERVED

SNOW DRIFT PLAN

S0.03

PROVIDE BARS THAT MATCH WALL
REINFORCING IN EACH OF FIRST (3) CORES
ADJACENT TO OPENING

(4) #5 VERT BARS W/ #2 TIES @ 8" OC IN GROUTED CORES FROM TOP OF FOUNDATION TO BOTTOM OF LINTEL

GROUTED ALL CORES SOLID FROM TOP OF FOUNDATION TO BOTTOM OF BEAM FOR FULL LENGTH OF SPREADER BEAM


H DOWEL ADDITIONAL REINFORCING BARS AT JAMBS INTO FOOTING

REINFORCING NOTATION APPLIES TO ENTIRE LENGTH OF WALL (NOT JUST THE SECTION OF WALL WHERE THE NOTE HAPPENS TO BE) INCLUDING ABOVE AND BELOW OPENINGS WITHIN THE WALL NOTED.

SHEAR WALLS: REQUIRE (1) VERTICAL BAR IN EACH OF FIRST (2) CORES AT EACH END; GROUTED FULL HEIGHT AND DOWELED INTO FOUNDATION. INDICATED AS THUS ON PLAN.

CMU WALL CO	NTROL JOINTS
NOTE:	
SPACE MASONRY WALL CONTROL JOINTS A MEXCEPT AS LIMITED TO LENGTHS GIVEN IN TH	
PROVIDE CONTROL JOINTS AT: CHANGES IN WALL HEIGHT OR THICKNES AT CONSTRUCTION JOINTS IN FOUNDATION AT COLUMNS. AT RETURN ANGLES IN L-SHAPED, T-SHAF	ON WALLS, ROOFS AND FLOORS.
DO NOT LOCATE CONTROL JOINTS WITHIN 2' -	· 0" OF AN ADJACENT OPENING.
GROUT, CONCRETE, REINFORCING BARS, HOF BOND BEAMS SHALL BE DISCONTINUOUS AT C WALL EXCEPT AT ROOF LEVEL, FLOOR LEVEL	CONTROL JOINTS FOR FULL HEIGHT OF
EXTEND CONTROL JOINTS THRU FACING IF IT CONTROL JOINTS NEED NOT EXTEND THRU FAWITH METAL VENEER TIES).	
MASONRY CONTROL JOINTS NEED NOT ALIGN	I WITH VENEER MOVEMENT JOINTS.
IN CORNER MATCH VEF	RERTICAL WALL REINFORCING R CORE - SIZE & QUANTITY TO RTICAL WALL REINFORCING R BARS IN BOND BEAMS
PROVIDE VERTICAL WALL REINFORCING IN FIRST CORE EACH SIDE OF CONTROL JOINT - SIZE & QUANTITY TO MATCH VERTICAL WALL REINFORCING	ZO-O" MAX AROUND CORNER
	24-0" MAX TYPICAL SPACING
	AN DETAIL

MARK	NUMBER OF BARS	BAR SIZE (GRADE 60)	BAR SPACING	REMARKS
R1-5-48	ONE	#5	48" OC	CENTER IN CORE
R1-6-32	ONE	#6	32" OC	CENTER IN CORE
R1-6-40	ONE	#6	40" OC	ONE EACH FACE
ALL BEARING ALL EXTERIC ALL INTERIO	R WALLS SHALL RE	CEIVE A MINIMUM F ECEIVE A MINIMUM ALLS OVER 16'-0" H	REINFORCING OF R REINFORCING OF I IGH SHALL RECEIV	R1-5-48.
TO MAINTAIN UNOBSTRUC	S VERTICALLY A CONTINUOUS TED 3" x 4" CELL IT SOLID FOR OF WALL		USE N POSIT IN PLA OF WA AT MA USE N POSIT IN PLA OF WA AT MA	YP. ALL SIDES) RTICAL REBAR - SEE S FOR SIZE & SPACING - RE IN PLACE BEFORE TING IIN 9 GA. WIRE REBAR IONERS TO HOLD BARS ICE AT TOP & BOTTOM ALL AND IN BETWEEN X 8'-0" INTERVALS IIN 9 GA. WIRE REBAR IONERS TO HOLD BARS ICE AT TOP & BOTTOM ALL AND IN BETWEEN X 8'-0" INTERVALS IERTICAL REBAR - SEE S FOR SIZE & SPACING - RE IN PLACE BEFORE

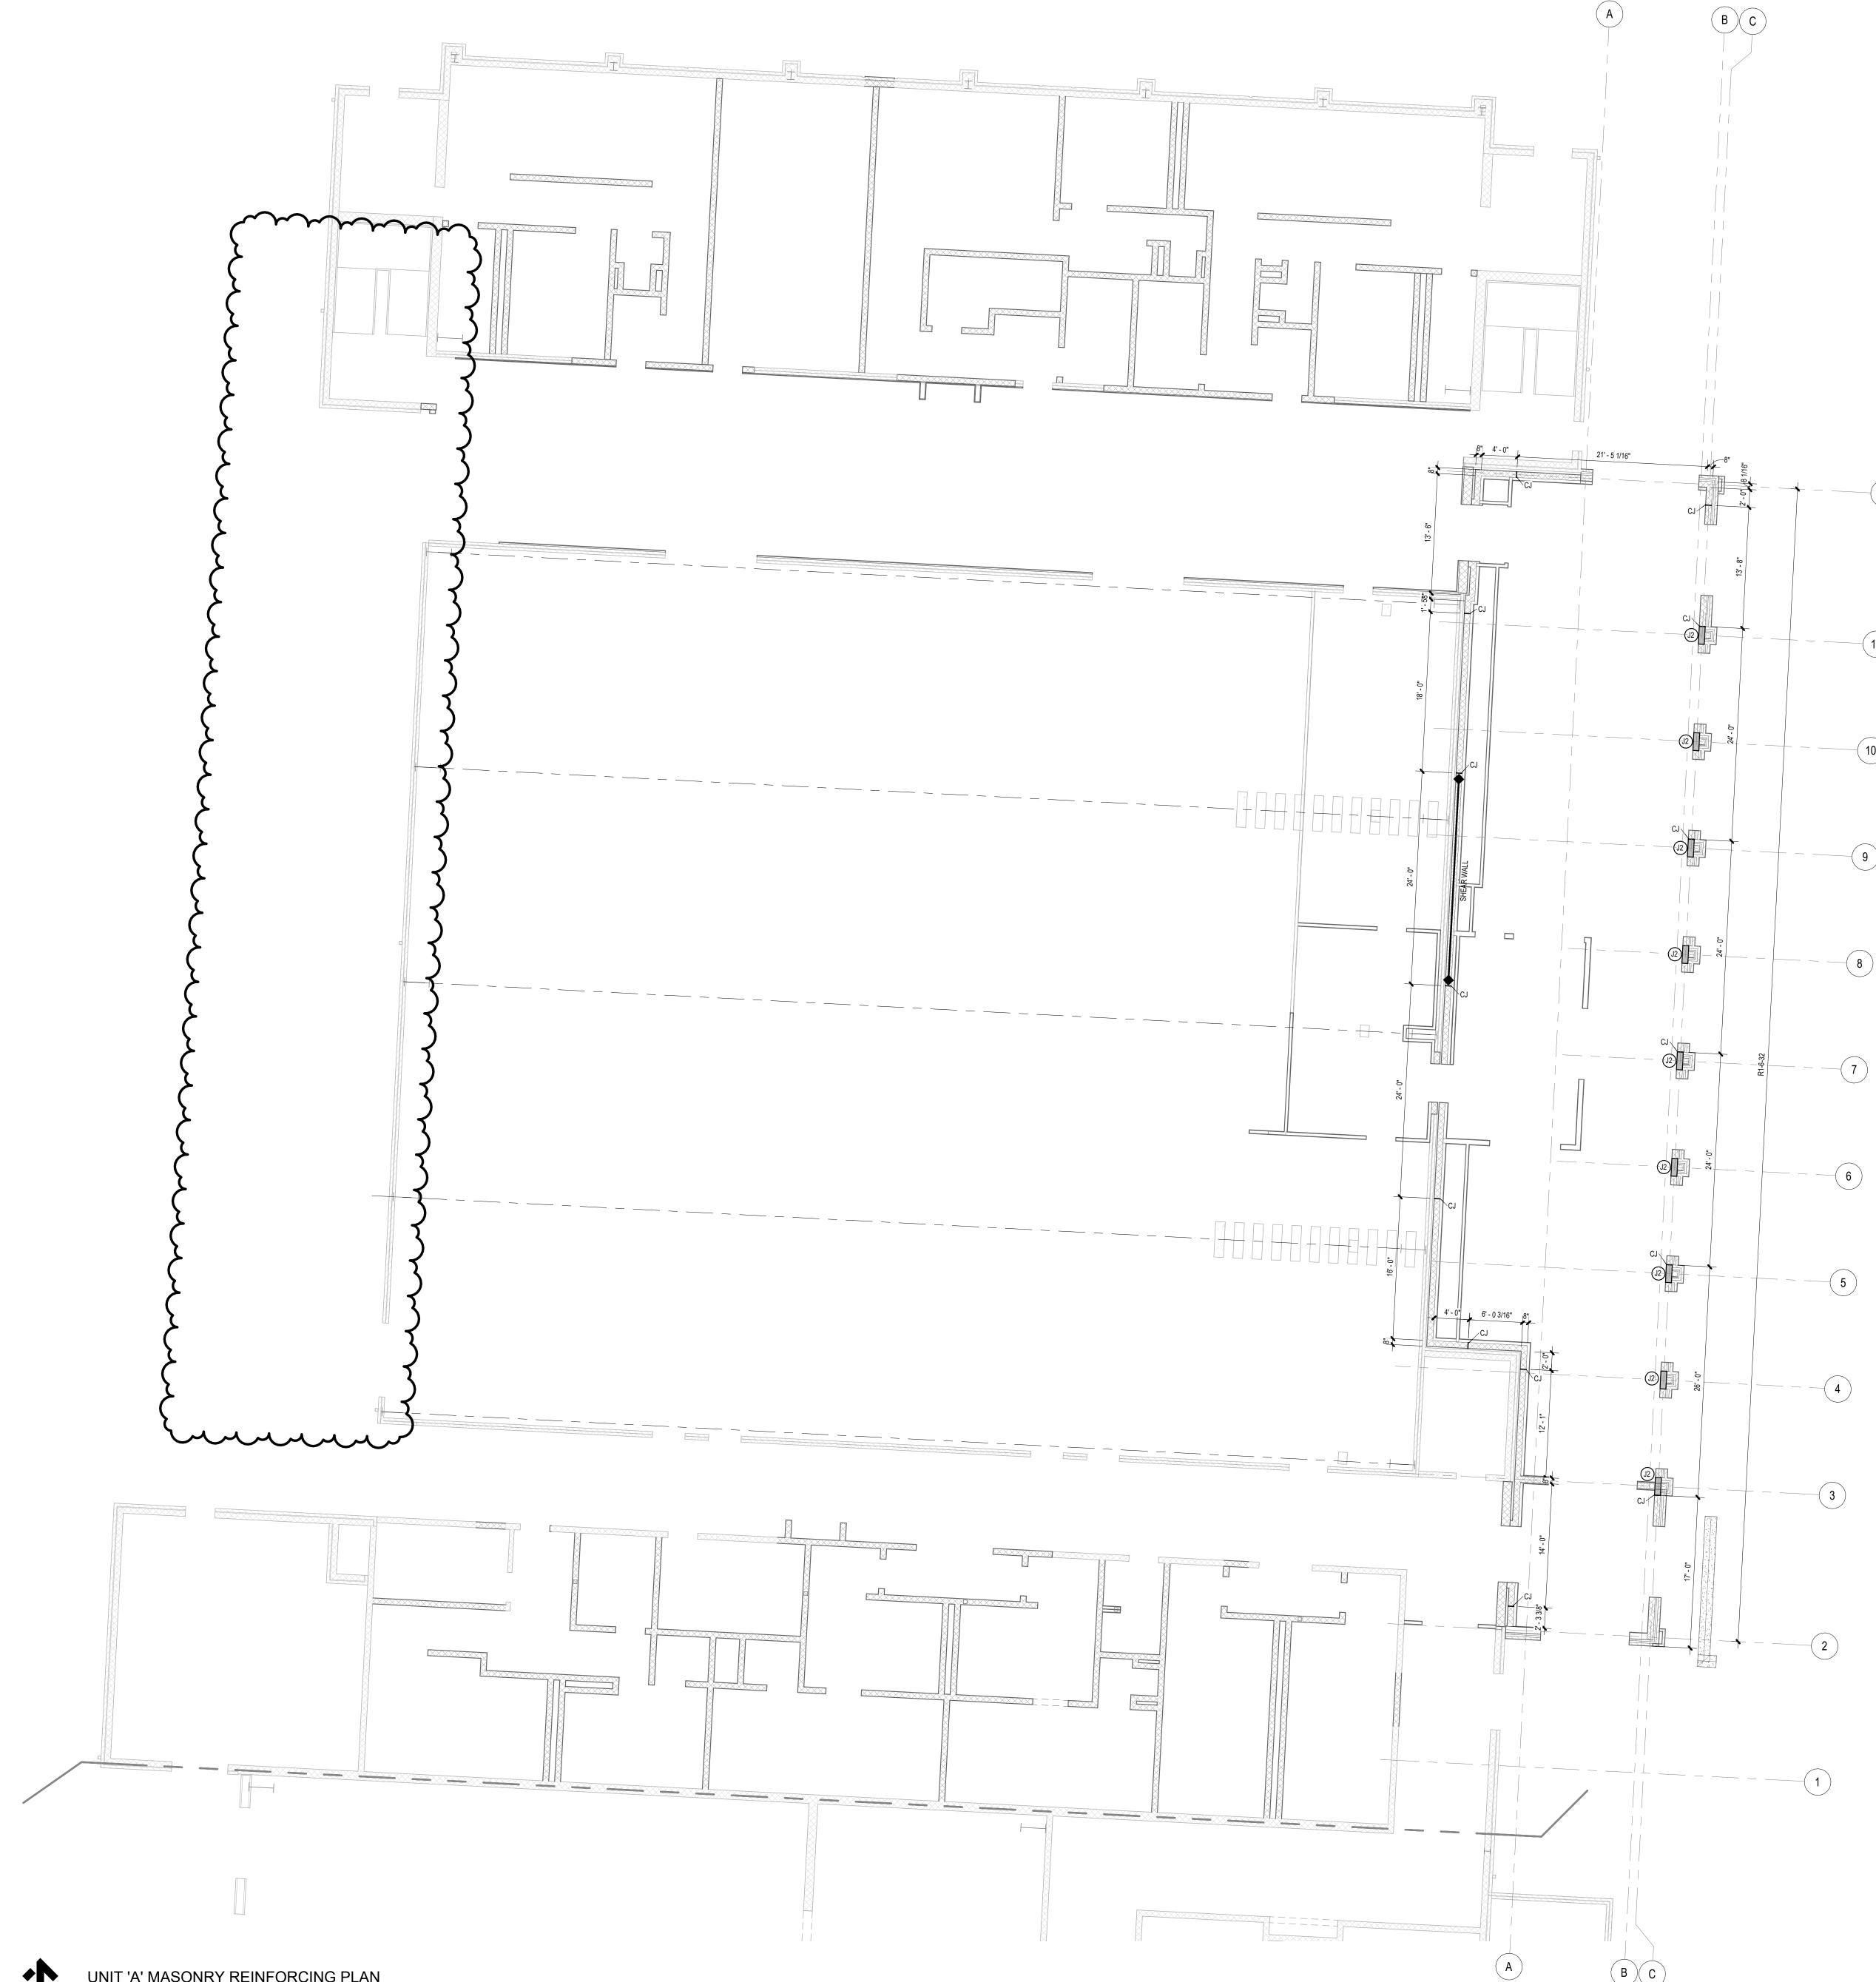



PAMELA

GORYL

ENGINEER

No.
6201067463 Tamella de 03/17/2025

ISSUANCES 01.06.2025 BIDS & CONSTRUCTION 03.13.2025 BULLETIN 001

DRAWN SFG REVIEWED AND

PROJECT NO. NO PART OF THIS DRAWING MAY BE USED OR REPRODUCED IN ANY FORM OR BY ANY MEANS, OR STORED IN A
DATA BASE OR RETRIEVAL SYSTEM,
WITHOUT PRIOR WRITTEN GMB COPYRIGHT © 2025 ALL RIGHTS RESERVED

MASONRY REINFORCING PLAN

S0.04



STERN WAYNE SCHOOLS

O1.06.2025 BIDS & CONSTRUCTION
O3.13.2025 BULLETIN 001

DRAWN SFG
REVIEWED AND

PROJECT NO. 5-6394

NO PART OF THIS DRAWING MAY BE USED OR REPRODUCED IN ANY FORM OR BY ANY MEANS, OR STORED IN A DATA BASE OR RETRIEVAL SYSTEM, WITHOUT PRIOR WRITTEN PERMISSION OF

GMB COPYRIGHT © 2025 ALL RIGHTS RESERVED

UNIT 'A' FLOOR AND LOW ROOF DEMOLITION PLAN

S1.1A

♦ KEYPLAN

03.13.2025 BULLETIN 001


Maze Design, Inc.

03/17/2025

GMB COPYRIGHT © 2025
ALL RIGHTS RESERVED

UNIT 'A' FOUNDATION PLAN

KEYPLAN S2.1A

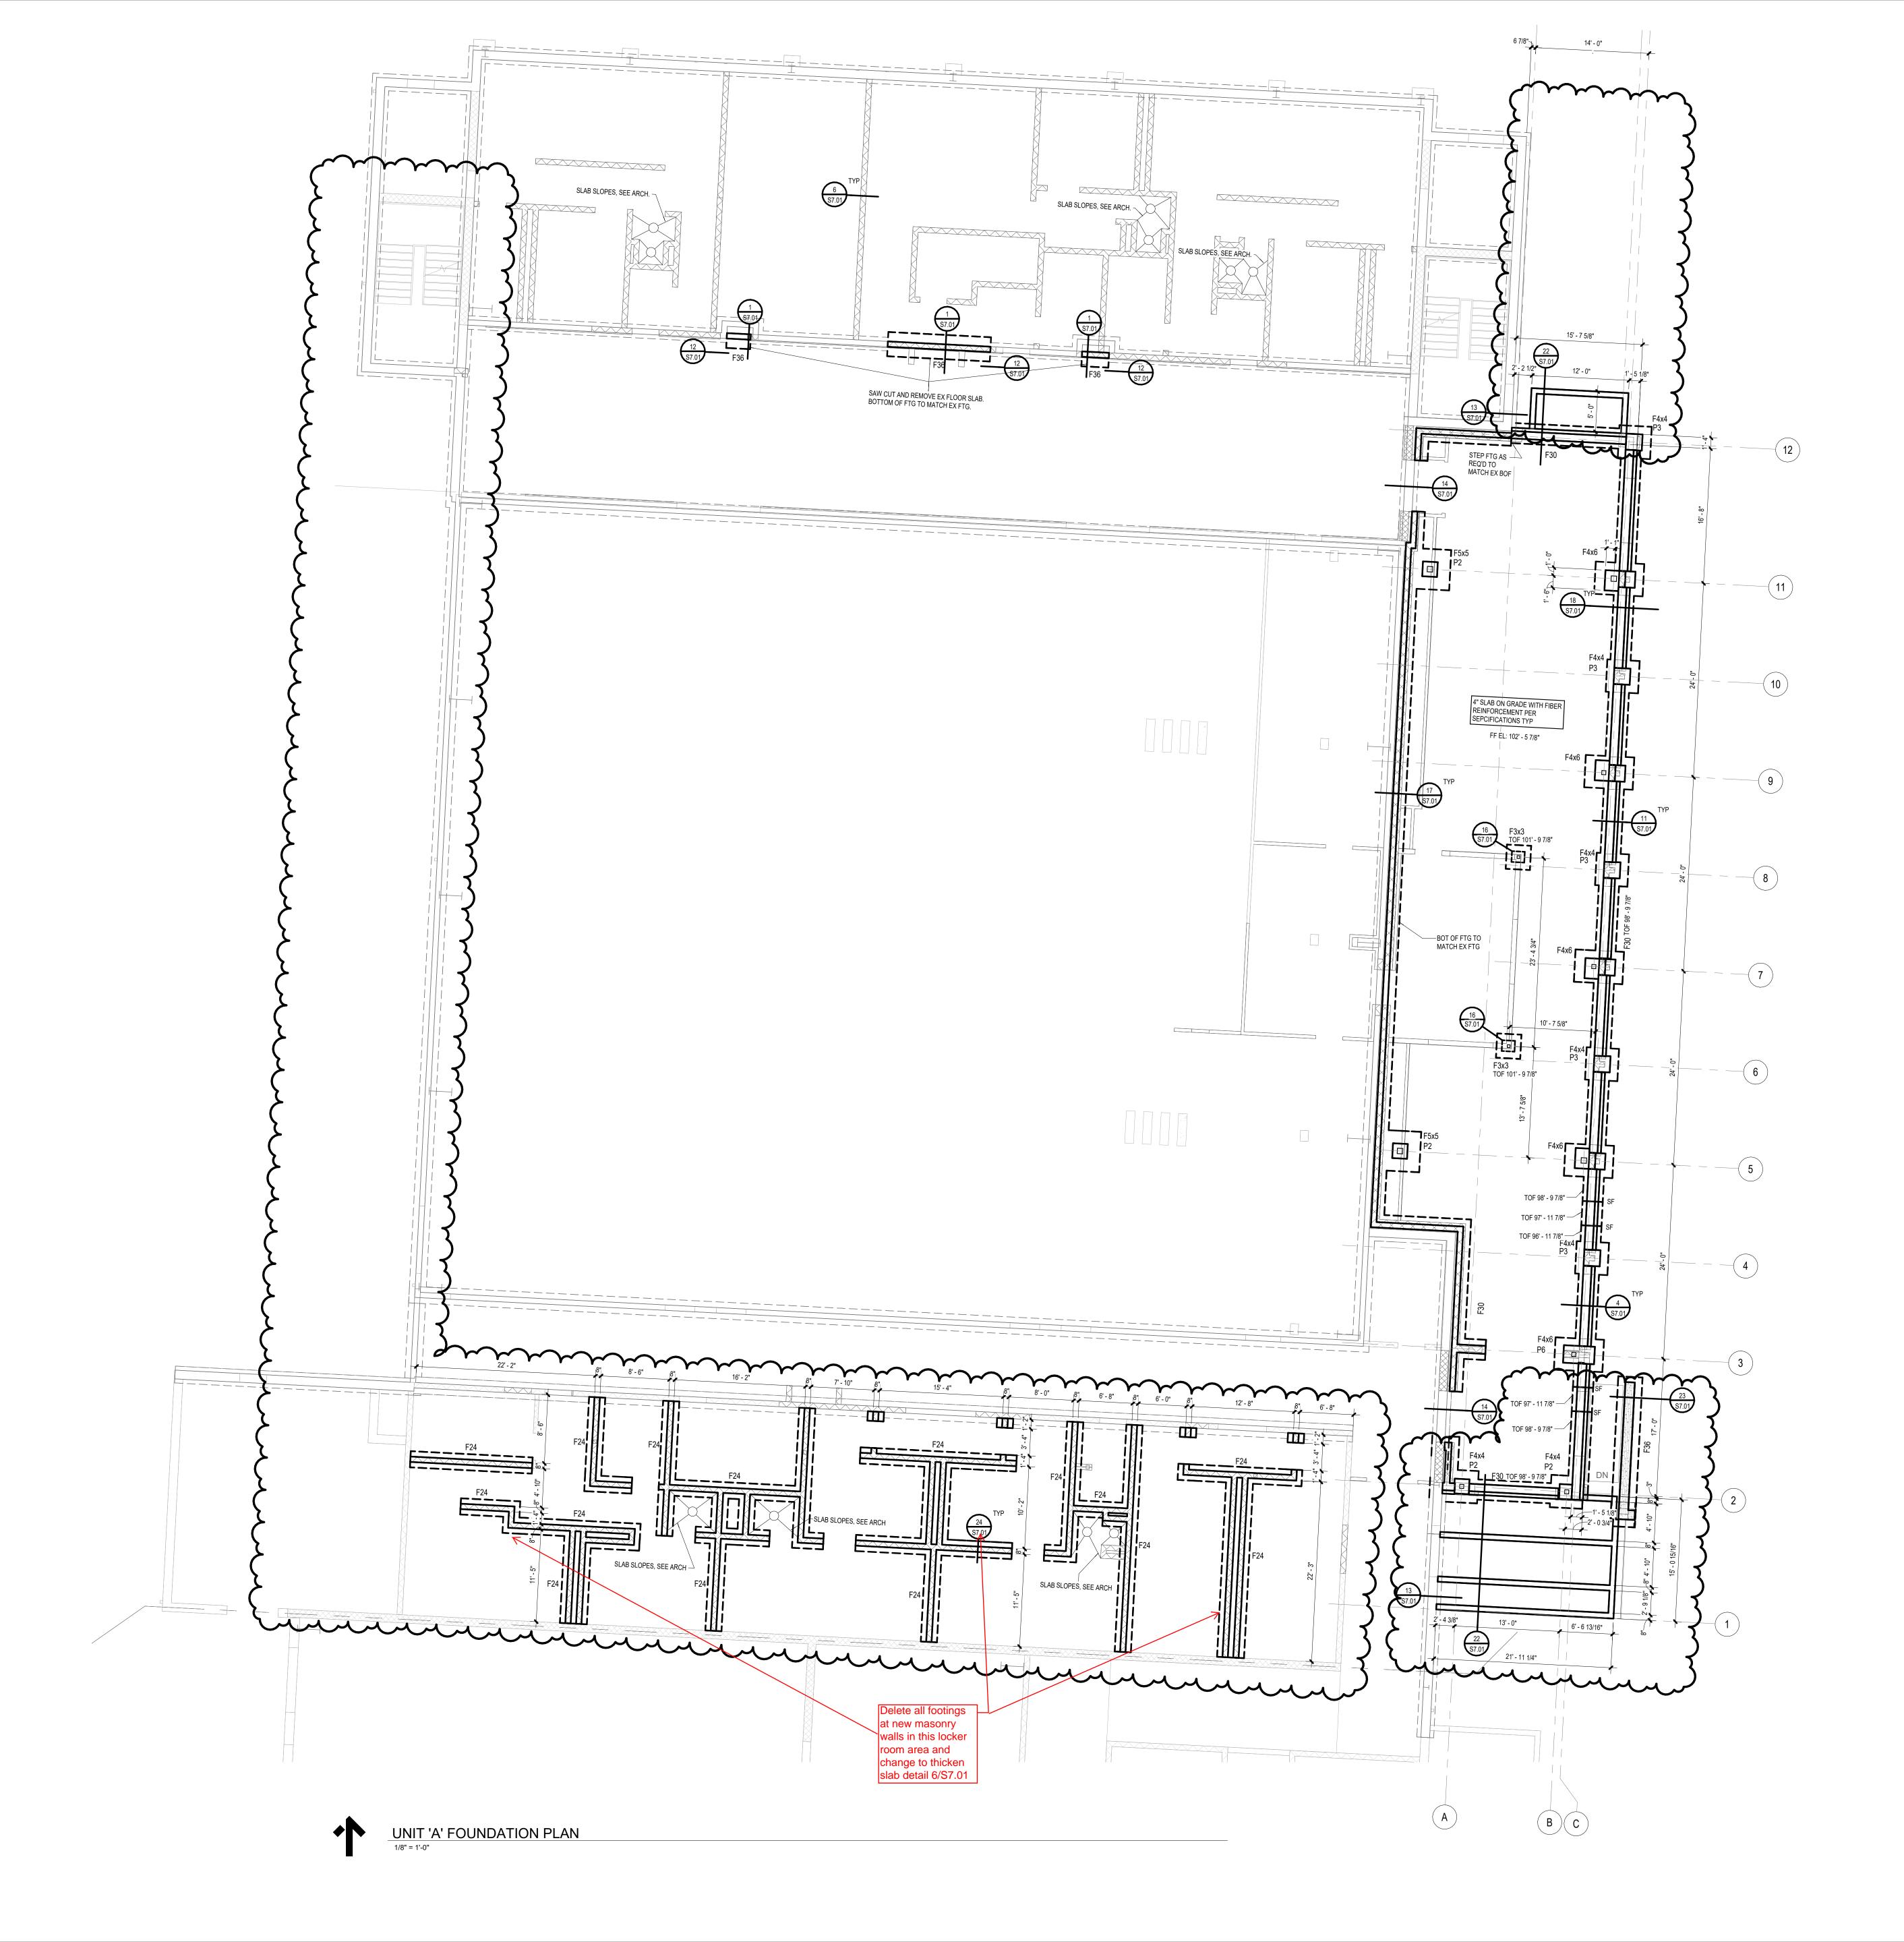

utodesk Docs://5-6394 Western Wayne Schools Additions & 12/2025 3:23:55 PM

ERN WAYNE SCHOOLS

ISSUANCES

01.06.2025 BIDS & CONSTRUCTION

01.16.2025 ADDENDUM 001

03.13.2025 BULLETIN 001

DRAWN SFG

REVIEWED AND

PROJECT NO. 5-6394

NO PART OF THIS DRAWING MAY BE USED OR REPRODUCED IN ANY FORM OR BY ANY MEANS, OR STORED IN A DATA BASE OR RETRIEVAL SYSTEM, WITHOUGH WITTEN


UNIT 'A' FLOOR AND LOW ROOF FRAMING PLAN

GMB COPYRIGHT © 2025 ALL RIGHTS RESERVED

KEYPLAN S3.1A

UNIT 'A' FLOOR AND LOW ROOF FRAMING PLAN

1/8" = 1'-0"

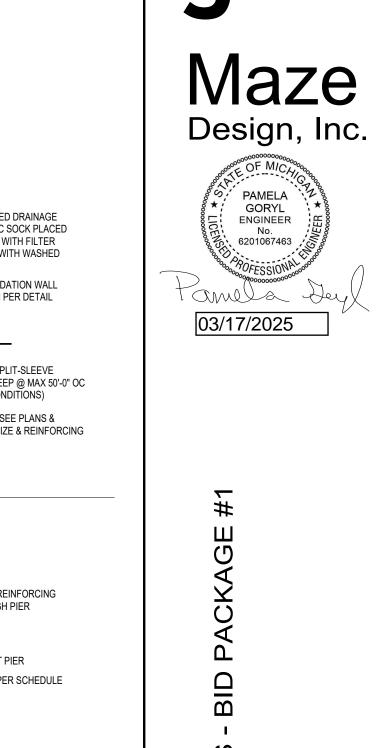




STEP LENGTH (MIN. 3X STEP HEIGHT) "Z" BARS - QUANTITY — & SIZE TO MATCH REINFORCING -FOOTING REINFORCING --SEE FOOTING SCHEDULE


INSTALLATION


YPICAL STEPPED FOOTING DETAIL


PIER AT EXTERIOR WALL

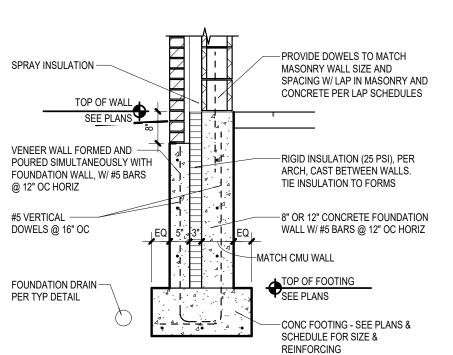




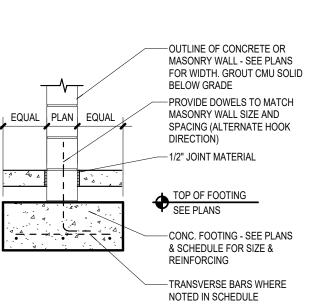

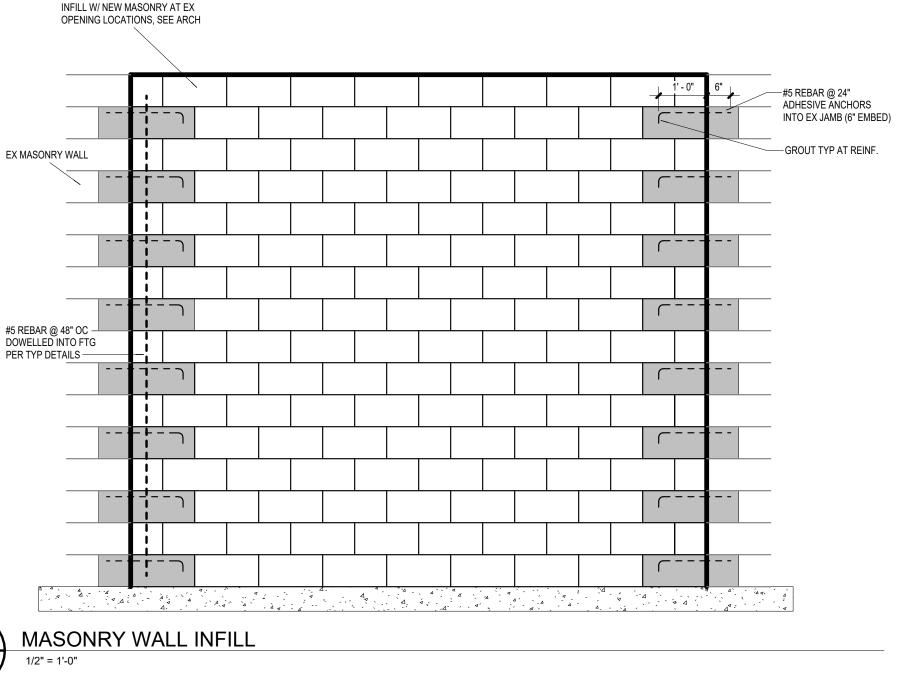

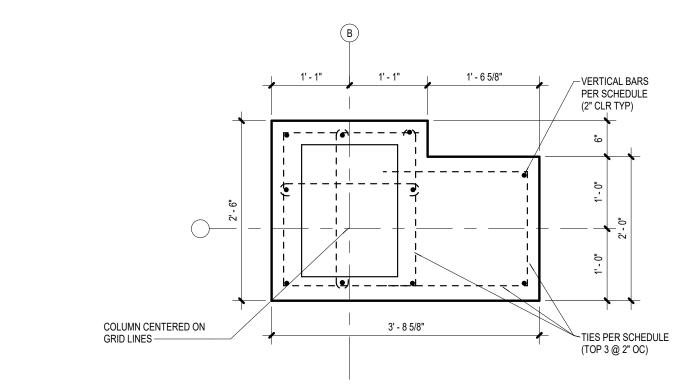

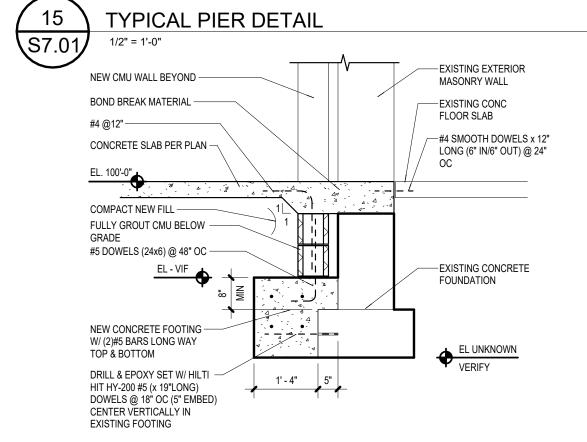


101' - 5 7/8"

NOTE: PROVIDE #5 DOWEL(S) x 30" -LONG TO MATCH MASONRY PIER

REINFORCING WHERE NO

STEEL COLUMN REQUIRED

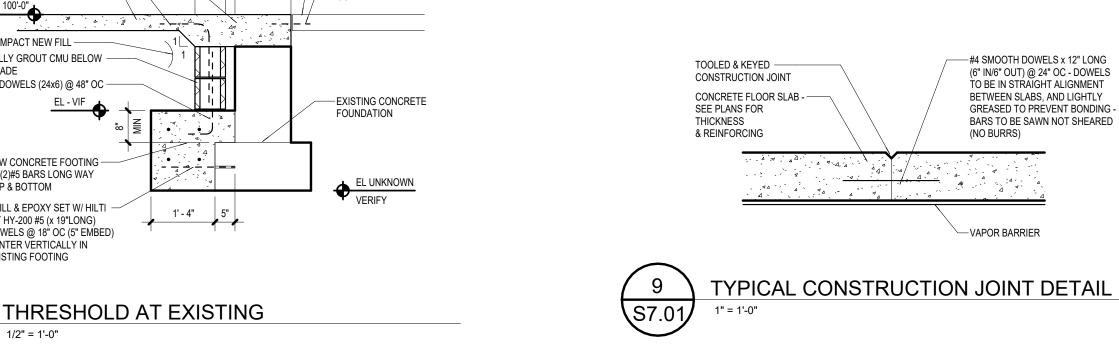

---#3 TIE @ 6" OC

—(4) #3 VERTS

AND CONCRETE

----3:1 SLOPE AWAY FROM COLUMN

-COLUMN ISOLATION SIM TO

20/S7.01 AT CONCRETE SLAB

-COAT COLUMN, BASE PLATE, AND

ANCHOR BOLTS BELOW GRADE W/

BITUMINOUS MATERIAL: PROVIDE BOND BREAK BETWEEN STEEL

CONCRETE PIER - SEE PLANS &

SCHEDULE FOR SIZES

FOR FOOTING ELEVATION

& SCHEDULE FOR SIZE &

REINFORCING

6" STUD AND

TILE PER ARCH -

@ 12" OC HORIZ

DOWELS @ 16" OC

FOUNDATION DRAIN -

FOUNDATION DRAIN PER TYP DETAIL

PER TYP DETAIL

#5 VERTICAL -

SPRAY INSULATION —

VENEER WALL FORMED AND -

POURED SIMULTANEOUSLY WITH

FOUNDATION WALL, W/ #5 BARS

TOP OF WALL

-PROVIDE DOWELS TO MATCH

- RIGID INSULATION (25 PSI) PER

ARCH, CAST BETWEEN WALLS.

-8" OR 12" CONCRETE FOUNDATION

WALL W/ #5 BARS @ 12" OC HORIZ

TIE INSULATION TO FORMS

SCHEDULE FOR SIZE &

RIGID INSULATION - COORDINATE JOINT

LOCATION & THICKNESS WITH ARCH

-RIGID INSULATION (25 PSI), PER ARCH, CAST

─8 OR 12" CONCRETE FOUNDATION WALL W/ #5 BARS @ 12" OC HORIZ

BARS @ 12" OC HORIZ

---#5 VERTICAL DOWELS @ 16" OC

—CONC FOOTING - SEE PLANS &

SCHEDULE FOR SIZE & REINFORCING

-VENEER WALL FORMED AND POURED

BETWEEN WALLS. TIE INSULATION TO FORMS

SIMULTANEOUSLY WITH FOUNDATION WALL, W/#5

SEE PLANS

REINFORCING

MATCH CMU WALL

FOUNDATION WALL WITH STUD AND TILE

FOUNDATION WALL AT GLASS

—SAWCUT JOINT MINIMUM 1" DEEP

SEE PLANS FOR

THICKNESS &

REINFORCING

-VAPOR BARRIER

-INTERIOR BLOCK

PARTITION (NON-LOAD

-DOWELS TO MATCH WALL REINF SIZE

AND SPACING W/ ACI STD. 90 DEGREE

HOOK (ALTERNATING HOOK DIRECTION

HILTI HIT HY-200 ADHESIVE (6" EMBED)

-#4 SMOOTH DOWELS x 12" LONG (6" IN/6" OUT) @ 24" OC - DOWELS TO BE IN

STRAIGHT ALIGNMENT BETWEEN SLABS,

AND LIGHTLY GREASED TO PREVENT

BONDING - BARS TO BE SAWN NOT

SHEARED (NO BURRS)

- INTERIOR BLOCK

BEARING

BOTTOM COURSE —

GROUT SOLID

PARTITION, NON-LOAD

---#5 DOWELS @ 48" OC

DRILL & SET USING HILTI

- THICKENED SLAB PER 15/S7.01

"SAFE SET" HIT HY-200

ADHESIVE - EMBED 3"

-EXISTING CONCRETE SLAB

OR SECURE DOWELS WITH

-CONCRETE FLOOR SLAB


VAPOR BARRIER


-(2)#5 BARS CONT


TYPICAL CONTROL JOINT DETAIL


CONCRETE PER LAP SCHEDULES


MASONRY WALL SIZE AND SPACING W/ LAP IN MASONRY AND EXTERIOR /

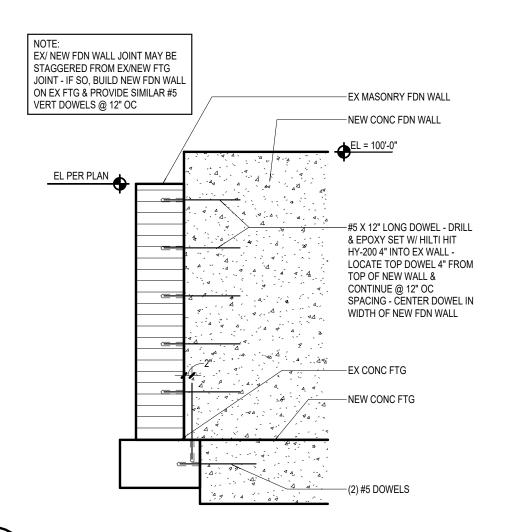


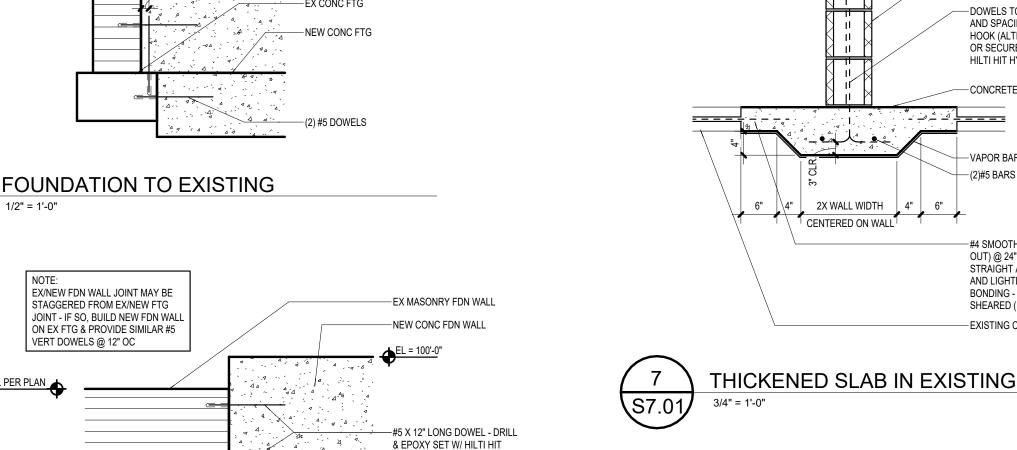


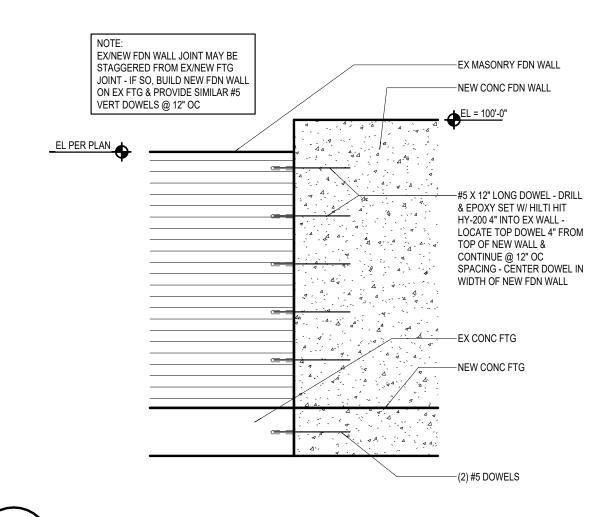


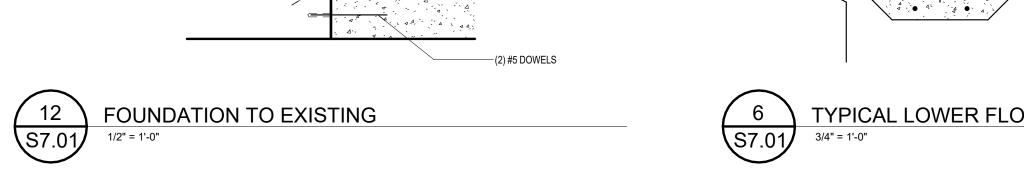


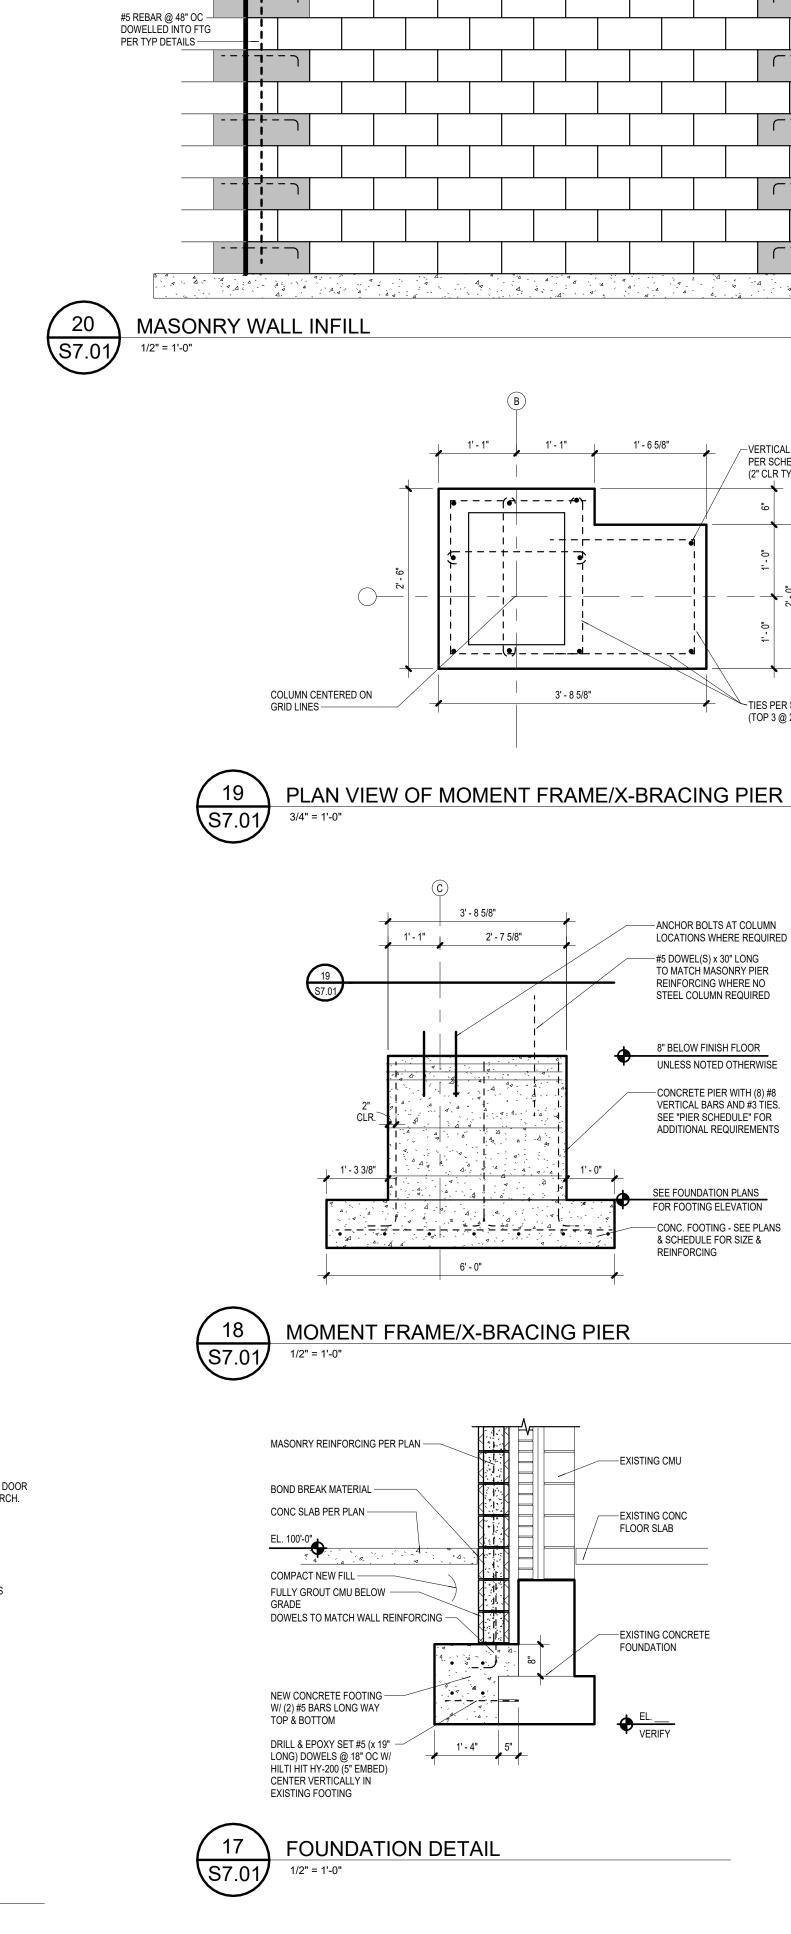

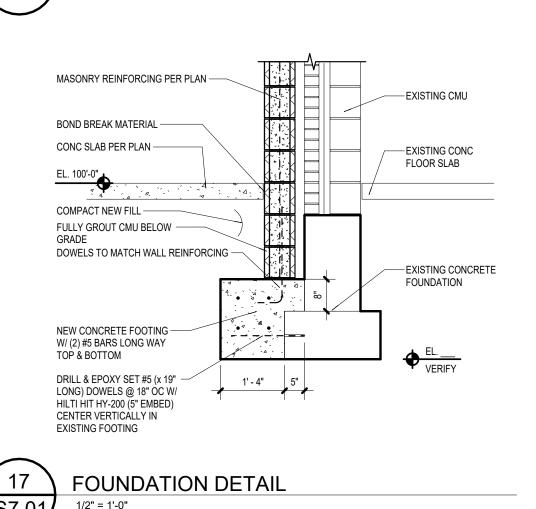

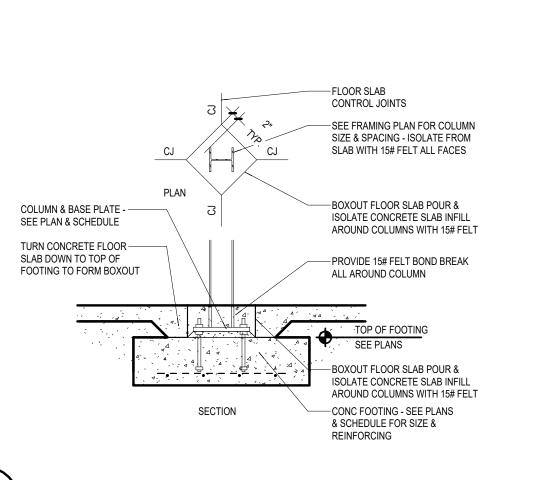

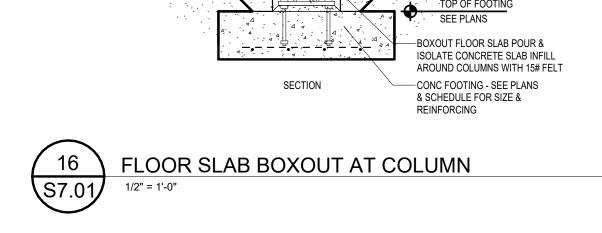

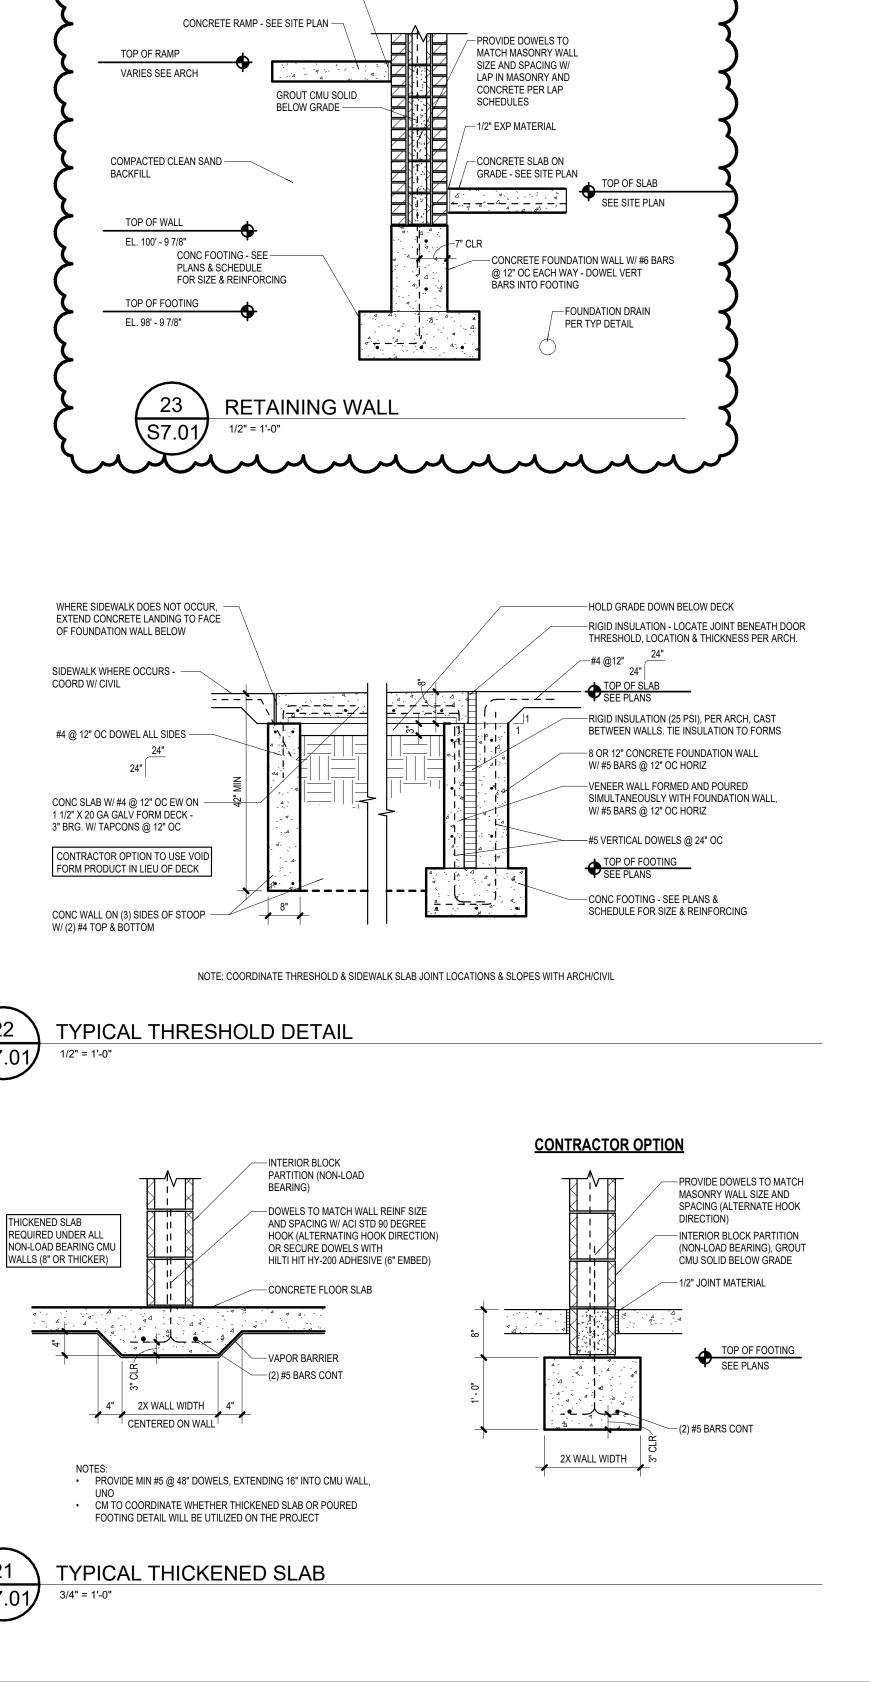

-PROVIDE DOWELS TO MATCH MASONRY WALL SIZE AND SPACING W/ LAP IN MASONRY AND CONCRETE

-GROUT CMU SOLID BELOW GRADE

-CONCRETE FOUNDATION WALL

-#5 VERTICAL DOWELS @ 24" OC

-CONC FOOTING - SEE PLANS &


1/2" EXP MATERIAL —


SCHEDULE FOR SIZE & REINFORCING


PLAN FOR WALL WIDTH)

W/ #5 BARS @ 12" OC HORIZ. (SEE

PER LAP SCHEDULES

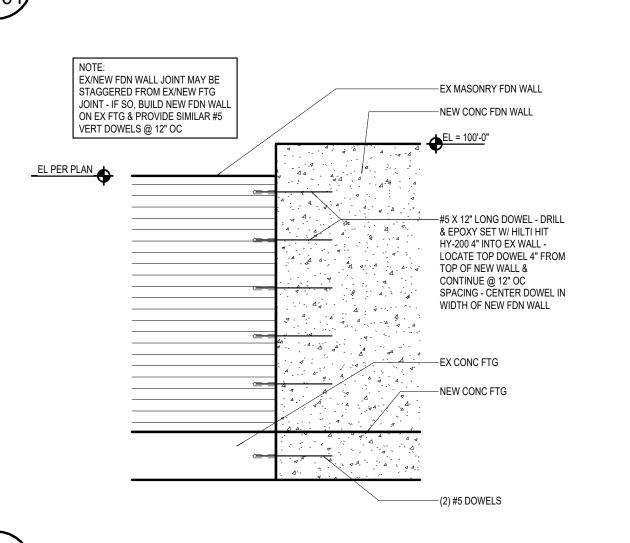

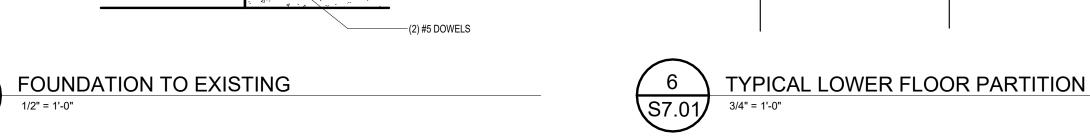

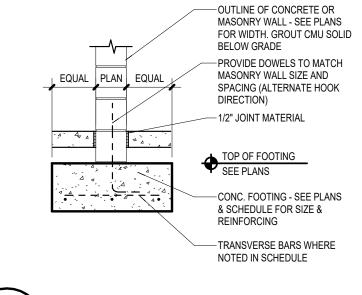

01.06.2025 BIDS &

DRAWN

REVIEWED PMB

PROJECT NO.

SFG

NO PART OF THIS DRAWING MAY BE

USED OR REPRODUCED IN ANY FORM

OR BY ANY MEANS, OR STORED IN A

DATA BASE OR RETRIEVAL SYSTEM,

WITHOUT PRIOR WRITTEN

PERMISSION OF

GMB COPYRIGHT © 2025

ALL RIGHTS RESERVED

FOUNDATION DETAILS

03.13.2025 BULLETIN 001

CONSTRUCTION

-MASONRY WALL ABOVE

-LINTEL PER PLAN, EXTEND 16" BEYOND OPENING AT

— 3/8" GAP MIN - SEE ARCH FOR FIRE CAULKING

- MASONRY LINTEL TO MATCH

-MASONRY LINTEL 2" WIDER THAN WALL ABOVE

WALL THICKNESS

--- METAL ROOF DECK

-CONTINUOUS L4X4X1/4 UNLESS NOTED OTHERWISE

—SECURE TO BLOCK WITH 1/2"ø ANCHORS USING HILTI HIT HY-270 ADHESIVE & SCREEN TUBES @ 24" OC (3 3/8" EMBEDMENT)

WALL THICKNESS AND BOND BM REINF VARIES- SEE PLAN AND GENERAL STRUCTURAL NOTES

TYPICAL ROOF DECK ANGLE

____L5X3X1/4 x 8" LONG (TYP)

-UNLESS OTHERWISE NOTED TYPICAL FRAMING LAYOUT AND SIZE SHOWN FOR TYPICAL ROOF

TYPICAL ROOF FRAME DETAIL

-AT LARGE OPENINGS, SEE FRAMING PLANS FOR FRAME MEMBER SIZES

EQUIPMENT OPENINGS. SEE FRAMING PLAN (& COORD W/ ARCH & MECH PLANS) FOR LOCATIONS.

-UNLESS OTHERWISE NOTED TYPICAL FRAMING LAYOUT AND SIZE SHOWN FOR: OPENINGS 18"X18" OR

-AT AREAS OF LARGER OPENINGS, HEAVIER LOADS, OR GREATER STRUCTURAL SPANS, SEE TYP ROOF

SMALLER; LOADS OF LESS THAN 1000 LBS; AND SPANS LESS THAN 5'-0" BETWEEN SUPPORTING MEMBERS

— COPE ANGLE TO ALLOW TOP FLANGE TO REST ON SUPPORTING STRUCTURE, TYP.

L3X3X1/4 DECK ---EDGE ANGLE

METAL —

ROOF DECK

BEAM PER PLAN, -GROUT BEAM POCKET

BP PER PLAN —

AND SCHEDULE

BEAM BEARING

NOTE:

AT EXISTING ROOF LOCATIONS, FRAME MAY -

BE BOLTED IN LIEU OF WELDED WITH (2) 1/2"

DIA A 325 BOLTS

CONT BOND BEAM AT

PER PLAN,

EOD 1/2"

PORTAL FRAME
3/4" = 1'-0"

EACH END

ISSUANCES 01.06.2025 BIDS & CONSTRUCTION


03.13.2025 BULLETIN 001


DRAWN SFG REVIEWED PMB


PROJECT NO. NO PART OF THIS DRAWING MAY BE USED OR REPRODUCED IN ANY FORM OR BY ANY MEANS, OR STORED IN A DATA BASE OR RETRIEVAL SYSTEM, WITHOUT PRIOR WRITTEN PERMISSION OF GMB COPYRIGHT © 2025 ALL RIGHTS RESERVED


FRAMING DETAILS


S7.02

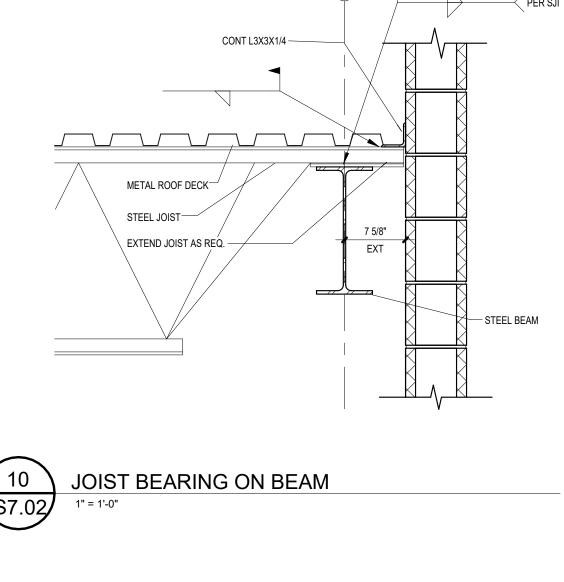


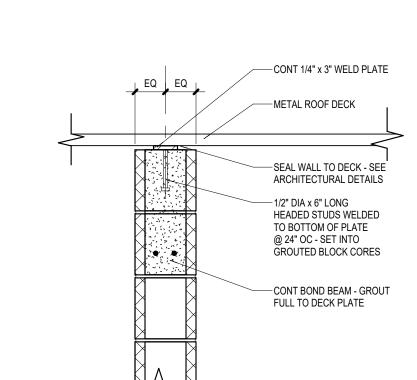


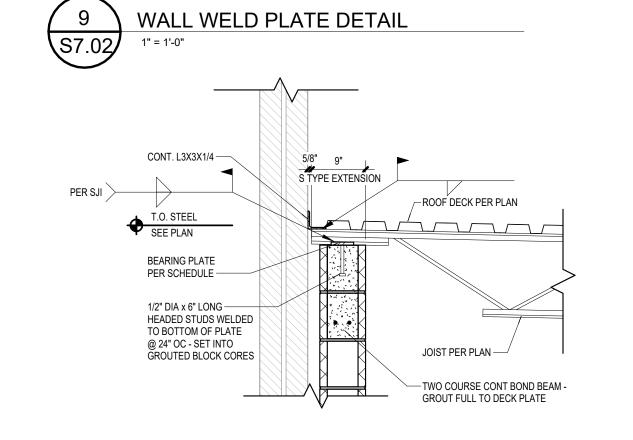


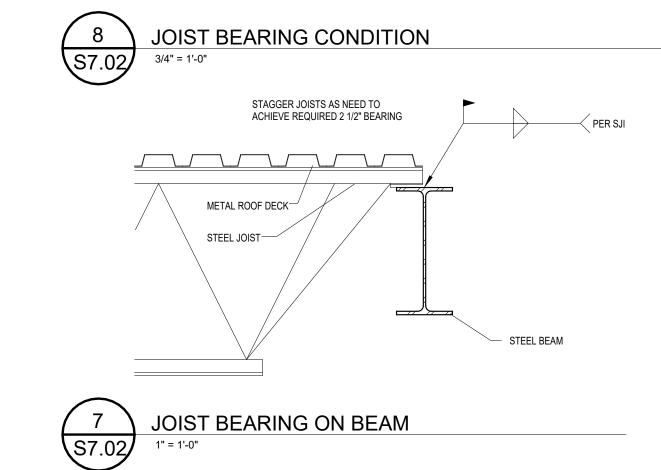


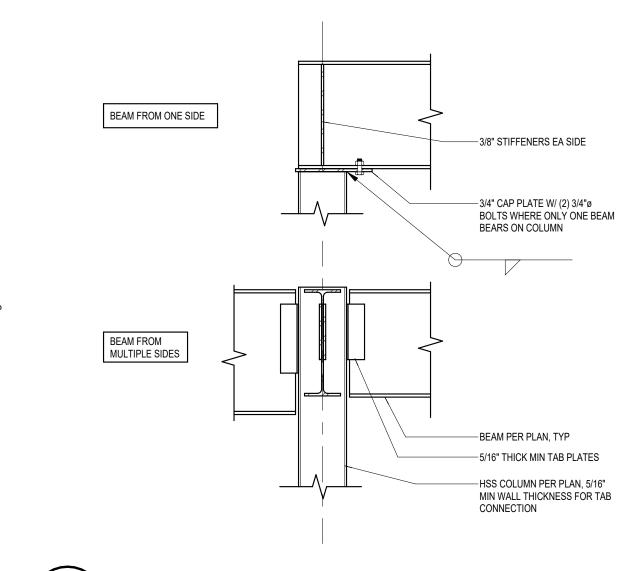

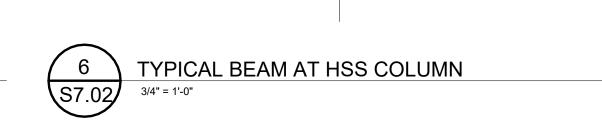

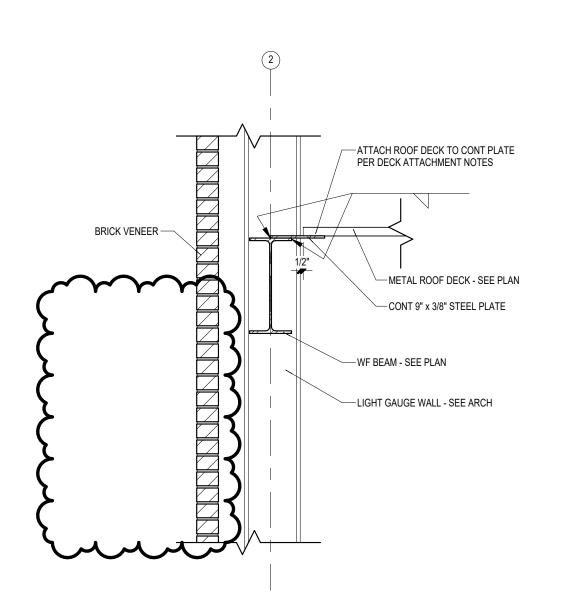


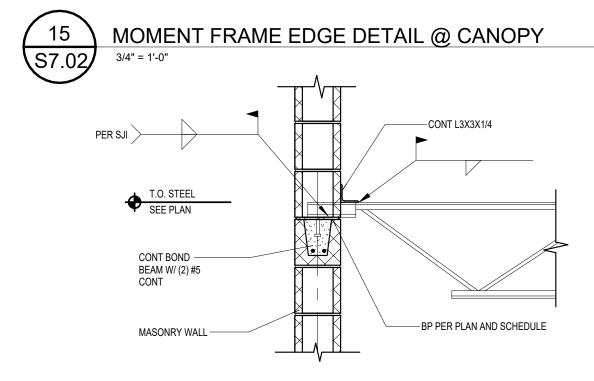


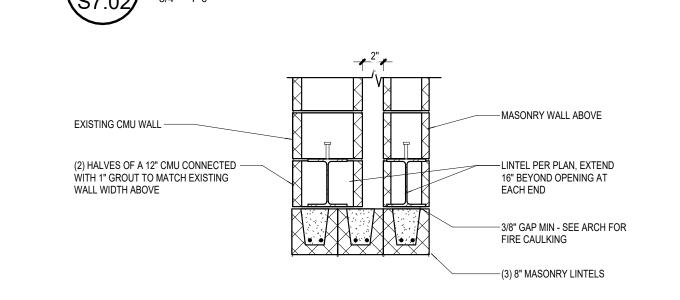


MODIFIED PORTAL FRAME

JOIST BEARING ON MASONRY WALL

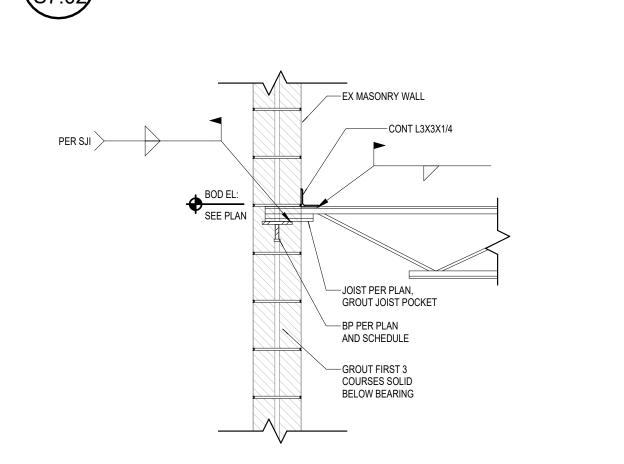

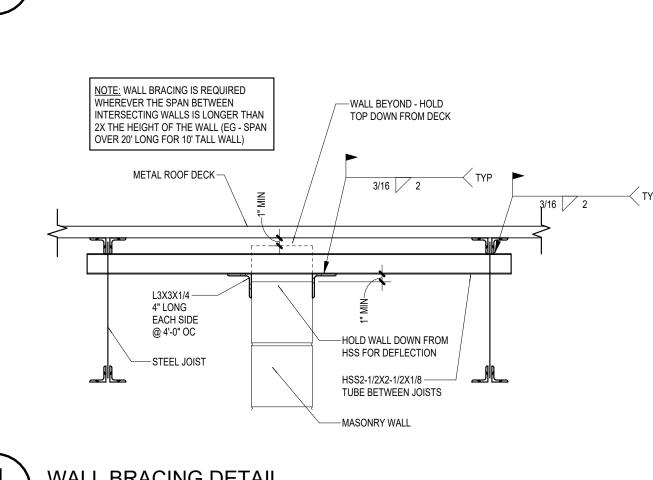

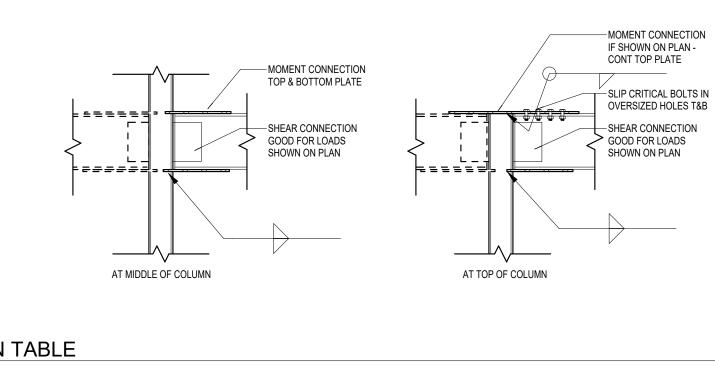



NOTE: LOADS PROVIDED ARE UNFACTORED

MARK | DL MOMENT | SL/LL MOMENT | WL MOMENT | WL AXIAL

1 k-ft

6 k-ft 12 k-ft 5 k

4 k-ft 46 k-ft 6 k


5 k-ft 2 k

PLAN VIEW OF TOP PLATE

MC2 3 k-ft

MC3 1 k-ft

PLAN VIEW OF BOT PLATE

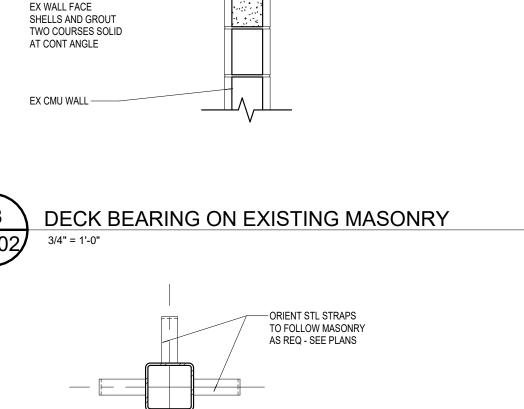



T.O. EXISTING WALL


SEE PLAN

SEE PLAN

BREAK HOLES INTO ---

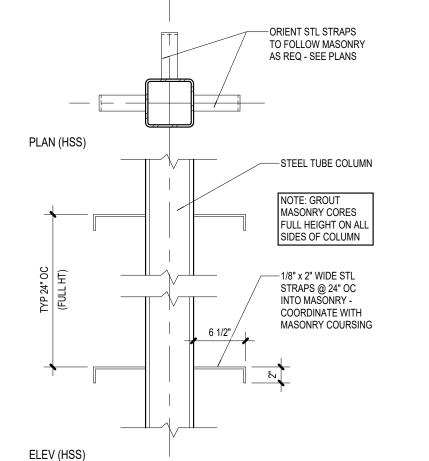

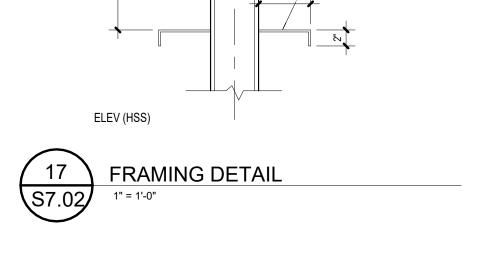

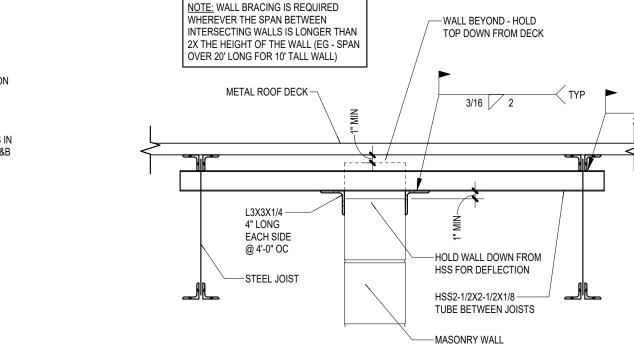

JOIST BEARING ON EX WALL
3/4" = 1'-0"



Maze Design, Inc.


03/17/2025

PROJECT NO. 5-6394

NO PART OF THIS DRAWING MAY BE USED OR REPRODUCED IN ANY FORM OR BY ANY MEANS, OR STORED IN A DATA BASE OR RETRIEVAL SYSTEM, WITHOUT PRIOR WRITTEN PERMISSION OF

GMB COPYRIGHT © 2025 ALL RIGHTS RESERVED

S7.03

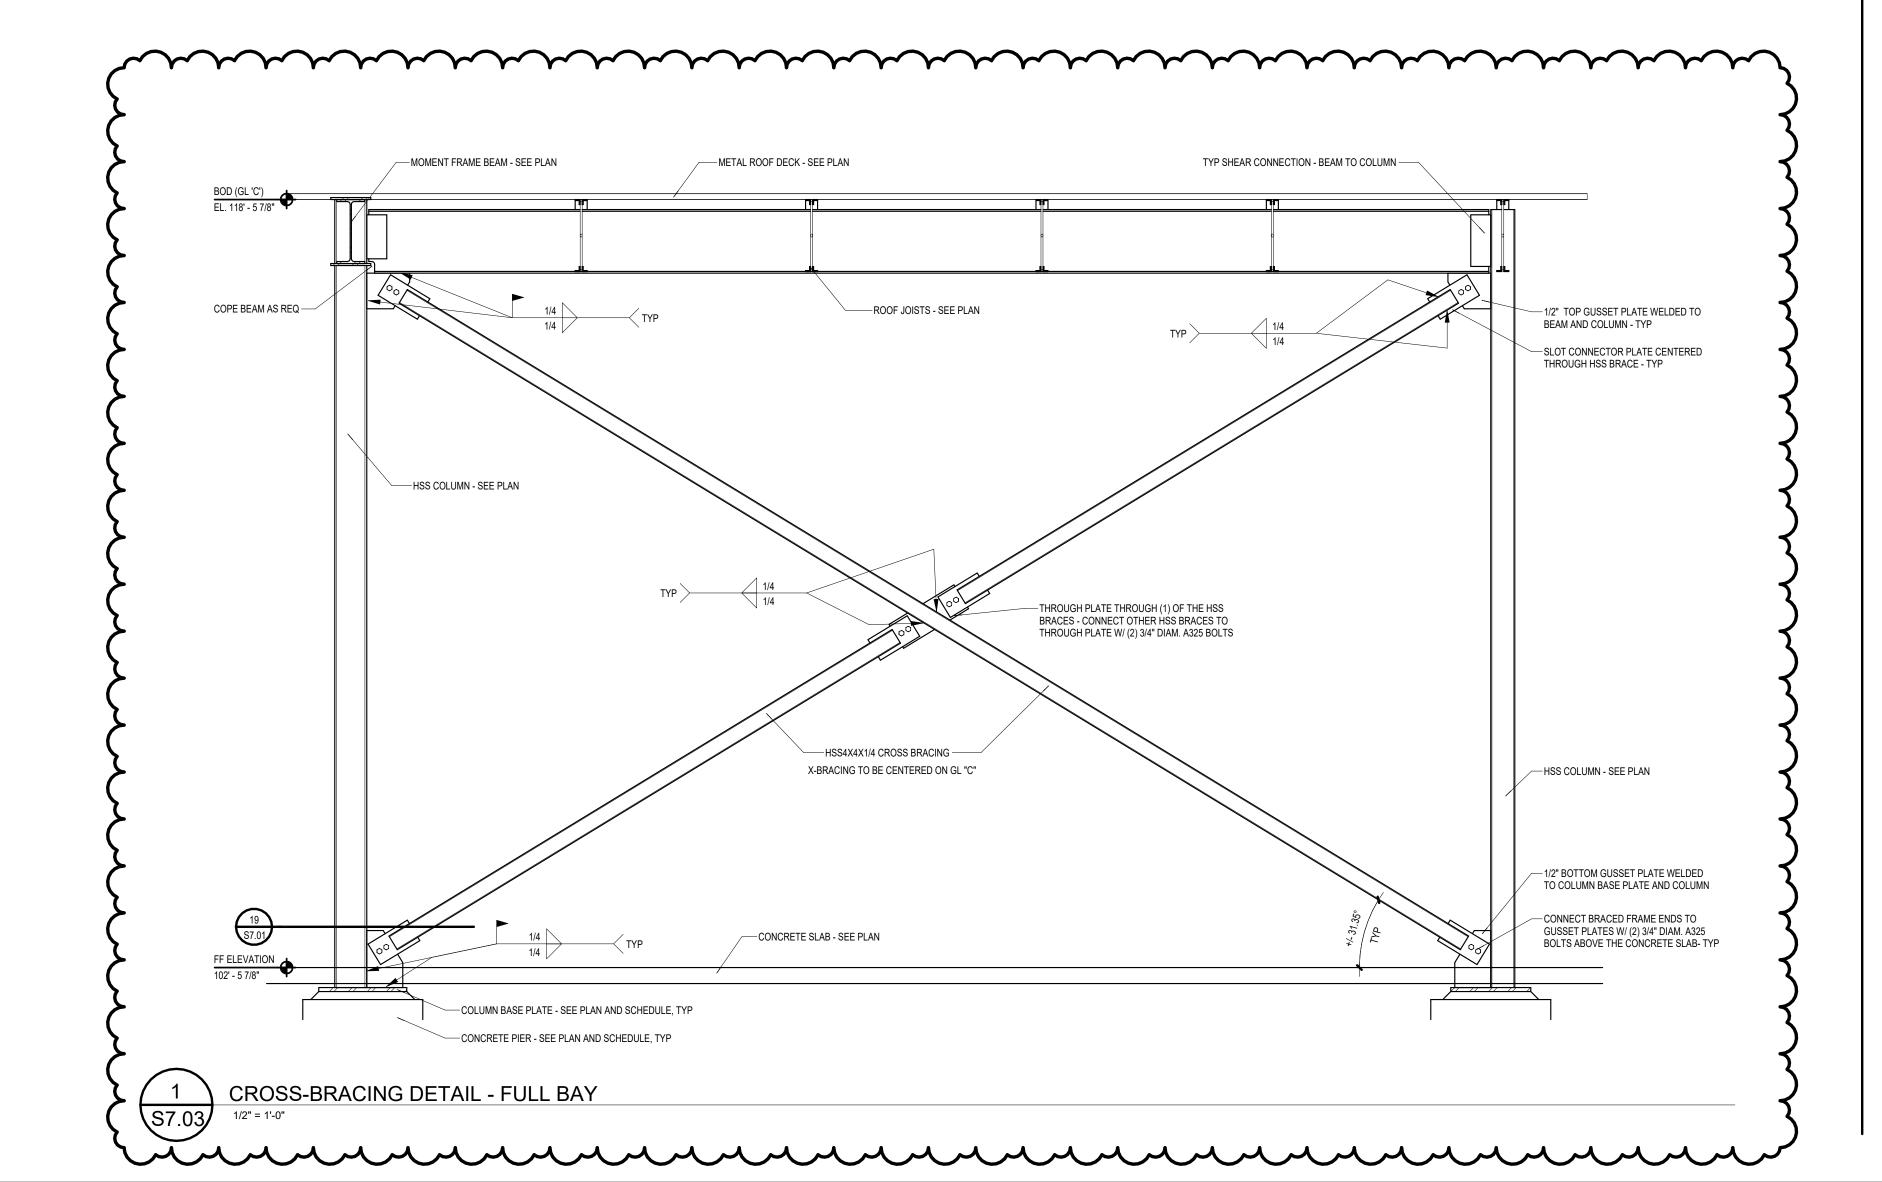

No.

AR11500077

STATE OF

3.18.2025

01.06.2025 BIDS &

01.16.2025 ADDENDUM 001

01.22.2025 ADDENDUM 002 03.13.2025 BULLETIN 001


CONSTRUCTION

DRAWN REVIEWED AGS

PROJECT NO. NO PART OF THIS DRAWING MAY BE USED OR REPRODUCED IN ANY FORM OR BY ANY MEANS, OR STORED IN A DATA BASE OR RETRIEVAL SYSTEM, WITHOUT PRIOR WRITTEN

UNIT 'A' FIRST FLOOF **DEMOLITION PLAN**

GMB COPYRIGHT © 2025 ALL RIGHTS RESERVED

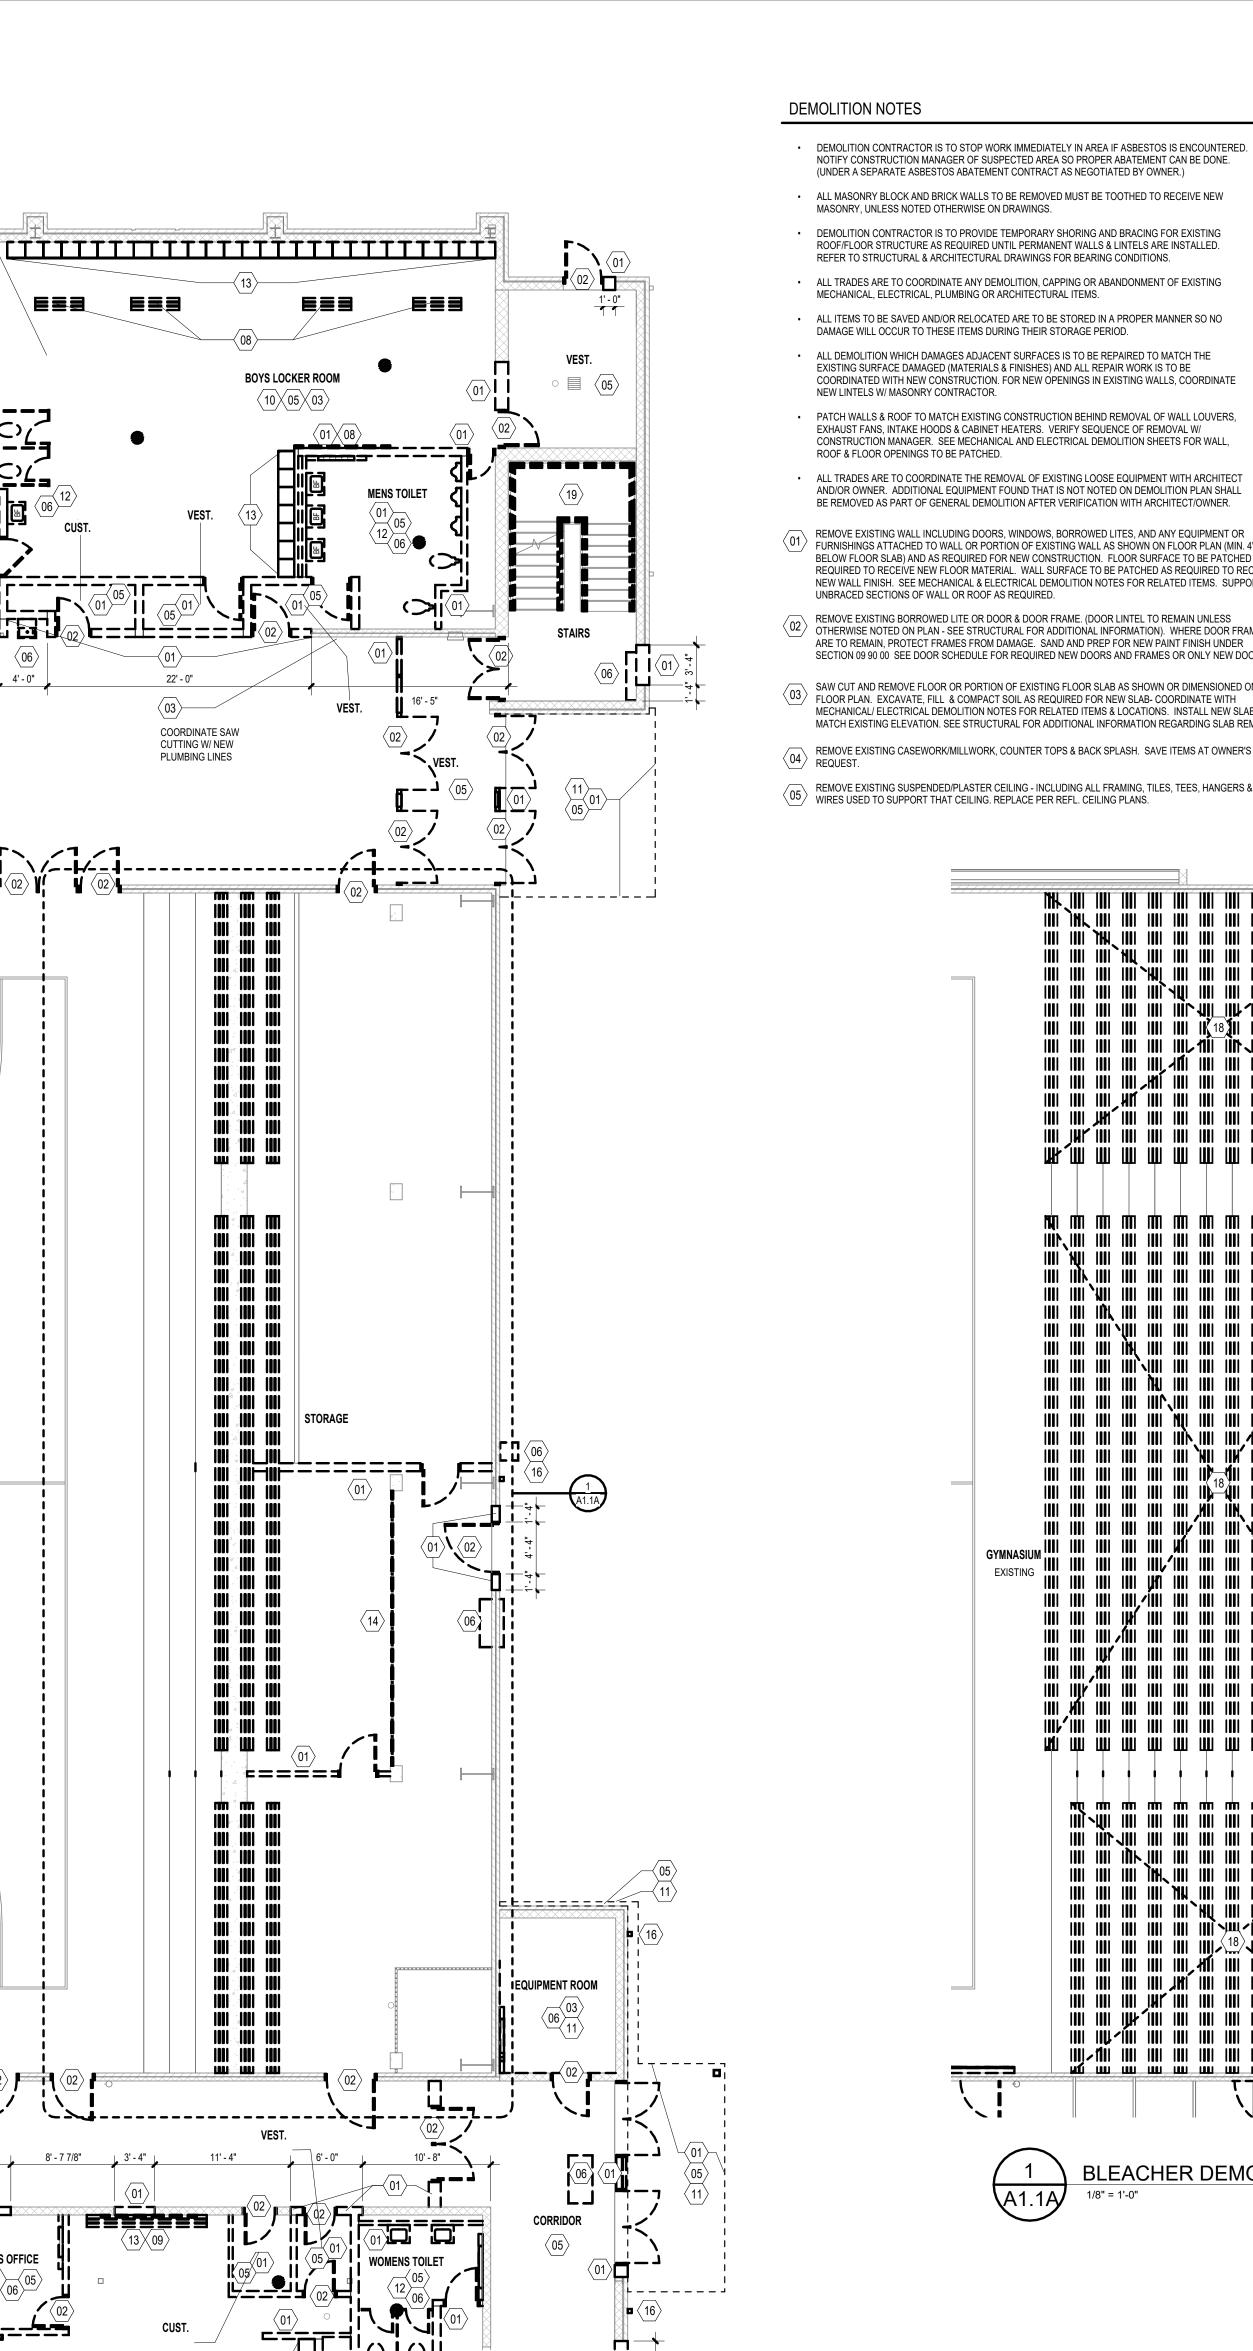

CUTTING W/ NEW

COACHES OFFICE

1' - 6 3/4"3' - 4"

BOYS LOCKER ROOM

 $\langle 10 \rangle \langle 05 \rangle \langle 03 \rangle$

COORDINATE SAW

1007-1001-1001

W W W

GIRLS LOCKER ROOM

CUST.

COACHES OFFICE

12

====

12' - 8"

CONCESSIONS

COACHES OFFICE

16' - 1"

COORDINATE EXTENTS OF

ARCHITECTURE. PROTECT

REMOVED SECTION FOR

GYMNASIUM

SAW CUTTING WITH

ELECTRICAL AND

FINISH FLOOR AND

COACHES OFFICE

SEE MECHANICAL DEMOLITION NOTES FOR REMOVAL OF EXIST. PLUMBING/MECHANICAL (i.e. LAVATORIES, 06 SINKS, WATER CLOSETS, URINALS, FIN TUBE, MECH. DUCTWORK, UNIT VENTS, ETC.)

REMOVE EXISTING WINDOW, WINDOW WALL WITH ALUMINUM FRAMING WITH METAL PANELS BELOW WINDOW, FRAME, SILL & GLAZING INCLUDING ALL EXISTING WOOD BLOCKING AND FRAMING ABOVE WINDOWS TO ROOF AND/OR MASONRY TIES AT BRICK PIERS AND SIDE WALLS.

REMOVE EXISTING EQUIPMENT OR FURNISHINGS SECURED TO FLOOR, WALL OR CEILING AND STORE FOR REMOVE EXISTING CHALK, TACK OR WHITE BOARD. REMOVE ALL GLUE RESIDUE, ETC. FROM BLOCK BEHIND

 $\langle ^{09}
angle$ board and prepare surface for New Finish materials where required. REMOVE EXISTING FLOOR COVERING AND BASE, INCLUDING ALL GLUE RESIDUE, MUDBEDS, ETC. FROM

FLOORS & WALLS AND PREPARE SURFACE FOR NEW FINISH MATERIALS, INCLUDING GRINDING, PATCHING AND/OR SELF-LEVELING COMPOUND AS REQUIRED. WALL & FLOOR SURFACE TO RECEIVE NEW FINISH MATERIAL & PATCH TO MATCH EXISTING. REMOVE PORTION OF EXISTING ROOF & STRUCTURE (AS SHOWN ON DEMOLITION PLAN). PROVIDE

TEMPORARY WEATHER PROTECTION AS NEEDED AROUND PERIMETER OF ROOF REMOVAL AS REQUIRED.

PROVIDE TEMPORARY SHORING & BRACING AS REQUIRED. REMOVE EXISTING TOILET PARTITION, DISPENSERS AND/OR TOILET ACCESSORIES AND REPAIR ADJACENT 12 SURFACES TO RECEIVE NEW FINISHES.

REMOVE EXISTING LOCKERS AND LOCKER BASE. CUT SLOPED LOCKER TOP & BASE AS NECESSARY. 13 RE-USE/RELOCATE EXISTING END PANEL(S) AS REQUIRED. REVISE & PREPARE FOR NEW FINISHES.

REMOVE FENCE AND PREP AFFECTED FLOORS AND WALLS FOR NEW FINISHES. SAVE ITEMS AT OWNER'S REQUEST.

REMOVE EXISTING WINDOW BLINDS. PREP AFFECTED WALLS FOR NEW FINISHES.

REMOVE DOWNSPOUT. CLEAN ADJACENT BRICK.

REMOVE EXISTING BLEACHER STRUCTURE.

REMOVE EXISTING BLEACHER BENCH, AND OTHER FURNISHING ATTACHED TO CONCRETE BLEACHERS. SAVE 18 ITEMS AT OWNER'S REQUEST. PREP FOR INSTALLATION OF NEW BENCHES

(19) REMOVE EXISTING RAILING, AND EQUIPMENT ATTACHED TO RAILING AND PREP FOR NEW RAILING AND EQUIPMENT

DEMOLITION LEGEND

PORTION OF EXISTING WALL TO BE DEMOLISHED

EXISTING WALL TO BE DEMOLISHED

EXISTING OBJECT TO BE DEMOLISHED

EXISTING WALLS TO REMAIN

AREA OF FLOOR CUTTING

EXISTING OBJECTS TO REMAIN

ROOM NAME EXISTING ROOM FINISH INFORMATION:


FLOOR FINISH ROOM NAME, FLOORING TYPE, CEILING TYPE


DEMOLITION TAG: SEE DEMOLITION NOTES

AREA OF CEILING REMOVAL AND REINSTALL

REMOVE AND REPLACE DAMAGED CEILING TILES.


REMOVE EXISTING LOCKERS AND ACCESSORIES FOR NEW FINISH AND RE-INSTALLATION. REFER TO 21 ENLARGED FLOOR PLANS FOR ADDITIONAL INFORMATION

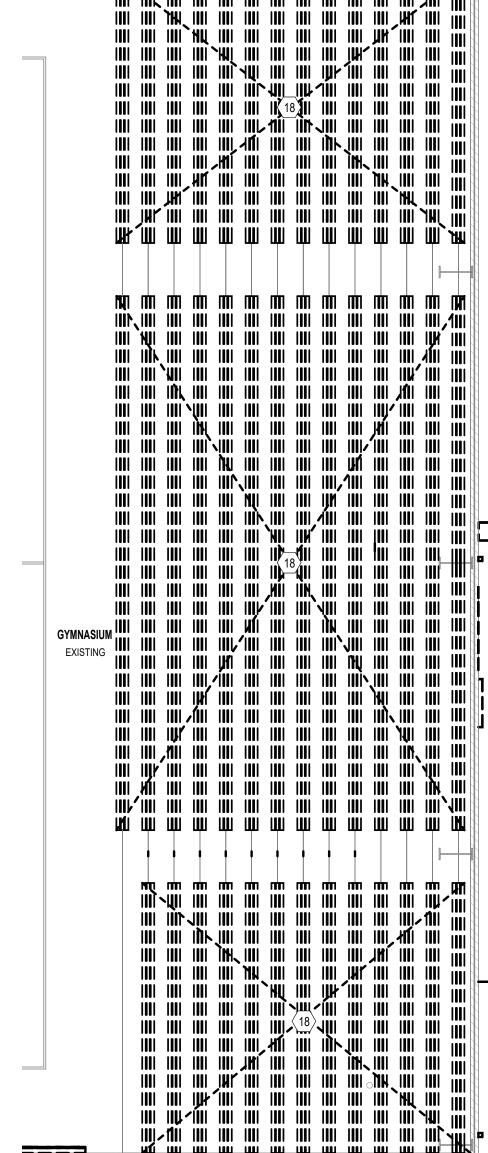

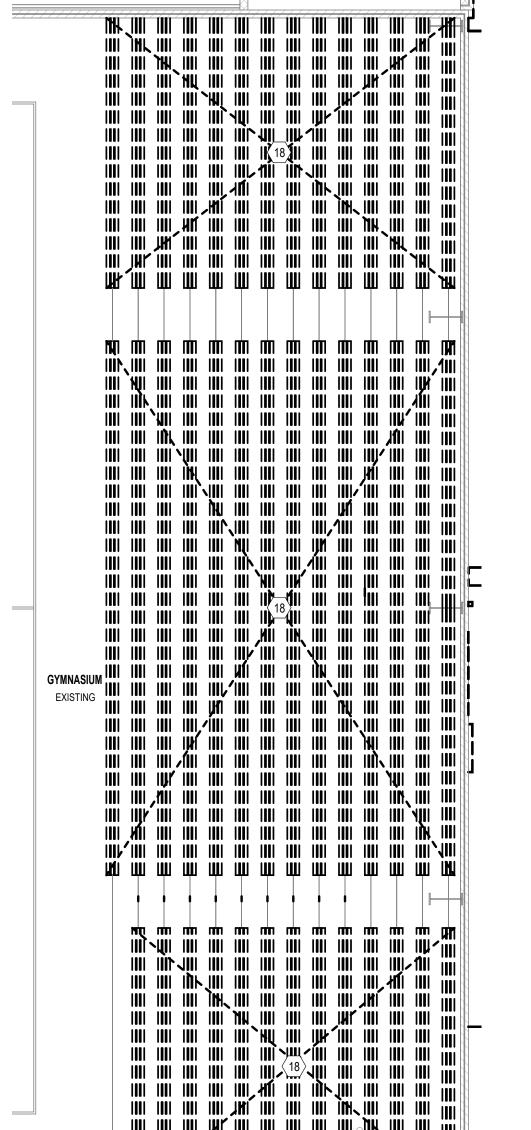

BLEACHER DEMOLITION PLAN

1/8" = 1'-0"

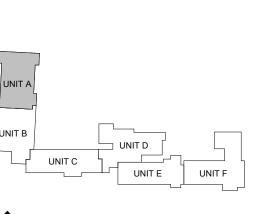



MECHANICAL






VEST.

(UNDER A SEPARATE ASBESTOS ABATEMENT CONTRACT AS NEGOTIATED BY OWNER.) ALL MASONRY BLOCK AND BRICK WALLS TO BE REMOVED MUST BE TOOTHED TO RECEIVE NEW. MASONRY, UNLESS NOTED OTHERWISE ON DRAWINGS.

DEMOLITION CONTRACTOR IS TO PROVIDE TEMPORARY SHORING AND BRACING FOR EXISTING ROOF/FLOOR STRUCTURE AS REQUIRED UNTIL PERMANENT WALLS & LINTELS ARE INSTALLED. REFER TO STRUCTURAL & ARCHITECTURAL DRAWINGS FOR BEARING CONDITIONS. ALL TRADES ARE TO COORDINATE ANY DEMOLITION, CAPPING OR ABANDONMENT OF EXISTING

MECHANICAL, ELECTRICAL, PLUMBING OR ARCHITECTURAL ITEMS. ALL ITEMS TO BE SAVED AND/OR RELOCATED ARE TO BE STORED IN A PROPER MANNER SO NO DAMAGE WILL OCCUR TO THESE ITEMS DURING THEIR STORAGE PERIOD. • ALL DEMOLITION WHICH DAMAGES ADJACENT SURFACES IS TO BE REPAIRED TO MATCH THE EXISTING SURFACE DAMAGED (MATERIALS & FINISHES) AND ALL REPAIR WORK IS TO BE

COORDINATED WITH NEW CONSTRUCTION. FOR NEW OPENINGS IN EXISTING WALLS, COORDINATE NEW LINTELS W/ MASONRY CONTRACTOR. PATCH WALLS & ROOF TO MATCH EXISTING CONSTRUCTION BEHIND REMOVAL OF WALL LOUVERS, EXHAUST FANS, INTAKE HOODS & CABINET HEATERS. VERIFY SEQUENCE OF REMOVAL W/ CONSTRUCTION MANAGER. SEE MECHANICAL AND ELECTRICAL DEMOLITION SHEETS FOR WALL,

ALL TRADES ARE TO COORDINATE THE REMOVAL OF EXISTING LOOSE EQUIPMENT WITH ARCHITECT AND/OR OWNER. ADDITIONAL EQUIPMENT FOUND THAT IS NOT NOTED ON DEMOLITION PLAN SHALL BE REMOVED AS PART OF GENERAL DEMOLITION AFTER VERIFICATION WITH ARCHITECT/OWNER.

FURNISHINGS ATTACHED TO WALL OR PORTION OF EXISTING WALL AS SHOWN ON FLOOR PLAN (MIN. 4" BELOW FLOOR SLAB) AND AS REQUIRED FOR NEW CONSTRUCTION. FLOOR SURFACE TO BE PATCHED AS REQUIRED TO RECEIVE NEW FLOOR MATERIAL. WALL SURFACE TO BE PATCHED AS REQUIRED TO RECEIVE NEW WALL FINISH. SEE MECHANICAL & ELECTRICAL DEMOLITION NOTES FOR RELATED ITEMS. SUPPORT UNBRACED SECTIONS OF WALL OR ROOF AS REQUIRED.

REMOVE EXISTING BORROWED LITE OR DOOR & DOOR FRAME. (DOOR LINTEL TO REMAIN UNLESS OTHERWISE NOTED ON PLAN - SEE STRUCTURAL FOR ADDITIONAL INFORMATION). WHERE DOOR FRAMES ARE TO REMAIN, PROTECT FRAMES FROM DAMAGE. SAND AND PREP FOR NEW PAINT FINISH UNDER SECTION 09 90 00 SEE DOOR SCHEDULE FOR REQUIRED NEW DOORS AND FRAMES OR ONLY NEW DOORS.

SAW CUT AND REMOVE FLOOR OR PORTION OF EXISTING FLOOR SLAB AS SHOWN OR DIMENSIONED ON FLOOR PLAN. EXCAVATE, FILL & COMPACT SOIL AS REQUIRED FOR NEW SLAB- COORDINATE WITH MECHANICAL/ ELECTRICAL DEMOLITION NOTES FOR RELATED ITEMS & LOCATIONS. INSTALL NEW SLAB TO MATCH EXISTING ELEVATION. SEE STRUCTURAL FOR ADDITIONAL INFORMATION REGARDING SLAB REMOVAL.

REMOVE EXISTING CASEWORK/MILLWORK, COUNTER TOPS & BACK SPLASH. SAVE ITEMS AT OWNER'S

REMOVE EXISTING SUSPENDED/PLASTER CEILING - INCLUDING ALL FRAMING, TILES, TEES, HANGERS & wires used to support that ceiling. Replace per Refl. Ceiling Plans.

01.06.2025 BIDS & CONSTRUCTION 03.13.2025 BULLETIN 001

DRAWN

REVIEWED AGS

NO PART OF THIS DRAWING MAY BE USED OR REPRODUCED IN ANY FORM OR BY ANY MEANS, OR STORED IN A DATA BASE OR RETRIEVAL SYSTEM, WITHOUT PRIOR WRITTEN

GMB COPYRIGHT © 2025 ALL RIGHTS RESERVED

UNIT 'A' FIRST FLOOR FLOOR **CUTTING PLAN**

PROJECT NO.

AR11500077

STATE OF

3.18.2025

DEMOLITION CONTRACTOR IS TO STOP WORK IMMEDIATELY IN AREA IF ASBESTOS IS ENCOUNTERED. NOTIFY CONSTRUCTION MANAGER OF SUSPECTED AREA SO PROPER ABATEMENT CAN BE DONE. (UNDER A SEPARATE ASBESTOS ABATEMENT CONTRACT AS NEGOTIATED BY OWNER.) ALL MASONRY BLOCK AND BRICK WALLS TO BE REMOVED MUST BE TOOTHED TO RECEIVE NEW.

MASONRY, UNLESS NOTED OTHERWISE ON DRAWINGS. DEMOLITION CONTRACTOR IS TO PROVIDE TEMPORARY SHORING AND BRACING FOR EXISTING

DEMOLITION NOTES

ROOF/FLOOR STRUCTURE AS REQUIRED UNTIL PERMANENT WALLS & LINTELS ARE INSTALLED. REFER TO STRUCTURAL & ARCHITECTURAL DRAWINGS FOR BEARING CONDITIONS.

 ALL TRADES ARE TO COORDINATE ANY DEMOLITION, CAPPING OR ABANDONMENT OF EXISTING MECHANICAL, ELECTRICAL, PLUMBING OR ARCHITECTURAL ITEMS. ALL ITEMS TO BE SAVED AND/OR RELOCATED ARE TO BE STORED IN A PROPER MANNER SO NO DAMAGE WILL OCCUR TO THESE ITEMS DURING THEIR STORAGE PERIOD.

 ALL DEMOLITION WHICH DAMAGES ADJACENT SURFACES IS TO BE REPAIRED TO MATCH THE EXISTING SURFACE DAMAGED (MATERIALS & FINISHES) AND ALL REPAIR WORK IS TO BE COORDINATED WITH NEW CONSTRUCTION. FOR NEW OPENINGS IN EXISTING WALLS, COORDINATE NEW LINTELS W/ MASONRY CONTRACTOR.


PATCH WALLS & ROOF TO MATCH EXISTING CONSTRUCTION BEHIND REMOVAL OF WALL LOUVERS, EXHAUST FANS, INTAKE HOODS & CABINET HEATERS. VERIFY SEQUENCE OF REMOVAL W/ CONSTRUCTION MANAGER. SEE MECHANICAL AND ELECTRICAL DEMOLITION SHEETS FOR WALL, ROOF & FLOOR OPENINGS TO BE PATCHED.


 ALL TRADES ARE TO COORDINATE THE REMOVAL OF EXISTING LOOSE EQUIPMENT WITH ARCHITECT AND/OR OWNER. ADDITIONAL EQUIPMENT FOUND THAT IS NOT NOTED ON DEMOLITION PLAN SHALL BE REMOVED AS PART OF GENERAL DEMOLITION AFTER VERIFICATION WITH ARCHITECT/OWNER.

REMOVE EXISTING WALL INCLUDING DOORS, WINDOWS, BORROWED LITES, AND ANY EQUIPMENT OR

- FURNISHINGS ATTACHED TO WALL OR PORTION OF EXISTING WALL AS SHOWN ON FLOOR PLAN (MIN. 4" BELOW FLOOR SLAB) AND AS REQUIRED FOR NEW CONSTRUCTION. FLOOR SURFACE TO BE PATCHED AS REQUIRED TO RECEIVE NEW FLOOR MATERIAL. WALL SURFACE TO BE PATCHED AS REQUIRED TO RECEIVE NEW WALL FINISH. SEE MECHANICAL & ELECTRICAL DEMOLITION NOTES FOR RELATED ITEMS. SUPPORT UNBRACED SECTIONS OF WALL OR ROOF AS REQUIRED.
- REMOVE EXISTING BORROWED LITE OR DOOR & DOOR FRAME. (DOOR LINTEL TO REMAIN UNLESS OTHERWISE NOTED ON PLAN SEE STRUCTURAL FOR ADDITIONAL INFORMATION). WHERE DOOR FRAMES ARE TO REMAIN, PROTECT FRAMES FROM DAMAGE. SAND AND PREP FOR NEW PAINT FINISH UNDER SECTION 09 90 00 SEE DOOR SCHEDULE FOR REQUIRED NEW DOORS AND FRAMES OR ONLY NEW DOORS.
- SAW CUT AND REMOVE FLOOR OR PORTION OF EXISTING FLOOR SLAB AS SHOWN OR DIMENSIONED ON FLOOR PLAN. EXCAVATE, FILL & COMPACT SOIL AS REQUIRED FOR NEW SLAB- COORDINATE WITH MECHANICAL/ ELECTRICAL DEMOLITION NOTES FOR RELATED ITEMS & LOCATIONS. INSTALL NEW SLAB TO MATCH EXISTING ELEVATION. SEE STRUCTURAL FOR ADDITIONAL INFORMATION REGARDING SLAB REMOVAL.
- REMOVE EXISTING CASEWORK/MILLWORK, COUNTER TOPS & BACK SPLASH. SAVE ITEMS AT OWNER'S REQUEST.
- REMOVE EXISTING SUSPENDED/PLASTER CEILING INCLUDING ALL FRAMING, TILES, TEES, HANGERS & WIRES USED TO SUPPORT THAT CEILING. REPLACE PER REFL. CEILING PLANS.

- SEE MECHANICAL DEMOLITION NOTES FOR REMOVAL OF EXIST. PLUMBING/MECHANICAL (i.e. LAVATORIES, SINKS, WATER CLOSETS, URINALS, FIN TUBE, MECH. DUCTWORK, UNIT VENTS, ETC.)
- REMOVE EXISTING WINDOW, WINDOW WALL WITH ALUMINUM FRAMING WITH METAL PANELS BELOW $\langle 07 \rangle$ window, frame, sill & glazing including all existing wood blocking and framing above
- WINDOWS TO ROOF AND/OR MASONRY TIES AT BRICK PIERS AND SIDE WALLS. REMOVE EXISTING EQUIPMENT OR FURNISHINGS SECURED TO FLOOR, WALL OR CEILING AND STORE FOR REUSE BY OWNER.
- REMOVE EXISTING CHALK, TACK OR WHITE BOARD. REMOVE ALL GLUE RESIDUE, ETC. FROM BLOCK BEHIND BOARD AND PREPARE SURFACE FOR NEW FINISH MATERIALS WHERE REQUIRED.
- REMOVE EXISTING FLOOR COVERING AND BASE, INCLUDING ALL GLUE RESIDUE, MUDBEDS, ETC. FROM FLOORS & WALLS AND PREPARE SURFACE FOR NEW FINISH MATERIALS, INCLUDING GRINDING, PATCHING AND/OR SELF-LEVELING COMPOUND AS REQUIRED. WALL & FLOOR SURFACE TO RECEIVE NEW FINISH MATERIAL & PATCH TO MATCH EXISTING.
- REMOVE PORTION OF EXISTING ROOF & STRUCTURE (AS SHOWN ON DEMOLITION PLAN). PROVIDE 11 TEMPORARY WEATHER PROTECTION AS NEEDED AROUND PERIMETER OF ROOF REMOVAL AS REQUIRED.
- PROVIDE TEMPORARY SHORING & BRACING AS REQUIRED. REMOVE EXISTING TOILET PARTITION, DISPENSERS AND/OR TOILET ACCESSORIES AND REPAIR ADJACENT SURFACES TO RECEIVE NEW FINISHES.
- REMOVE EXISTING LOCKERS AND LOCKER BASE. CUT SLOPED LOCKER TOP & BASE AS NECESSARY. RE-USE/RELOCATE EXISTING END PANEL(S) AS REQUIRED. REVISE & PREPARE FOR NEW FINISHES.
- REMOVE FENCE AND PREP AFFECTED FLOORS AND WALLS FOR NEW FINISHES. SAVE ITEMS AT OWNER'S REQUEST.
- REMOVE EXISTING WINDOW BLINDS. PREP AFFECTED WALLS FOR NEW FINISHES.
- REMOVE DOWNSPOUT. CLEAN ADJACENT BRICK.
- REMOVE EXISTING BLEACHER STRUCTURE.
- REMOVE EXISTING BLEACHER BENCH, AND OTHER FURNISHING ATTACHED TO CONCRETE BLEACHERS. SAVE ITEMS AT OWNER'S REQUEST. PREP FOR INSTALLATION OF NEW BENCHES
- REMOVE EXISTING RAILING, AND EQUIPMENT ATTACHED TO RAILING AND PREP FOR NEW RAILING AND EQUIPMENT
- REMOVE AND REPLACE DAMAGED CEILING TILES.
- REMOVE EXISTING LOCKERS AND ACCESSORIES FOR NEW FINISH AND RE-INSTALLATION. REFER TO (21) ENLARGED FLOOR PLANS FOR ADDITIONAL INFORMATION

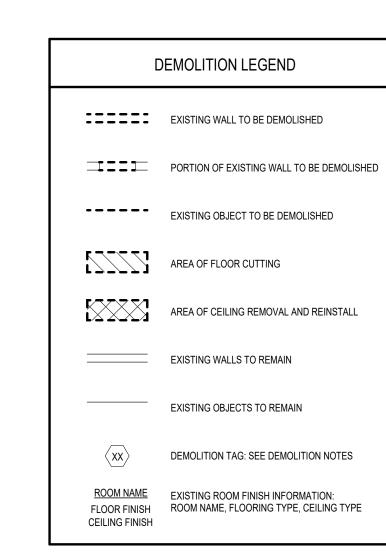

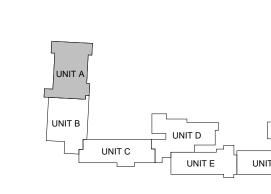



STORAGE

BOYS LOCKER ROOM

MECHANICAL

++++++++

CONCESSIONS

2' - 6" 2' - 8 1/2". 3' - 6" 2' - 8 1/2". 3' - 3"

COACHES OFFICE

GIRLS LOCKER ROOM

┍╃╾╼┪┍╼╼╼

GIRLS LOCKER ROOM

╱╱╱╱╱╱

BOYS LOCKER ROOM

EQUIPMENT ROOM

AR11500077

3.18.2025

STATE OF

01.06.2025 BIDS &


01.22.2025 ADDENDUM 002 03.13.2025 BULLETIN 001

CONSTRUCTION

REVIEWED AGS PROJECT NO. NO PART OF THIS DRAWING MAY BE USED OR REPRODUCED IN ANY FORM OR BY ANY MEANS, OR STORED IN A DATA BASE OR RETRIEVAL SYSTEM, WITHOUT PRIOR WRITTEN

UNIT 'A' FIRST FLOOR PLAN

GMB COPYRIGHT © 2025 ALL RIGHTS RESERVED

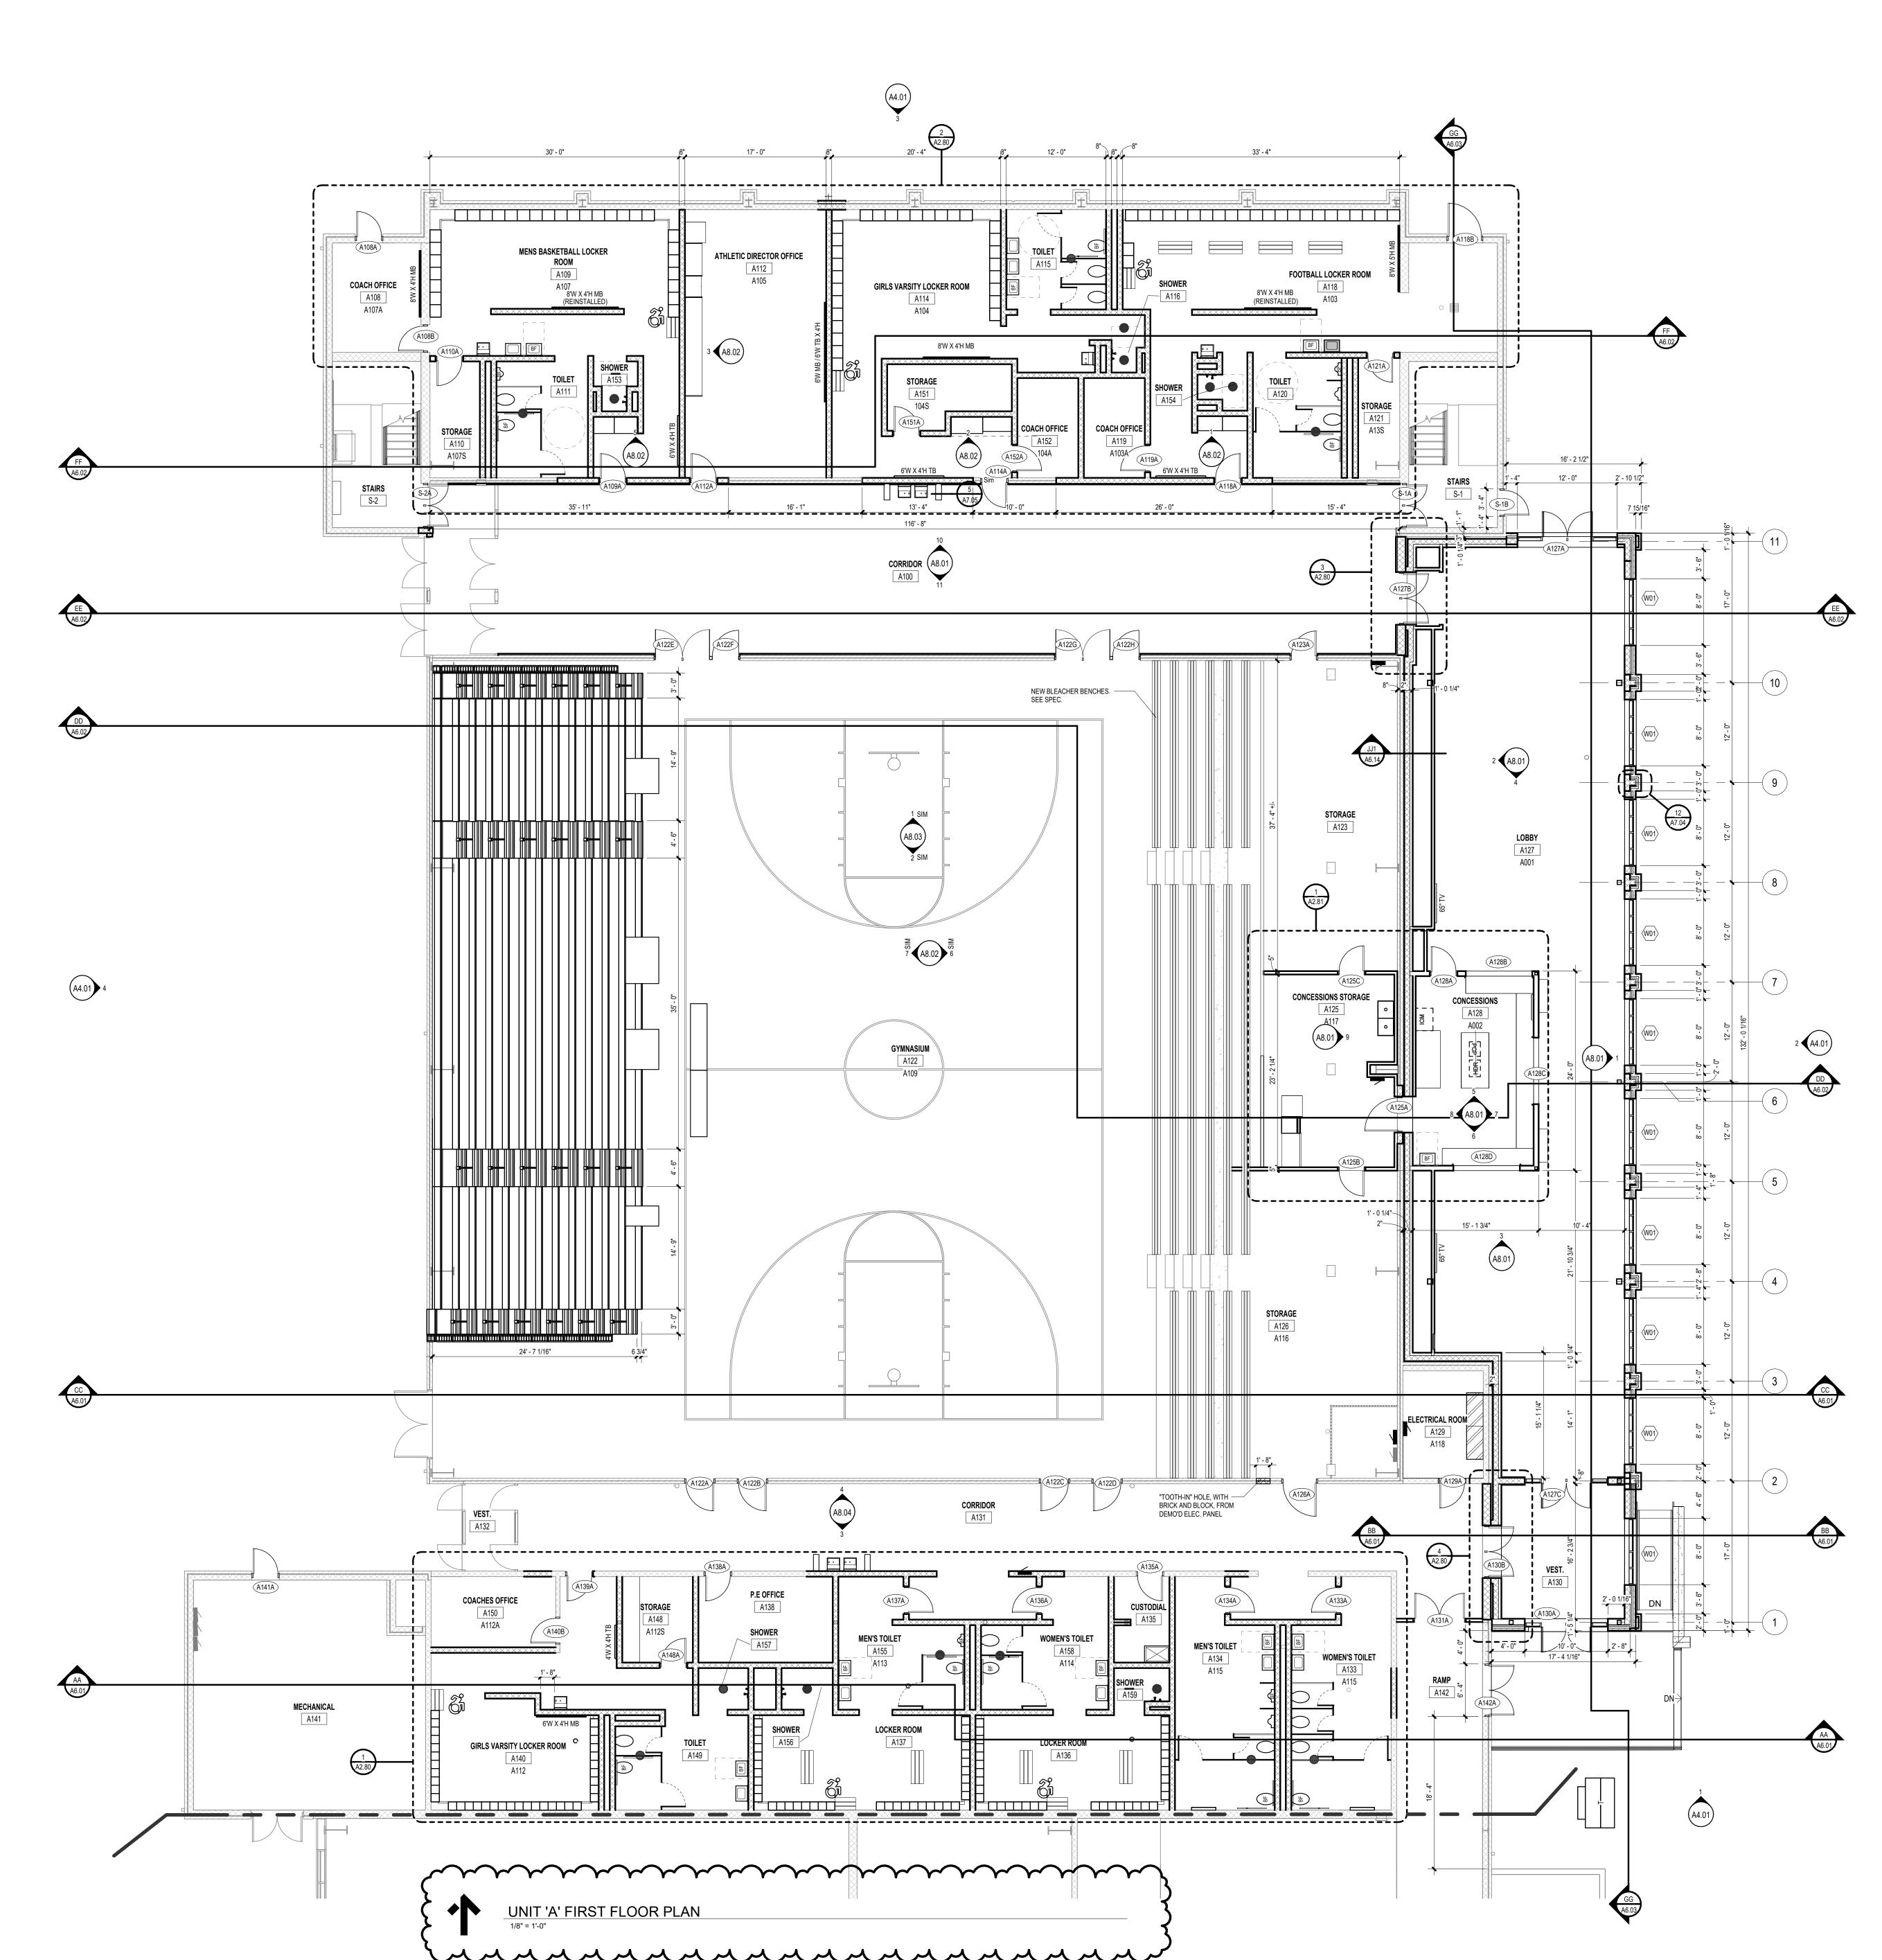

GENERAL FLOOR PLAN NOTES:

1. DIMENSIONS GIVEN ARE TO THE FACE OF MASONRY UNITS OR TO THE FINISHED FACE OF METAL STUD PARTITION WALLS.

2. REFERENCE STRUCTURAL DRAWINGS FOR CONCRETE SLAB SIZES AND SLAB RELATED INFORMATION.

- 3. INTERIOR STUD WALLS ARE TO USE 3 5/8" METAL STUD FRAMING UNLESS OTHERWISE NOTED.
- 4. TURN UP VAPOR RETARDER MATERIAL AT JOINTS BETWEEN FLOOR SLAB AND FOUNDATION WALL UNLESS NOTED
- 5. SEE FOUNDATION PLANS FOR FLOOR SLAB RECESSES FOR TILE, WOOD FLOOR, ETC. (VERIFY RECESS REQUIRED BY MFR.)
- 6. EXTEND ALL INTERIOR WALL PARTITIONS (MASONRY OR STUDS) TO BOTTOM OF DECK ABOVE UNLESS NOTED OTHERWISE. 7. REFERENCE STRUCTURAL, MECHANICAL, PLUMBING AND ELECTRICAL FOR ITEMS NOT SHOWN. COORDINATE AS REQUIRED
- INCLUDING NECESSARY FRAMING, BLOCKING, ETC. 8. FIELD VERIFY ALL DIMENSIONS PRIOR TO FABRICATION OF ANY CABINETRY, FRAMES, STRUCTURAL ITEMS, ETC.
- 9. PROVIDE PAINTED ACCESS PANELS IN WALLS AND CEILINGS TO PROVIDE ACCESS TO CONCEALED ITEMS INCLUDING BUT NOT LIMITED TO VALVES, CONTROLS, MECH. EQUIPMENT, ETC. ACCESS PANELS MAY NOT ALWAYS BE SHOWN ON PLANS. IT IS THE SUB-CONTRACTOR RESPONSIBILITY TO DETERMINE LOCATIONS. COORDINATE LOCATIONS WITH OTHER GENERAL CONTRACTOR / SITE SUPERVISOR.
- 10. COORDINATE WALLS WITH COLUMNS AND OTHER ENCASED ITEMS. COLUMNS ARE TO BE CONTAINED WITHIN WALLS. THE FRAMING CONTRACTOR SHALL INCREASE FRAMING SIZE TO ACCOMMODATE COLUMNS, DRAIN LEADERS, PIPING, ELECTRICAL PANELS, ETC. WHERE WALLS REQUIRE EXTRA WIDTH THE ENTIRE WALL SHALL BE WIDENED UNLESS
- 11. ALL GUARDRAILS AND HANDRAILS SHALL BE FABRICATED AND INSTALLED IN ACCORDANCE WITH ALL REQUIREMENTS OF THE 2015 M.B.C., ANSI ICC A117.1-2009 & AMERICANS WITH DISABILITIES ACT GUIDELINES. THE MOST STRINGENT SHALL
- 12. PROVIDE MINIMUM CLEARANCES AT ALL DOORS PER DETAILS. SEE G0.01 FOR REQUIREMENTS.
- 13. FOR ALL CABINETRY, SEE INTERIOR ELEVATIONS FOR LAYOUTS. FIELD VERIFY CLEAR WIDTHS PRIOR TO FABRICATION.
- 14. ALL EXTERIOR BLOCK CORNERS ARE TO BE BULLNOSE BLOCK EXCEPT CONCRETE BLOCK COLUMNS, PIERS AND WALLS TO RECEIVE TILE UNLESS NOTED OTHERWISE.


15. CONTRACTOR TO MAINTAIN / REPAIR RATING OF EXISTING PARTITIONS AS AFFECTED BY DEMOLITION / NEW

CONSTRUCTION. TYPICAL THROUGHOUT. 16. SEAL ALL PENETRATIONS IN FIRE RATED FLOORS AND WALLS WITH APPROVED FIRESTOPPING.

B. ALL EXTERIOR WALLS SHALL RECEIVE A MINIMUM REINFORCING OF R1-5-48.

- 17. WHERE SPECIALTY BLOCK IS REQUIRED AT THE SAME HEIGHT ON BOTH SIDES OF A WALL USE (2) SPECIALTY BLOCKS BACK TO BACK TO MAINTAIN THE FINISHED WALL APPEARANCE BOTH SIDES OF THE WALL. COORDINATE WITH STRUCTURAL FOR
- LINTELS CONDITIONS PER SPECIFICATIONS. 18. WALLS TO BE PATCHED WITH LIKE MATERIALS WHERE EXISTING WALLS HAVE BEEN COMPROMISED FROM DEMOLITION. THIS SHALL INCLUDE, BUT NOT BE LIMITED TO REMOVAL AND REINSTALLATION OF CASEWORK AND WALL MOUNTED EQUIPMENT IN ORDER TO ACHIEVE SAID PATCH. IN AREAS WHERE BLOCK OR BRICK HAVE BEEN USED, NEW MASONRY TO BE TOOTHED IN AND MATCH EXISTING. AREAS AND FINISHES IN QUESTION SHALL BE COORDINATED WITH
- 19. SEE STRUCTURAL FRAMING PLANS FOR ADDITIONAL WALL REINFORCING REQUIREMENTS. MINIMUM REINFORCING (FOR ALL WALLS NOT OTHERWISE NOTED ON STRUCTURAL PLANS): A. ALL BEARING WALLS SHALL RECEIVE A MINIMUM REINFORCING OF R1-5-48.


C. ALL INTERIOR NON-BEARING WALLS OVER 16'-0" HIGH SHALL RECEIVE A MINIMUM REINFORCING OF R1-5-48.

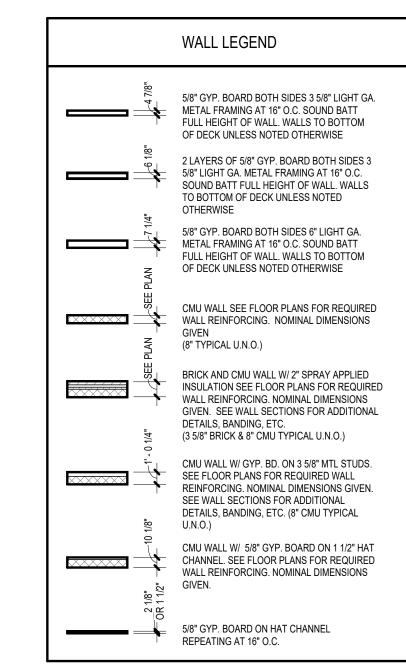

-FIRE RATINGS AS CALLED FOR ON CODE COMPLIANCE PLAN -DIMENSIONS GIVEN ARE TO THE FINISHED FACE OF CMU OR GYPSUM WALL BOARD UNLESS NOTED OTHERWISE


FLOOR PLAN KEYNOTES

- 101 TOOTH-IN NEW CMU AND OR BRICK
- 02 INFILL WITH GYP. & MTL. STUDS
- 4' 0" TALL BLOCK WALL

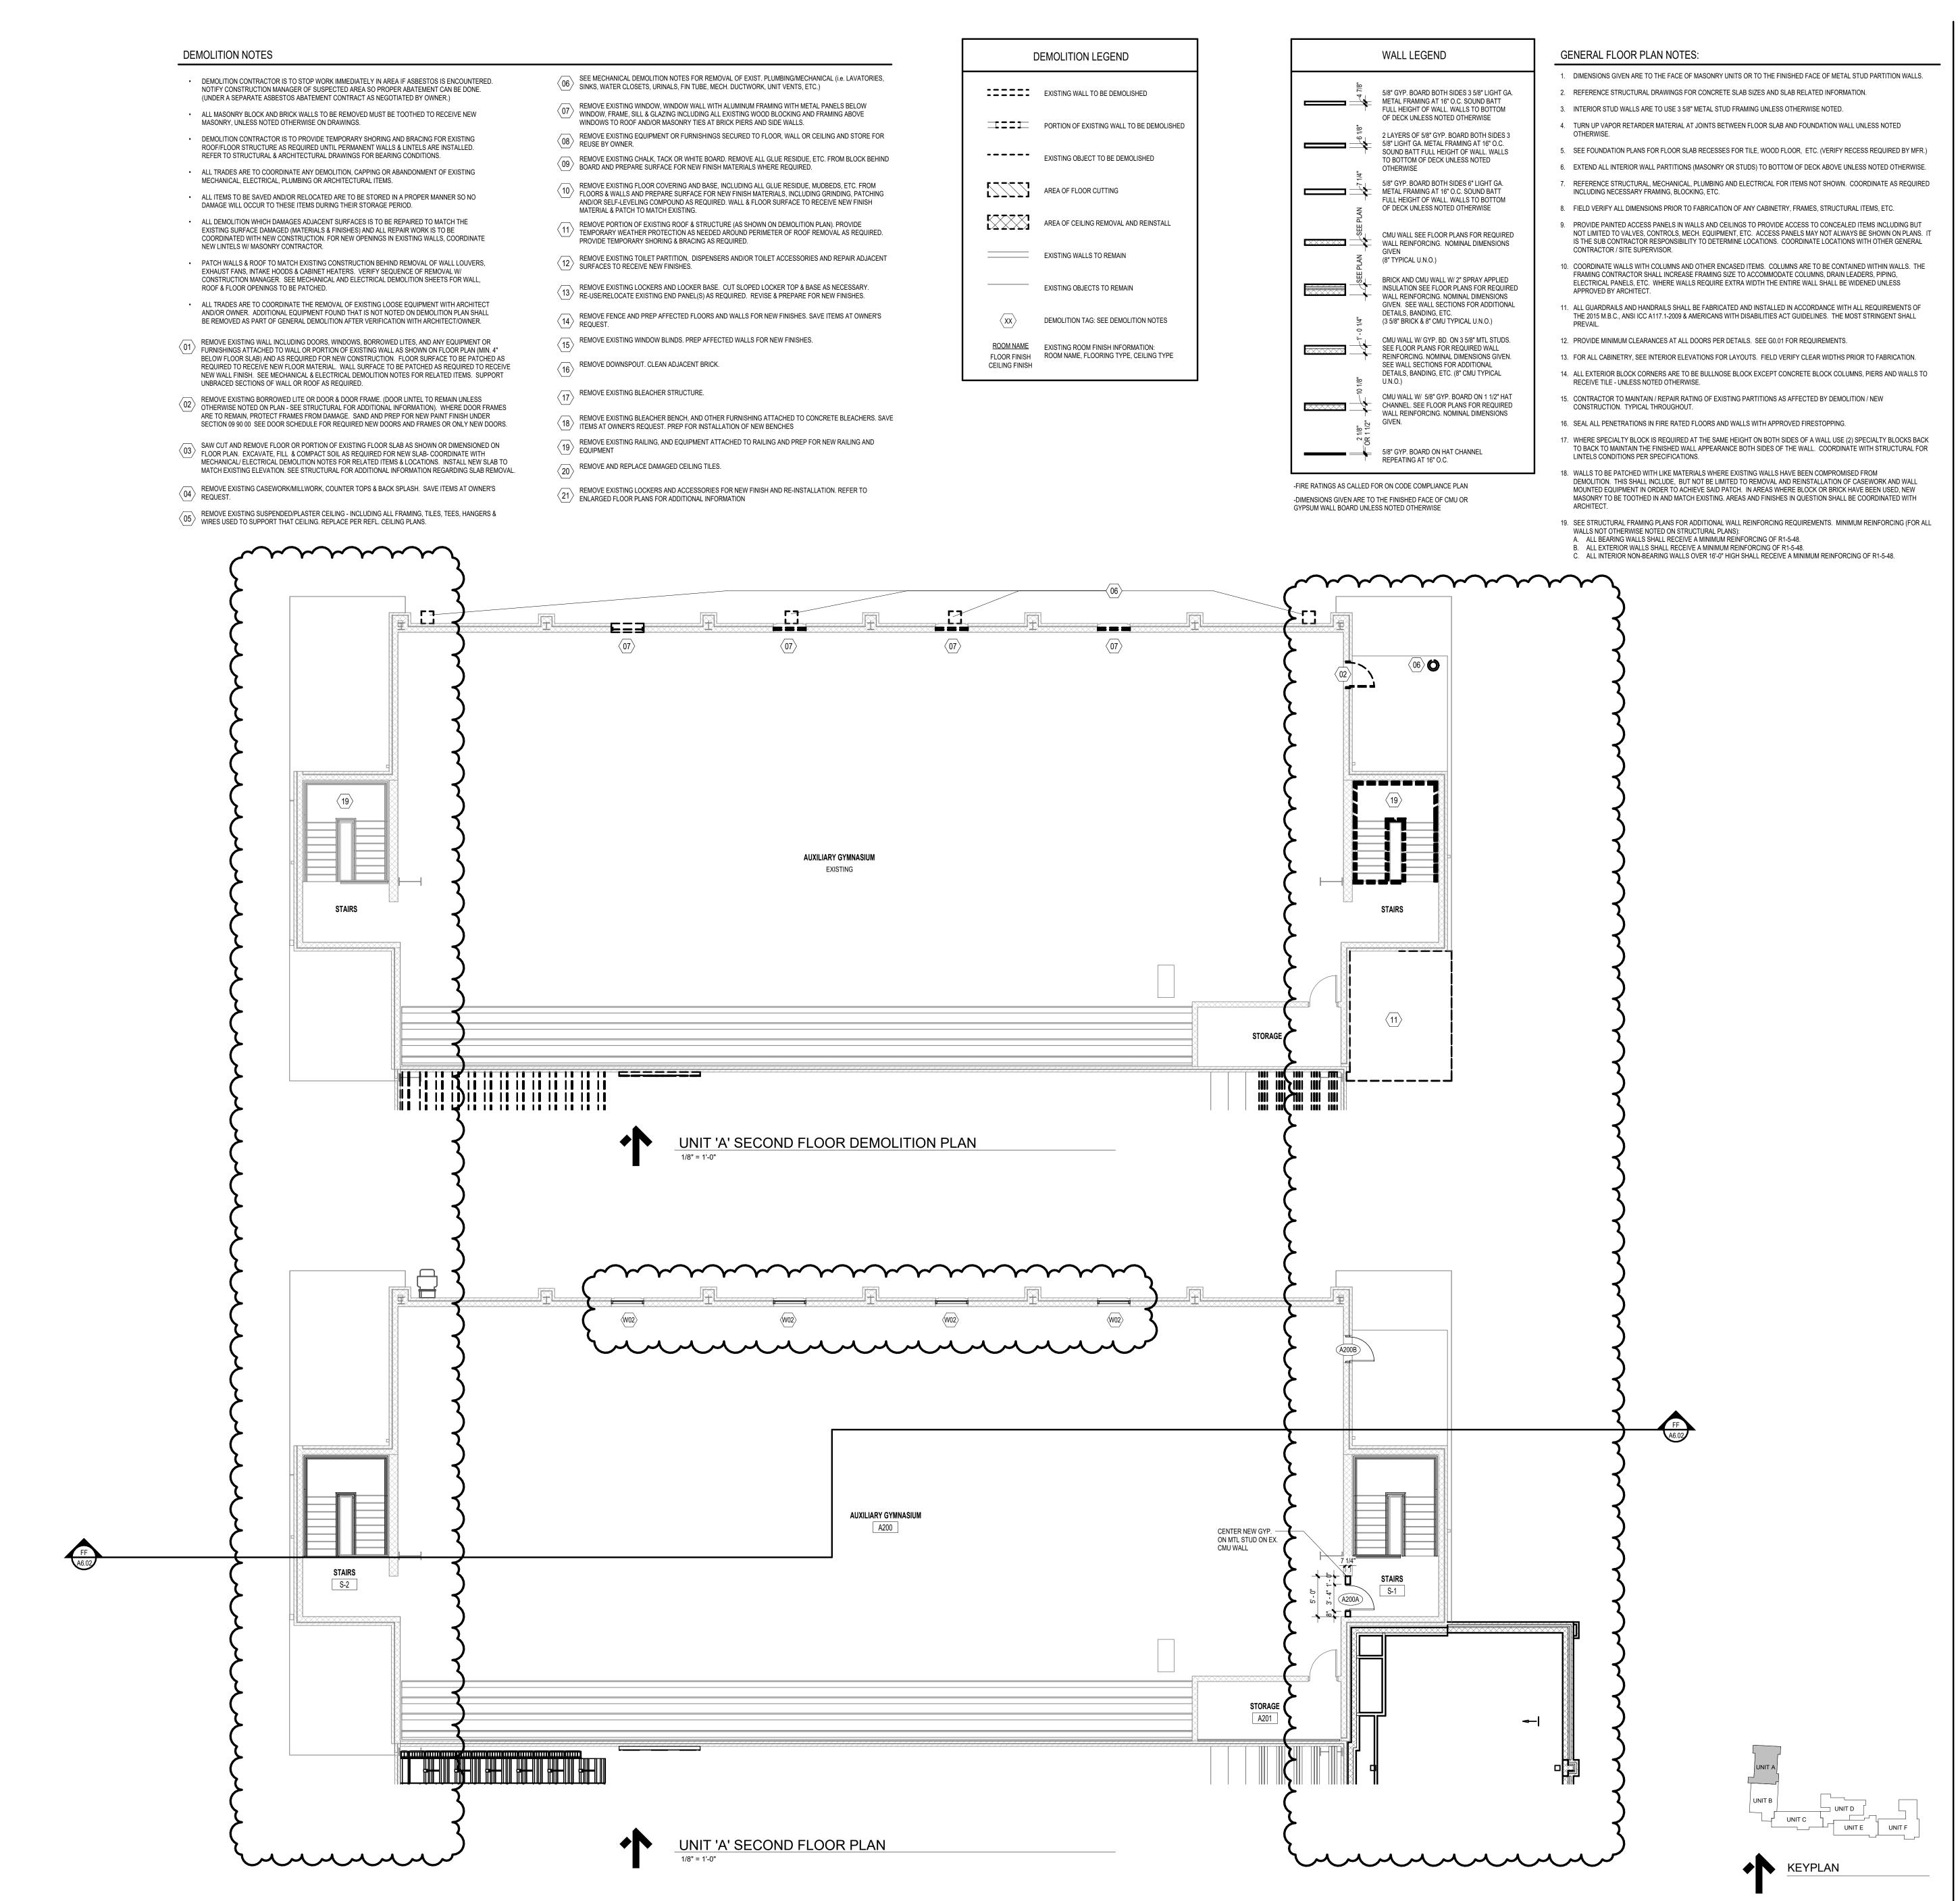

gmb

Maze Design, Inc

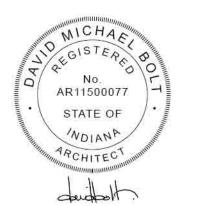

3 18 2025

3.10.2023

CKAGE #1

ERN WAYNE SCHOOL

ISSUANCES

01.06.2025 BIDS & CONSTRUCTION

03.13.2025 BULLETIN 001

DRAWN JMD
REVIEWED AGS

PROJECT NO. 5-6394


NO PART OF THIS DRAWING MAY BE USED OR REPRODUCED IN ANY FORM OR BY ANY MEANS, OR STORED IN A DATA BASE OR RETRIEVAL SYSTEM, WITHOUT PRIOR WRITTEN PERMISSION OF

GMB COPYRIGHT © 2025

UNIT 'A' SECOND FLOOR PLANS

ALL RIGHTS RESERVED

A2.2A

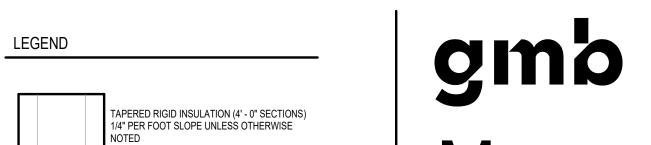

TAPERED RIGID INSULATION (4' - 0" SECTIONS @ 1/2" SLOPE PER FOOT AT CRICKETS) CRICKETS SLOPE TO ROOF DRAINS.

DIRECTION OF STRUCTURAL ROOF SLOPE. (SEE STRUCTURAL PLANS FOR ROOF FRAMING SLOPES)

STANDARD ROOF DRAIN

- ROOF DRAIN NUMBER

THICKNESS OF TAPERED INSULATION AT PERIMETER OR DRAIN (NOT INCLUDING BASE INSULATION THICKNESS)

— ROOF DRAIN NUMBER

— ROOF AREA (SEE ROOF KEYPLAN)

— RD OR ORD

— C OR NOTHING

ROOF DRAIN LABEL

CR#1 CORE SAMPLE LOCATIONS SEE LEGEND FOR DESCRIPTION

ROOF HATCH

MATERIAL)

ROOF WALKWAY PAD (SEE SPEC. FOR

SLOPE DIRECTION OF ROOF SLOPE.
WITH TAPERED INSULATION

Maze Design, Inc.



3.18.2025

O

SCHO

GENERAL NOTES

C-RD-5-1

- ROOF DETAILS LOCATED ON SHEET A7.04
 ROOF DRAIN
 ROOF OVERFLOW DRAIN
- FASTENING ENHANCEMENT AT CORNER SEE SPEC AND DETAIL PLUMBING VENT
- STACK FLASHING
 METAL COPING SPLICE DETAIL
 ROOF CURB DETAIL
- 2. RE-ROOFING EXISTING NAILERS / BLOCKING TO REMAIN: CONTRACTOR TO FIELD VERIFY THE EXISTING NAILERS / BLOCKING WILL COMPLY TO MEET THE WIND UP LIFT CRITERIA. REMOVE ALL DAMAGED NAILERS / BLOCKING AND / OR INSTALL ADDITIONAL FASTENER AS REQUIRED TO COMPLY.
- REFER TO PLUMBING DRAWINGS FOR LOCATION AND NUMBER OF PLUMBING VENTS THRU ROOF. REFER TO MECHANICAL DRAWINGS TO COORDINATE ALL ROOF PENETRATIONS & LOCATIONS.
- 5. PROVIDE 1/2" TAPERED CRICKETS AT ALL ROOF HATCHES AND MECHANICAL ROOF PENETRATIONS UNLESS OTHERWISE NOTED. TAPER SHALL PROVIDE DRAINAGE AROUND HATCH AND EQUIPMENT.
- 6. SEE SPECIFICATION FOR ROOFING SYSTEM TO BE USED AND ROOF PLAN FOR LOCATIONS OF TAPERED INSULATION AND OR SLOPE CHANGES OF ROOF.
- CONTRACTOR RESPONSIBLE TO FIELD VERIFY ALL SQUARE FOOTAGE VALUES NOTED ON PLANS
- 8. IN AREAS WHERE EXISTING ROOF DRAINS ARE BEING REPLACED WITH NEW ROOF DRAIN TO BE INSTALLED IN THE EXACT LOCATION OF EXISTING AND WILL BE CONNECTED TO EXISTING PIPING AS
- REQUIRED.
- SCUPPER LOCATIONS TO BE COORDINATED SO THAT THEY DO NOT APPEAR OVER DOORS, WINDOWS OR MECHANICAL LOUVERS
- 10. STANDARD ROOF ABBREVIATIONS
 RD = ROOF DRAIN
 ORD = OVERFLOW ROOF DRAIN
 EF = EXHAUST FAN
 IV = INTAKE VENT
 RTU = ROOF TOP UNIT
 RV = RELIEF VENT

ISSUANCES


01.06.2025 BIDS & CONSTRUCTION 01.16.2025 ADDENDUM 001 03.13.2025 BULLETIN 001


DRAWN JHB REVIEWED AGS

PROJECT NO. NO PART OF THIS DRAWING MAY BE USED OR REPRODUCED IN ANY FORM OR BY ANY MEANS, OR STORED IN A
DATA BASE OR RETRIEVAL SYSTEM,
WITHOUT PRIOR WRITTEN
PERMISSION OF

UNIT 'A' ROOF PLAN


GMB COPYRIGHT © 2025 ALL RIGHTS RESERVED

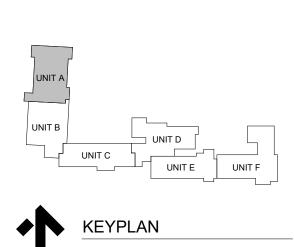

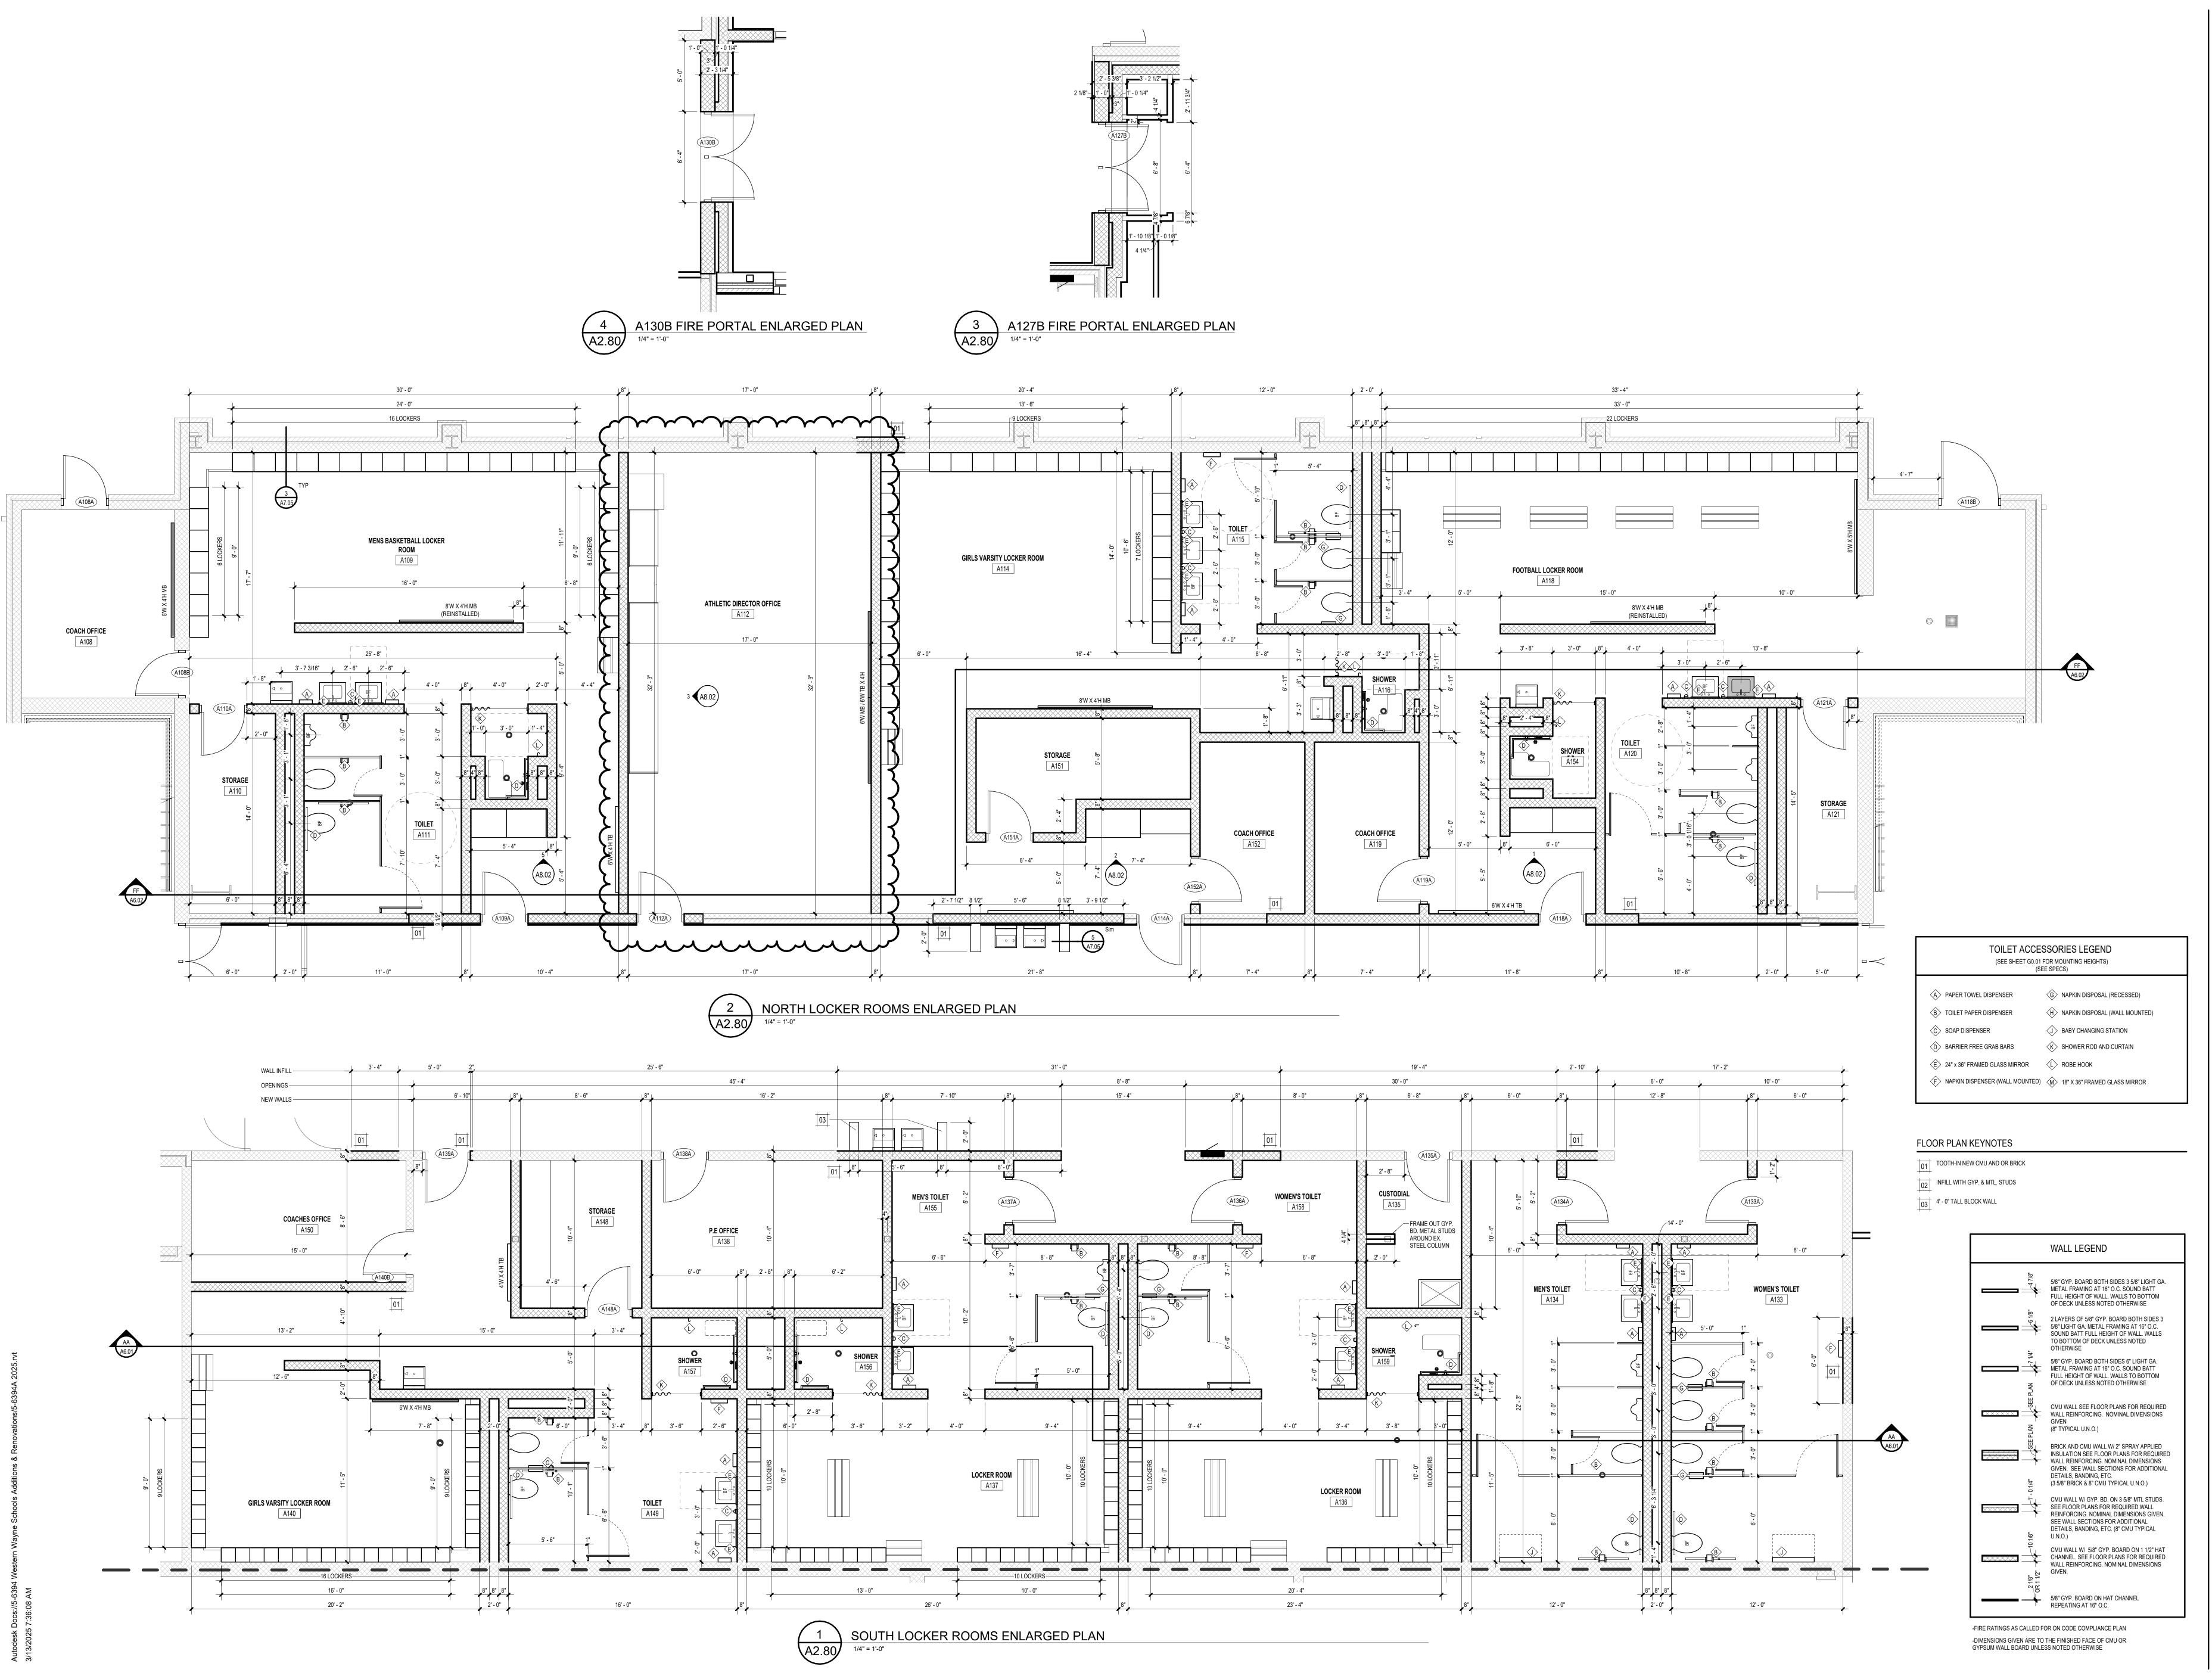

gmb

Maze Design, Inc.

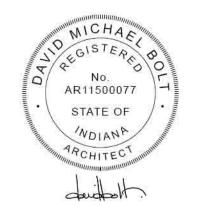

3.18.2025

ISSUANCES

01.06.2025 BIDS & CONSTRUCTION 03.13.2025 BULLETIN 001

DRAWN JHB REVIEWED AGS

PROJECT NO. NO PART OF THIS DRAWING MAY BE USED OR REPRODUCED IN ANY FORM OR BY ANY MEANS, OR STORED IN A DATA BASE OR RETRIEVAL SYSTEM, WITHOUT PRIOR WRITTEN PERMISSION OF

GMB COPYRIGHT © 2025 ALL RIGHTS RESERVED **ENLARGED PLANS**

CMU WALL W/ GYP. BD. ON 3 5/8" MTL STUDS.
SEE FLOOR PLANS FOR REQUIRED WALL
REINFORCING. NOMINAL DIMENSIONS GIVEN.
SEE WALL SECTIONS FOR ADDITIONAL
DETAILS, BANDING, ETC. (8" CMU TYPICAL
U.N.O.)

CMU WALL W/ 5/8" GYP. BOARD ON 1 1/2" HAT
CHANNEL. SEE FLOOR PLANS FOR REQUIRED
WALL REINFORCING. NOMINAL DIMENSIONS
GIVEN.

DETAILS, BANDING, ETC. (3 5/8" BRICK & 8" CMU TYPICAL U.N.O.)

WALL LEGEND

5/8" GYP. BOARD BOTH SIDES 3 5/8" LIGHT GA.

METAL FRAMING AT 16" O.C. SOUND BATT
FULL HEIGHT OF WALL. WALLS TO BOTTOM

5/8" LIGHT GA. METAL FRAMING AT 16" O.C.

OTHERWISE

METAL FRAMING AT 16" O.C. SOUND BATT

WALL REINFORCING. NOMINAL DIMENSIONS
GIVEN
(8" TYPICAL U.N.O.)

OF DECK UNLESS NOTED OTHERWISE

2 LAYERS OF 5/8" GYP. BOARD BOTH SIDES 3

SOUND BATT FULL HEIGHT OF WALL. WALLS TO BOTTOM OF DECK UNLESS NOTED

5/8" GYP. BOARD BOTH SIDES 6" LIGHT GA.

FULL HEIGHT OF WALL. WALLS TO BOTTOM OF DECK UNLESS NOTED OTHERWISE

CMU WALL SEE FLOOR PLANS FOR REQUIRED

BRICK AND CMU WALL W/ 2" SPRAY APPLIED INSULATION SEE FLOOR PLANS FOR REQUIRED WALL REINFORCING. NOMINAL DIMENSIONS

GIVEN. SEE WALL SECTIONS FOR ADDITIONAL

-FIRE RATINGS AS CALLED FOR ON CODE COMPLIANCE PLAN
-DIMENSIONS GIVEN ARE TO THE FINISHED FACE OF CMU OR GYPSUM WALL BOARD UNLESS NOTED OTHERWISE

TOILET ACCESSORIES LEGEND

(SEE SHEET G0.01 FOR MOUNTING HEIGHTS)
(SEE SPECS)

A PAPER TOWEL DISPENSER

G NAPKIN DISPOSAL (RECESSED)

(H) NAPKIN DISPOSAL (WALL MOUNTED)

© SOAP DISPENSER

D BARRIER FREE GRAB BARS

E 24" x 36" FRAMED GLASS MIRROR

D BARRIER FREE GRAB BARS

E 24" x 36" FRAMED GLASS MIRROR

F NAPKIN DISPENSER (WALL MOUNTED) (M) 18" X 36" FRAMED GLASS MIRROR


FLOOR PLAN KEYNOTES

01 TOOTH-IN NEW CMU AND OR BRICK

02 INFILL WITH GYP. & MTL. STUDS

B TOILET PAPER DISPENSER

4' - 0" TALL BLOCK WALL

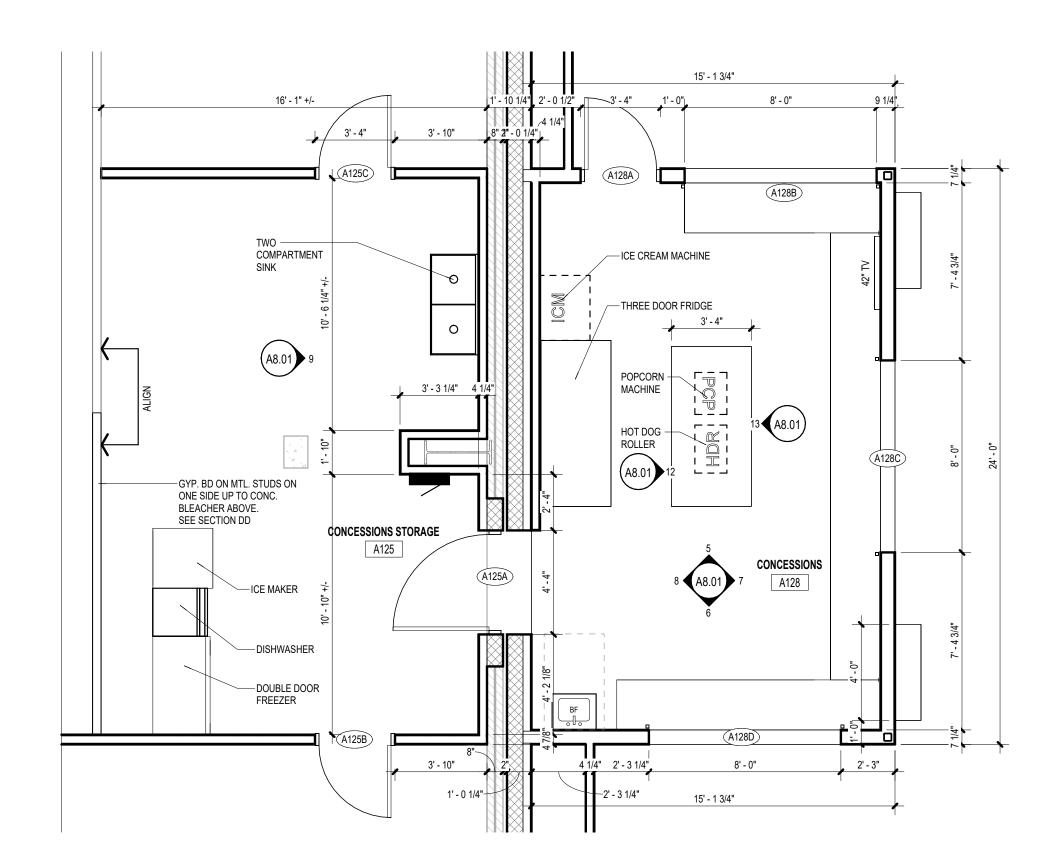



ISSUANCES

01.06.2025 BIDS 8

01.06.2025 BIDS & CONSTRUCTION 01.22.2025 ADDENDUM 002 03.13.2025 BULLETIN 001

DRAWN JHB
REVIEWED AGS

PROJECT NO. 5-6394

NO PART OF THIS DRAWING MAY BE USED OR REPRODUCED IN ANY FORM OR BY ANY MEANS, OR STORED IN A DATA BASE OR RETRIEVAL SYSTEM, WITHOUT PRIOR WRITTEN PERMISSION OF

GMB COPYRIGHT © 2025
ALL RIGHTS RESERVED

ENLARGED PLANS

A2.81

AR11500077

STATE OF

duillot.

3.18.2025

CEILING TILE TYPE AS SPECIFIED - CEILING HEIGHTS NOTED ON REFLECTED CEILING PLANS.
 CEILING ELEVATIONS ARE FROM THAT ROOM'S FINISH FLOOR.

3. WIRE CEILING SYSTEM FROM STRUCTURE ABOVE AND WIRE FOR ADDITIONAL LOAD AT LIGHTS, CEILING DIFFUSERS, AND OTHER DEVICES. WIRING TO METAL DECK IS STRICTLY PROHIBITED.

4. UNLESS OTHERWISE NOTED, CEILING TO BE SUSPENDED METAL TEE AND ACOUSTICAL TILE 2' - 0" x 2' - 0" OR 2' - 0" x 4' - 0" TYPICAL. SEE SPECIFICATIONS FOR MANUFACTURER AND STYLE.

5. PENDANT MOUNTED FIXTURES CENTERED ON GRID REQUIRE GRID TO BE CUT AND SUPPORTED ON


6. MOUNT SPEAKERS AND SUPPLY AIR DIFFUSERS IN THE CENTER OF WHOLE CEILING PANELS. ADHERE A RIGID PANEL BACKER TO PANELS AT LOCATIONS WHICH INDICATE SPEAKERS,


DIFFUSERS, LIGHTS, SMOKE DETECTORS, EXIT LIGHTS AND FIRE PROTECTION SPRINKLERS.

7. PROVIDE 2' - 0" CEILING GRID CROSS-TEE AT EACH RETURN AIR GRILLE.

8. PROVIDE AN ADDITIONAL CROSS-TEE AT EACH SLOT DIFFUSER.

9. REFER TO THE MECHANICAL DRAWINGS FOR LOUVERS REQUIRED TO BE FRAMED IN GYPSUM BOARD BULKHEADS. 10. ALL CEILING HEIGHTS ARE SUBJECT TO CHANGE TO ACCOMMODATE UNFORESEEN FIELD CONDITIONS - COORDINATE CHANGES WITH ARCHITECT & AFFECTED DISCIPLINES. 11. SOME CORRIDOR CEILING PANEL LAYOUTS HAVE BEEN ADJUSTED AT A CHANGE IN CORRIDOR DIRECTION TO ACCOMMODATE LIGHTING LAYOUT.

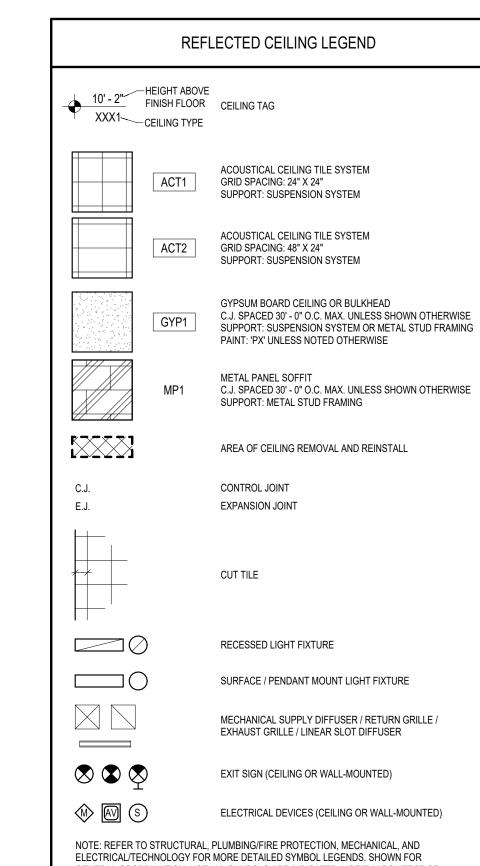

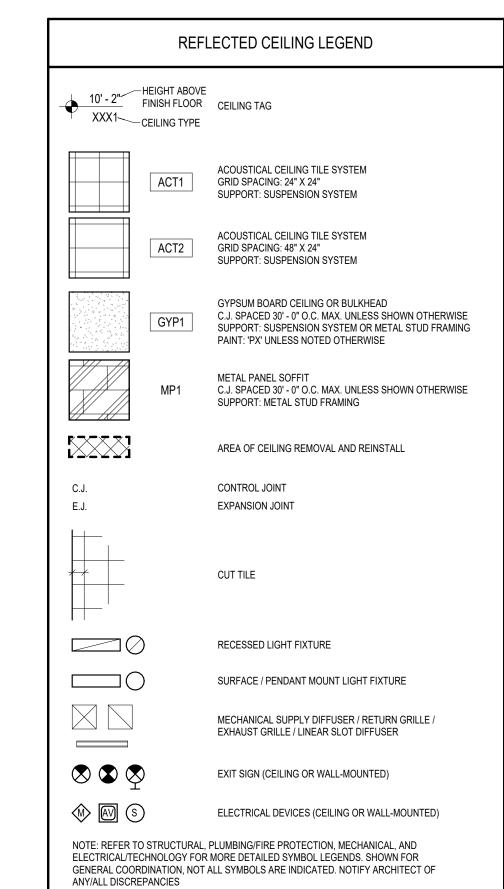

ISSUANCES


01.06.2025 BIDS & CONSTRUCTION 01.16.2025 ADDENDUM 001 03.13.2025 BULLETIN 001

DRAWN JHB REVIEWED AGS

PROJECT NO. NO PART OF THIS DRAWING MAY BE USED OR REPRODUCED IN ANY FORM OR BY ANY MEANS, OR STORED IN A DATA BASE OR RETRIEVAL SYSTEM, WITHOUT PRIOR WRITTEN GMB COPYRIGHT © 2025 ALL RIGHTS RESERVED

UNIT 'A' FIRST FLOOR REFLECTED CEILING PLAN

A3.1A

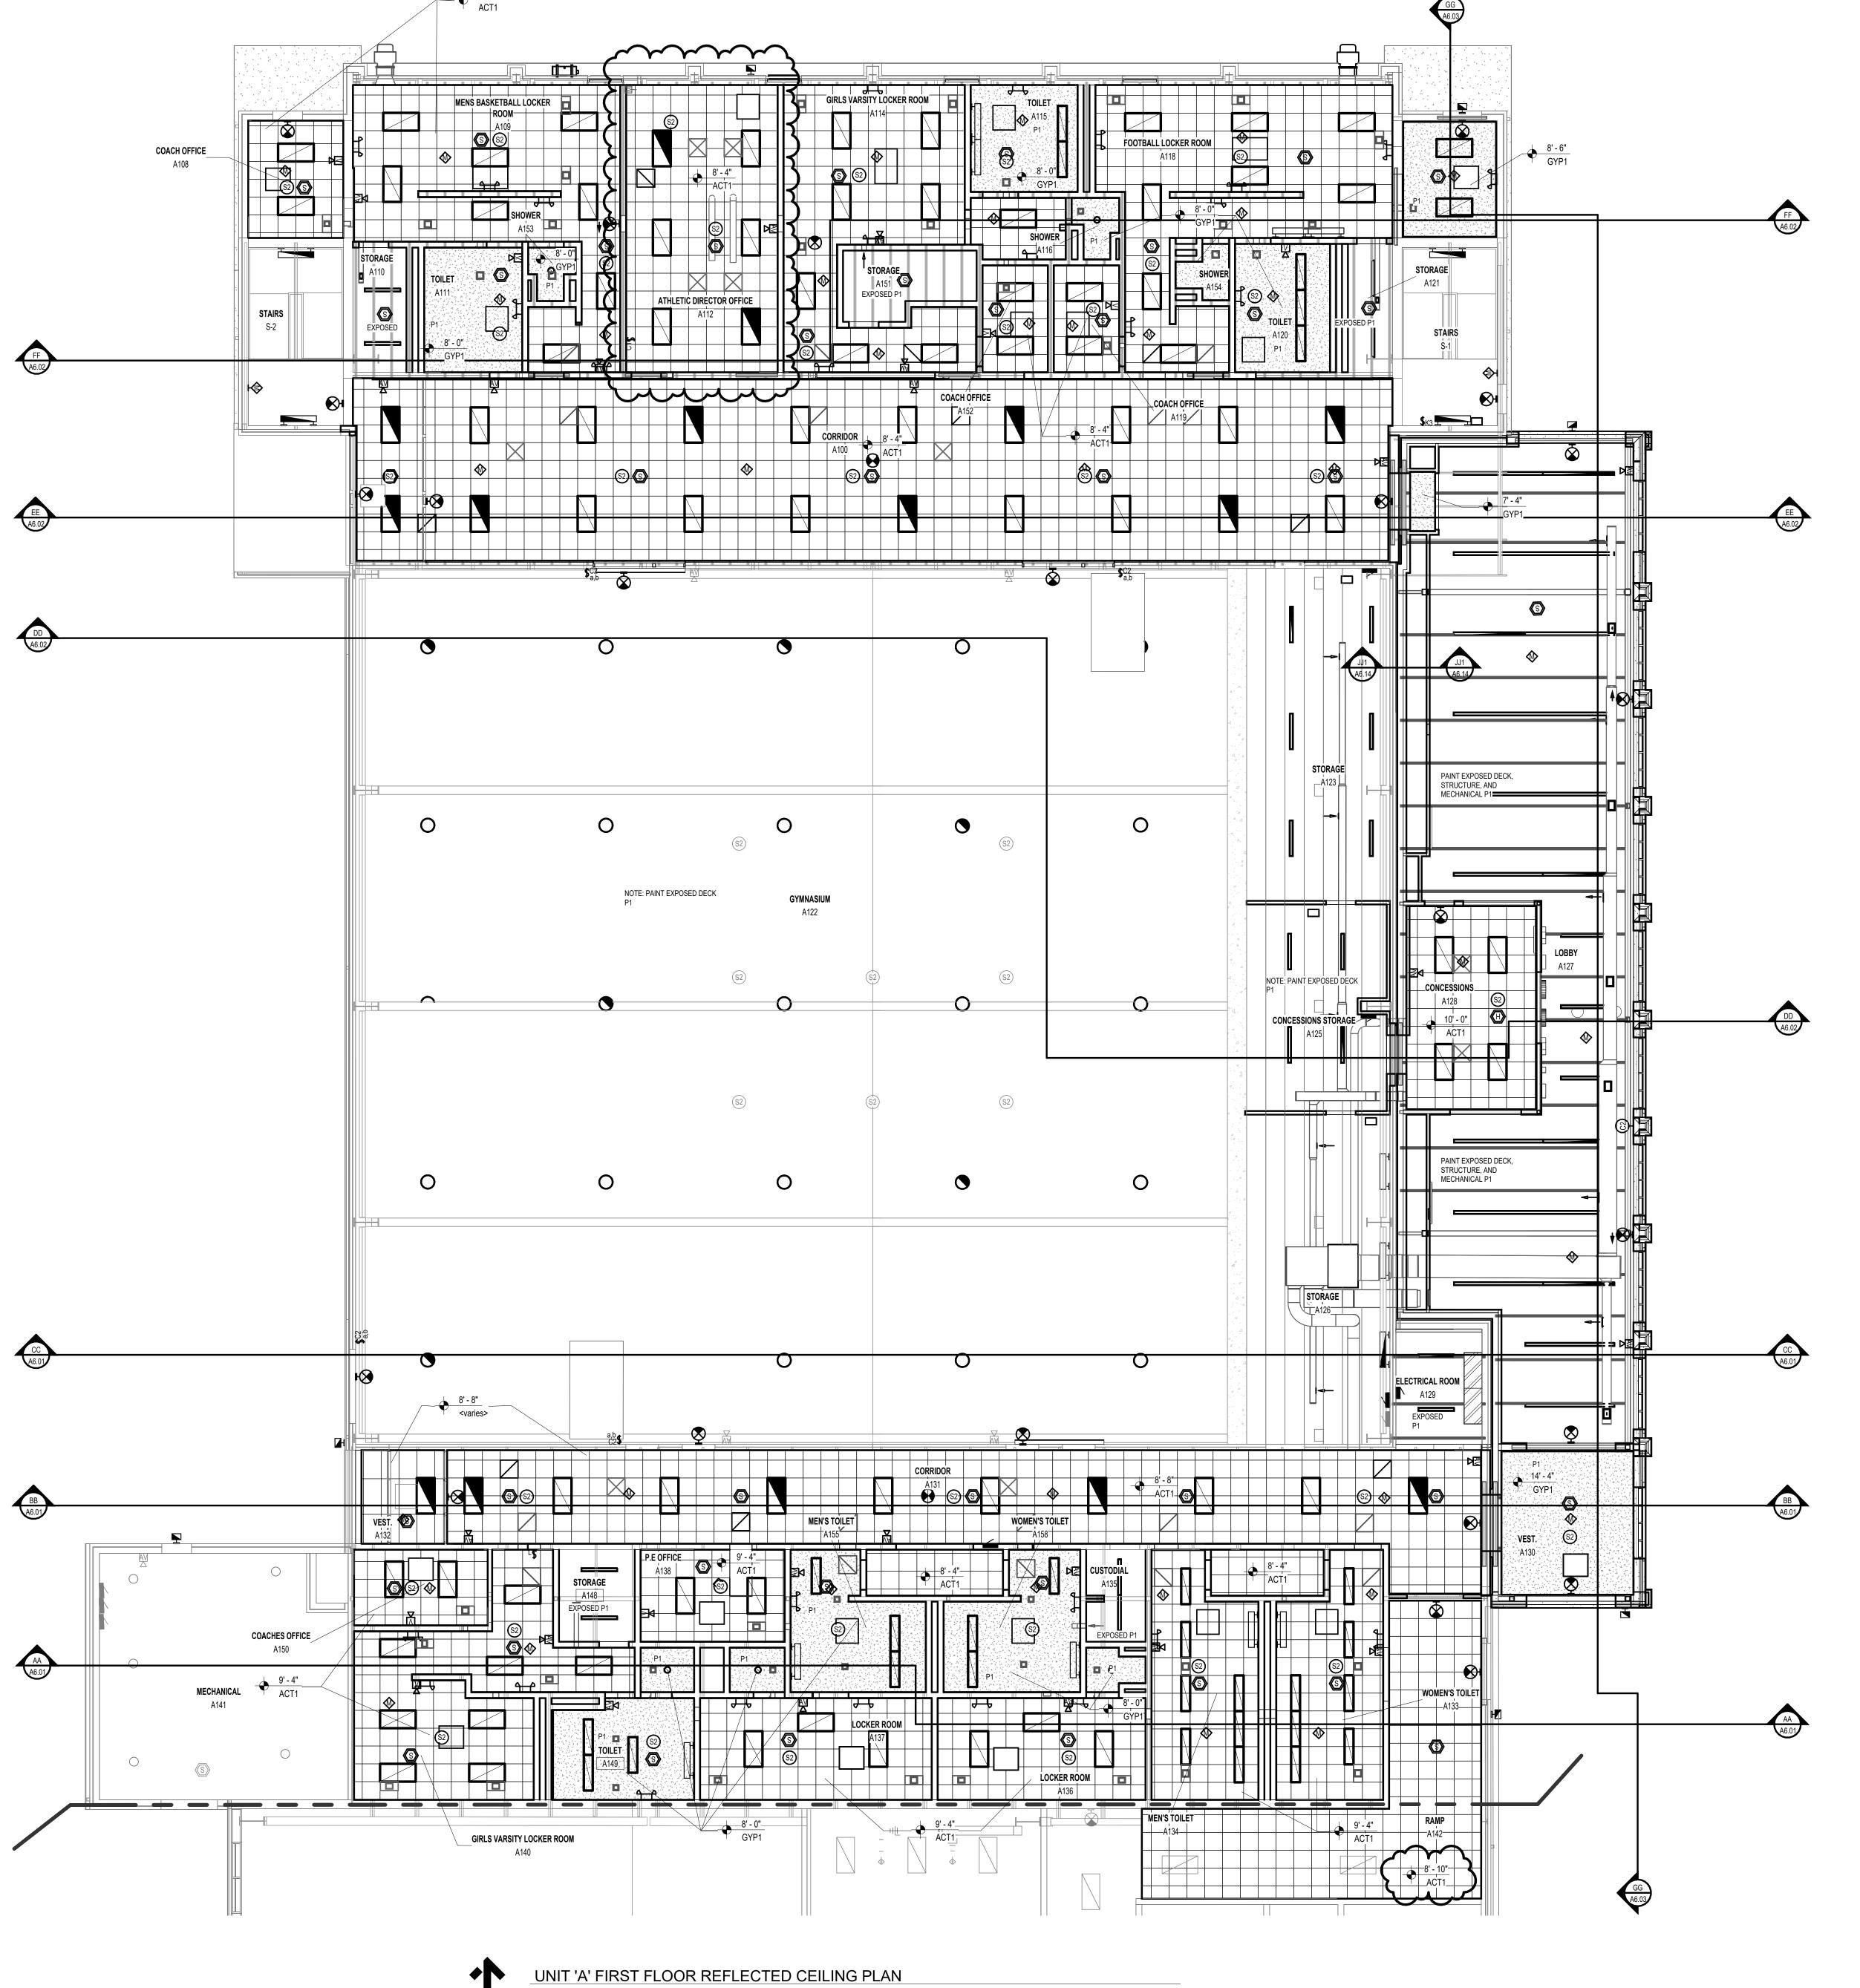

gmb

Maze Design, Inc.



3.18.2025

J. 10.202

PACKAGE #′

ITIONS & RENOVATIONS
WAYNE SCHOOLS

WESTERN WAYNE S

ISSUANCES

01.06.2025 BIDS &
CONSTRUCTION
01.16.2025 ADDENDUM 001

03.13.2025 BULLETIN 001

DRAWN JHB

PROJECT NO. 5-6394


NO PART OF THIS DRAWING MAY BE USED OR REPRODUCED IN ANY FORM OR BY ANY MEANS, OR STORED IN A DATA BASE OR RETRIEVAL SYSTEM, WITHOUT PRIOR WRITTEN PERMISSION OF


GMB COPYRIGHT © 2025
ALL RIGHTS RESERVED


EXTERIOR ELEVATIONS


A4.01

= SPANDREL PANEL = LOUVER PANEL

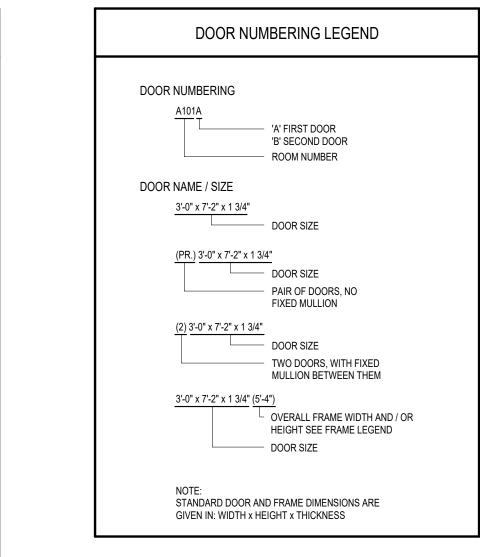

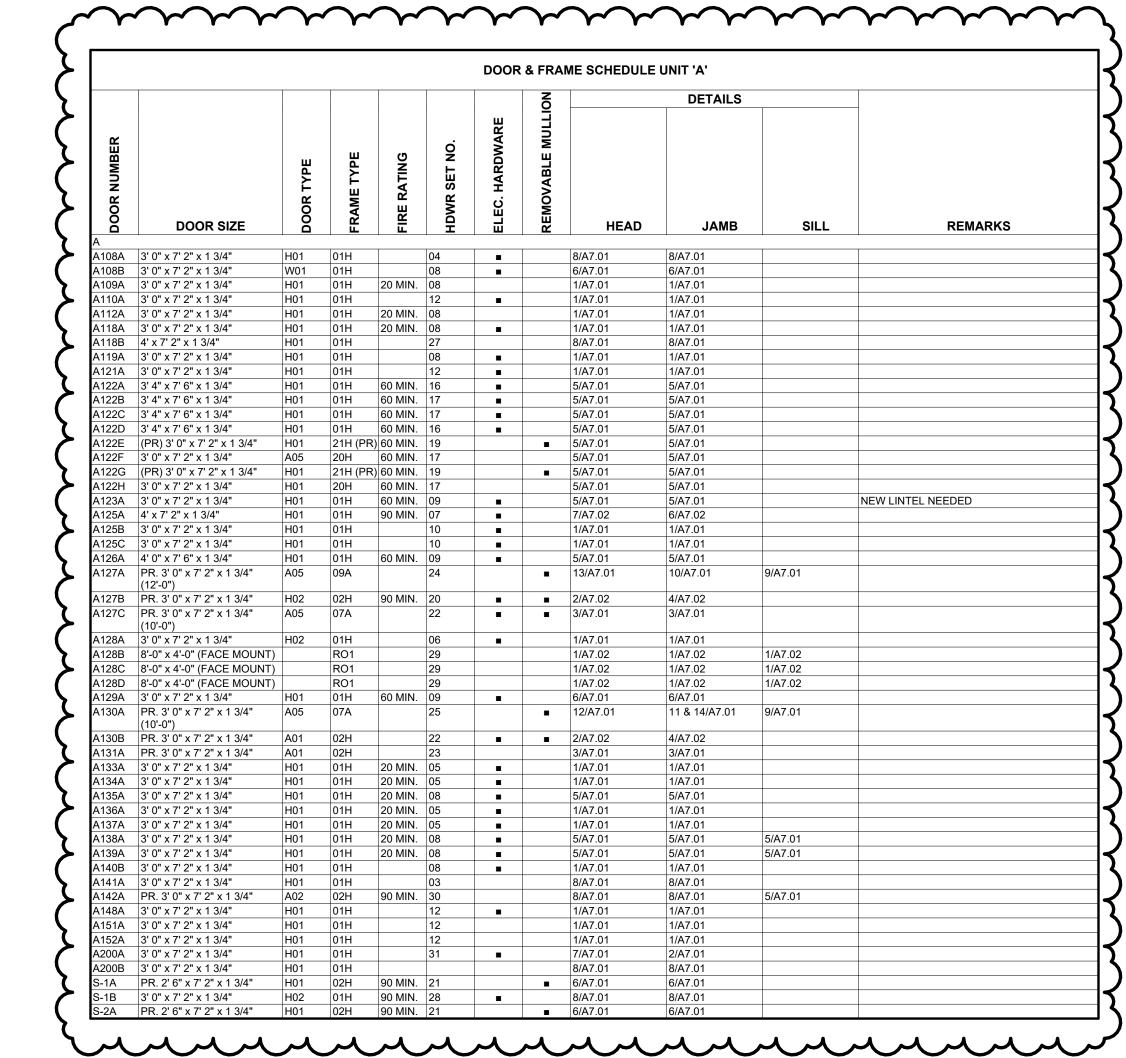

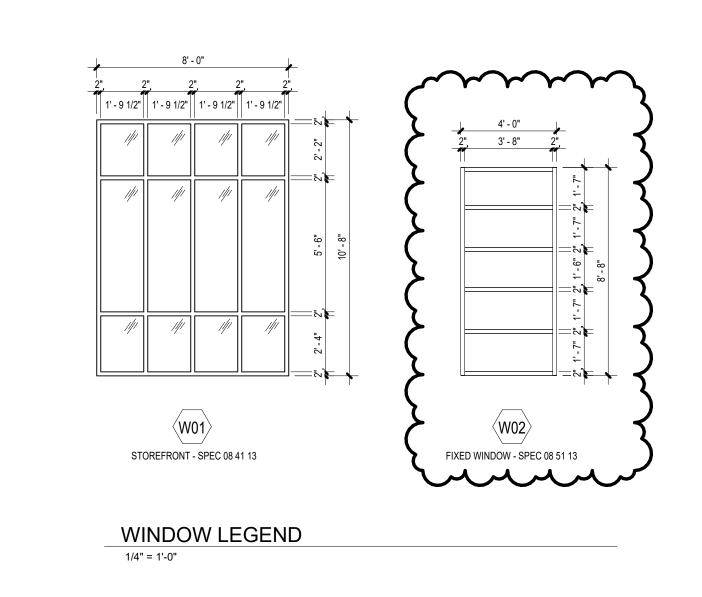

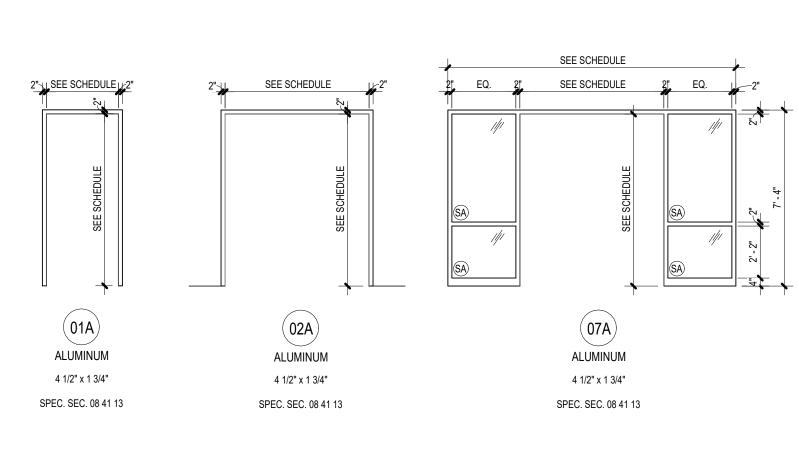

WIDTH IN STUD WALL APPLICATIONS


SPEC. SEC. 08 11 13

WIDTH IN STUD WALL APPLICATIONS

SPEC. SEC. 08 11 13

1/4" = 1'-0"

DOOR FRAME LEGEND

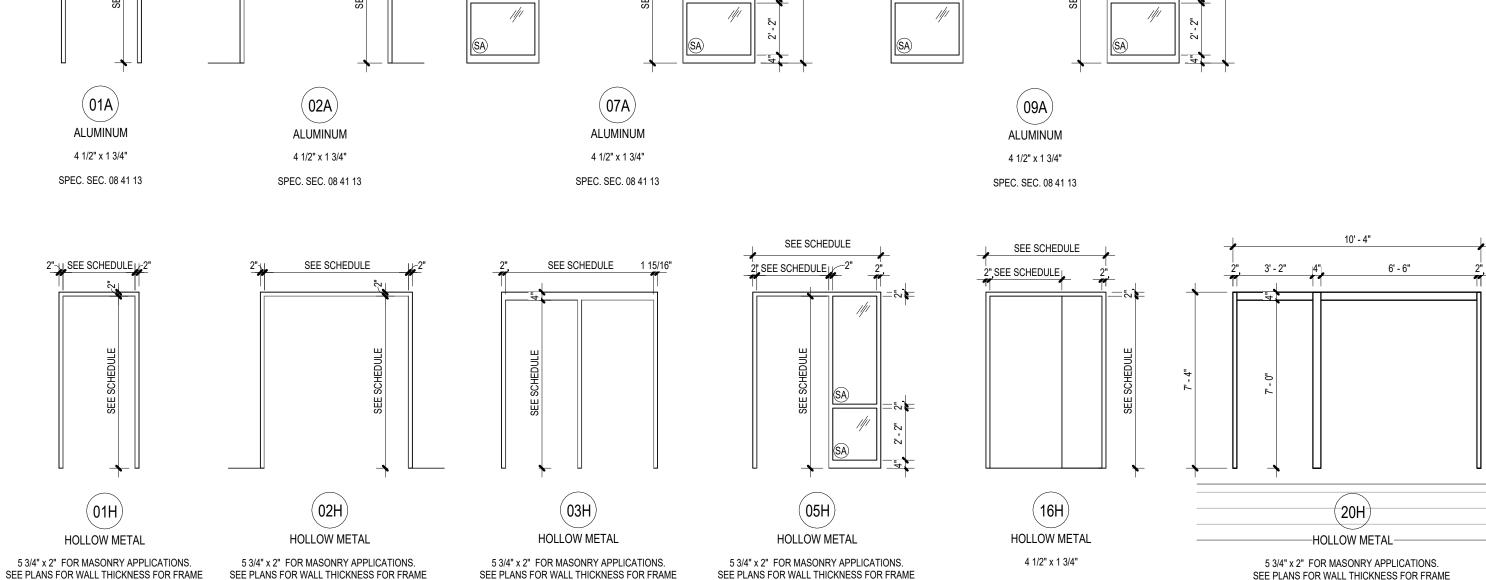


WIDTH IN STUD WALL APPLICATIONS

SPEC. SEC. 08 11 13

WIDTH IN STUD WALL APPLICATIONS

SPEC. SEC. 08 11 13

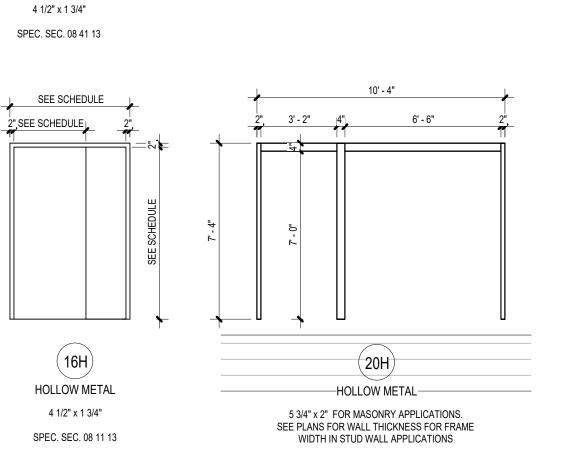

SPEC. SEC. 08 11 13

SEE SCHEDULE 2", EQ. 2

HOLLOW METAL HOLLOW METAL ROLLING FIRE DOOR W/ NARROW W/ INTEGRAL FRAME

ALUMINUM

CROSSRAIL FULL

PANIC & PUSH


PULL HARDWARE TO BE MOUNTED

DOOR TYPE LEGEND 1/4" = 1'-0"

W01) WOOD

SOLID CORE FLUSH

Design, Inc.

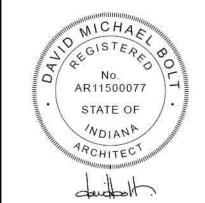


3.18.2025

OL SCHO

ISSUANCES 01.06.2025 BIDS & CONSTRUCTION 03.13.2025 BULLETIN 001

DRAWN REVIEWED AGS PROJECT NO. NO PART OF THIS DRAWING MAY BE USED OR REPRODUCED IN ANY FORM OR BY ANY MEANS, OR STORED IN A DATA BASE OR RETRIEVAL SYSTEM, WITHOUT PRIOR WRITTEN PERMISSION OF GMB COPYRIGHT © 2025 ALL RIGHTS RESERVED

DOOR & FRAME SCHEDULES

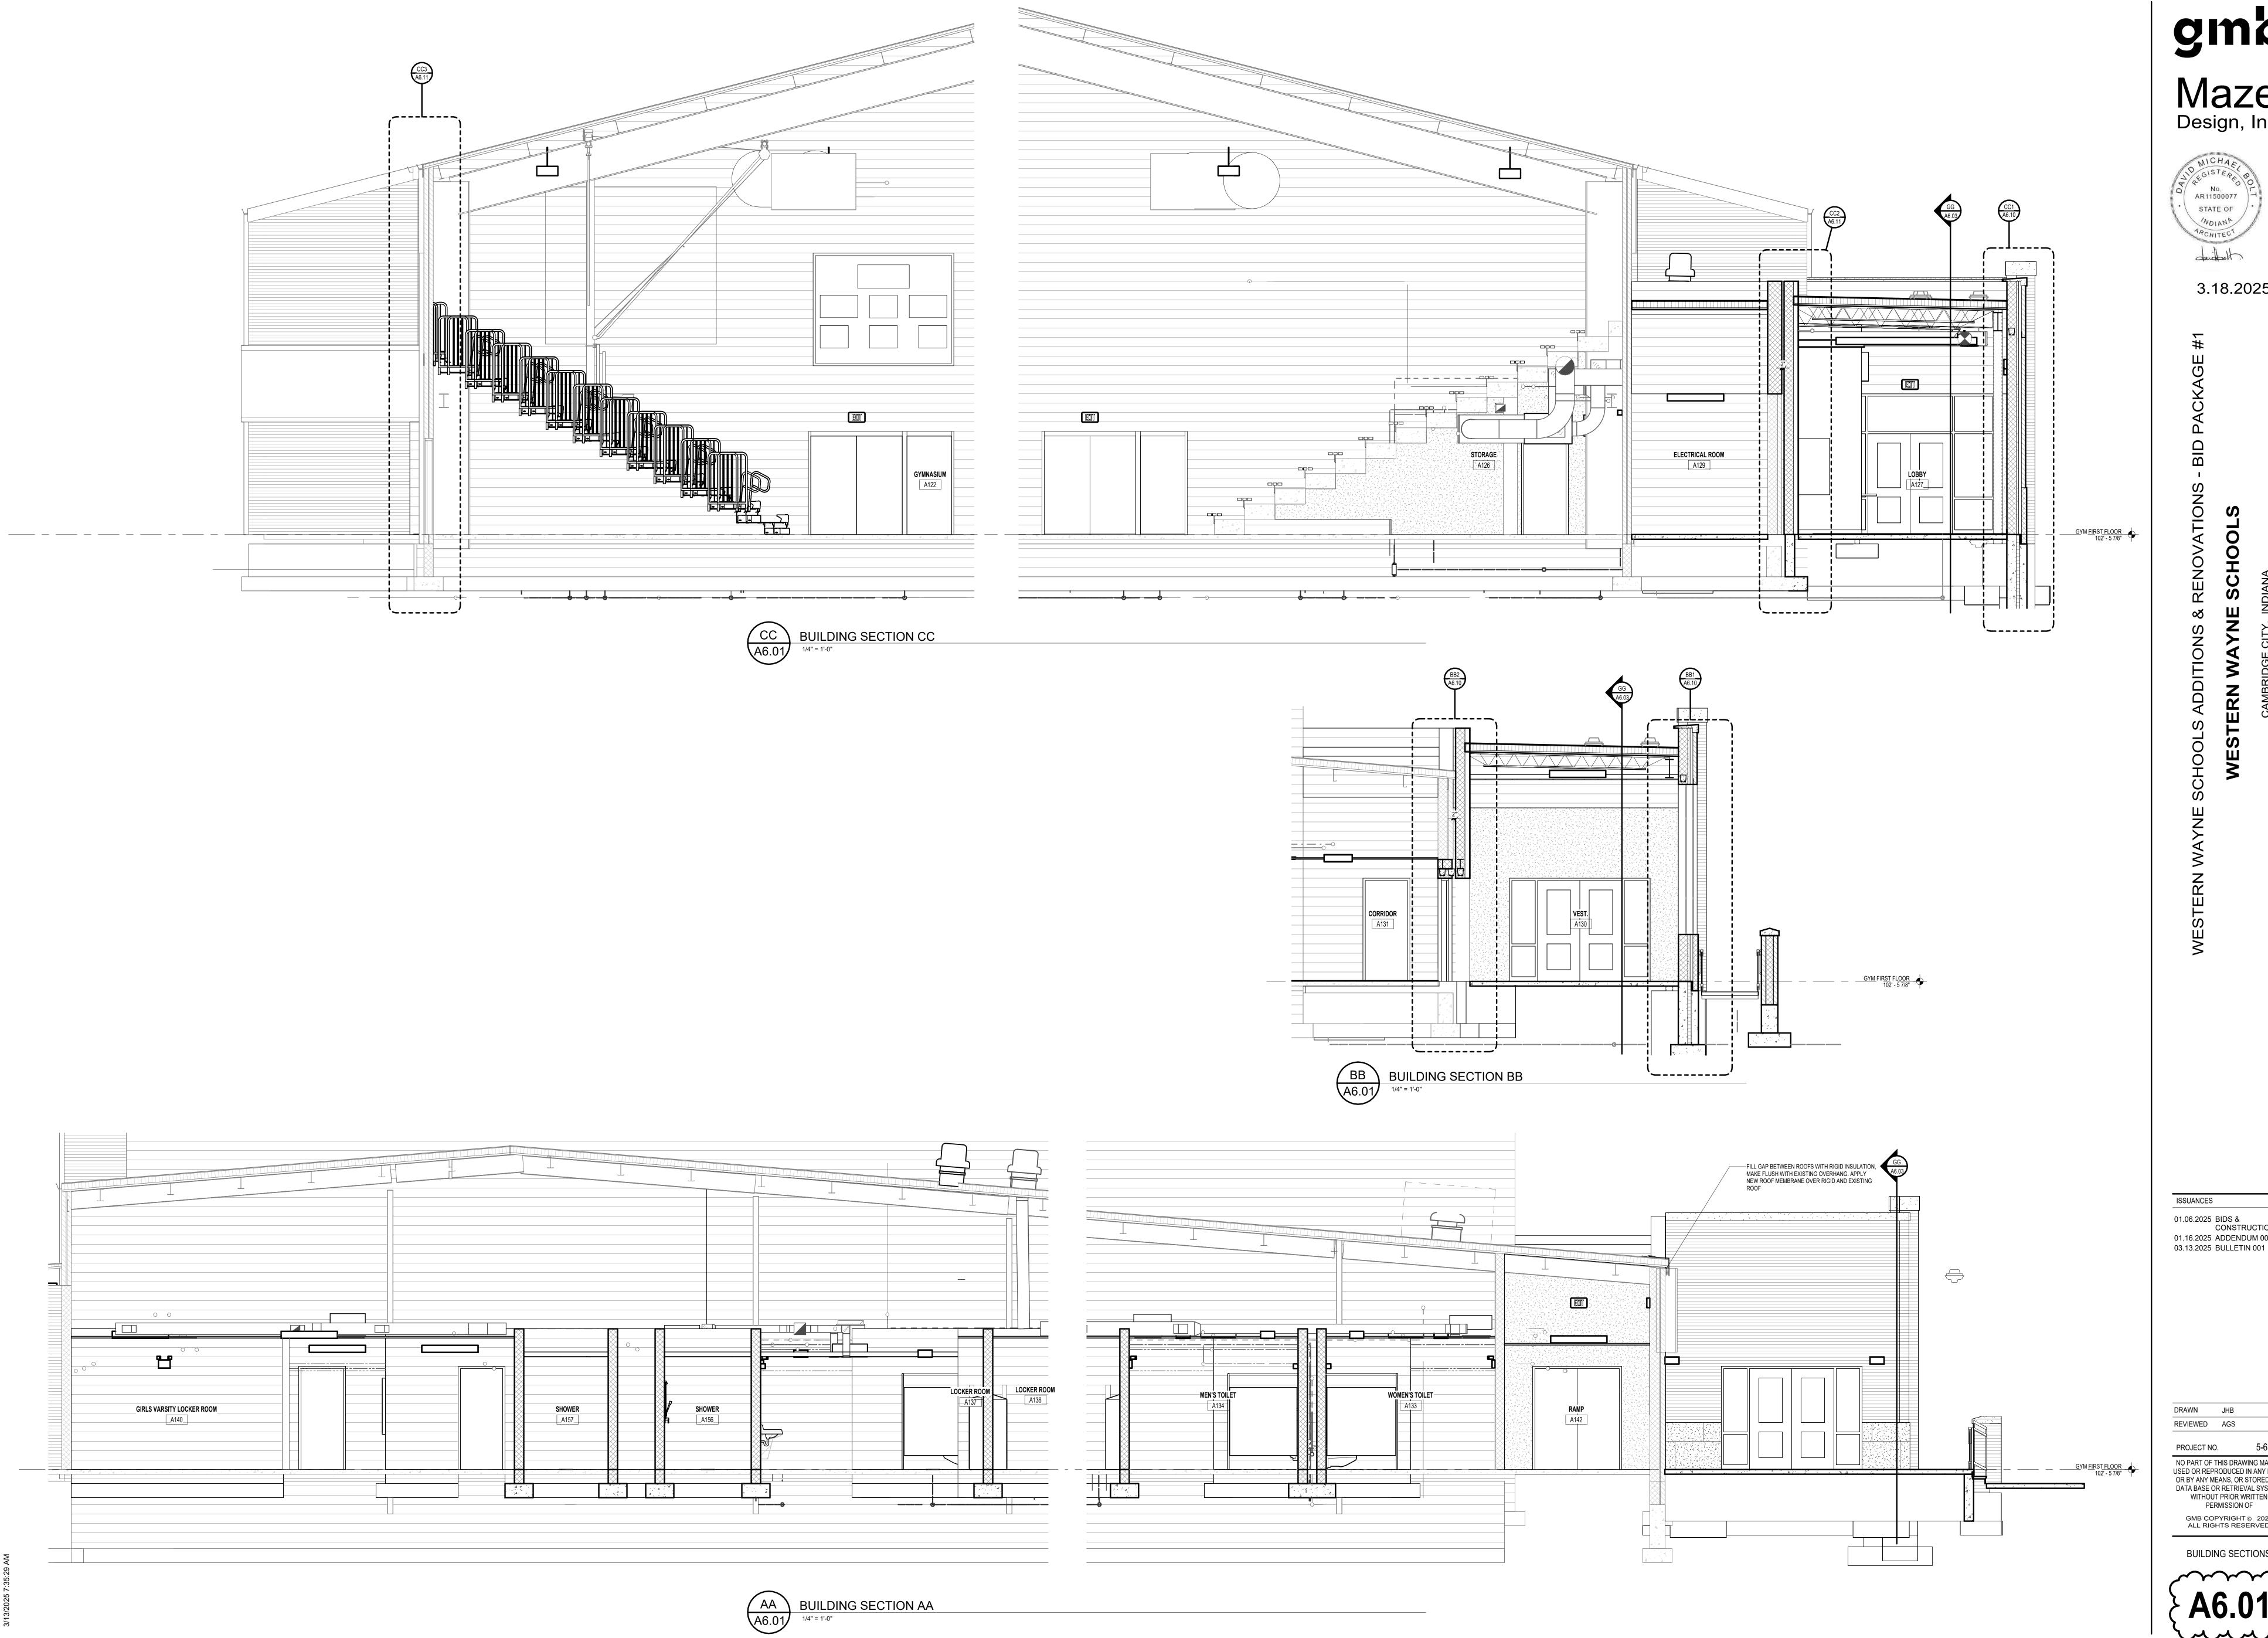



3.18.2025

ISSUANCES 01.06.2025 BIDS & CONSTRUCTION 01.16.2025 ADDENDUM 001

DRAWN JHB REVIEWED AGS


PROJECT NO. NO PART OF THIS DRAWING MAY BE USED OR REPRODUCED IN ANY FORM OR BY ANY MEANS, OR STORED IN A
DATA BASE OR RETRIEVAL SYSTEM,
WITHOUT PRIOR WRITTEN PERMISSION OF

GMB COPYRIGHT © 2025 ALL RIGHTS RESERVED **BUILDING SECTIONS**

DD BUILDING SECTION DD

A6.02 1/4" = 1'-0"

Maze Design, Inc.

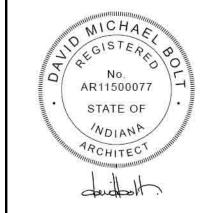

3.18.2025

ISSUANCES 01.06.2025 BIDS & CONSTRUCTION

01.16.2025 ADDENDUM 001 03.13.2025 BULLETIN 001

DRAWN JHB REVIEWED AGS

PROJECT NO. NO PART OF THIS DRAWING MAY BE USED OR REPRODUCED IN ANY FORM OR BY ANY MEANS, OR STORED IN A
DATA BASE OR RETRIEVAL SYSTEM,
WITHOUT PRIOR WRITTEN PERMISSION OF GMB COPYRIGHT © 2025 ALL RIGHTS RESERVED

BUILDING SECTIONS

DRAWN JHB

PROJECT NO. 5-6394

NO PART OF THIS DRAWING MAY BE USED OR REPRODUCED IN ANY FORM OR BY ANY MEANS, OR STORED IN A DATA BASE OR RETRIEVAL SYSTEM, WITHOUT PRIOR WRITTEN PERMISSION OF


WITHOUT PRIOR WRITTEN
PERMISSION OF


GMB COPYRIGHT © 2025
ALL RIGHTS RESERVED

BUILDING SECTIONS


BUILDING SECTIONS


A6.03

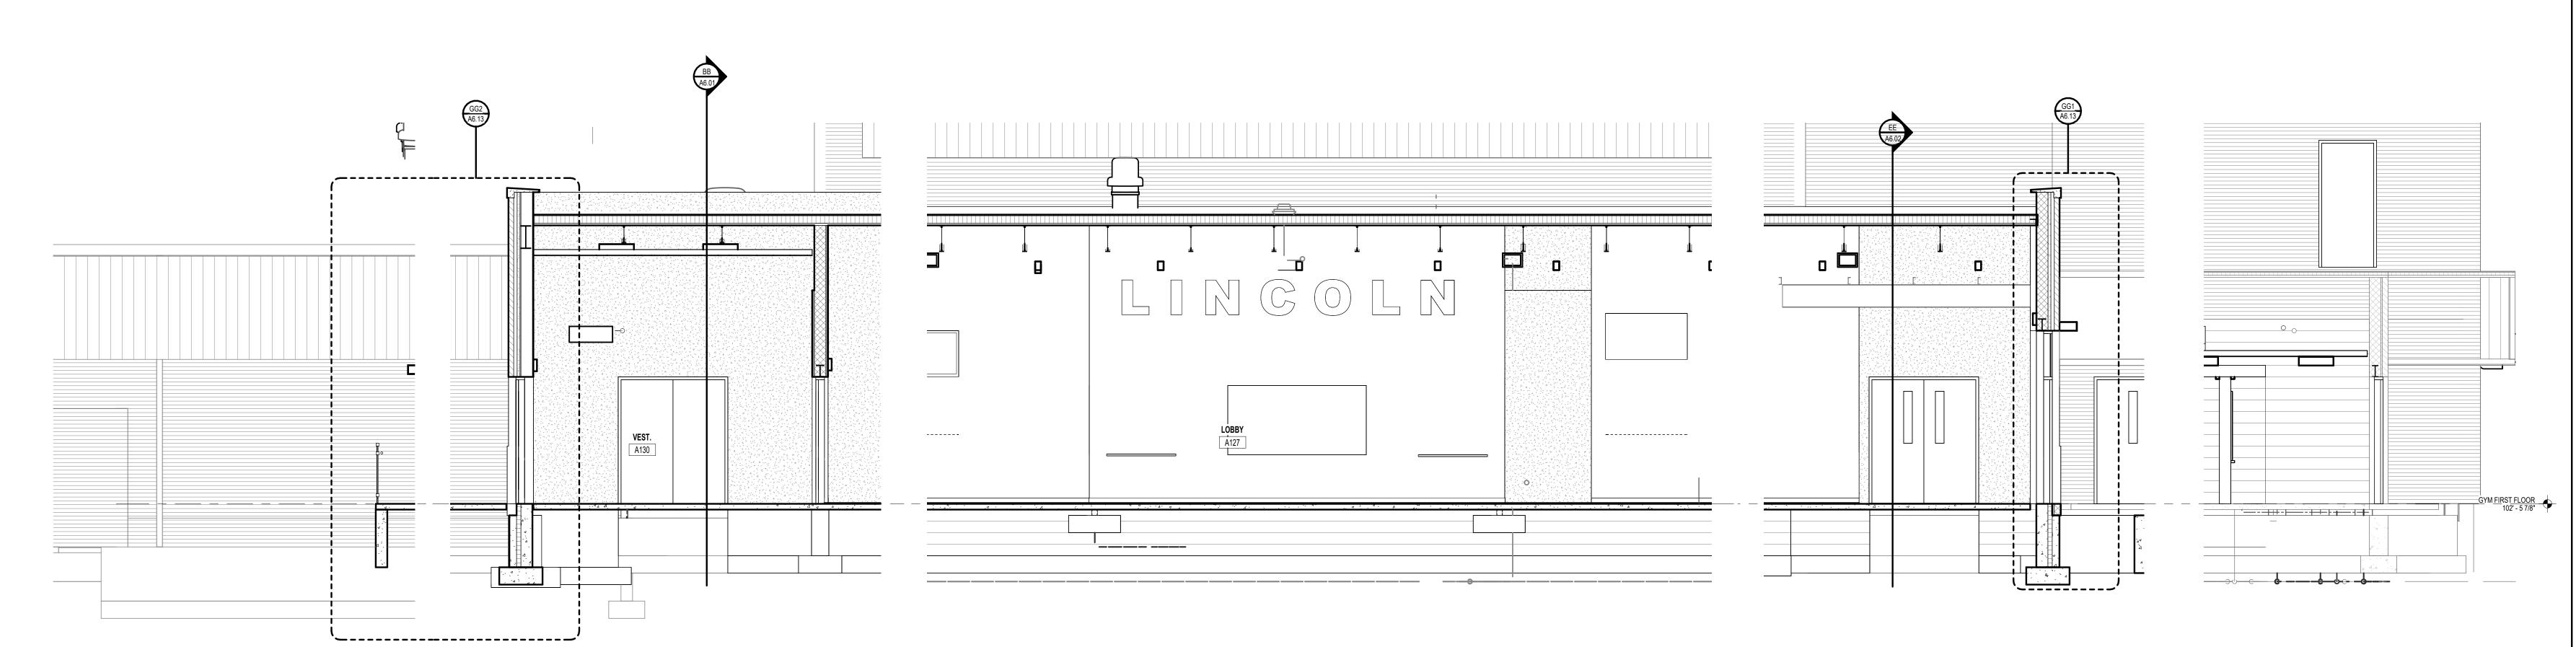

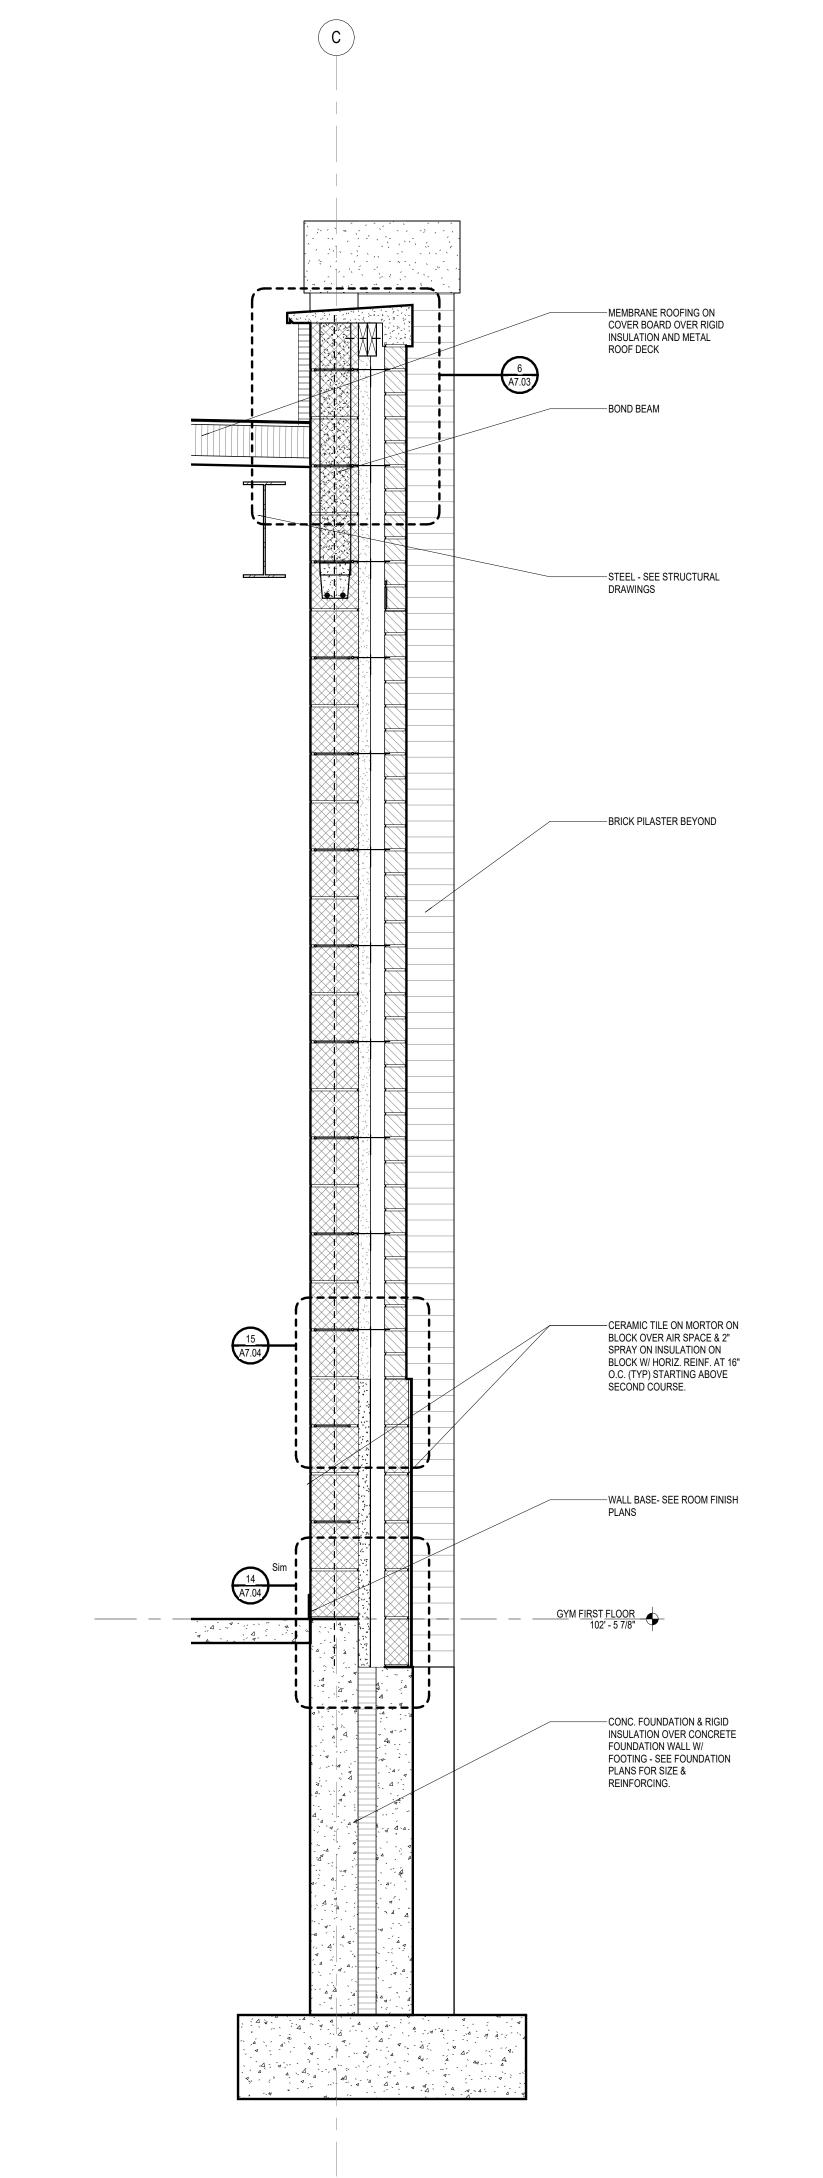


WALL SECTION CC1

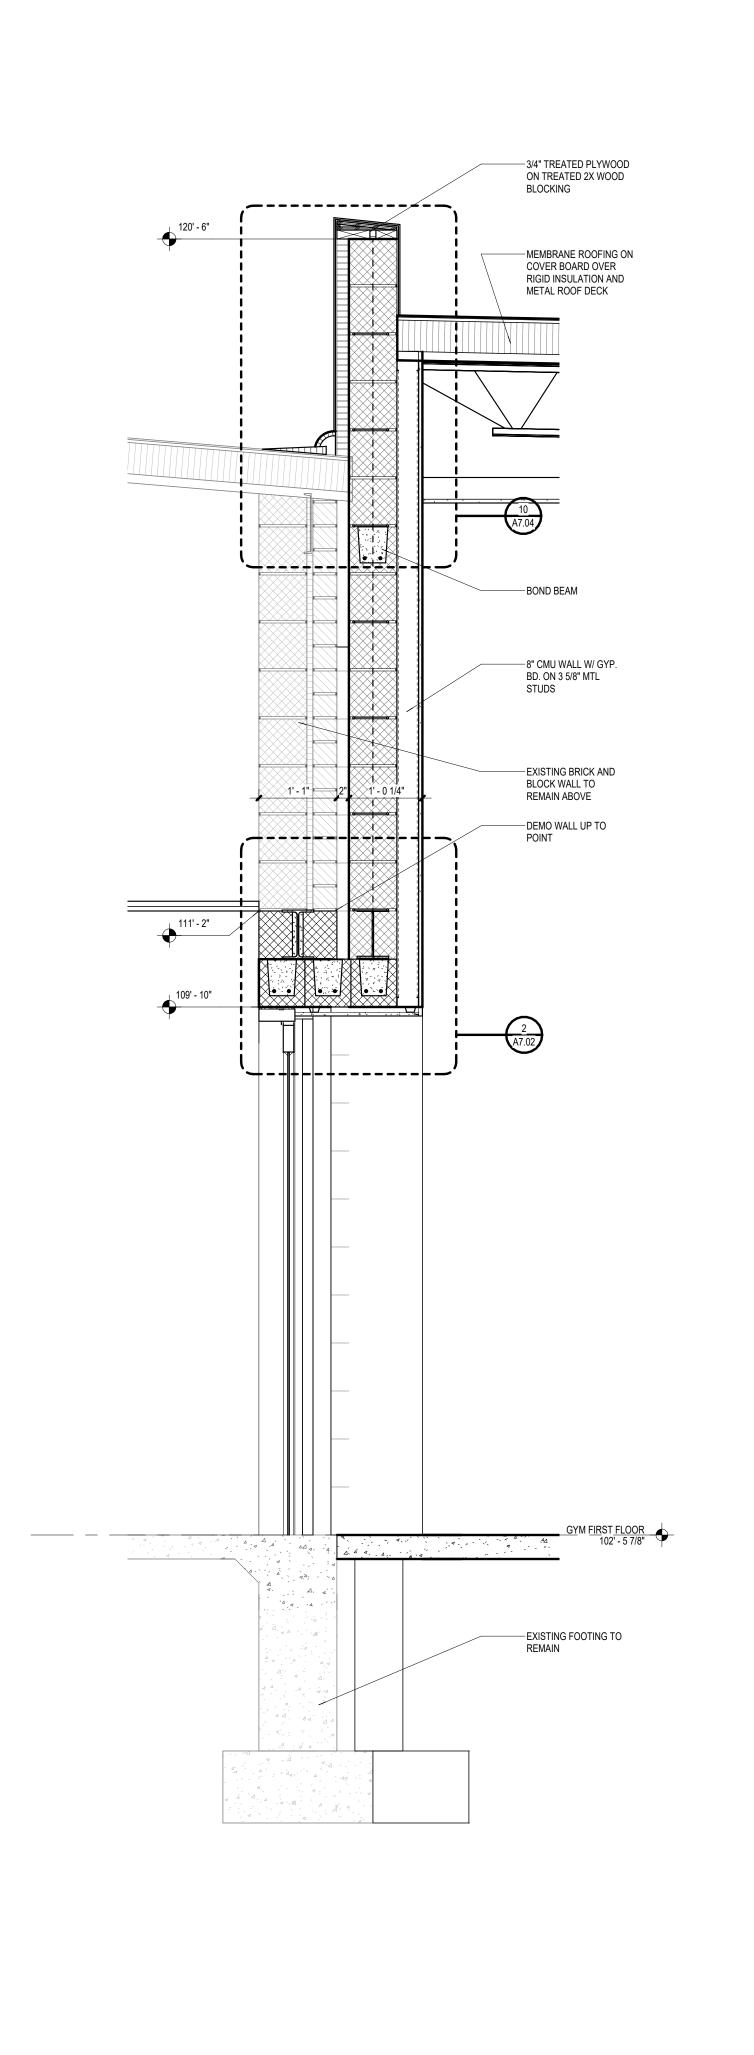

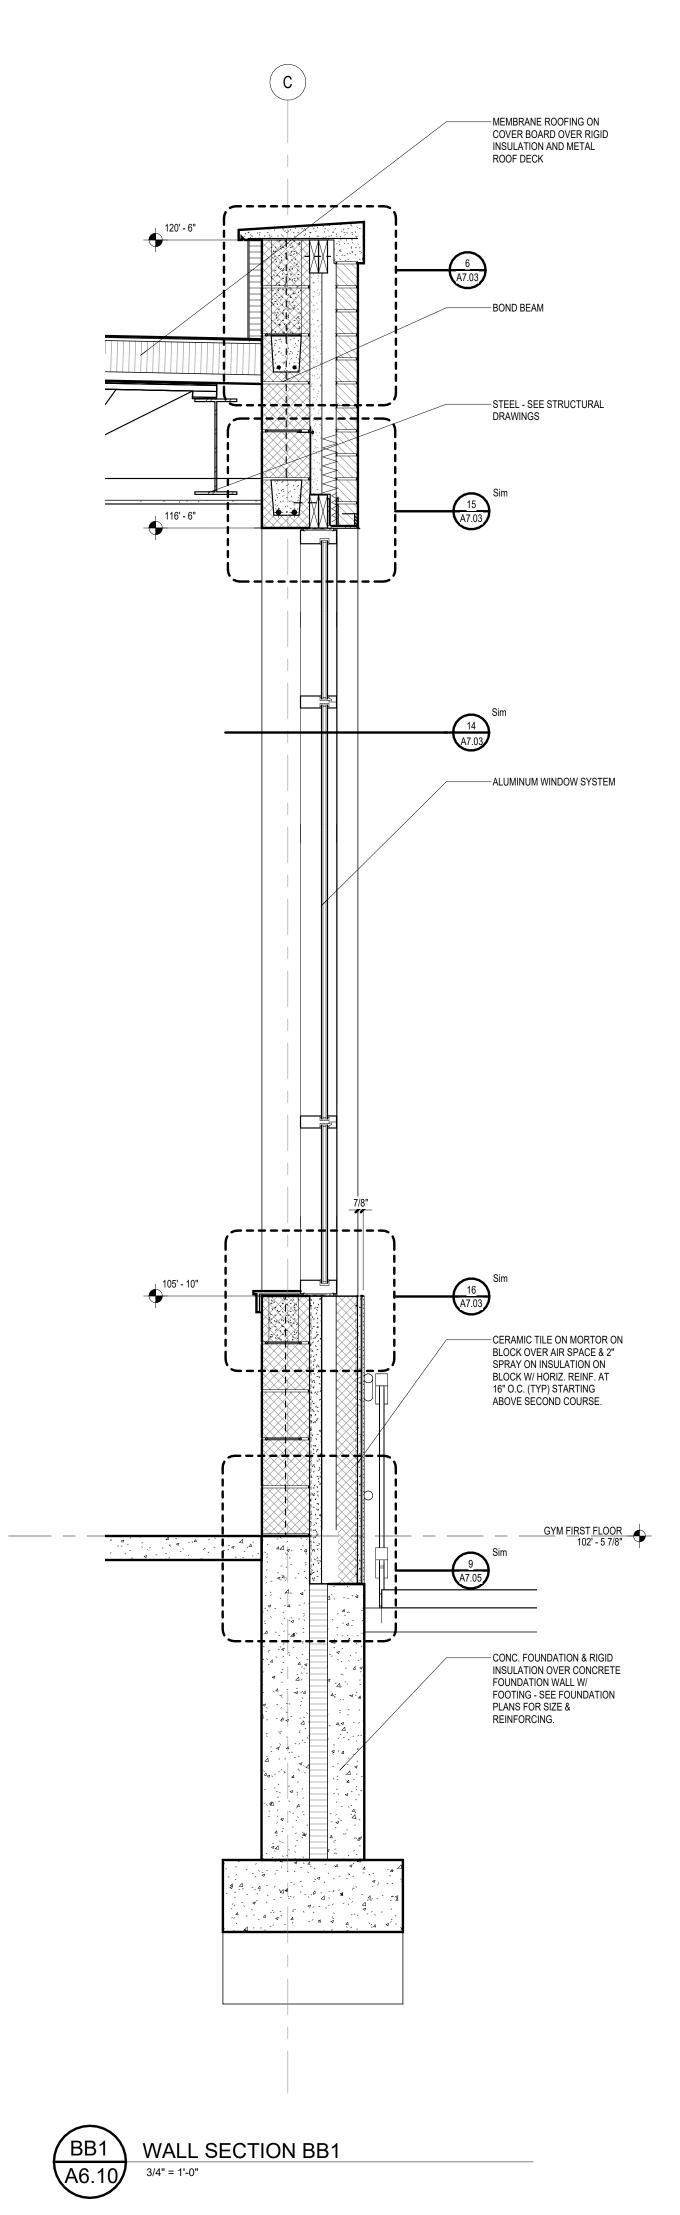

gmb

Maze Design, Inc.

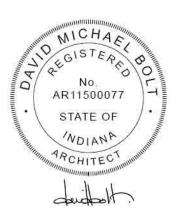

3.18.2025

ERN WAYNE SCHOO
CAMBRIDGE CITY, INDIANA

WESTERN WA

ISSUANCES

01.06.2025 BIDS & CONSTRUCTION

01.16.2025 ADDENDUM 001 03.13.2025 BULLETIN 001

DRAWN JHB
REVIEWED AGS

PROJECT NO. 5-6394


NO PART OF THIS DRAWING MAY BE USED OR REPRODUCED IN ANY FORM

USED OR REPRODUCED IN ANY FORM
OR BY ANY MEANS, OR STORED IN A
DATA BASE OR RETRIEVAL SYSTEM,
WITHOUT PRIOR WRITTEN
PERMISSION OF


GMB COPYRIGHT © 2025
ALL RIGHTS RESERVED

WALL SECTIONS

A6.10

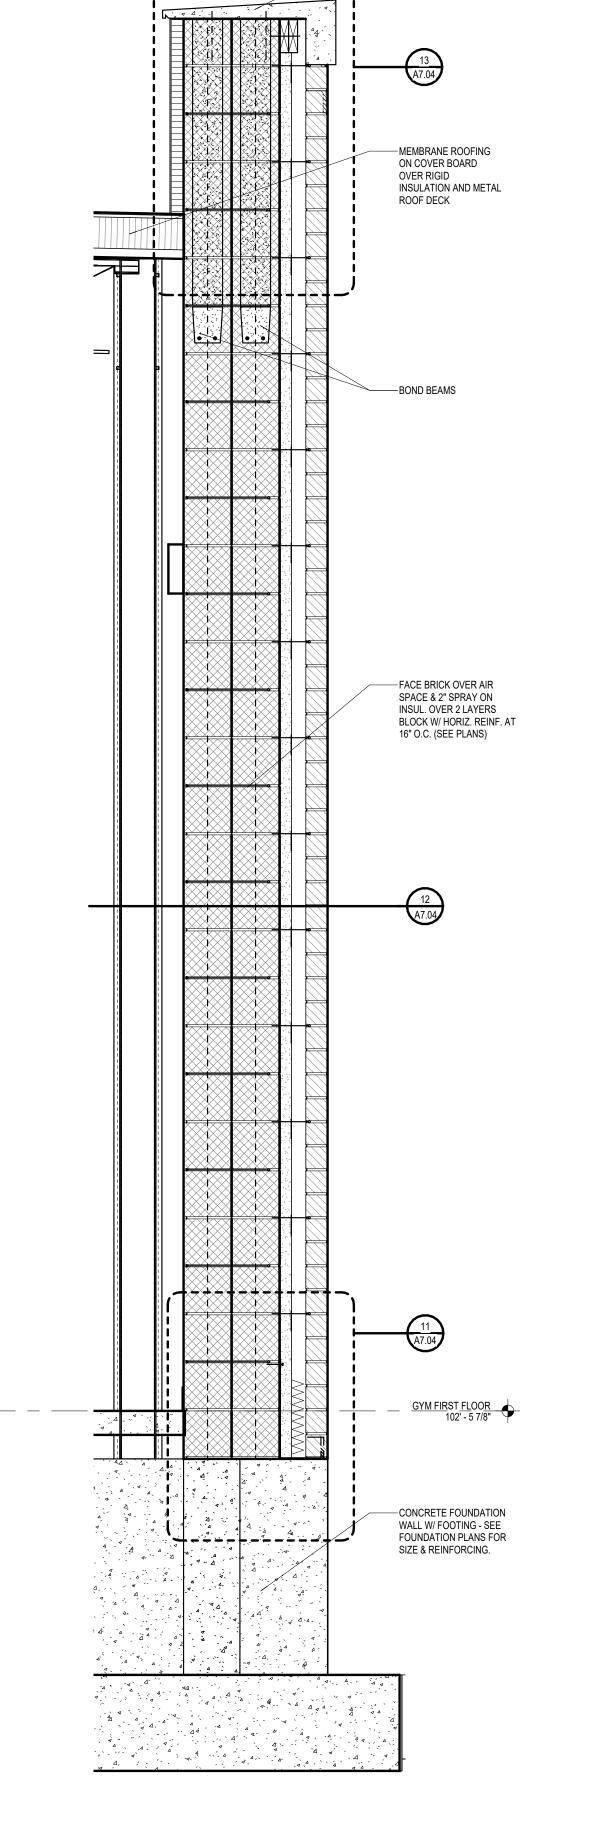

CAST STONE PARAPET CAP WITH ANCHORS PER MFR. STANDARDS

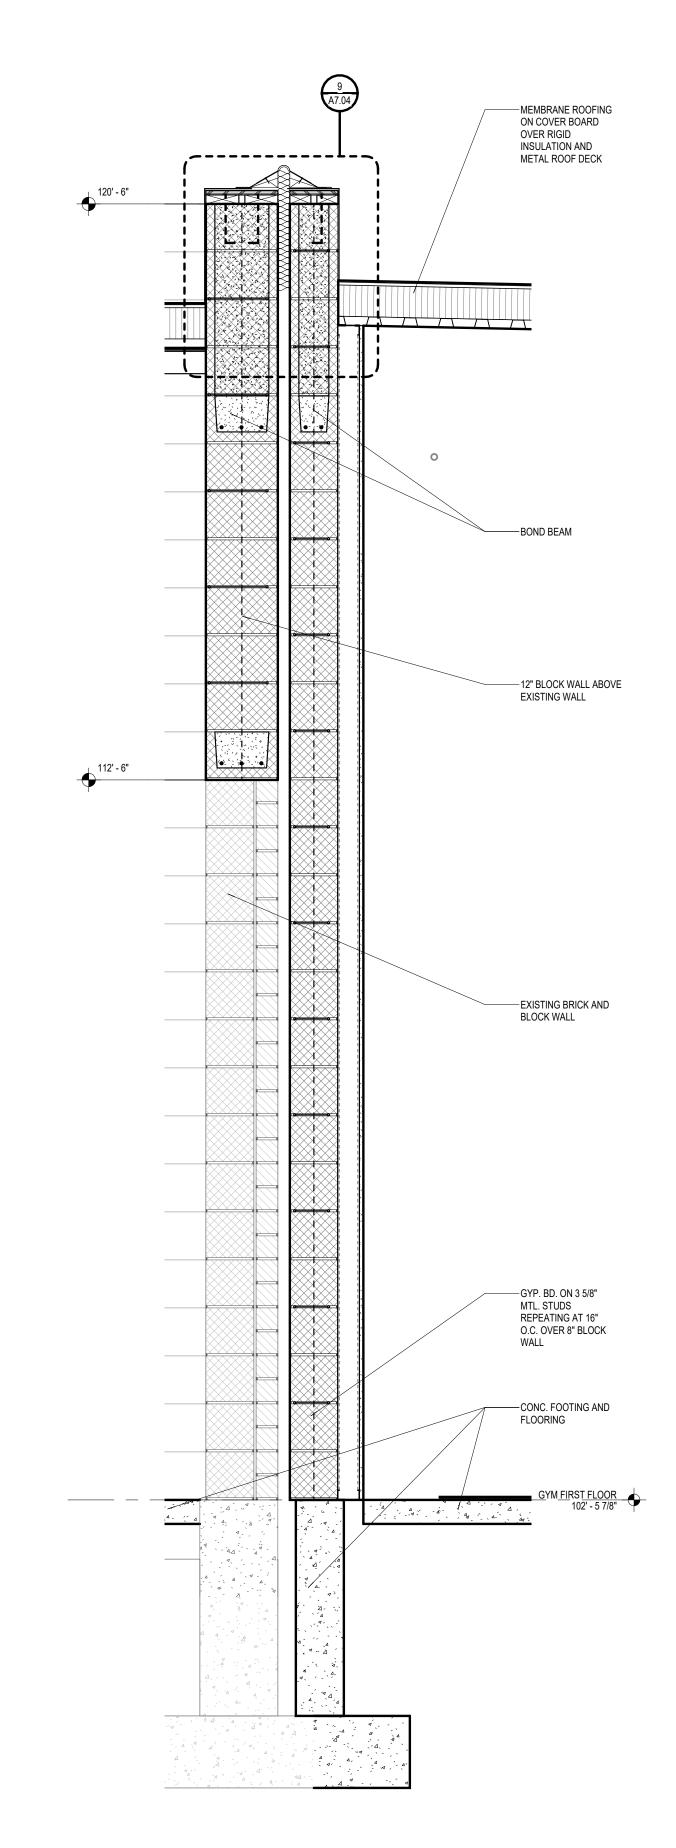

Maze Design, Inc.

3.18.2025

ISSUANCES 01.06.2025 BIDS & CONSTRUCTION

03.13.2025 BULLETIN 001

DRAWN JHB REVIEWED AGS


PROJECT NO. NO PART OF THIS DRAWING MAY BE USED OR REPRODUCED IN ANY FORM OR BY ANY MEANS, OR STORED IN A
DATA BASE OR RETRIEVAL SYSTEM,
WITHOUT PRIOR WRITTEN
PERMISSION OF GMB COPYRIGHT © 2025 ALL RIGHTS RESERVED

WALL SECTIONS

03.13.2025 BULLETIN 001

REVIEWED AGS PROJECT NO. NO PART OF THIS DRAWING MAY BE USED OR REPRODUCED IN ANY FORM OR BY ANY MEANS, OR STORED IN A DATA BASE OR RETRIEVAL SYSTEM, WITHOUT PRIOR WRITTEN PERMISSION OF GMB COPYRIGHT © 2025 ALL RIGHTS RESERVED

WALL SECTIONS

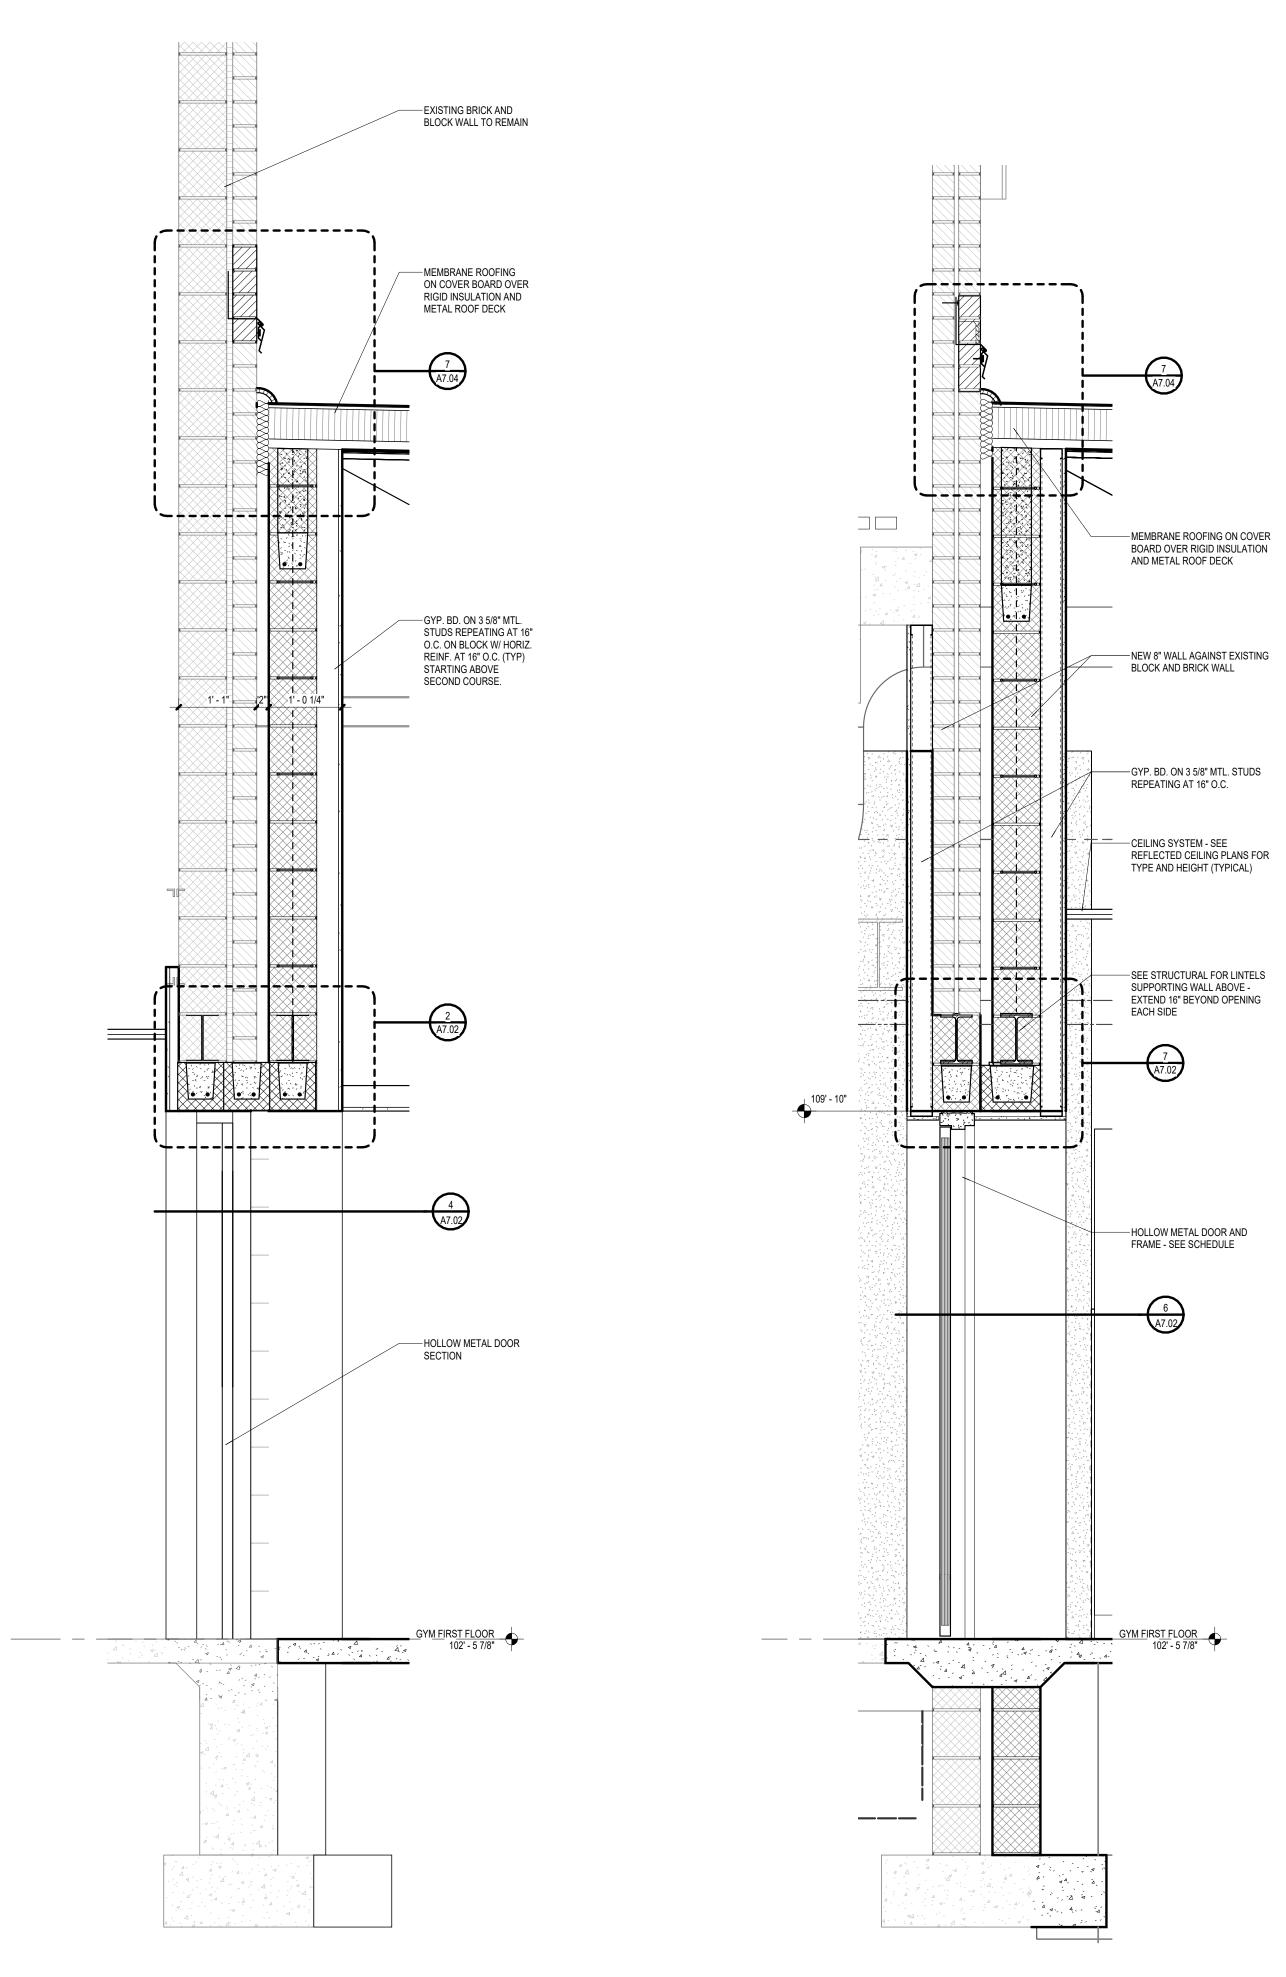


DD3 WALL SECTION DD3

A6.12 3/4" = 1'-0"





GG2 WALL SECTION GG2
A6.13 3/4" = 1'-0"

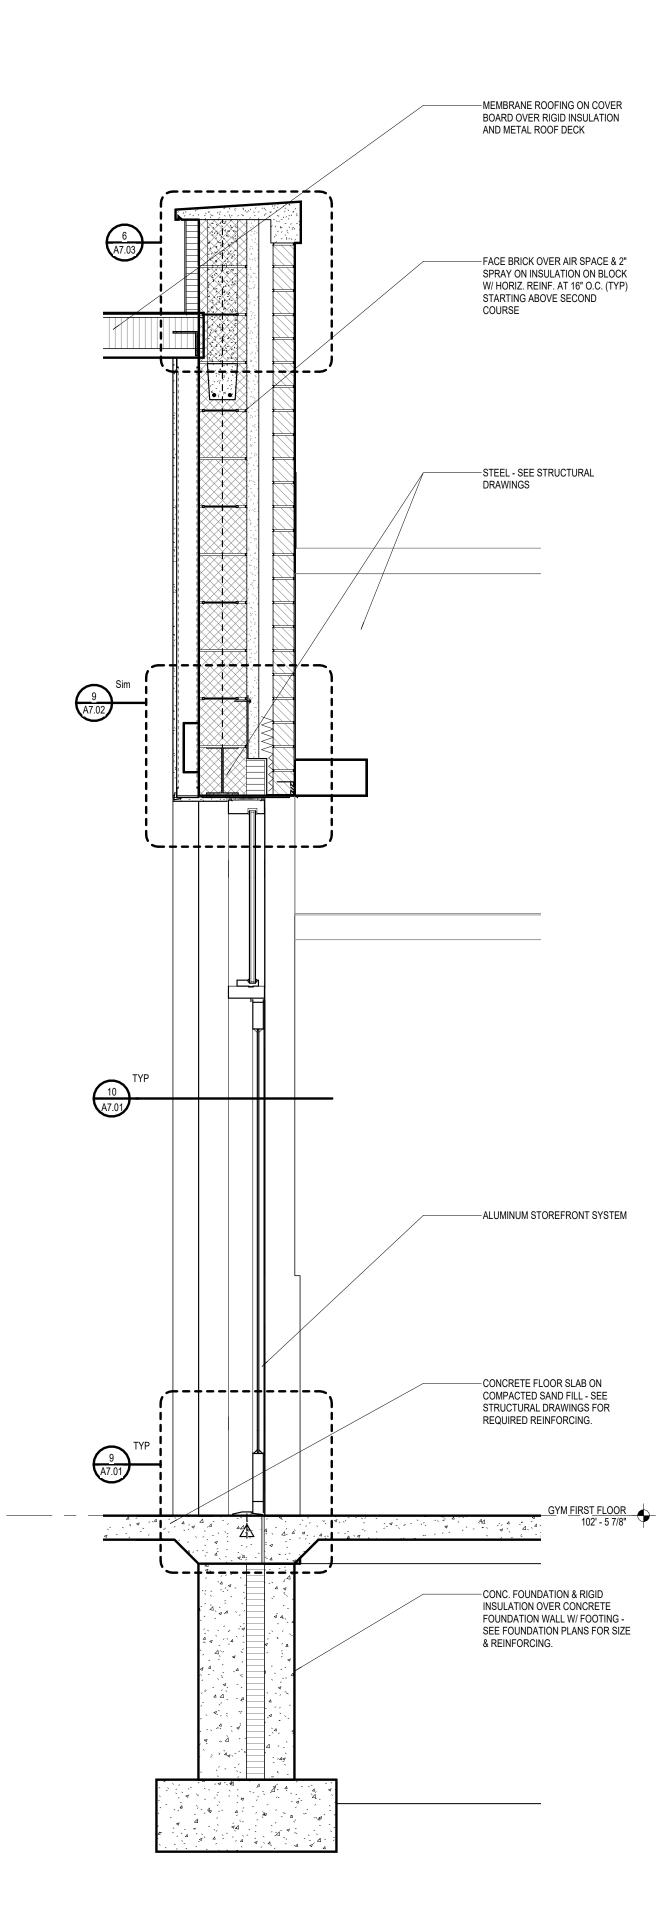



GG1 WALL SECTION GG1
A6.13 3/4" = 1'-0"

gmb

Maze Design, Inc.



3.18.2025

CHOOLS

STERN WAYNE SCHO
CAMBRIDGE CITY, INDIANA

WESTE

ISSUANCES

01.06.2025 BIDS & CONSTRUCTION

03.13.2025 BULLETIN 001

DRAWN JHB
REVIEWED AGS


PROJECT NO. 5-6394

NO PART OF THIS DRAWING MAY BE USED OR REPRODUCED IN ANY FORM OR BY ANY MEANS, OR STORED IN A DATA BASE OR RETRIEVAL SYSTEM, WITHOUT PRIOR WRITTEN PERMISSION OF

GMB COPYRIGHT © 2025
ALL RIGHTS RESERVED

WALL SECTIONS

A6.13

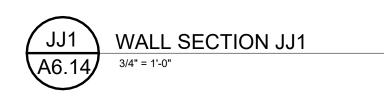

gmk

Maze Design, Inc.



3.18.2025

ERN WAYNE SCHOOL
CAMBRIDGE CITY, INDIANA

RN WAYNE SCHOOLS ADDITION:
WESTERN WAY

ISSUANCES

01.06.2025 BIDS & CONSTRUCTION
03.13.2025 BULLETIN 001

DRAWN JHB
REVIEWED AGS


PROJECT NO. 5-6394

NO PART OF THIS DRAWING MAY BE USED OR REPRODUCED IN ANY FORM OR BY ANY MEANS, OR STORED IN A DATA BASE OR RETRIEVAL SYSTEM, WITHOUT PRIOR WRITTEN PERMISSION OF

GMB COPYRIGHT © 2025 ALL RIGHTS RESERVED

WALL SECTIONS

A6.14

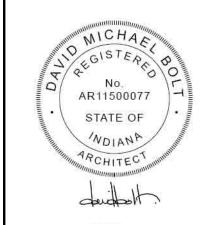

—3 5/8" METAL BRACING AT 48" O.C.

WHEN REQUIRED

-6" METAL STUDS @ 16" O.C

BRACING AT 48" O.C.

-CEILING SYSTEM - SEE

REFLECTED CEILING PLAN

TO DECK ABOVE

EXTENDED AND SECURED TO

ROOF DECK W/ 3 5/8" METAL

-5/8" GYP. W/ BATT. INSULATION

3.18.2025

0 SCHO ERN


ISSUANCES 01.06.2025 BIDS & CONSTRUCTION 01.16.2025 ADDENDUM 001


03.13.2025 BULLETIN 001

DRAWN JHB REVIEWED AGS PROJECT NO.

NO PART OF THIS DRAWING MAY BE USED OR REPRODUCED IN ANY FORM OR BY ANY MEANS, OR STORED IN A DATA BASE OR RETRIEVAL SYSTEM, WITHOUT PRIOR WRITTEN PERMISSION OF GMB COPYRIGHT © 2025 ALL RIGHTS RESERVED

DOOR DETAILS

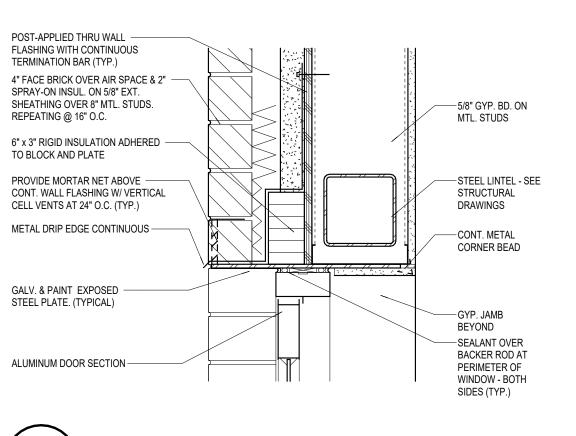

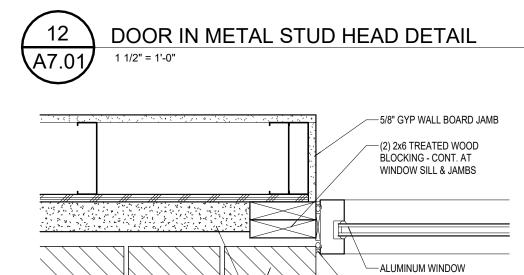

SECTION.

-SEALANT OVER BACKER

ROD AT PERIMETER OF


WINDOW - BOTH SIDES





4" FACE BRICK OVER AIR SPACE & 2" ----


SPRAY ON 5/8" FIBER GLASS REINF. GYP

WALL BOARD OVER 6" METAL STUDS @

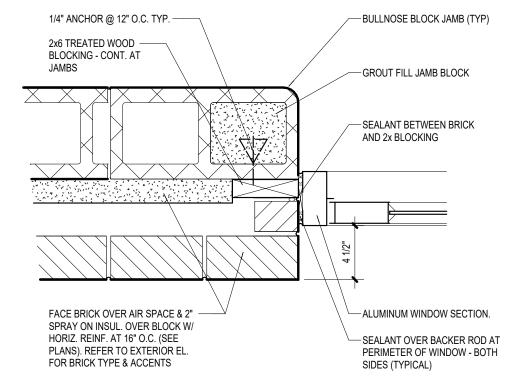


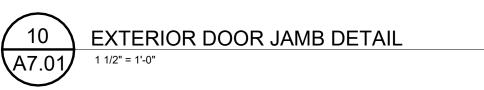

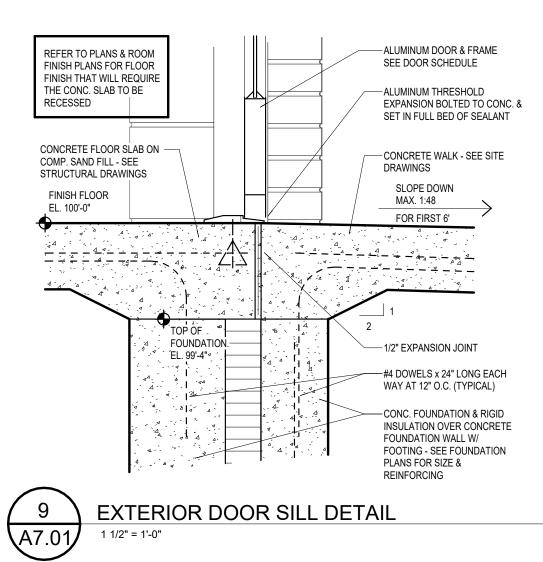

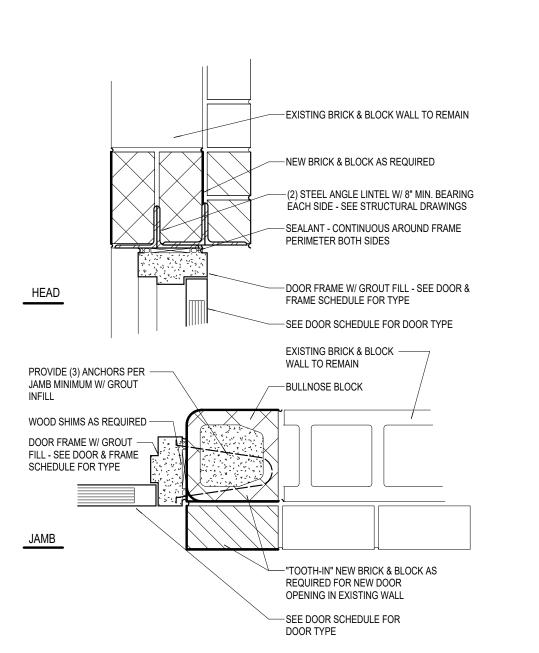



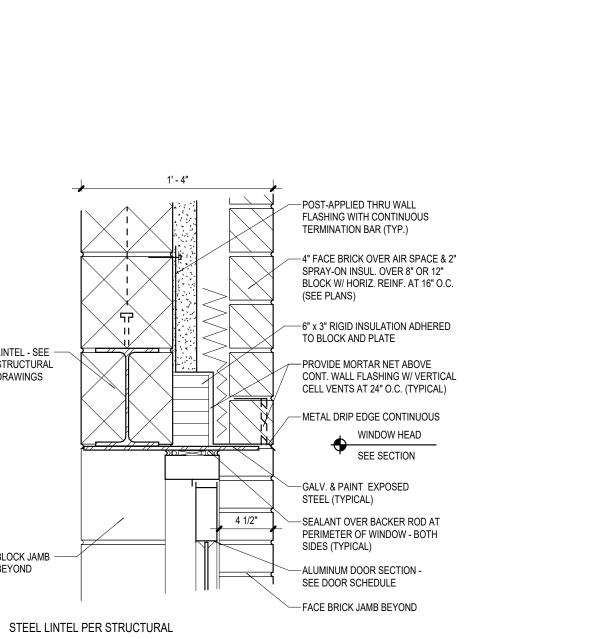

— 5/8" GYP WALL BOARD JAMB

-CERAMIC TILE OVER MORTOR ON BLOCK OVER AIR SPACE & 2" SPRAY ON INSULATION OVER 5/8" EXT. SHEATHING ON 8" MTL. STUDS

REPEATING @ 16" O.C. ON MTL.

—ALUMINUM WINDOW

— SEALANT OVER BACKER

ROD AT PERIMETER OF

WINDOW - BOTH SIDES

SECTION.

(TYPICAL)

DOOR IN METAL STUD JAMB DETAIL

(2) 2x6 TREATED WOOD ---

BLOCKING - CONT. AT

LINTEL - SEE -


STRUCTURAL


DRAWINGS


BLOCK JAMB -


BEYOND

WINDOW SILL & JAMBS

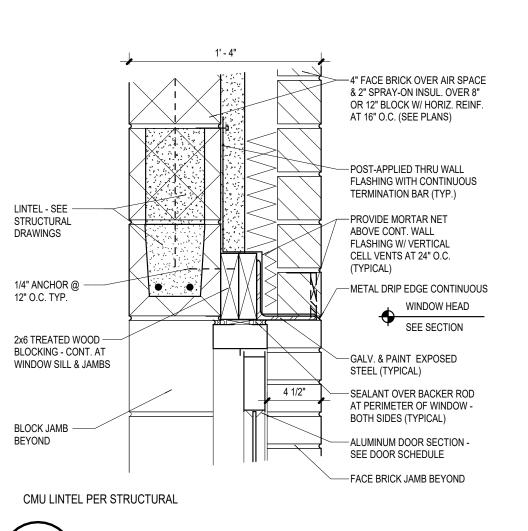


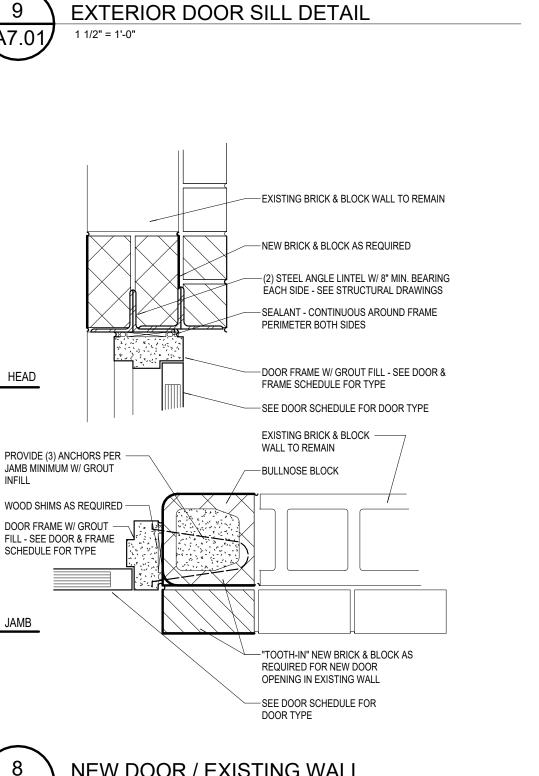

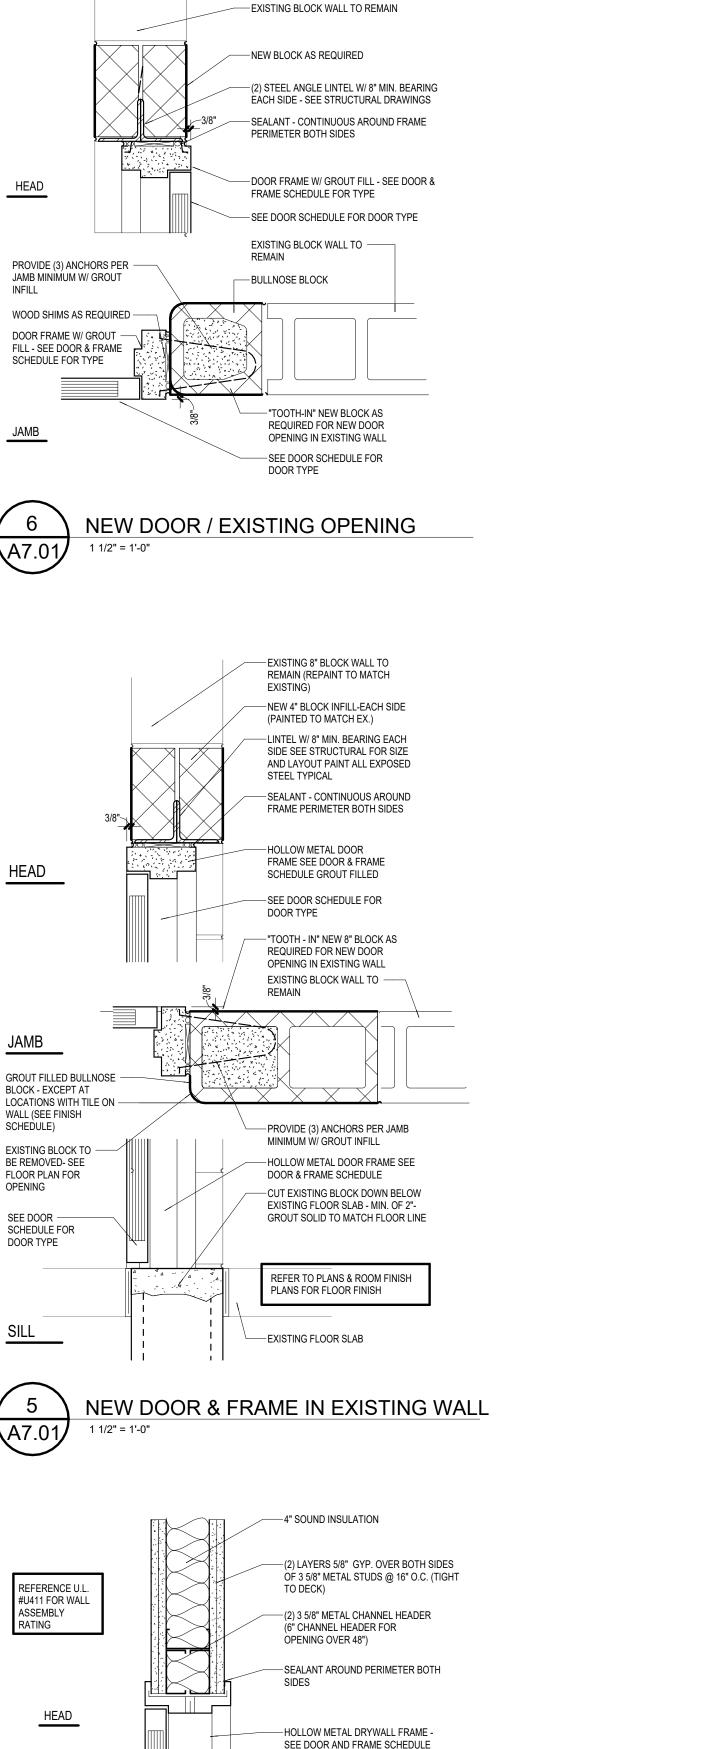

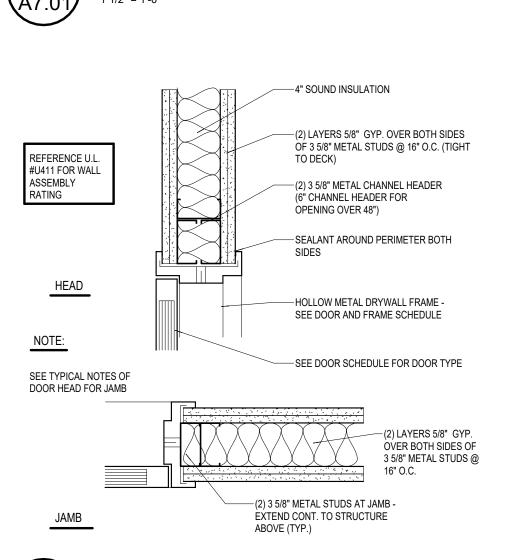



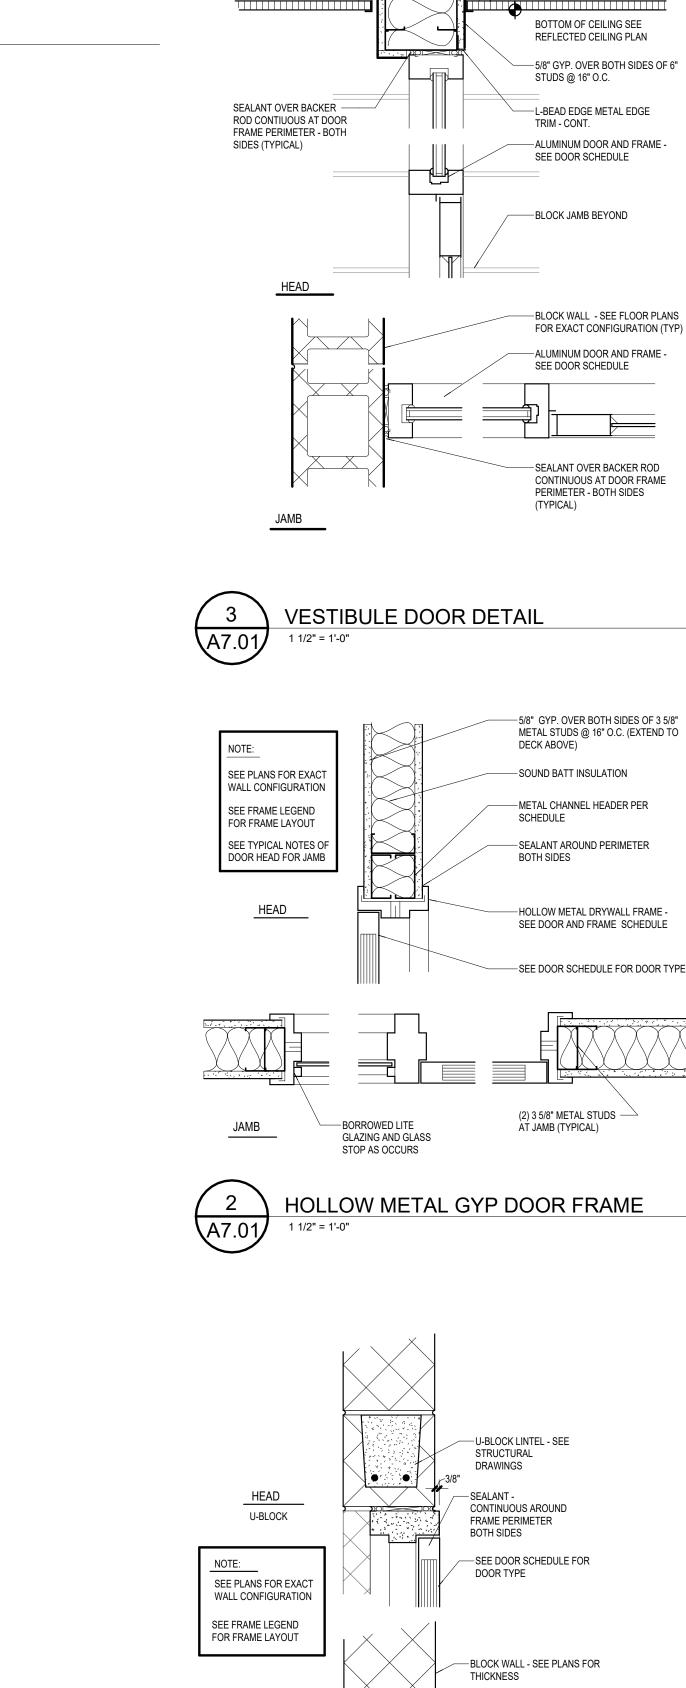

HEAD

DOOR FRAME W/ -

GROUT FILL - SEE

SCHEDULE FOR TYPE

STEEL BEAM

-STEEL LINTEL AND PLATE -

—SEE DOOR SCHEDULE

FOR DOOR TYPE

WOOD SHIMS ---

AS REQ.

BORROWED LITE GLAZING AND GLASS STOP

GROUT FILLED BULLNOSE BLOCK - EXCEPT -

—PROVIDE (3) ANCHORS PER JAMB MINIMUM —

HOLLOW METAL MASONRY DOOR FRAME

AT LOCATIONS WITH TILE ON WALL (SEE

FINISH SCHEDULE)

W/ GROUT INFILL

BOTH SIDES

AROUND FRAME PERIMETER

SEE STRUCTURAL DRAWINGS

(GALV. & PAINT ALL EXPOSED

METAL STUD HEADER —

SEE HEADER SCHEDULE

CEILING SYSTEM - SEE —

REFLECTED CEILING PLAN

-EXISTING BLOCK TO REMAIN

EXISTING LINTEL AND PLATE

— SEALANT - CONTINUOUS AROUND

FRAME PERIMETER BOTH SIDES

—DOOR FRAME W/ GROUT FILL -

—SEE DOOR SCHEDULE FOR

— EXISTING JAMB BLOCK (TYPICAL)

BORROWED LITE GLAZING AND GLASS STOP

— SEE DOOR SCHEDULE FOR DOOR TYPE

—EXPOSED HEADS TO BE BONDO FILLED

SEE DOOR & FRAME SCHEDULE FOR TYPE

(RE-PAINT)

TO REMAIN

DOOR TYPE

HEAD

NEW DOOR & SIDELITE IN EX. OPENING

SEE PLANS FOR EXACT WALL CONFIGURATION

SEALANT - CONTINUOUS AROUND —

FRAME PERIMETER BOTH SIDES

JAMB

—EXISTING BLOCK WALL TO

PROVIDE (3) NEW ANCHORS FOR EXISTING —

MASONRY WITH 3/8" DIA. BOLTS PER JAMB

EXTERIOR DOOR HEAD DETAIL

-----BLOCK WALL - SEE PLANS FOR

—STEEL LINTEL AND PLATE - SEE

— SEALANT - CONTINUOUS AROUND FRAME PERIMETER BOTH SIDES

STRUCTURAL DRAWINGS (GALV. & PAINT ALL EXPOSED

THICKNESS

STEEL LINTEL HEAD

SCHOOLS ERN

ISSUANCES 01.06.2025 BIDS & CONSTRUCTION


03.13.2025 BULLETIN 001


DRAWN JHB REVIEWED AGS PROJECT NO.


NO PART OF THIS DRAWING MAY BE USED OR REPRODUCED IN ANY FORM OR BY ANY MEANS, OR STORED IN A DATA BASE OR RETRIEVAL SYSTEM, WITHOUT PRIOR WRITTEN GMB COPYRIGHT © 2025 ALL RIGHTS RESERVED


DOOR DETAILS

COILING CONCESSIONS DOOR DETAIL

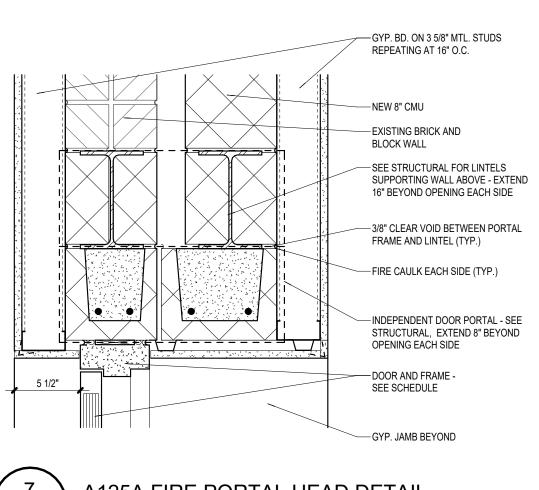


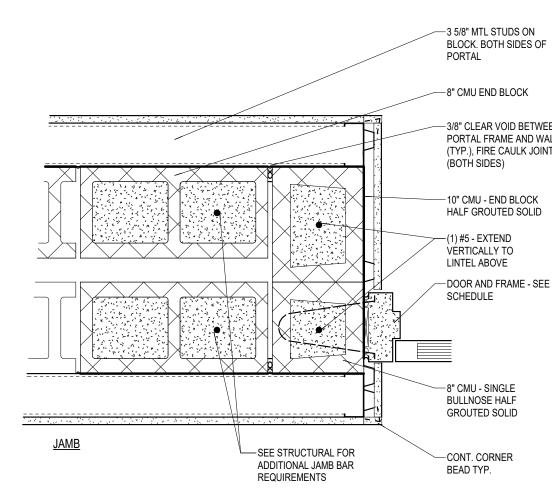

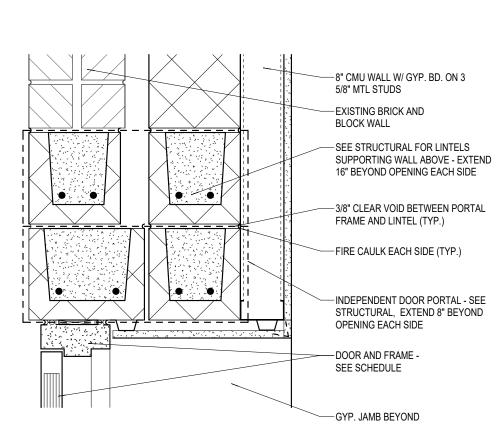

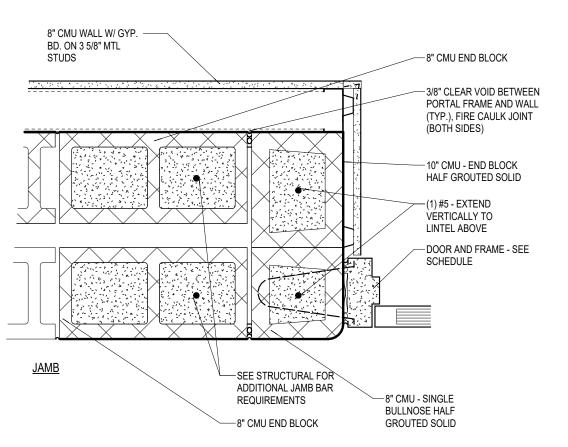



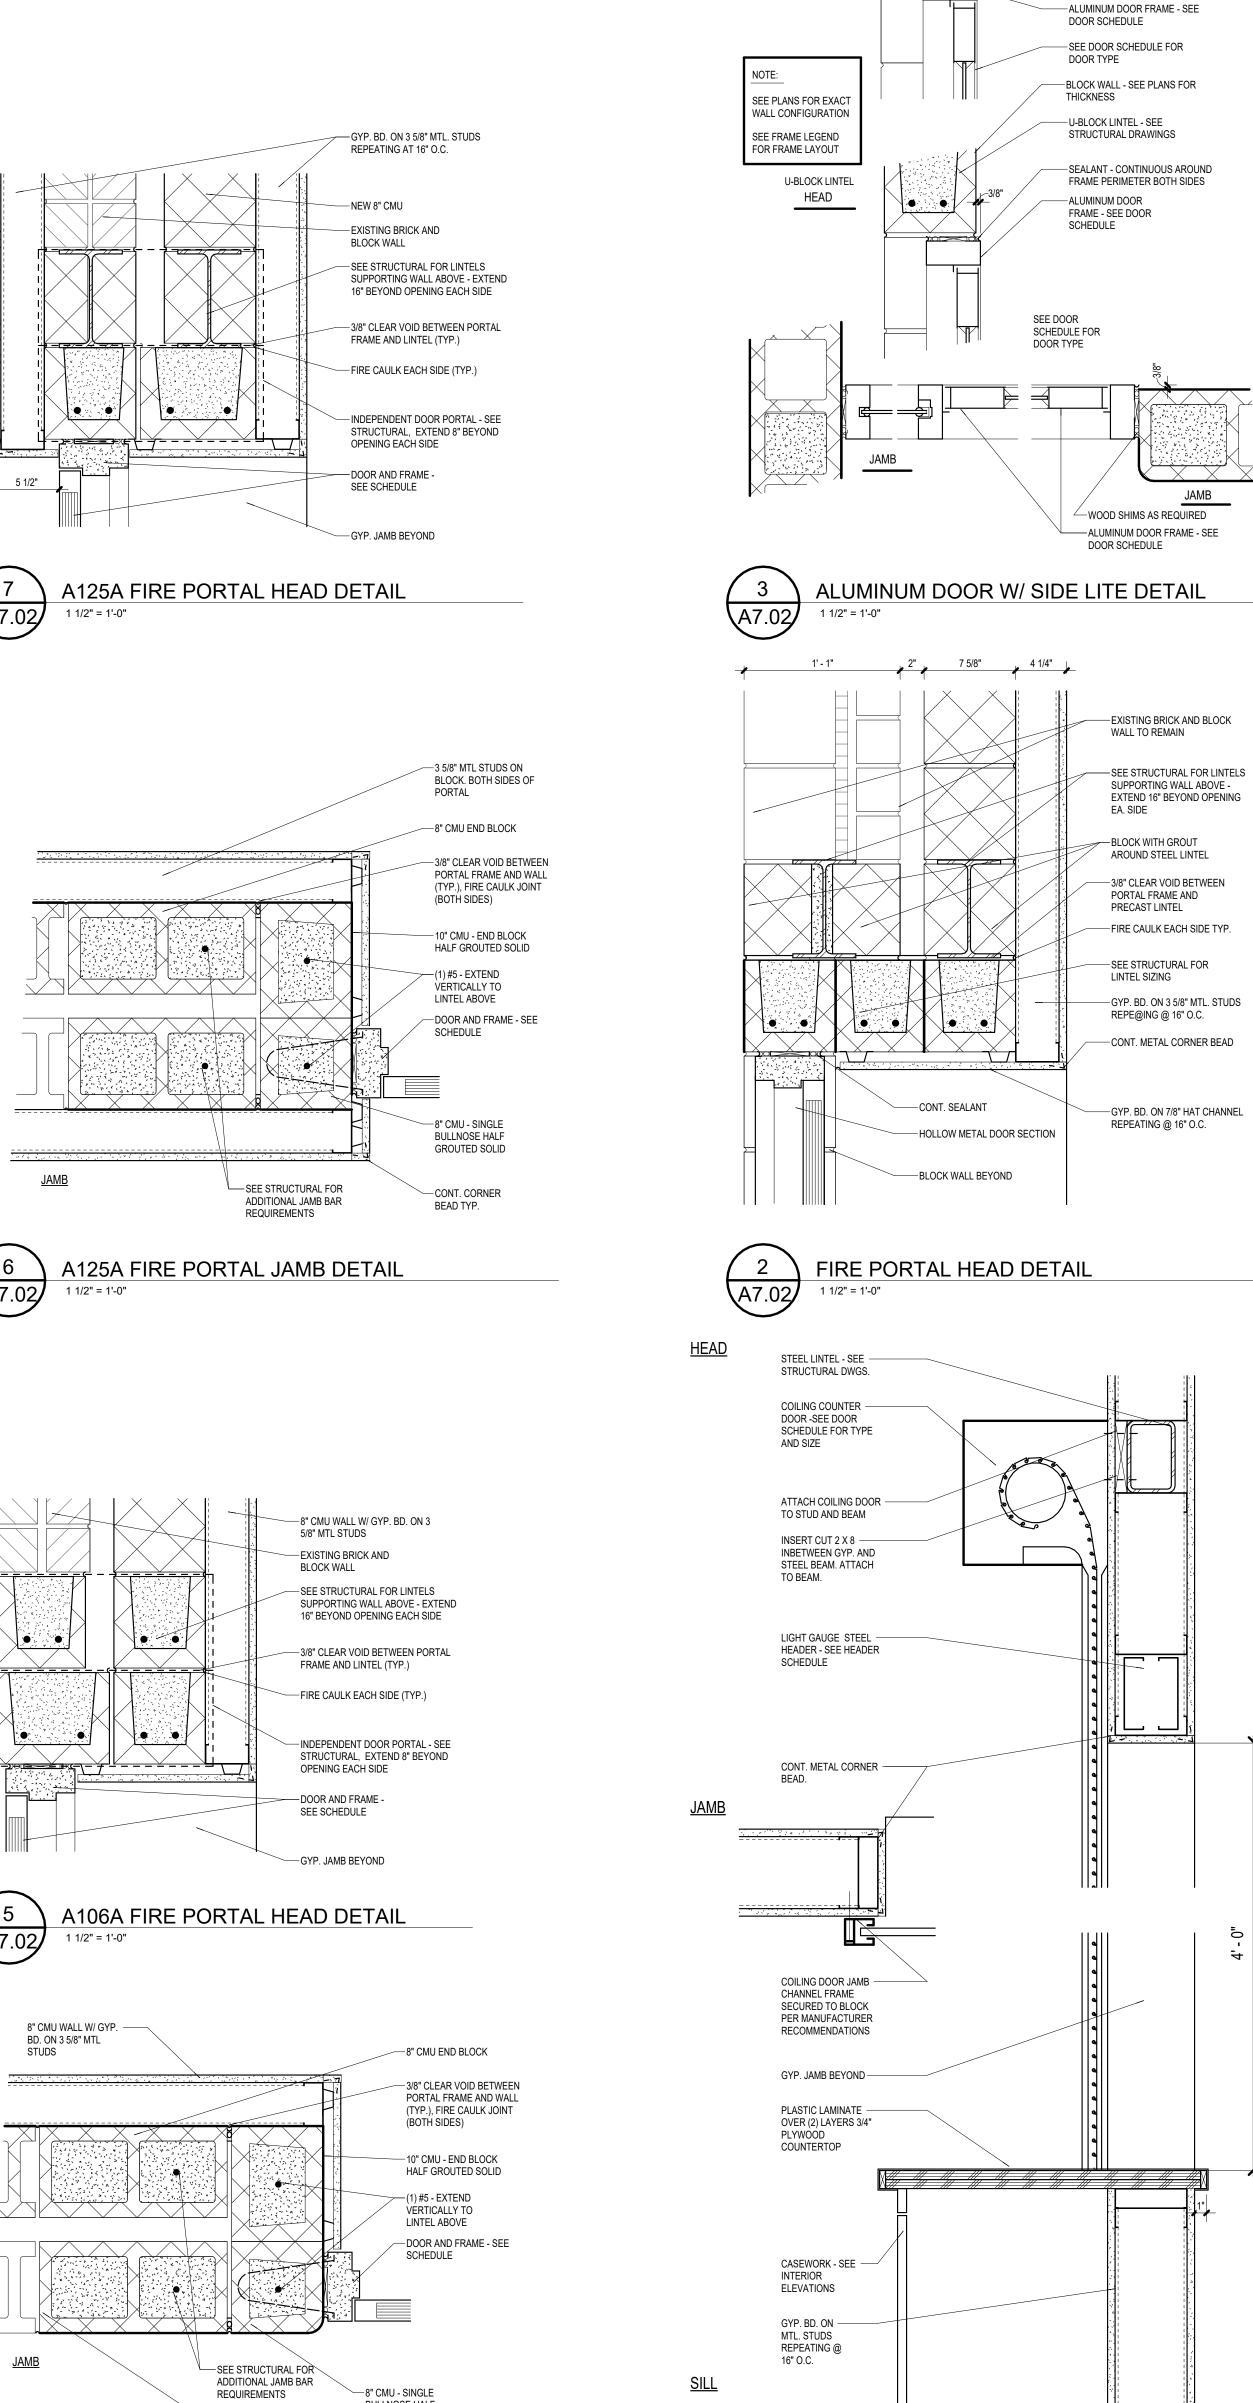


ISSUANCES 01.06.2025 BIDS & CONSTRUCTION 01.16.2025 ADDENDUM 001 03.13.2025 BULLETIN 001


DRAWN JHB REVIEWED AGS PROJECT NO. NO PART OF THIS DRAWING MAY BE USED OR REPRODUCED IN ANY FORM OR BY ANY MEANS, OR STORED IN A DATA BASE OR RETRIEVAL SYSTEM, WITHOUT PRIOR WRITTEN


GMB COPYRIGHT © 2025 ALL RIGHTS RESERVED WALL AND WINDOW DETAILS

— CONT. P.T. 2x12 WOOD NAILER SECURED INTO 2x6 NAILERS BELOW WITH 3" GALV. — CONT. MASTIC SEALANT --- CONT PRE-ENGINEERED PARAPET CAP SYSTEM. WOOD SCREWS AT 12" O.C. STRANDGUARD TIMBERSTRAND LSL BY PREBUCK —P.T 2x3 WOOD NAILER SECURED -3/4" TREATED PLYWOOD ON 2x TREATED — CONT. MASTIC SEALANT ENGINEERED FRAMING SYSTEMS. 1 1/2" THICK WITH TO 2x12 NAILER BEHIND WITH 3" WOOD BLOCKING CONTINUOUS W/ TAPER PROFILE AND COUNTERSUNK SLOTTED HOLES GALV. WOOD SCREWS COUNTERSUNK 1/2" DIA X 6" RED HEAD LDT @ 24" O.C. STAGGERED FOR 1/2" DIA x 6" LDT REDHEAD —FACE BRICK JAMB ANCHORS @ 24" O.C. (STAGGERED) INTO NEW CONT 24 GA. PREMIUM -NEW CONT 24 GA CONT GROUTED TOP COURSE PREMIUM TWO PIECE PREMANUFACTURED 4" —CONTINUE MEMBRANE - ALUMINUM WINDOW SECTION PREMANUFACTURED OVER TOP OF WALL METAL FASCIA WITH — METAL DECK — 5 1/2" METAL FASCIA EXTENSION AND CONT WITH EXTENSION AND HOLD DOWN CLIP (COMPLY /- 1/2" SOLÌD SURFACE WINDOW —SEALANT OVER BACKER ROD - HOLD WALLS SHORT OF DECK -CONT HOLD DOWN WITH ES-1 PER SPRI AT PERIMETER OF WINDOW FOR DEFLECTION (SEE CLIP (COMPLY WITH TESTING) WITH #9 x 2" BOTH SIDES (TYPICAL) STRUCTURAL) FILL VOID W/ ES-1 PER SPRI -2" RIGID INSULATION STAINLESS STEEL SCREW TESTING) WITH #9 x 2" FASTENERS AT 12"O.C. OR STAINLEŚS STEEL PARAPET WALL NRCA APPROVED DETAIL -CONCRETE MASONRY UNITS -SCREW FASTENERS AT 12" O.C. OR NRCA SEE SECTION -MEMBRANE ROOFING ON APPROVED DETAIL COVER BOARD OVER SEE SPEC -ALUMINUM WINDOW SILL RIGID INSULATION AND −8# MINERAL WOOL COMPRESSED 50% — 1/4" AIR SPACE. — METAL ROOF DECK AND INSERTED INTO FLUTES FLUSH CONT. SEALANT W/ ---PROVIDE CONT. CAULK —SET WEEP FLUSH WITH TILE WITH FACES OF WALL BACKER ROD AND BACKERROD TYP. — CONT. 2X WOOD BLOCKING VERTICAL CELL VENTS -VERTICAL CELL VENTS -AT 48" O.C. (TYPICAL) AT 48" O.C. (TYPICAL) 4" FACE BRICK OVER AIR -CERAMIC TILE ON SPACE & 2" SPRAY ON MORTOR ON BLOCK OVER (2) CONT. P.T. 2x6 ANCHORED -— 1/8" THICK FIRESTOP SPRAY — AIR SPACE & 2" SPRAY ON INSUL. OVER 8" OR 12" OVERLAP ONTO WALL & DECK A TO BLOCK WITH 1/4" DIA BLOCK W/ HORIZ. REINF. INSULATION ON BLOCK W/ TAPCON AT 24" O.C. INTO MINIMUM OF 1/2" (TYPICAL BOTH AT 16" O.C. (SEE PLANS) HORIZ. REINF. AT 16" O.C. SIDES OF WALL) BLOCK W/ 1 1/2" EMBEDMENT (TYP) STARTING ABOVE SECOND COURSE. — CONCRETE MASONRY UNITS — 4" FACE BRICK OVER AIR -SPACE & 2" SPRAY ON INSUL. OVER 8" OR 12" BLOCK W/ HORIZ. REINF. AT 16" O.C. (SEE PLANS) WINDOW SILL DETAIL W/ TILE SEE FLOOR PLANS SEE FLOOR PLANS FIRE-RATED WALL (TYP.)




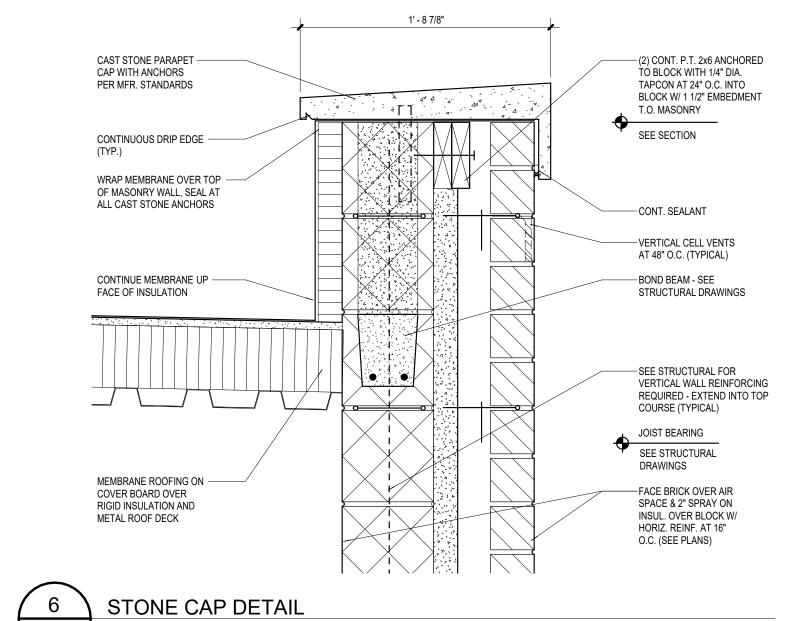


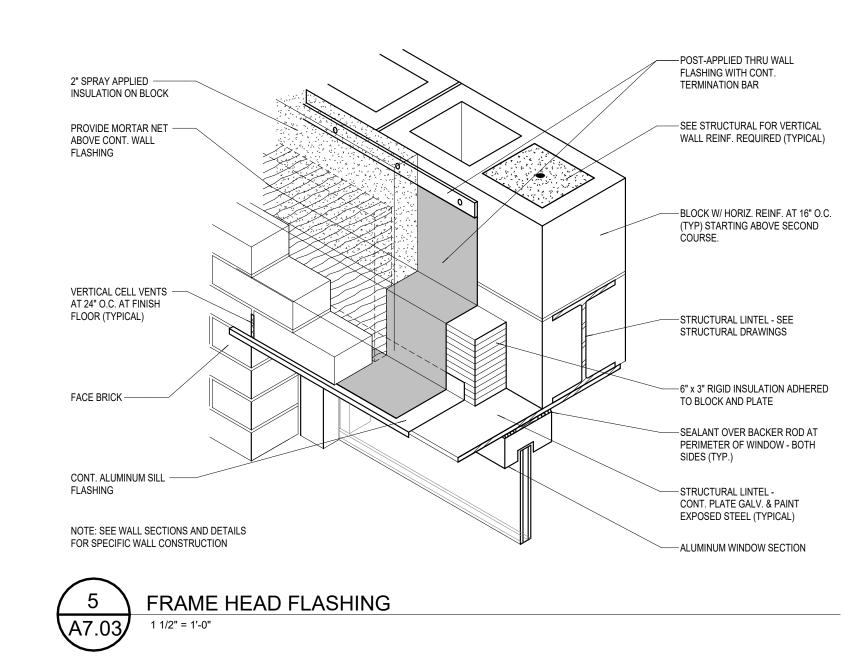


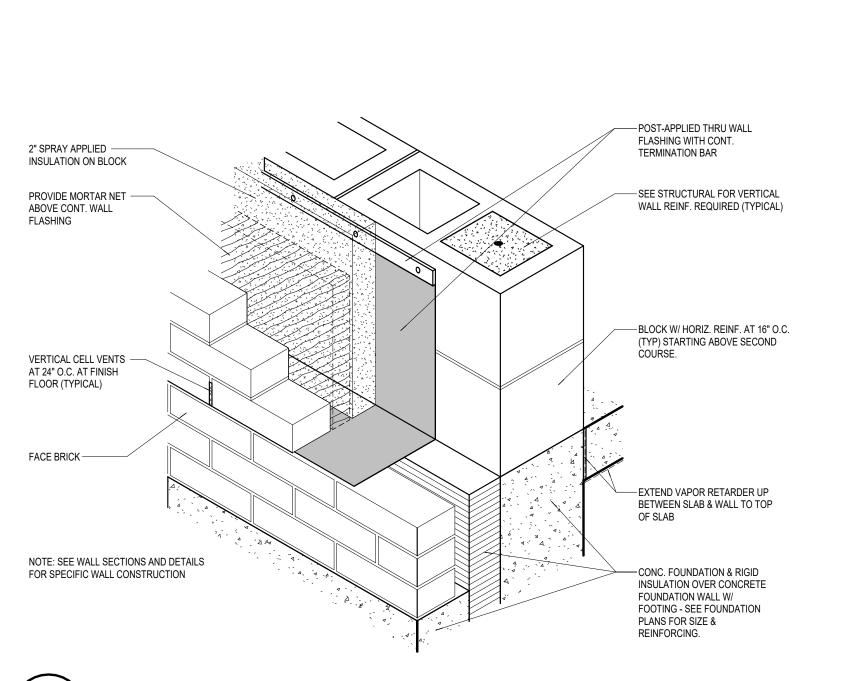





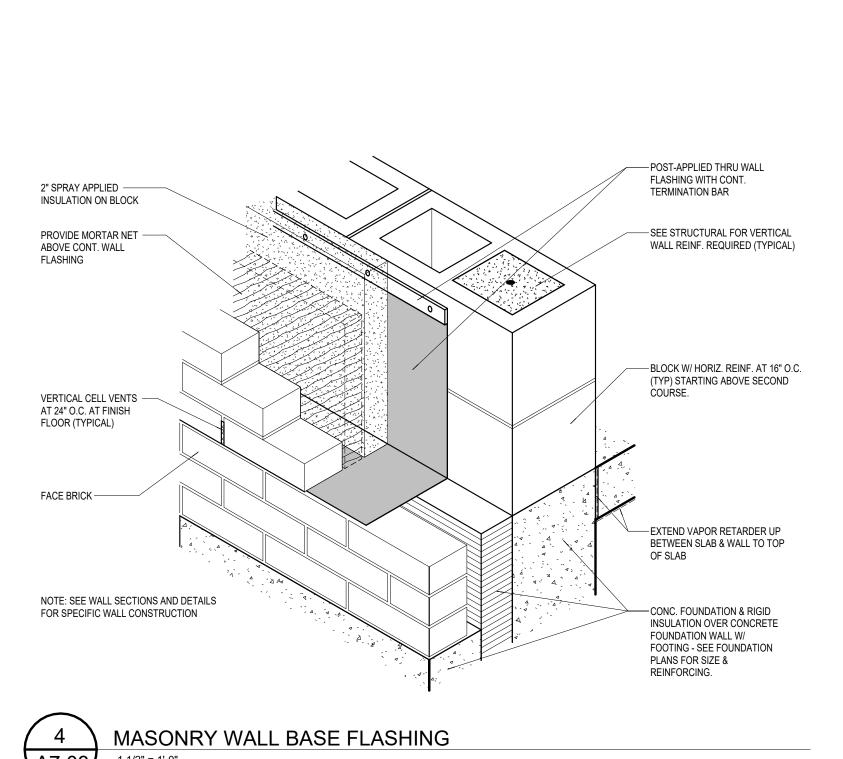


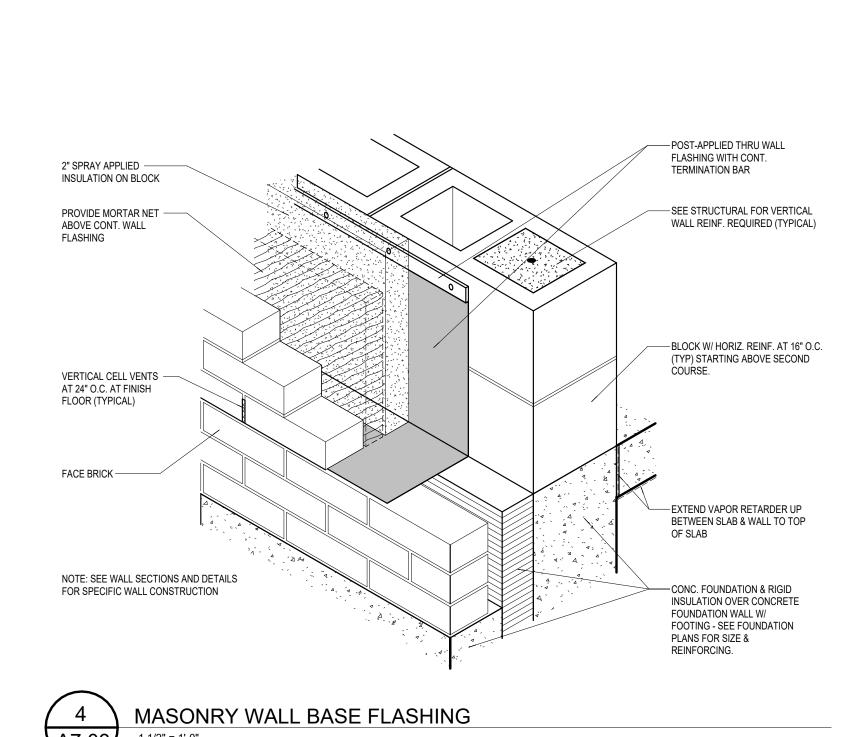

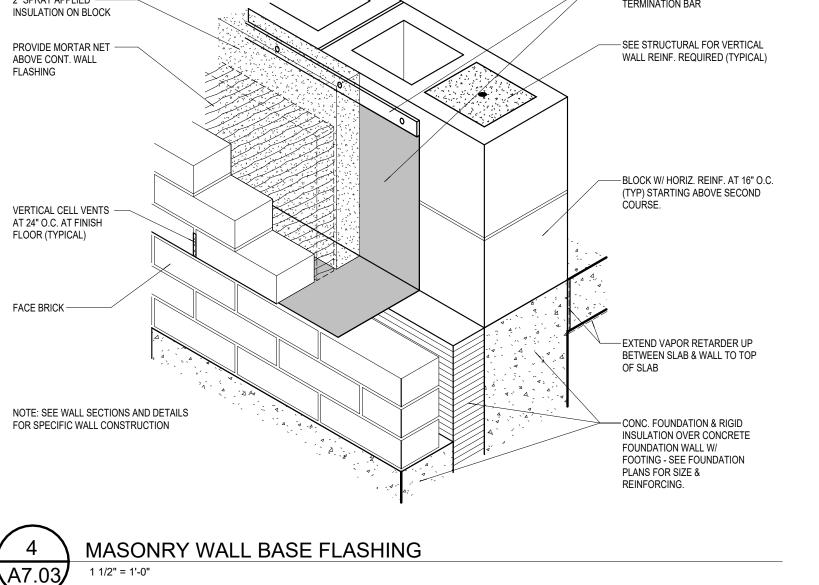

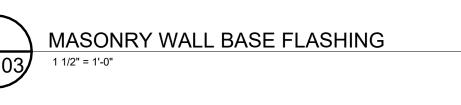

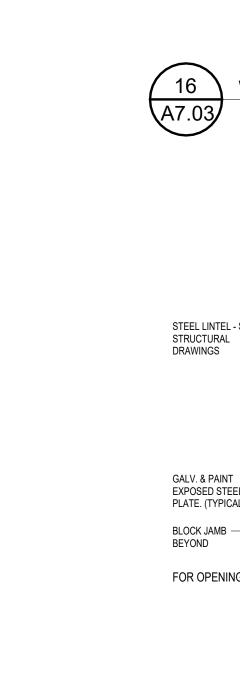

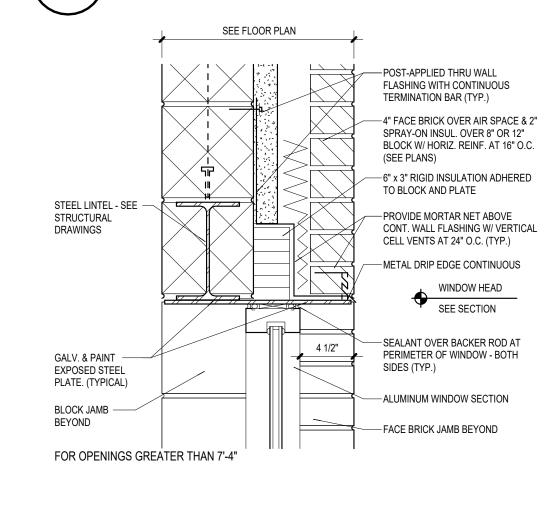

- BULLNOSE BLOCK -


STOOL ON EPOXY SETTING


BED ON BLOCK, GROUT TOP


JAMB BEYOND


—COURSE—₁


ELEVATION

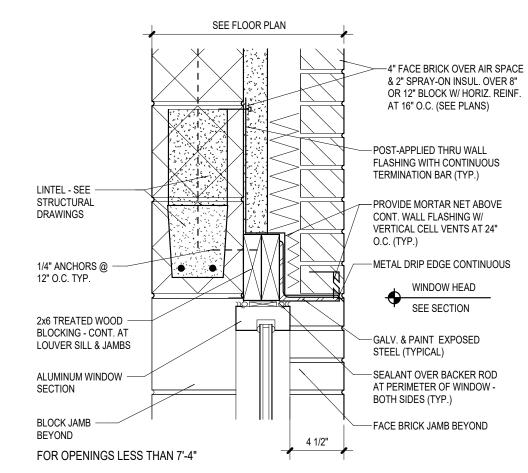


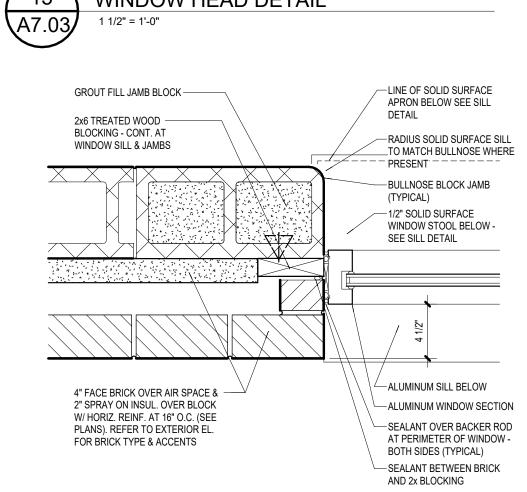

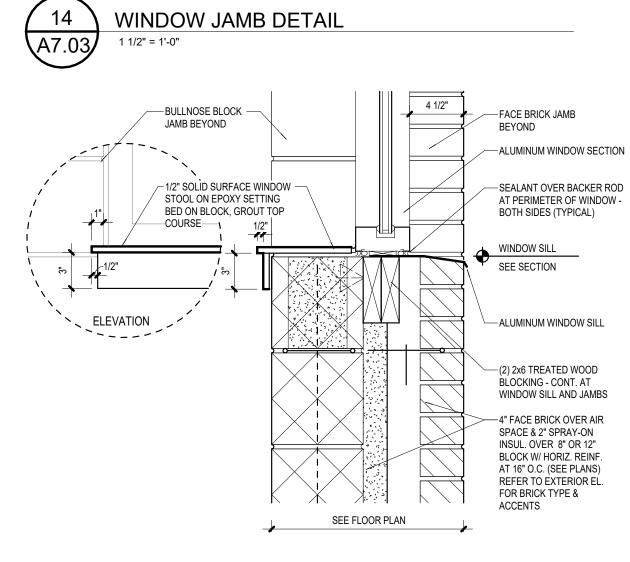

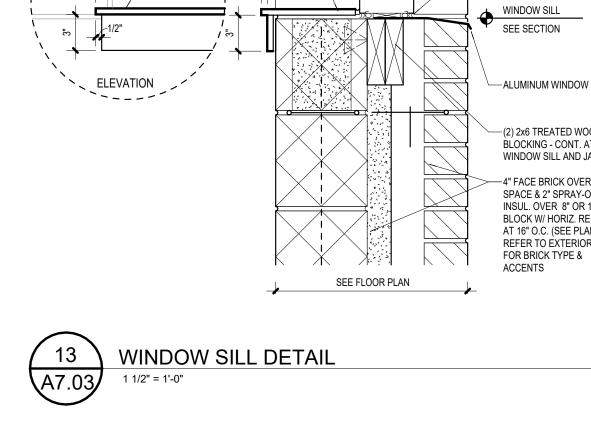

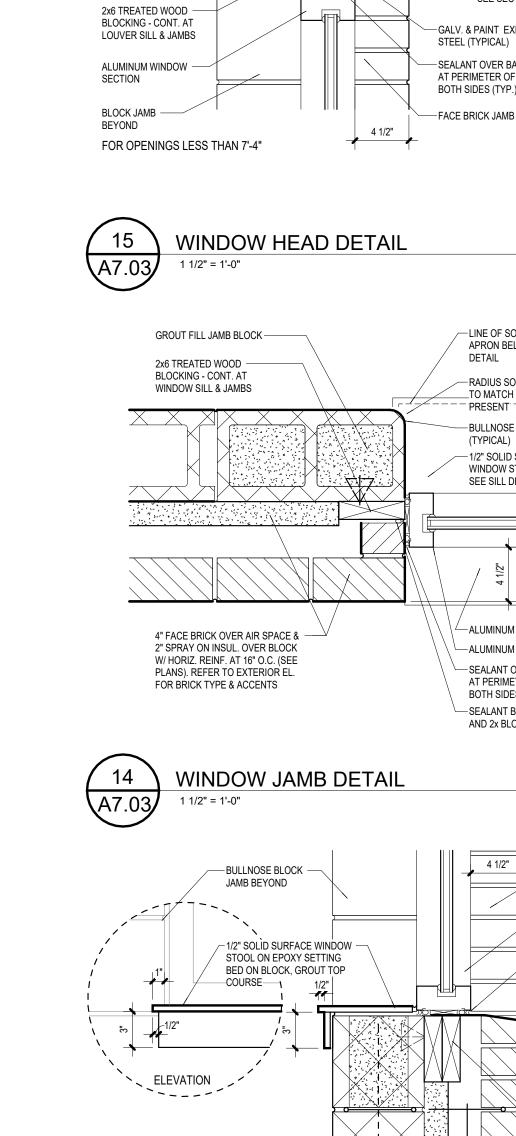

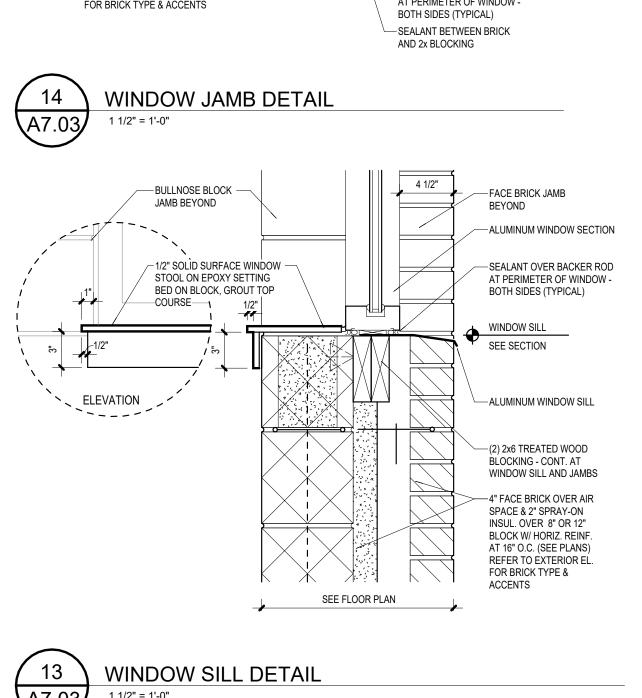



CONTROL JOINT

MOVEMENT JOINTS

TOP OF WALL DETAILS

-3/8" SEALANT JOINT W/

-FILL BLOCK CORES W/

-CONT L 3"x 3"x 1/4" ANGLE SECURED TO EX. WALL W/ 1/2" DIA.

FULL HEIGHT OF WALL

BLOCK CONNECTION TO EX. WALL

ADHESIVE ANCHORS AT 32" O.C.-

- ISOLATE ONE SIDE OF

BLOCK CORE W/ 15#

FELT CONTINUOUS & FILL CORE W/GROUT

SEE STRUCTURAL FOR ADDITIONAL INFORMATION

BLOCK CONTROL JOINTS NEED NOT ALIGN WITH

EXISTING WALL - SEE PLANS

AND ELEVATIONS FOR WALL

-4" FACE BRICK OVER AIR SPACE

AND 2" SPRAY ON INSUL. OVER 8"

OR 12" BLOCK W/ HORIZ. REINF. AT 16" O.C. (TYPICAL)

-FILL BLOCK CORES W/

-CONT L3"x 3"x 1/4" ANGLE SECURED

- ISOLATE ONE SIDE OF BLOCK CORE W/ 15

—CONTROL JOINT (C.J.) 1/2" DEEP SEALANT JOINT

W/ BACKER ROD CONT. AT FACE BRICK OVER

CONT. PREMOLDED COMPRESSIVE JOINT

FILLER. SEE STRUCTURAL FOR ADDITIONAL

INFORMATION & JOINT LOCATIONS

SEE PLANS & ELEVATIONS FOR MASONRY JOINT

LOCATIONS - SPACE 20 FEET APART MAXIMUM

DO NOT CONTINUE JOINT REINF. THRU BLOCK

BLOCK CONTROL JOINTS NEED NOT ALIGN WITH

FELT CONTINUOUS & FILL CORE W/

TO EXISTING WALL W/ 1/2" DIA.

ADHESIVE ANCHORS AT 32" O.C

FULL HEIGHT OF WALL

CONCRETE FILL

MASONRY CONNECTION TO EXIST. WALL

AND JOINT LOCATIONS

MOVEMENT JOINTS

CONCRETE FILL.

BOTH SIDES

BACKER ROD CONTINUOUS

1 1/2" = 1'-0"

1/2" DEEP SEALANT JOINT ----

W/BACKER ROD CONTINUOUS

ON BOTH FACES OF BLOCK

NOTE:

TIE ANY NEW THRU WALL

THRU WALL FLASHING

FLASHING INTO EXISTING

-3/8" SEALANT JOINT

CONTINUOUS BOTH

1/2" DEEP SEALANT JOINT W/ -

BACKER ROD CONTINUOUS ON

FACE BRICK OVER AIR SPACE & ---

2" SPRAY ON INSUL. ON BLOCK

- MASONRY JOINT (M.J.) LOCATION

SEALANT AND BACKER ROD


OVER BRICK MASONRY JOINT

W/ HORIZ. REINF. AT 16" O.C.

BOTH FACES OF BLOCK

W/ BACKER ROD

A7.03

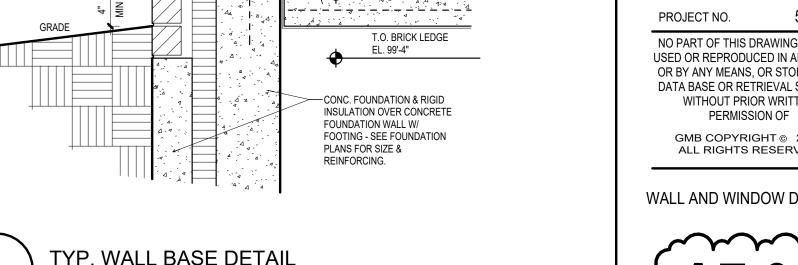

—SEE STRUCTURAL FOR VERTICAL WALL REINF. REQUIRED (TYPICAL)

-POST-APPLIED THRU WALL

-WALL BASE- SEE ROOM FINISH

—EXTEND VAPOR RETARDER UP

-CONCRETE FLOOR SLAB OI

REQUIRED REINFORCING.

COMPACTED SAND FILL - SEE

STRUCTURAL DRAWINGS FOR

FINISH FLOOR

EL. 100'-0"

—CONC. FOUNDATION & RIGID

INSULATION OVER CONCRETE

T.O. BRICK LEDGE

—SEE STRUCTURAL PLANS FOR

-POST - APPLIED THRU WALL

-WALL BASE - SEE ROOM FINISH

-EXTEND VAPOR RETARDER UP

-CONCRETE FLOOR SLAB ON

COMPACTED SAND FILL - SEE

STRUCTURAL DRAWINGS FOR

INSULATION OVER CONCRETE

FOUNDATION WALL W/

PLANS FOR SIZE &

FOOTING - SEE FOUNDATION

FINISH FLOOR

T.O. BRICK LEDGE

— SEE STRUCTURAL FOR VERTICAL

-WALL BASE- SEE ROOM FINISH

-EXTEND VAPOR RETARDER UF

-CONCRETE FLOOR SLAB ON

COMPACTED SAND FILL - SEE

REQUIRED REINFORCING. FINISH FLOOR

EL. 100'-0"

BETWEEN SLAB & WALL TO TOP

-POST-APPLIED THRU WALL

FLASHING WITH CONT.

TERMINATION BAR

WALL REINF. REQUIRED (TYPICAL)

REQUIRED REINFORCING

BETWEEN SLAB & WALL TO TOP

FLASHING WITH CONT.

TERMINATION BAR

(TYPICAL)

PLANS

VERTICAL WALL REINF. REQUIRED

EL. VARIES - SEE STRUCTURAL

FOUNDATION WALL W/ FOOTING -SEE FOUNDATION PLANS FOR SIZE

BETWEEN SLAB & WALL TO TOP

FLASHING WITH CONT.

TERMINATION BAR

OF SLAB

FACE BRICK OVER AIR -

SPACE & 2" SPRAY ON

INSULATION ON BLOCK

W/ HORIZ. REINF. AT 16" O.C. (TYP) STARTING

PROVIDE MORTAR NET -

FLASHING W/ VERTICAL

CELL VENTS AT 24" O.C. AT FINISH FLOOR

PROVIDE DOVETAIL SLOTS

AT AREAS OF BRICK 16" OR

ABOVE CONT. WALL

ABOVE SÉCOND

COURSE.

(TYPICAL)

HIGHER ALONG

FACE BRICK OVER AIR -

SPACE & 2" SPRAY ON

INSULATION ON BLOCK

O.C. (TYP) STARTING

ABOVE SÉCOND

COURSE

W/ HORIZ. REINF. AT 16"

PROVIDE MORTAR NET -

FLASHING W/ VERTICAL

CELL VENTS AT 24" O.C.

4" CONC. MAINT. STRIP -

FACE BRICK OVER AIR -

SPACE & 2" SPRAY ON

PROVIDE MORTAR NET -

FLASHING W/ VERTICAL

CELL VENTS AT 24" O.C.

ABOVE CONT. WALL

AT FINISH FLOOR

(TYPICAL)

INSULATION ON BLOCK W/ HORIZ. REINF. AT 16"

O.C. (TYP) STARTING

ABOVE SECOND

COURSE.

COORDINATE W/ SITE PLAN


AT FINISH FLOOR

(TYPICAL)

ABOVE CONT. WALL

FOUNDATION WALLS



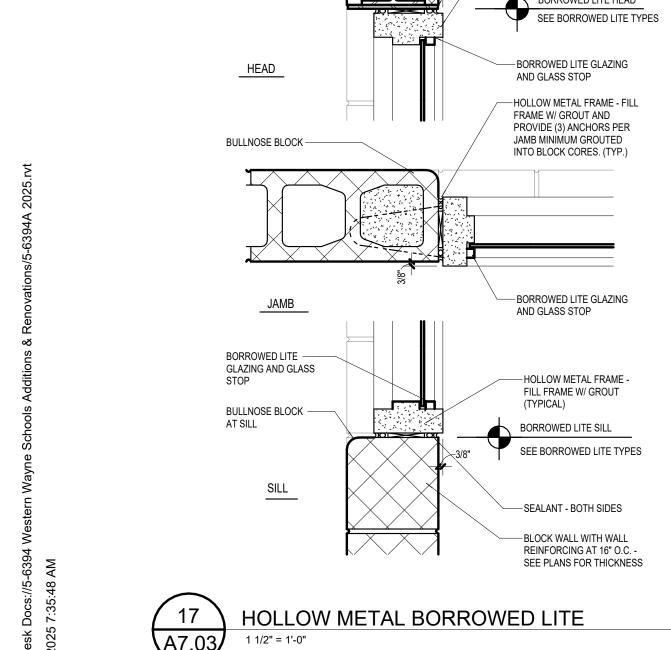

FLASHING IS TO BE POST APPLIED WITH A -TERMINATION BAR SYSTEM OR ADHERED

-TURN FLASHING ENDS UP 2" MINIMUM $\,-\,$

INTO HEAD JOINTS TO FORM SIDE DAMS

FLASHING DAMS ARE REQUIRED AT ALL

OTHER FLASHING ENDS TO BE LAPPED 6"

OPENINGS AND BELOW ALL SILLS. ALL

MINIMUM AND JOINTS SEALED

TYPICAL FLASHING & DAM DETAIL

2. ALL EXPOSED EDGE TO BE HEMMED

—4" SOUND BATT INSULATION

----5/8" GYP. OVER BOTH SIDES

—SEALANT AROUND PERIMETER

FRAME - SEE BORROWED

AT JAMB - FLOOR TO

STRUCTURE ABOVE

SEE TYPICAL NOTES OF BORROWED LITE HEAD

AND GLASS STOP

- HOLLOW METAL DRYWALL FRAME

SEE BORROWED LITE SCHEDULE

— SEALANT AROUND PERIMETER

-(2) 3 5/8" METAL STUDS AT SILL

-STEEL LINTEL & PLATE - SEE

(GALV. & PAINT ALL EXPOSED

AROUND FRAME PERIMETER

→ BORROWED LITE HEAD

BORROWED LITE GLAZING

AND GLASS STOP

AND GLASS STOP

REINFORCING AT 16" O.C.

SEE PLANS FOR THICKNESS

STRUCTURAL DRAWINGS

- SEALANT - CONTINUOUS

-HOLLOW METAL FRAME -

FILL FRAME W/ GROUT

BOTH SIDES

-5/8" GYP. OVER BOTH SIDES

OF 3 5/8" METAL STUD

AND SILL FOR JAMB

FRAMING AT 16" O.C.

-SEE SHEET G0.01 FOR

HEADER SCHEDULE

BOTH SIDES

(TYPICAL)

OVER DAMP-PROOFING WITH CONT.

TURNED UP WALL 8" MINIMUM

NOTE:

SEE PLANS FOR EXACT


WALL CONFIGURATION


4" SOUND BATT -

INSULATION

A7.03

SEALANT ALONG THE TOP EDGE (TYP.) -

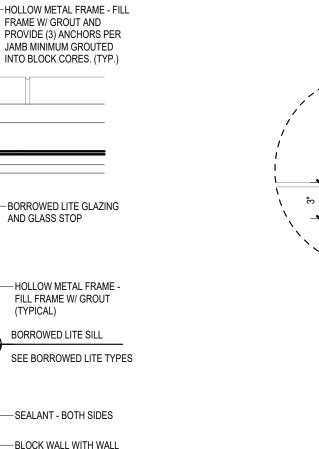

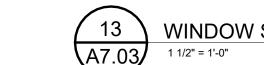

— CONCEALED SPLICE CLEAT

METAL COPING SPLICE DETAIL A7.04

—EXPANSION JOINT PER
MANUFACTURER'S SPECIFICATION

-MEMBRANE AND COVER BOARD ON

RIGID INSULATION MECHANICALLY FASTENED TO METAL ROOF DECK

--- MEMBRANE SEAL OVER

FLASHING AND WALL

-BOND BEAM - SEE

POST-APPLIED THRU WALL FLASHING WITH CONTINUOUS

-NEW WALL WEEP

TERMINATION BAR (TYP.)

- REMOVE AND REINSTALL

-EXISTING BLOCK TO

-MEMBRANE ROOFING ON

INSULATION AND METAL

-2" SPRAY INSULATION UP

TO METAL DECK OVER EX.

ROOF DECK

BRICK WALL

POST-APPLIED THRU WALL FLASHING WITH CONTINUOUS

TERMINATION BAR (TYP.)

-REMOVE AND REINSTALL

EX. WALL - EXTEND TO

BELOW ROOF LINE

—FILL GAP WITH BATT

- MEMBRANE ROOFING OVER

FILL EXPANSION JOINT PER MFR. RECOMMENDED DETAILS

-MEMBRANE ROOFING ON

COVER BOARD OVER RIGID

INSULATION AND METAL ROOF

-GYP. BD. ON 3 5/8" MTL. STUDS

-BLOCK W/ HORIZ. REINF. AT 16"

REPEATING AT 16" O.C.

---BOND BEAM AND GROUT

O.C. (TYP)

-NEW WALL WEEP

COVER BOARD OVER RIGID

STRUCT. DRAWINGS

FILL CAVITY WITH INSULATION

3/4" TREATED PLYWOOD ON —

WOOD BLOCKING W/ 1/2" DIA. x

TOP OF STEEL ELEV. VARIES SEE STRUCT. DWGS.

ANGLE DECK CARRIER;

REFER TO STRUCTURAL

SEE FLOOR PLANS FOR — VERTICAL WALL REINFORCING REQUIRED (TYPICAL)

BLOCK W/ HORIZ. REINF. AT 16"

O.C. (SEE PLANS)

9 A7.04


W W W W W W W

2-HR DOUBLE FIRE WALL T.O.W. DETAIL


NEW ROOF TO EX. WALL DETAIL

8"L. ANCHOR BOLTS AT 32" O.C. GROUTED INTO BLOCK CORES


CONTINUOUS TREATED 2x

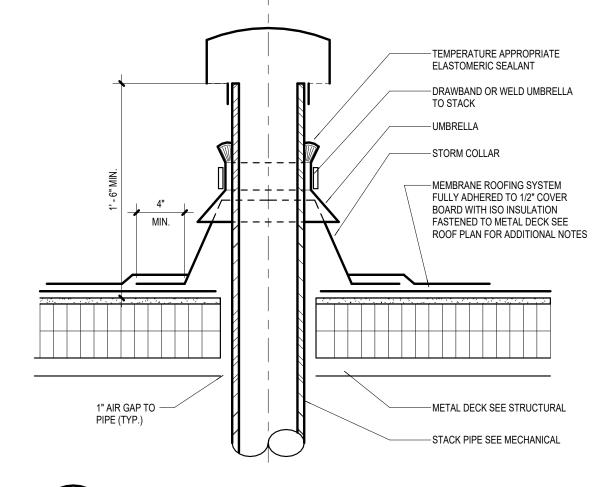



STACK FLASHING DETAIL

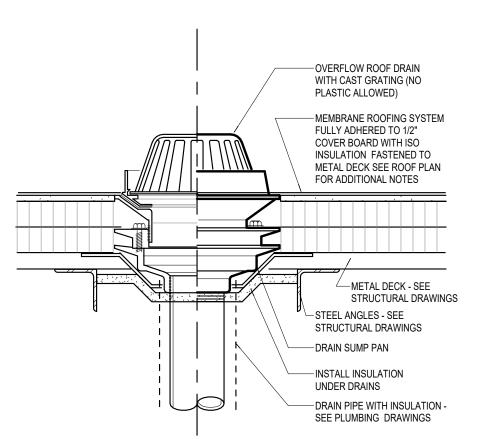




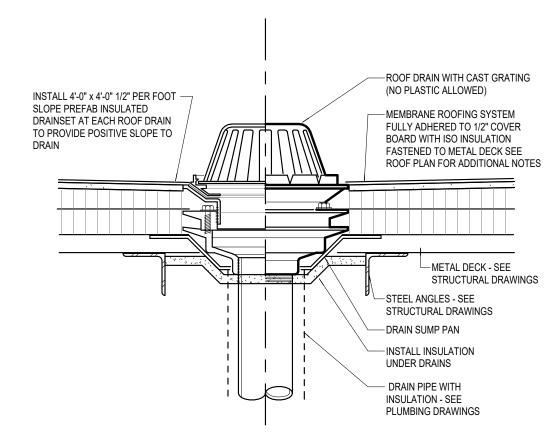

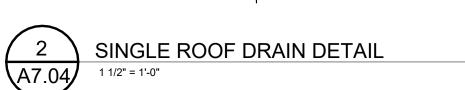


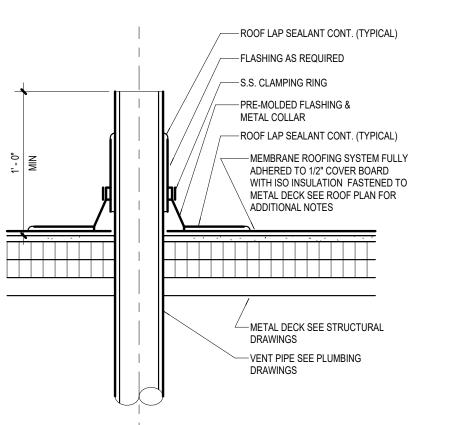


TYPICAL ROOF VENT DETAIL

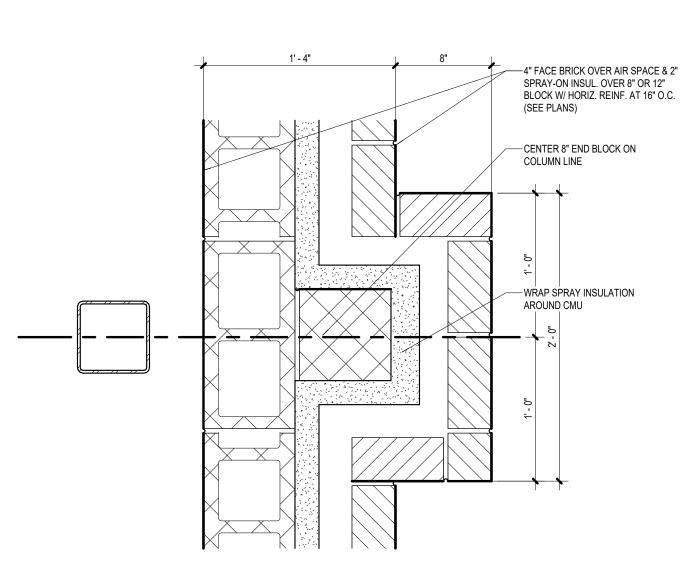




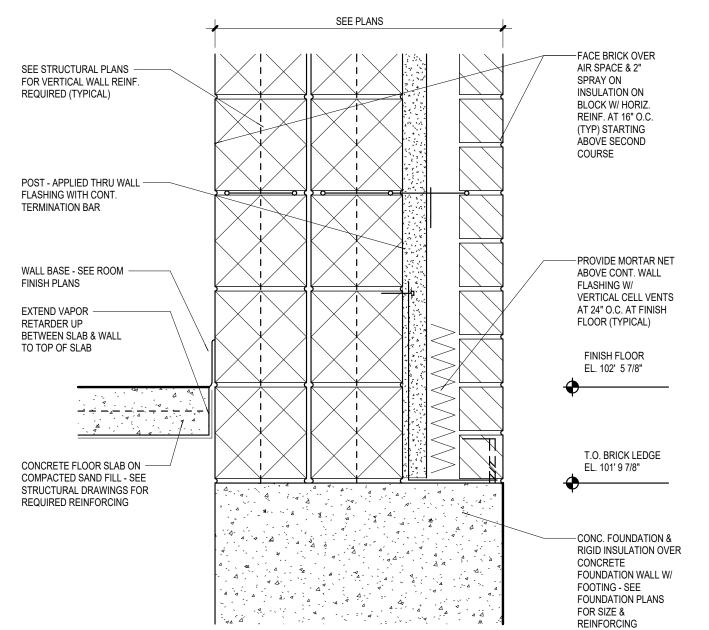




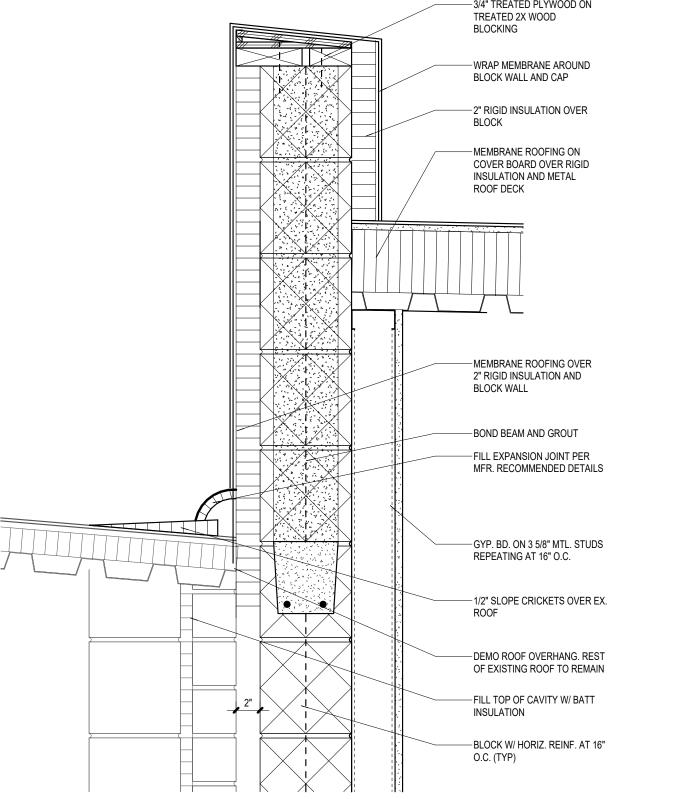


EXPANSION JOINT DETAIL

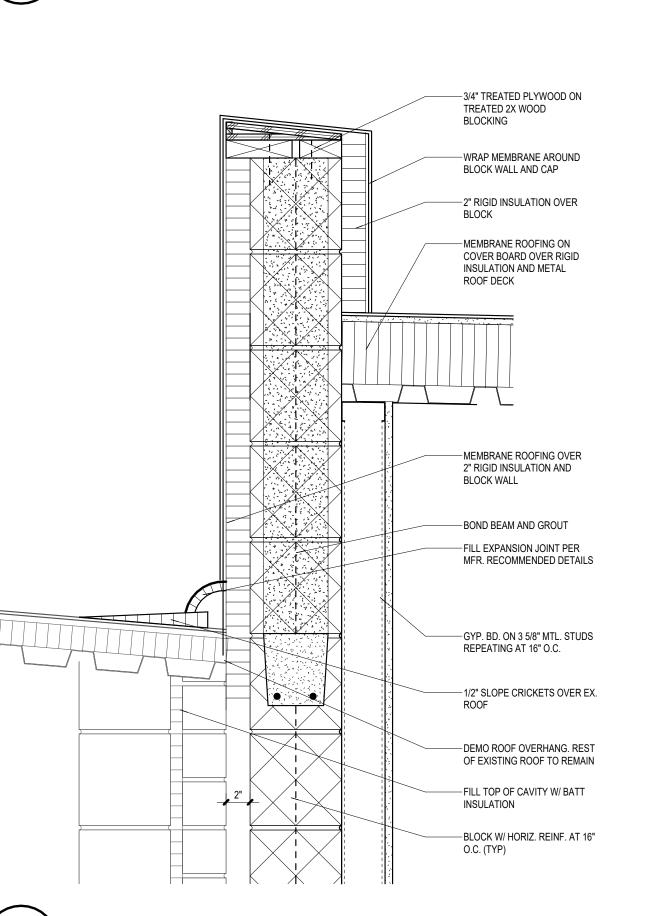


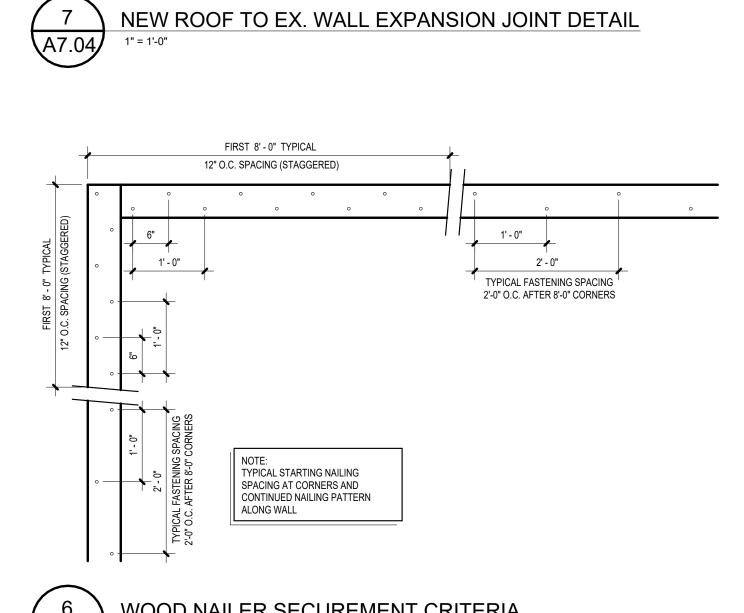


WOOD NAILER SECUREMENT CRITERIA 6 A7.04 3/4" = 1'-0"

A7.04

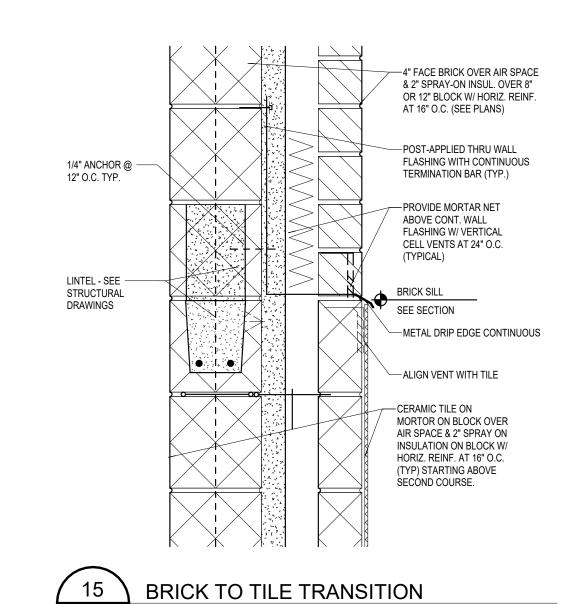

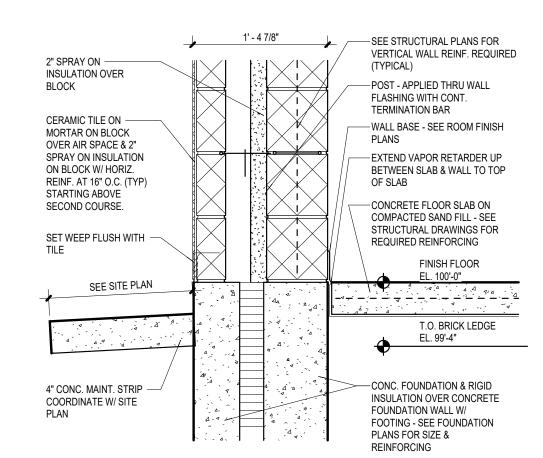



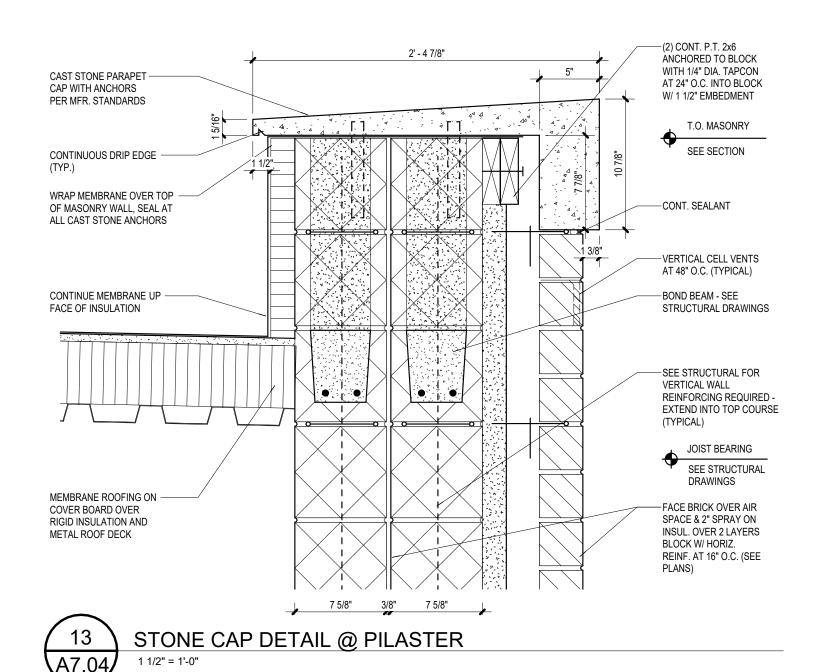

ROOF DRAIN OVERFLOW DETAIL

Design, Inc.

No. AR11500077 STATE OF

MOIANA

Leitelt.

3.18.2025

SCHOOL

ERN

ISSUANCES 01.06.2025 BIDS & CONSTRUCTION

01.16.2025 ADDENDUM 001

03.13.2025 BULLETIN 001

DRAWN JHB REVIEWED AGS PROJECT NO. NO PART OF THIS DRAWING MAY BE USED OR REPRODUCED IN ANY FORM OR BY ANY MEANS, OR STORED IN A DATA BASE OR RETRIEVAL SYSTEM, WITHOUT PRIOR WRITTEN

PERMISSION OF

GMB COPYRIGHT © 2025

ALL RIGHTS RESERVED

DETAILS


AR11500077 STATE OF

3.18.2025


03.13.2025 BULLETIN 001


REVIEWED AGS PROJECT NO. NO PART OF THIS DRAWING MAY BE USED OR REPRODUCED IN ANY FORM OR BY ANY MEANS, OR STORED IN A
DATA BASE OR RETRIEVAL SYSTEM,
WITHOUT PRIOR WRITTEN
PERMISSION OF GMB COPYRIGHT © 2025 ALL RIGHTS RESERVED


DETAILS

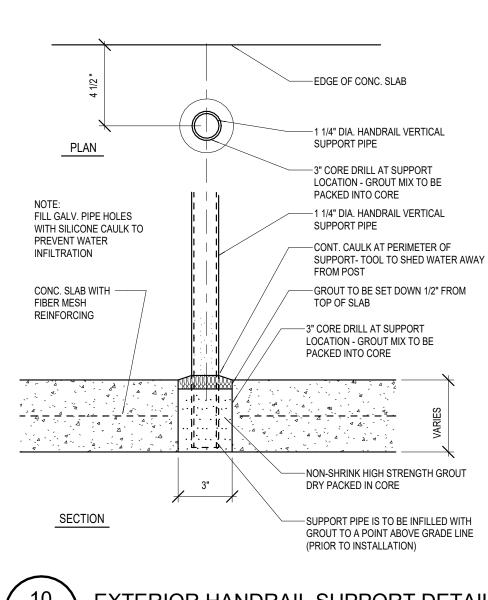





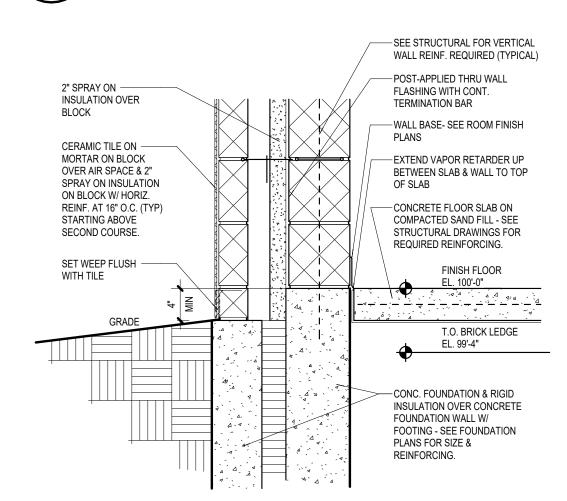

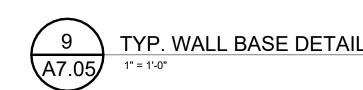

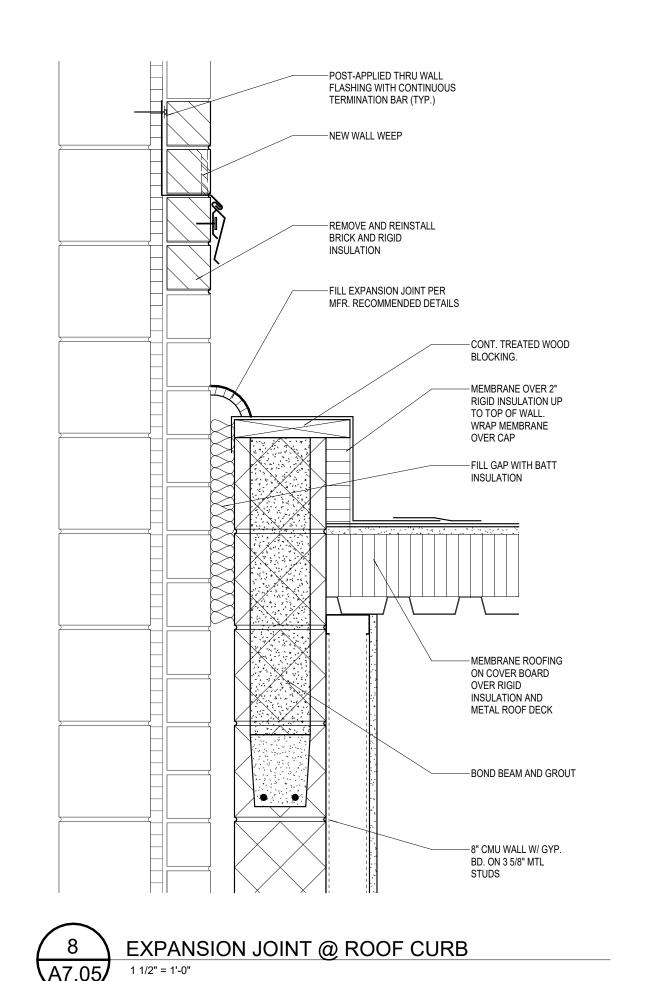


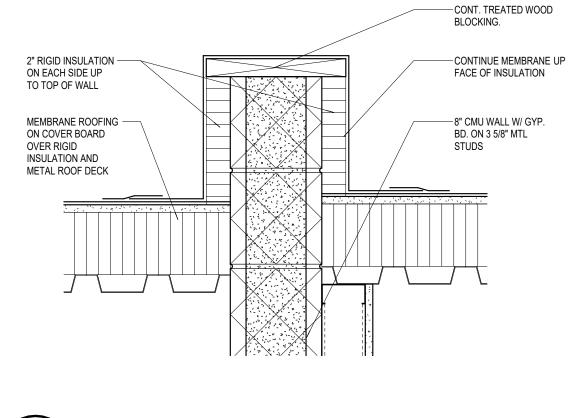


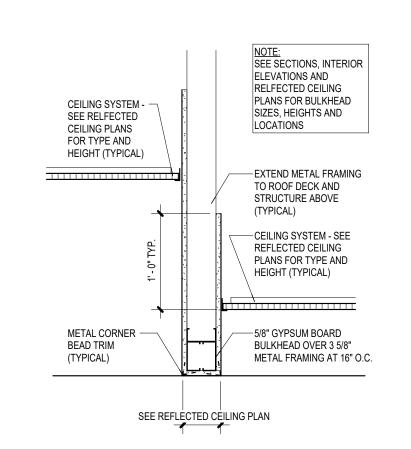


WALL CAP DETAIL
1 1/2" = 1'-0"


7 A7.05

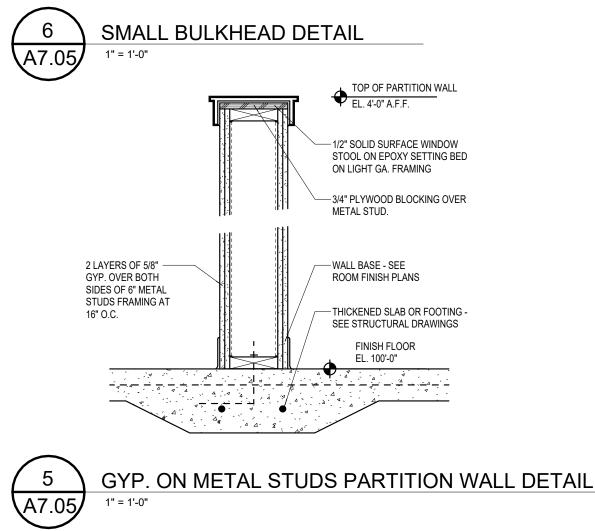

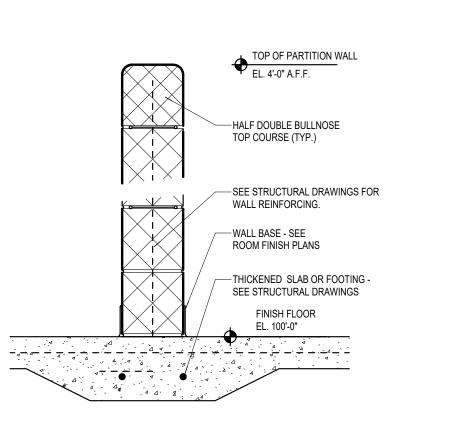

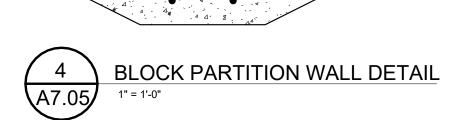




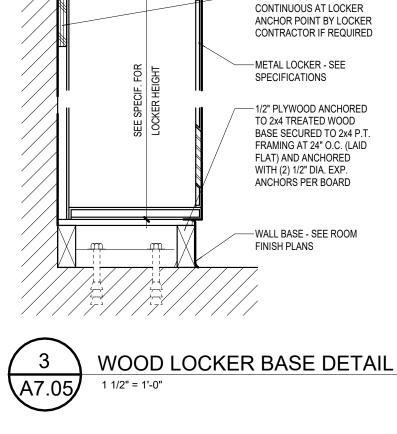



-SLOPED LOCKER TOP - SEE

-3/4" PLYWOOD x 4"WIDE

SPECIFICATIONS

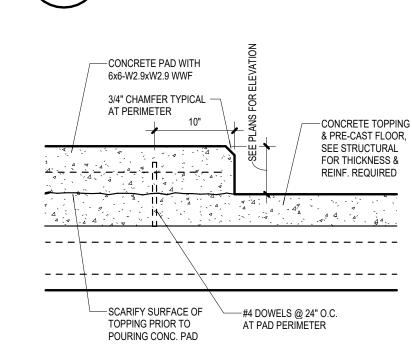


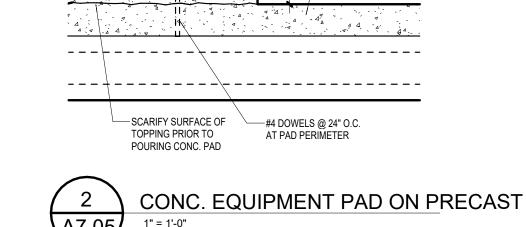

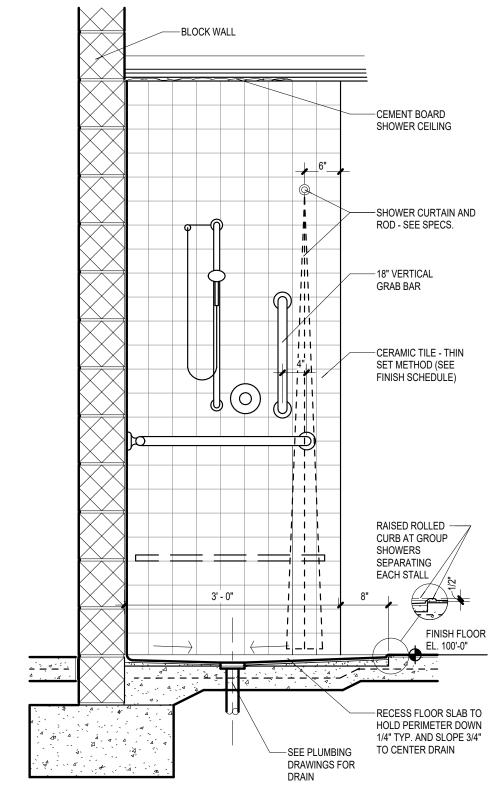

BARRIER FREE INDIVIDUAL SHOWER

3/4" = 1'-0"

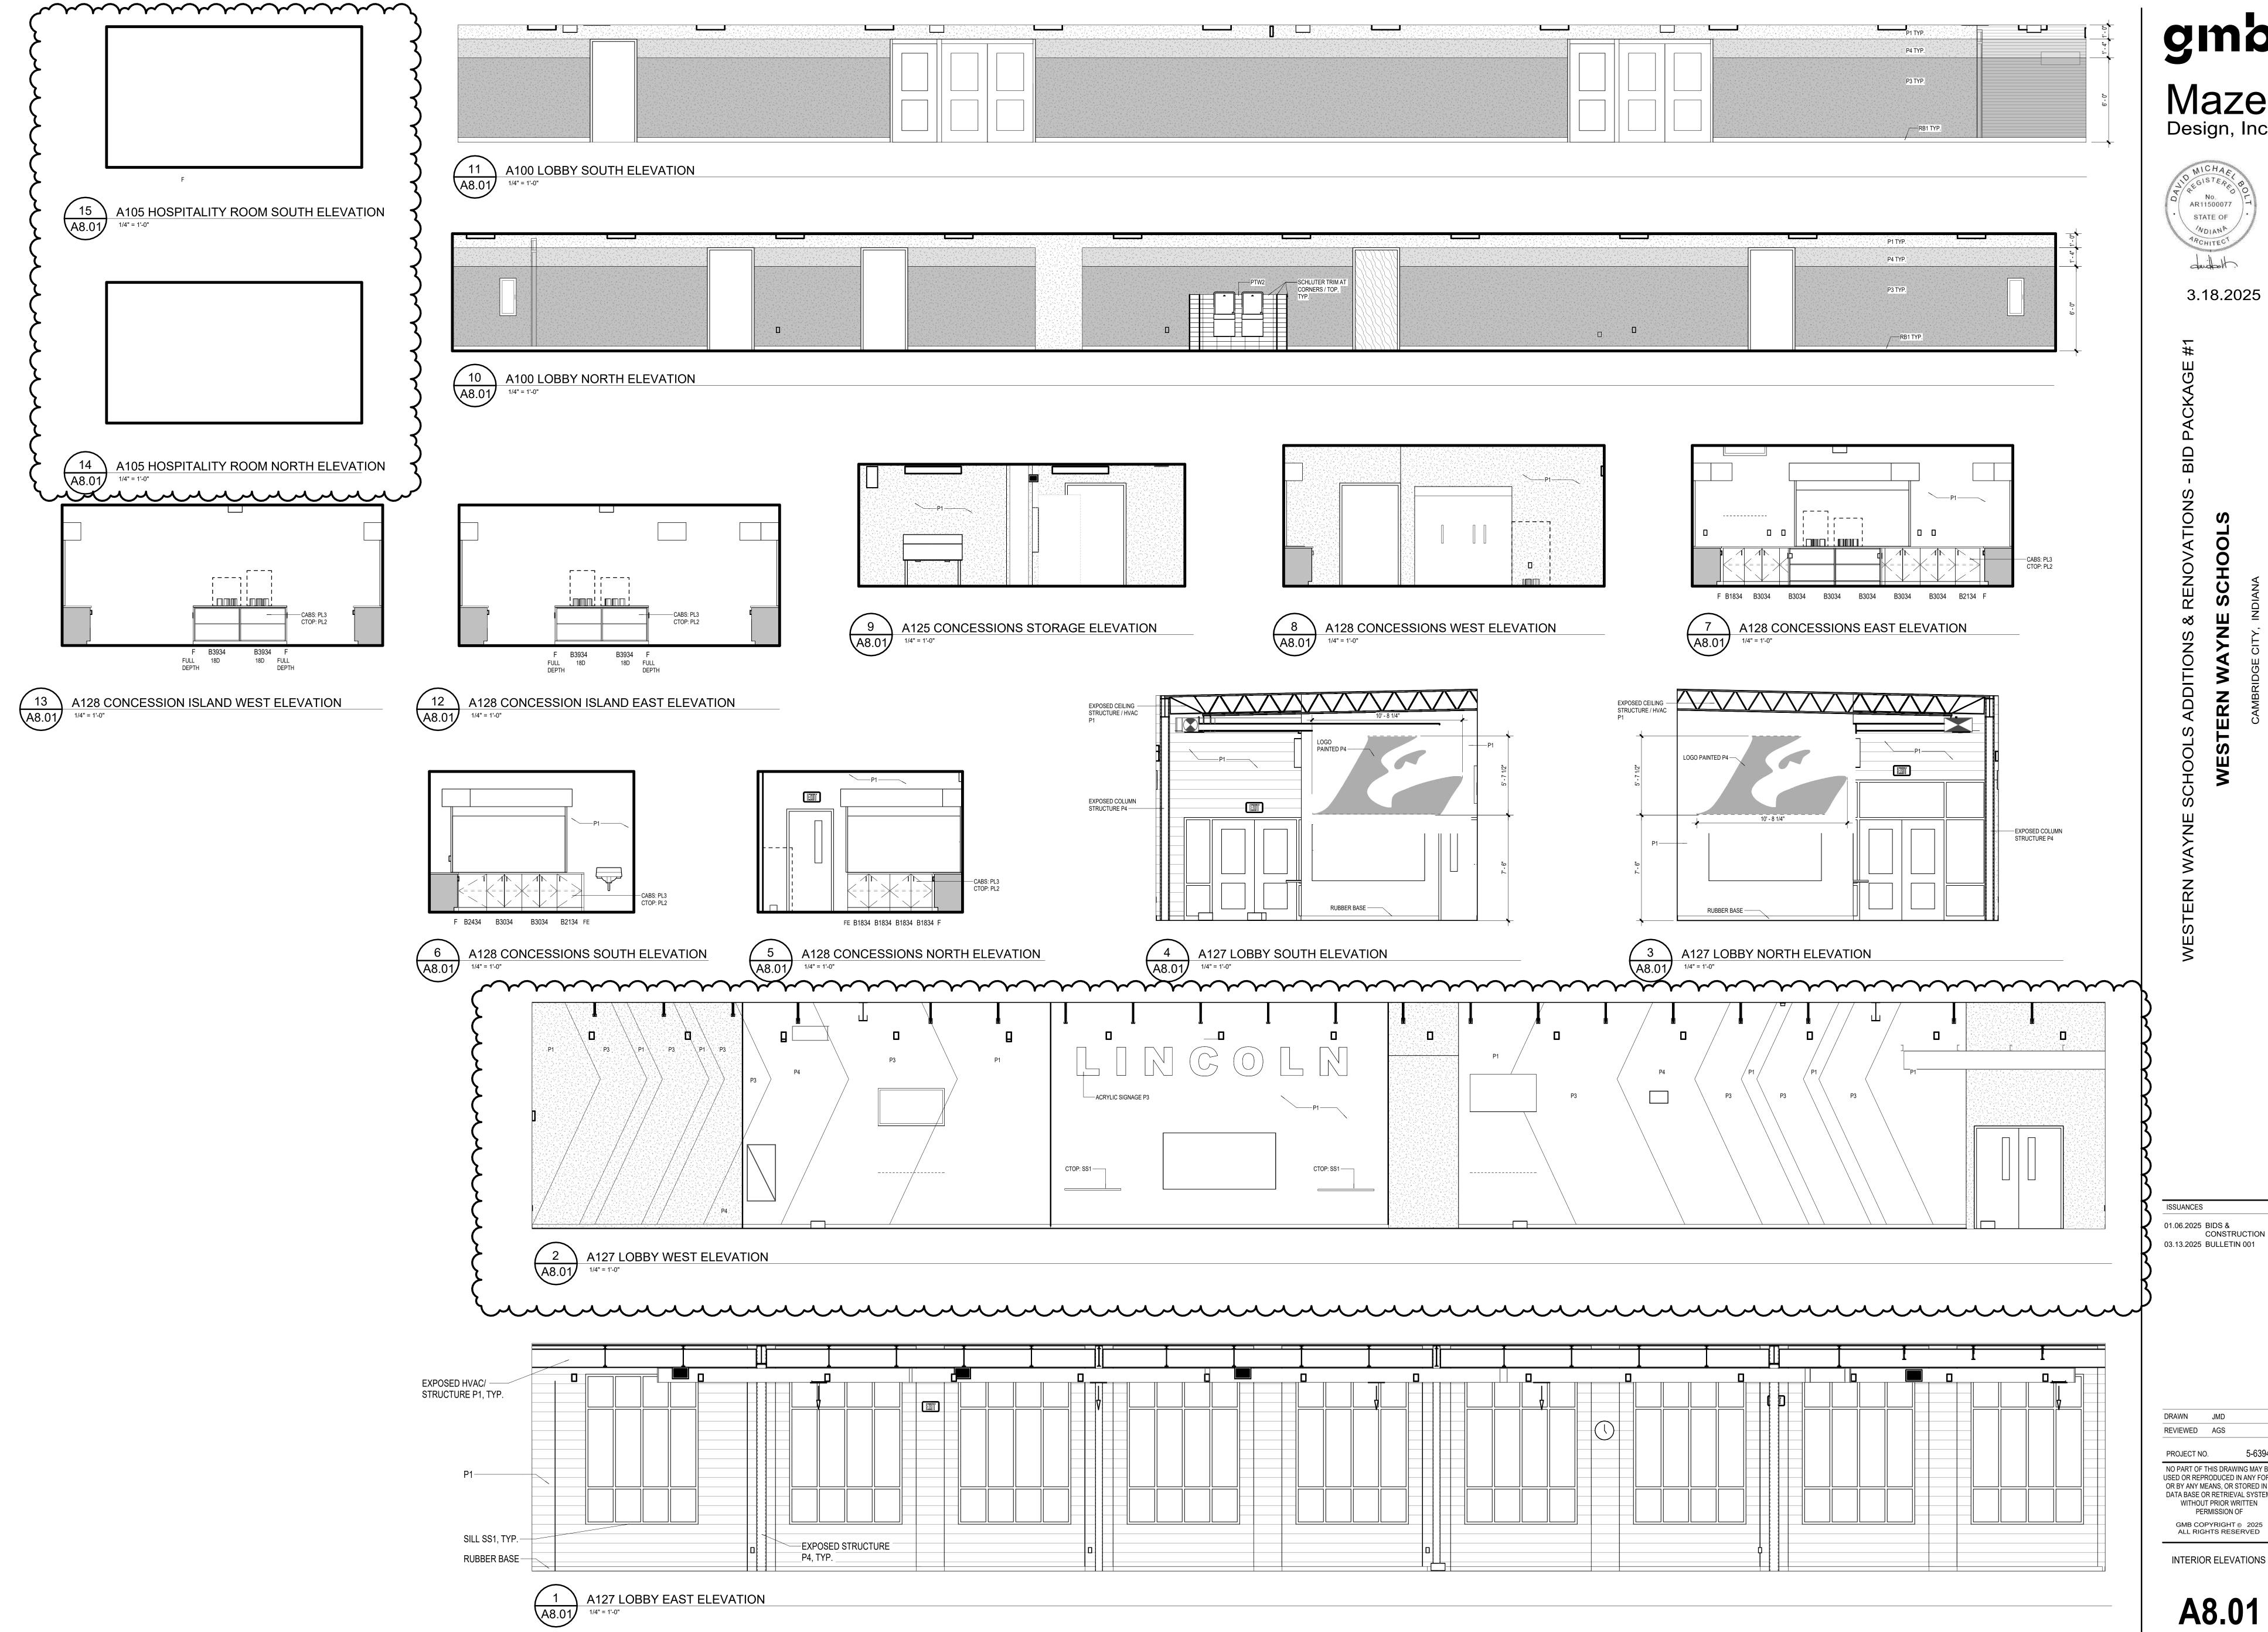



3.18.2025

SCHOOLS

01.06.2025 BIDS & CONSTRUCTION

DRAWN JMD REVIEWED AGS

5-6394 NO PART OF THIS DRAWING MAY BE USED OR REPRODUCED IN ANY FORM OR BY ANY MEANS, OR STORED IN A
DATA BASE OR RETRIEVAL SYSTEM,
WITHOUT PRIOR WRITTEN
PERMISSION OF


INTERIOR ELEVATIONS

A8.01

MICHA,
MI


STATE OF

3.18.2025

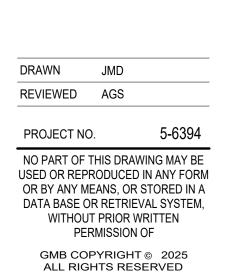


INTERIOR ELEVATIONS


A8.02

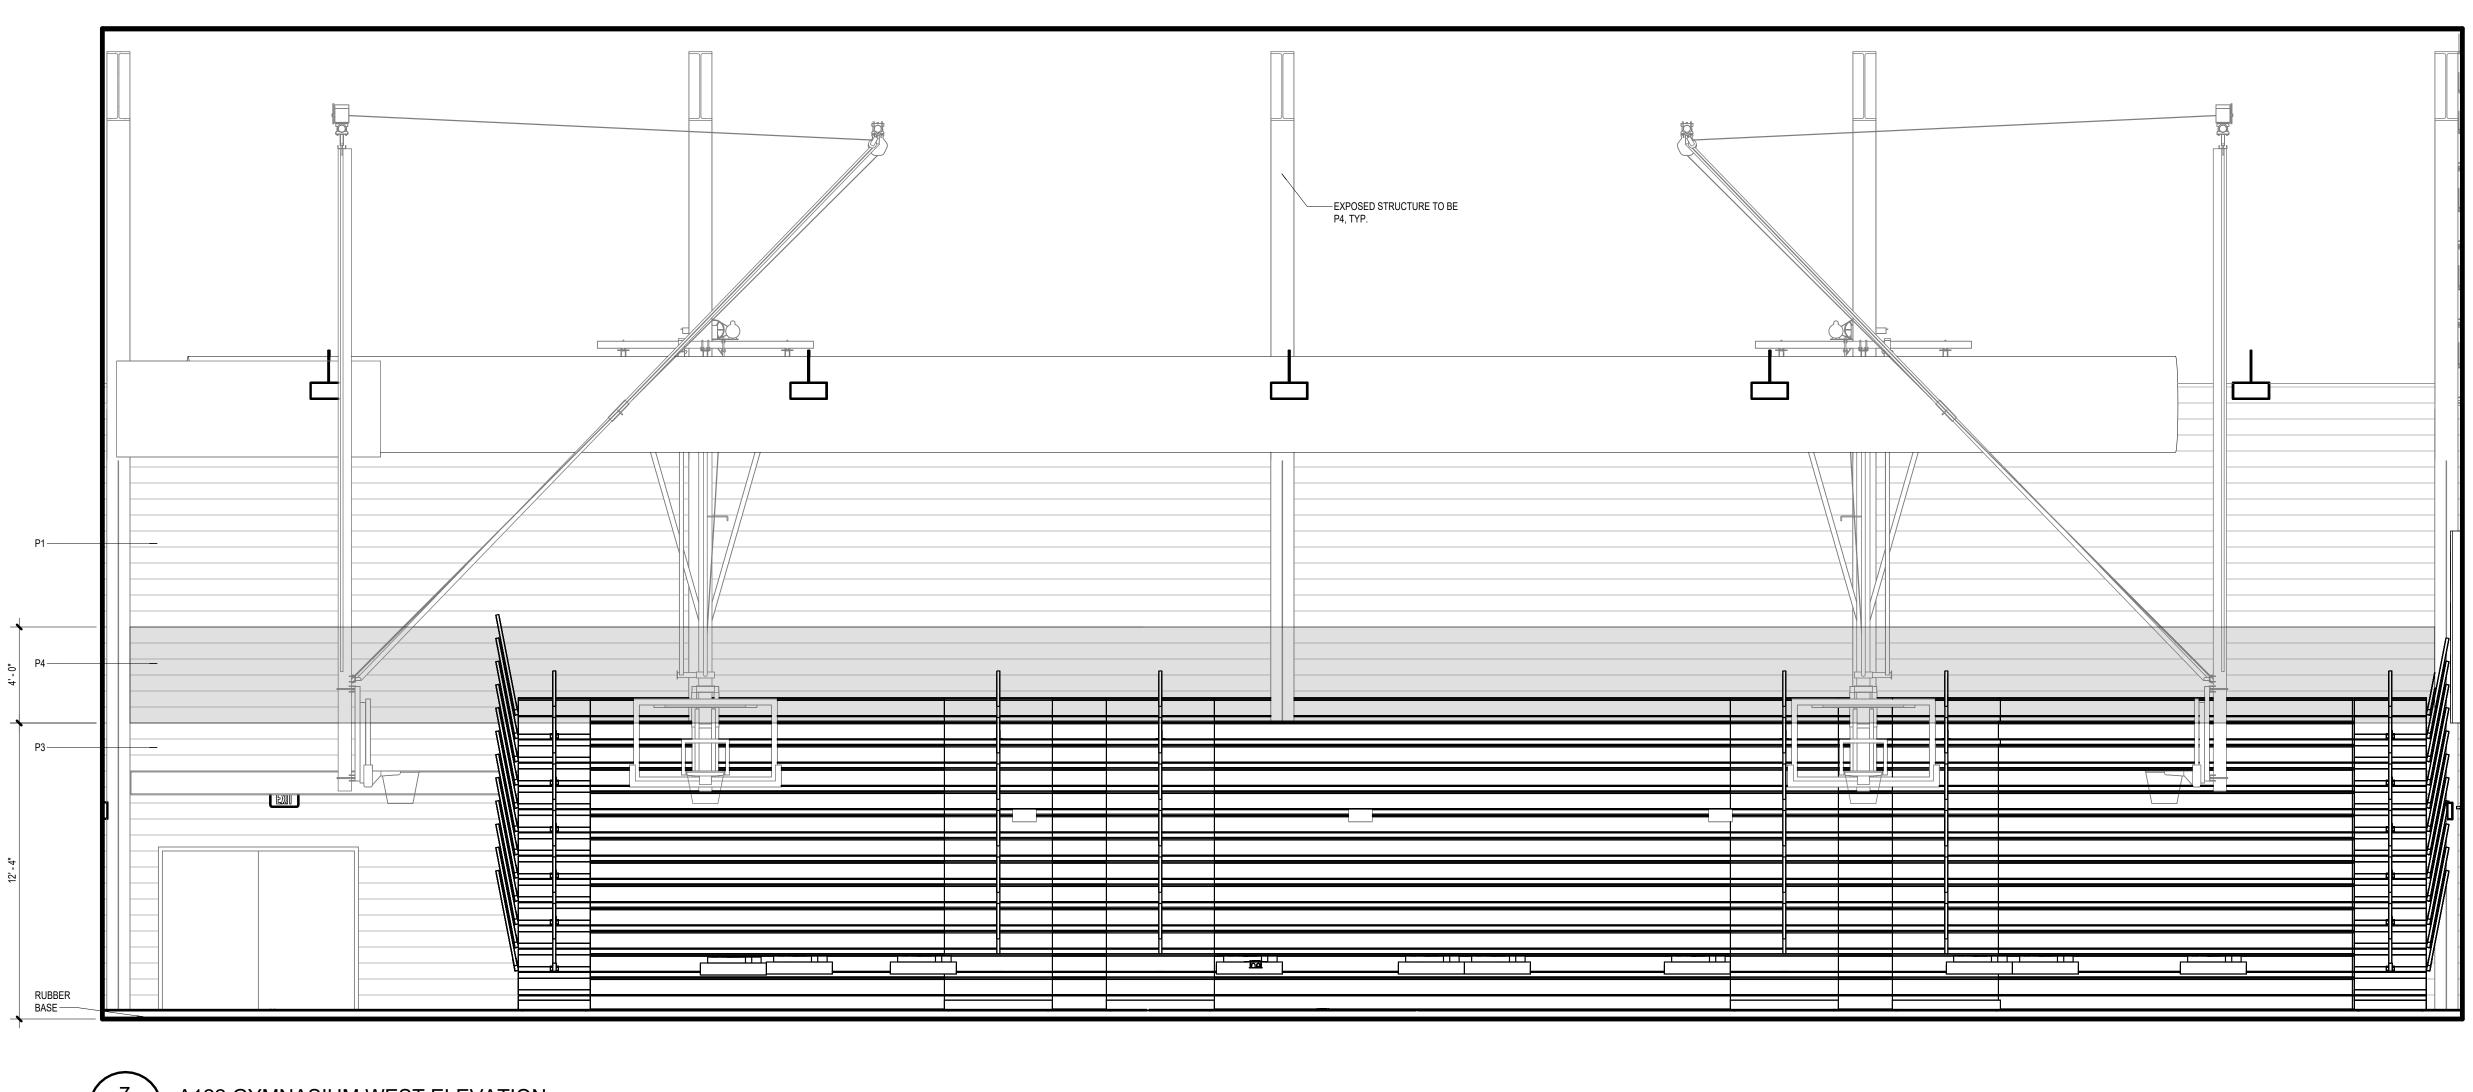





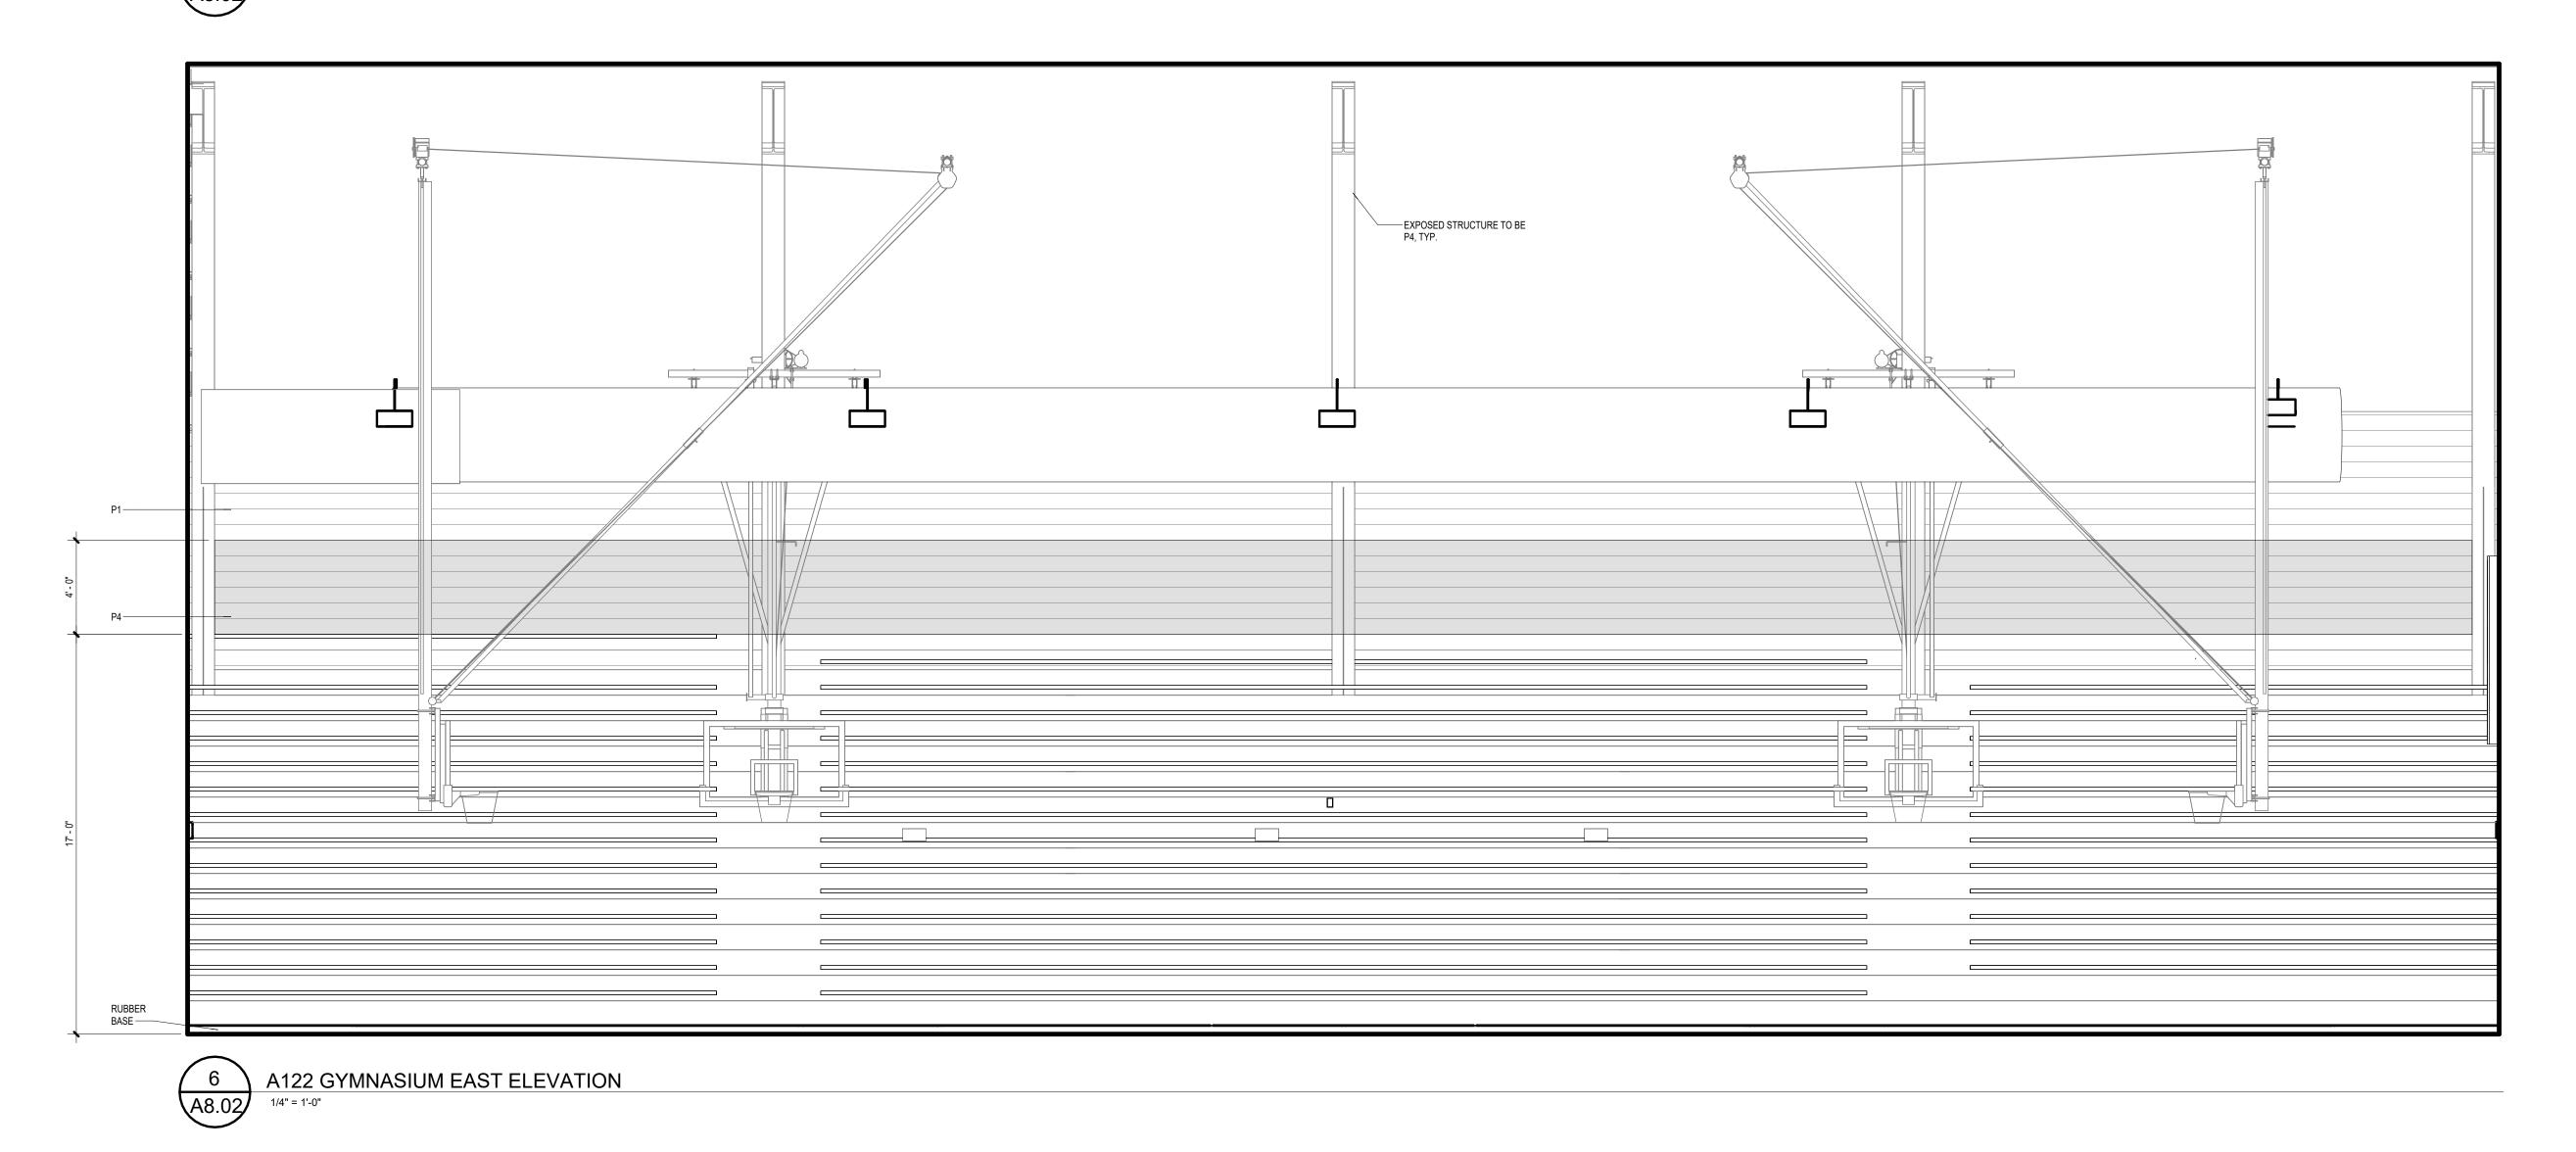




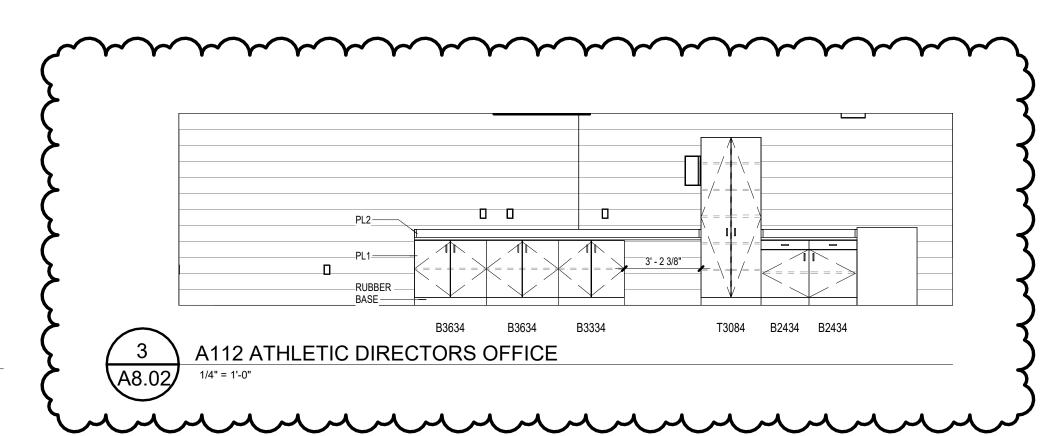

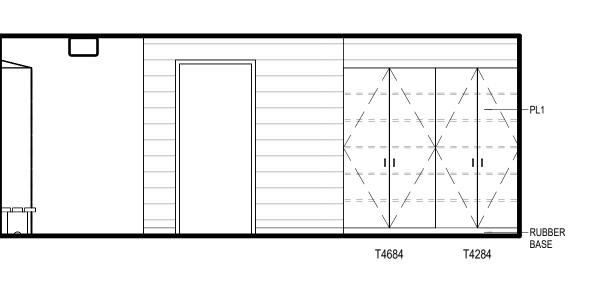


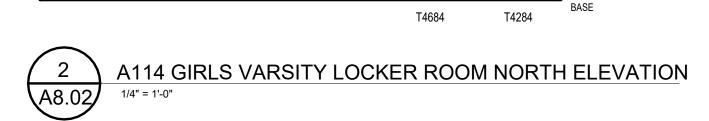

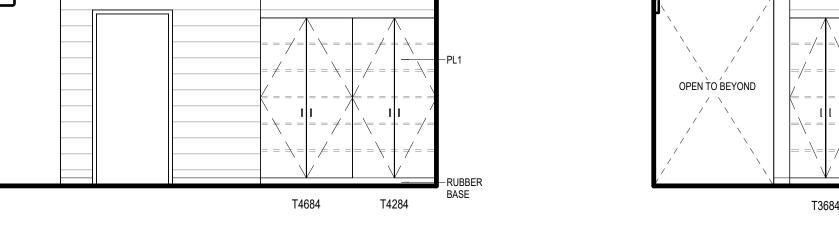

1 A118 F A8.02 1/4" = 1'-0"

A118 FOOTBALL LOCKER ROOM NORTH ELEVATION

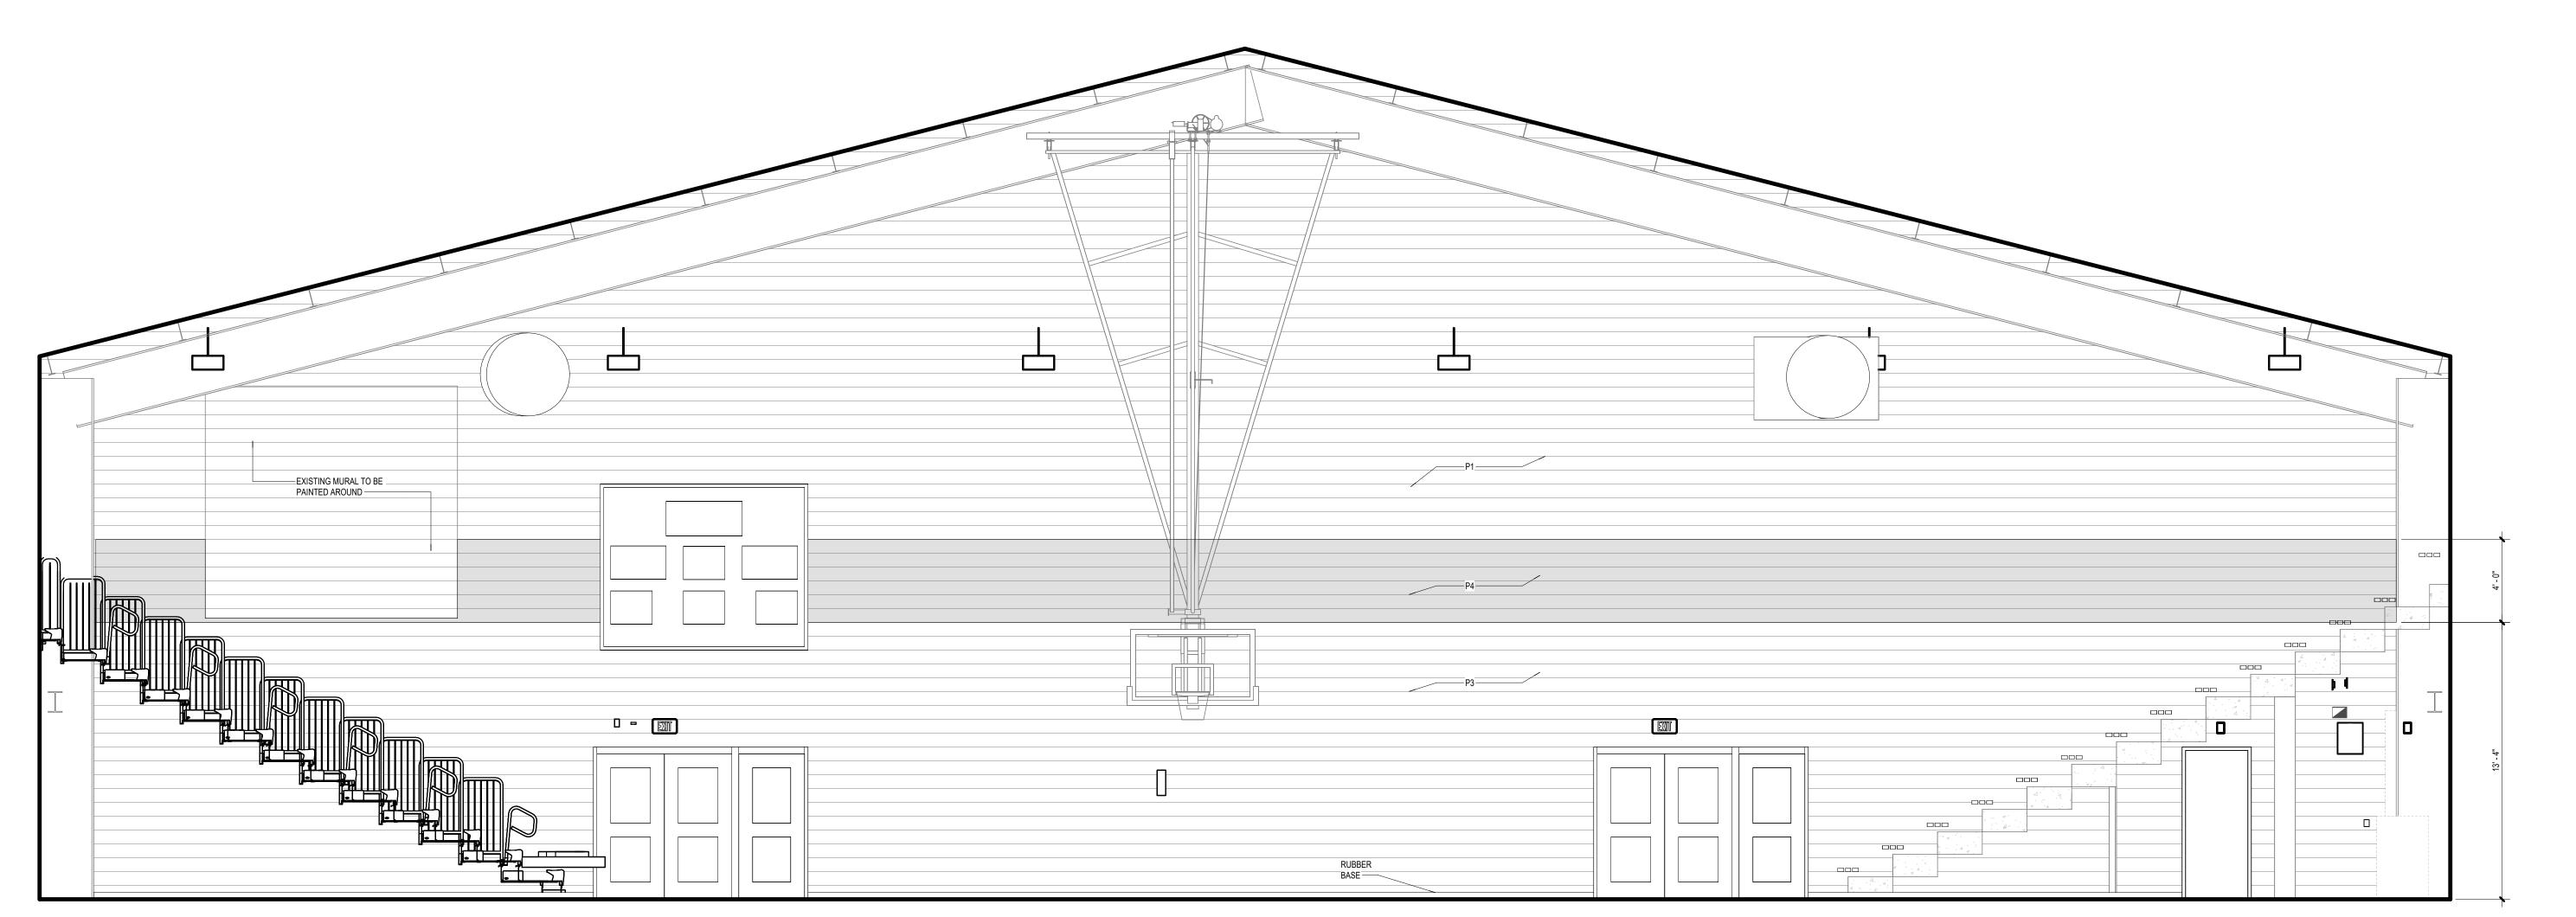

1 A122 GYMNASIUM NORTH ELEVATION

1/4" = 1'-0"

gmb

Maze Design, Inc.



3.18.2025

ONS - BID PACKAGE #

ESTERN WAYNE SCHOOL

WESTERN WAY

ISSUANCES

01.06.2025 BIDS & CONSTRUCTION

DRAWN JMD
REVIEWED AGS

PROJECT NO. 5-6394

NO PART OF THIS DRAWING MAY BE USED OR REPRODUCED IN ANY FORM OR BY ANY MEANS, OR STORED IN A DATA BASE OR RETRIEVAL SYSTEM, WITHOUT PRIOR WRITTEN PERMISSION OF

GMB COPYRIGHT © 2025 ALL RIGHTS RESERVED

INTERIOR ELEVATIONS


A8.03

3.18.2025

01.06.2025 BIDS & CONSTRUCTION

ROOM SIGNAGE


A9.01

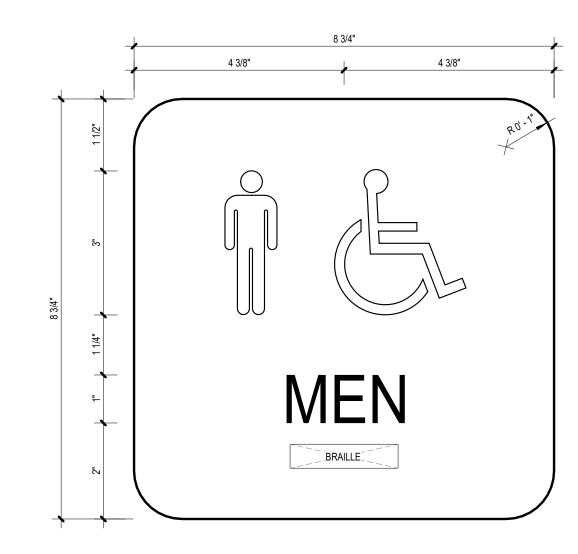


SIGNAGE TYPE C
6" = 1'-0"



SIGNAGE TYPE E 6" = 1'-0"

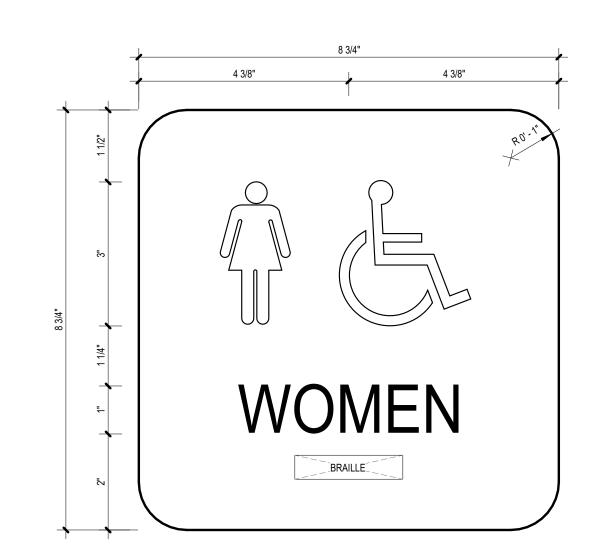

SIGNAGE TYPE D
6" = 1'-0"

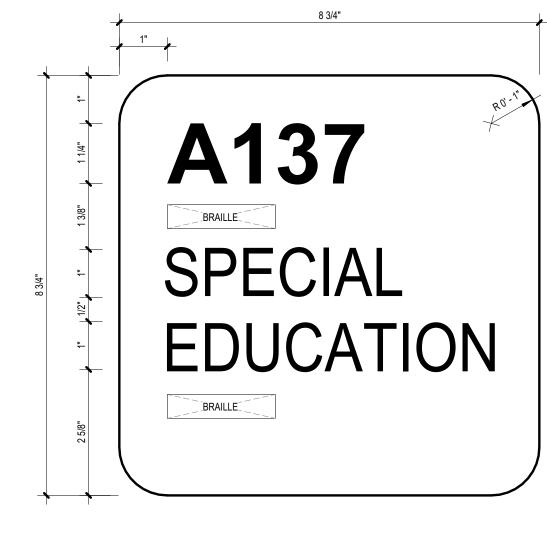

SIGNAGE TYPE B	
6" = 1'-0"	

			ROOM SIGNAGE	SCHEDULE UN	IT 'A'	
	ı	I		1		I
				OWNER		
	GMB ROOM	SIGNAGE		ROOM		
MB ROOM NAME	NUMBER	TYPE	OWNER ROOM NAME	NUMBER	BACK PLATE	ROOM SIGNAGE COMMENTS
	I	I		1		
OFFICE	A103	В	OFFICE	A110		
ATHLETIC STORAGE	A104	В	ATHLETIC STORAGE	A110S		
HOSPITALITY ROOM	A105	В	HOSPITALITY	A111		
TORAGE	A106	В	STORAGE	A111A		
REF LOCKER ROOM	A107	В	REF LOCKER ROOM	A108		
COACH OFFICE	A108	В	COACH OFFICE	A107A		
MENS BASKETBALL	A109	В	MENS BASKETBALL	A107A		
OCKER ROOM	A109		LOCKER	Alui		
STORAGE	A110	В	STORAGE	A107S		
A.T. ROOM	A112	В	ATHLETIC TRAINING	A105		
AUNDRY	A113	В	LAUNDRY	A106		
GIRLS VARSITY	A114	В	GIRLS VARSITY	A104		
OCKER ROOM			GINES VARSITI	A104		
OOTBALL LOCKER	A118	В	FOOTBALL LOCKER ROOM	A103		
ROOM						
COACH OFFICE	A119	В	COACH OFFICE	A103A		
STORAGE	A121	В	STORAGE	A13S		
SYMNASIUM	A122	В	GYMNASIUM	A109		4 SIGNS
CONCESSIONS	A125	В	CONCESSION STORAGE	A117		2 SIGNS
STORAGE						
STORAGE	A126	В	STORAGE	A116		
.OBBY	A127	В	LOBBY	A001		3 SIGNS
CONCESSIONS	A128	В	CONCESSIONS	A002		
ELECTRICAL ROOM	A129	В	ELECTRICAL	A118		
VOMEN'S TOILET	A133	D	WOMENS TOILET	A115		
MEN'S TOILET	A134	С	MENS TOILET	A115		
VIEN S TOILET					1	
IRLS VARSITY	A140	В	GIRLS VARSITY	A112	1	

A112A

104A A113

GIRLS VARSITY

COACH OFFICE

COACH OFFICE MENS LOCKER

WOMENS LOCKER

OFFICE STORAGE

STORAGE

GIRLS VARSITY LOCKER ROOM

OFFICE A143
STORAGE A148
COACHES OFFICE A150
STORAGE A151
COACH OFFICE A152
MEN'S TOILET A155

WOMEN'S TOILET A158



3.18.2025

CHO

ISSUANCES 01.06.2025 BIDS &


CONSTRUCTION

DRAWN JMD REVIEWED AGS

PROJECT NO. NO PART OF THIS DRAWING MAY BE USED OR REPRODUCED IN ANY FORM OR BY ANY MEANS, OR STORED IN A DATA BASE OR RETRIEVAL SYSTEM, WITHOUT PRIOR WRITTEN GMB COPYRIGHT © 2025

UNIT 'A' FIRST FLOOR FINISH

ALL RIGHTS RESERVED

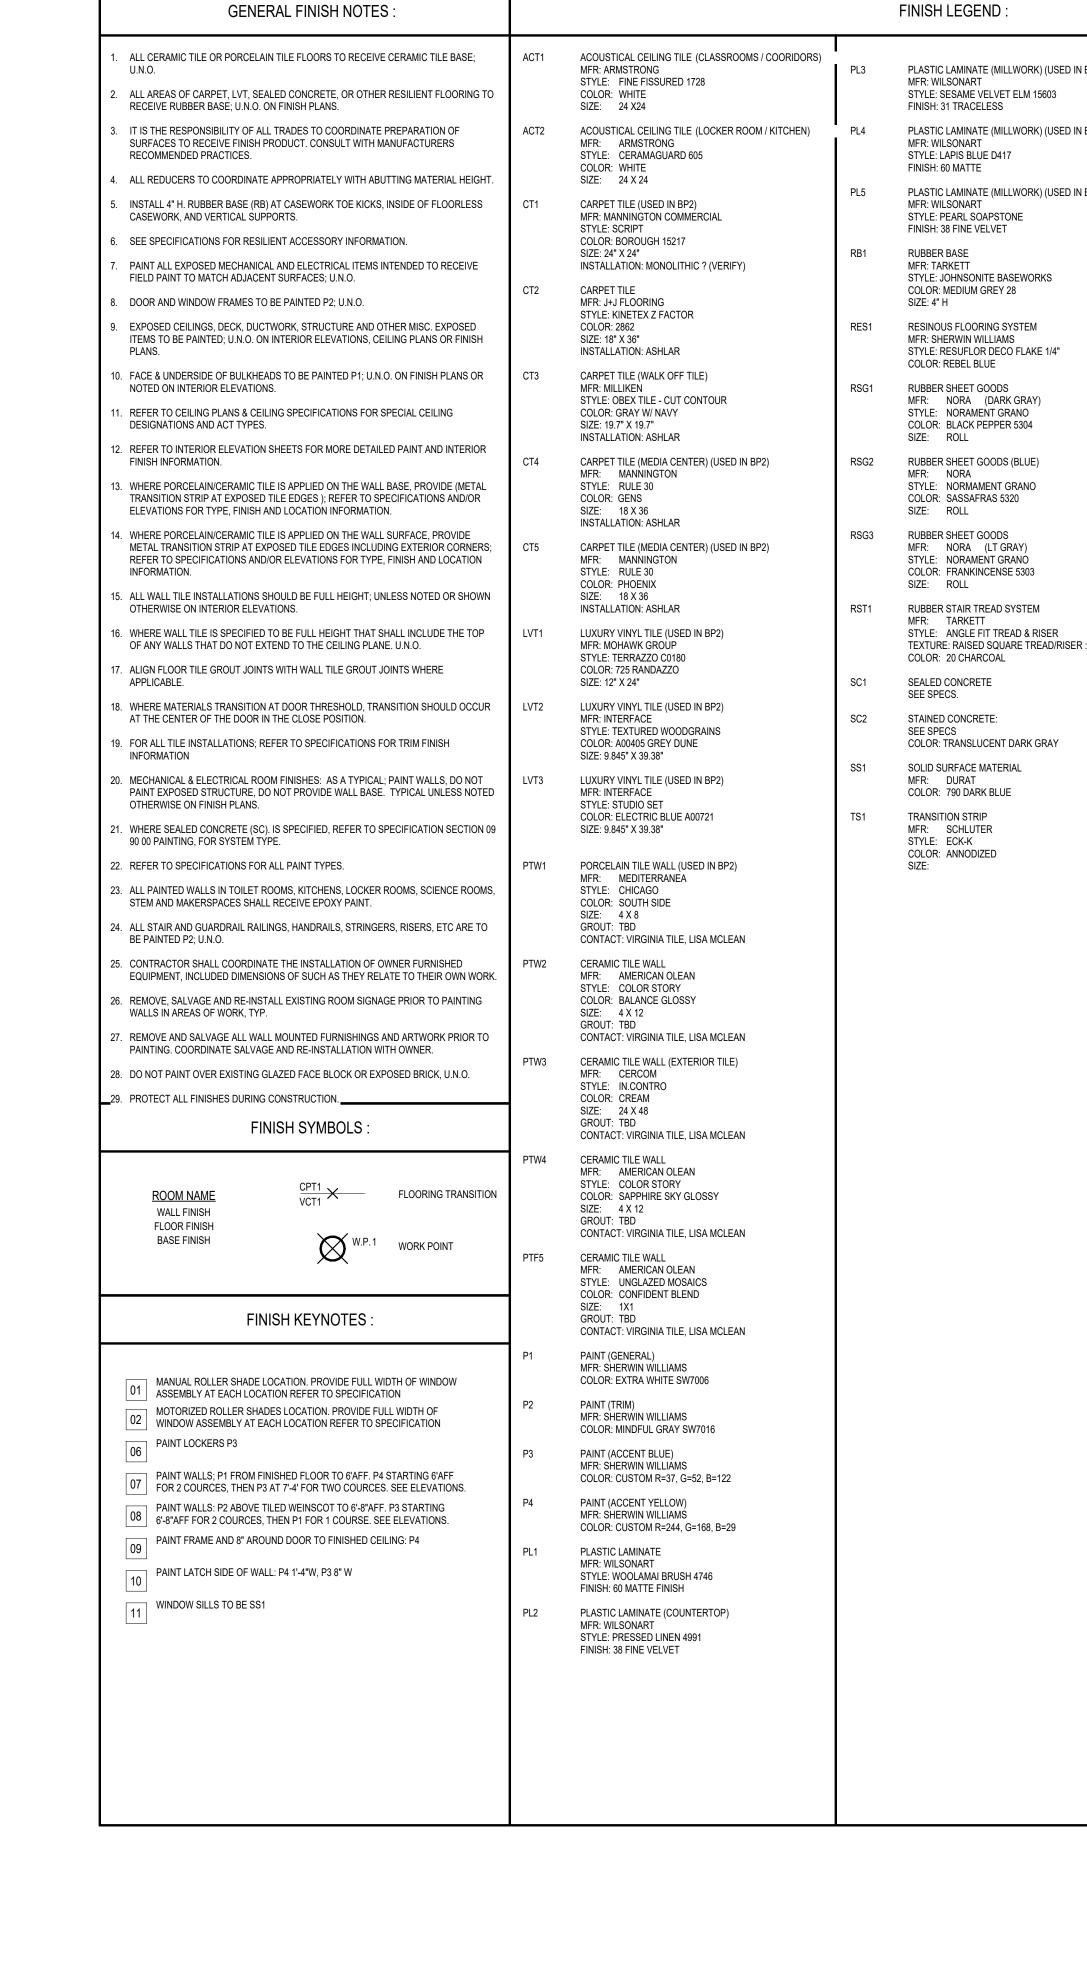

PLASTIC LAMINATE (MILLWORK) (USED IN BP2) MFR: WILSONART PLASTIC LAMINATE (MILLWORK) (USED IN BP2) PLASTIC LAMINATE (MILLWORK) (USED IN BP2) TEXTURE: RAISED SQUARE TREAD/RISER: VIRNSQTR

> ISSUANCES 01.06.2025 BIDS & CONSTRUCTION

AR11500077

STATE OF

3.18.2025

SCHOOL


DRAWN REVIEWED AGS

PROJECT NO. NO PART OF THIS DRAWING MAY BE USED OR REPRODUCED IN ANY FORM OR BY ANY MEANS, OR STORED IN A DATA BASE OR RETRIEVAL SYSTEM, WITHOUT PRIOR WRITTEN GMB COPYRIGHT © 2025

UNIT 'A' SECOND FLOOR FINISH PLAN

ALL RIGHTS RESERVED

A9.2A

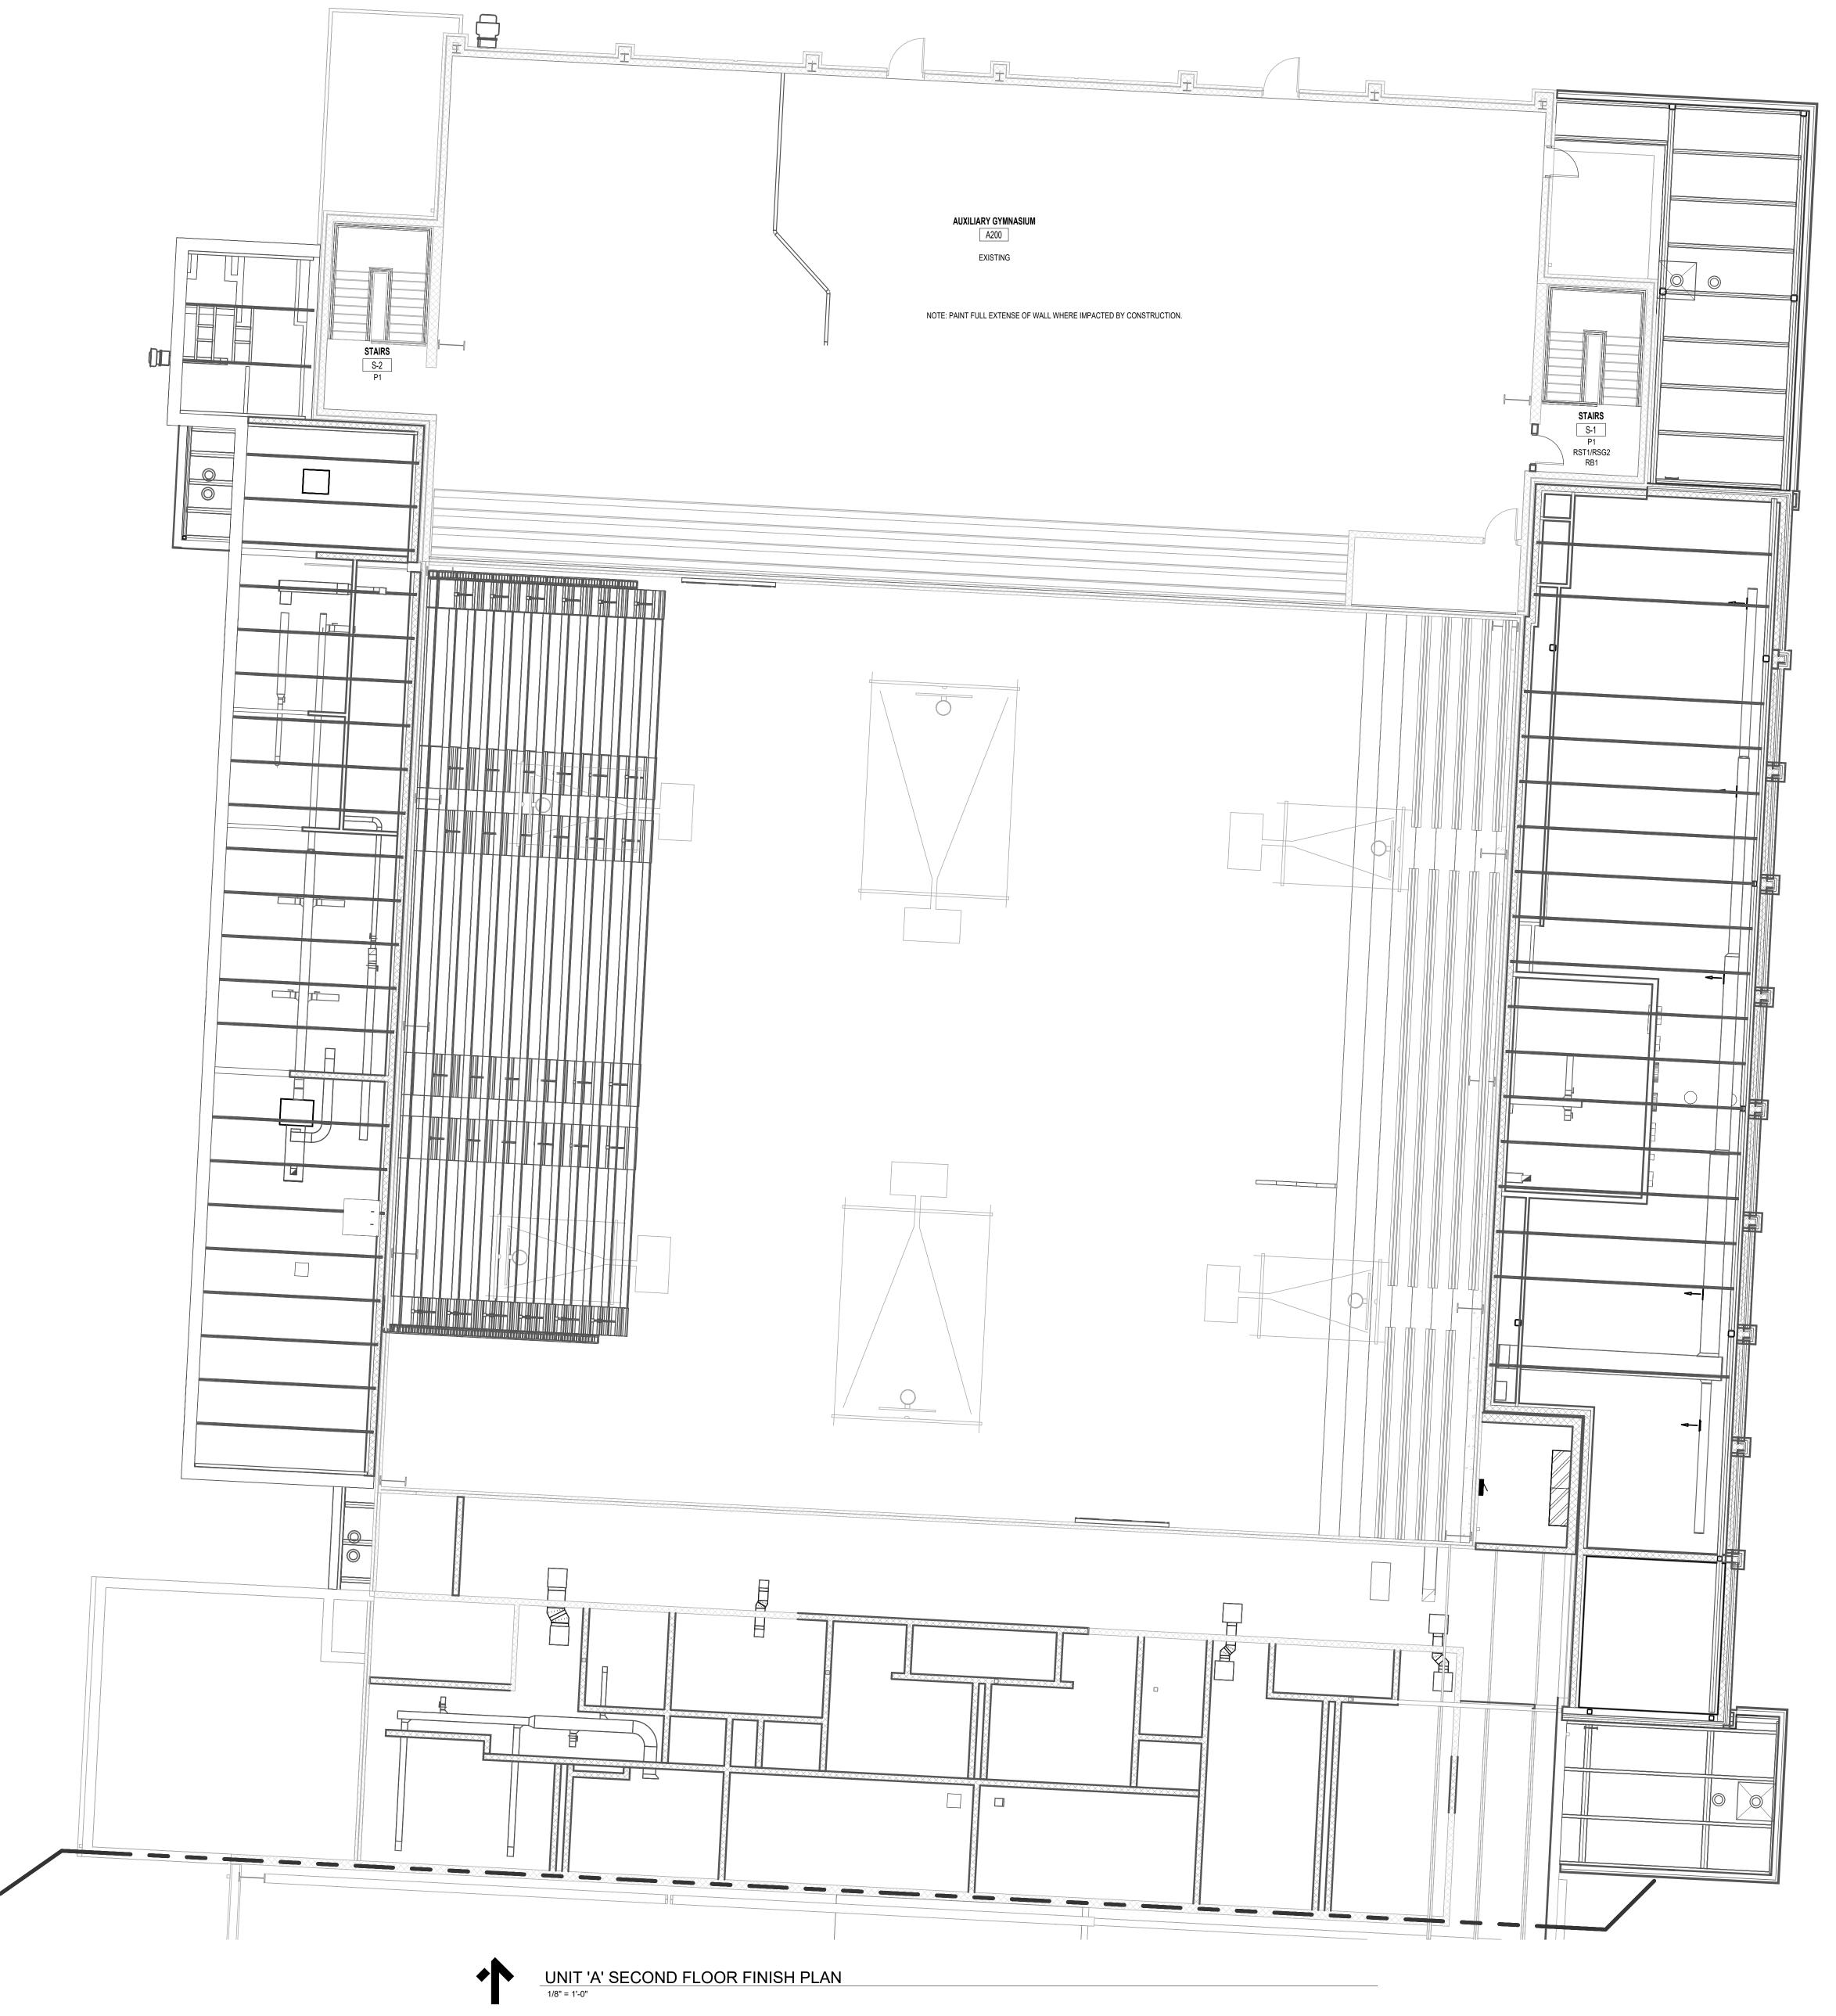

WATER CLOSET DESCRIPTION (WC-1A): AMERICAN STANDARD AFWALL MILLENNIUM FLOWISE ELONGATED FLUSHOMETER TOILET MODEL 2257.101, ACCESSIBLE, WALL HUNG, SIPHON JET, VITREOUS CHINA CLOSET BOWL, ELONGATED RIM, 1-1/2 INCH TOP SPUD, CHINA BOLT CAPS, 1.6 GPE COLOR: WHITE INSTALL PER BARRIER FREE AND ADA REQUIREMENTS FLUSH VALVE (FLUSHOMETER) DESCRIPTION: SLOAN REGAL 111 SFSM-1.6-XL-TMO,1.6 GPF, XL SWEAT SOLDER ADAPTER KIT, POLISHED CHROME FINISH, 1.5" FLUSH CONNECTION, FIXTURE CONNECTION TOP SPUD, SINGLE FLUSH, 1" INLET,1" CONTROL STOP, TRUE MECHANICAL OVERRIDE, BATTERY, INFRARED, EXPOSED SENSOR WATER CLOSET FLUSHOMETER. SEAT DESCRIPTION: BEMIS MODEL 1955SSCT, COMMERCIAL HEAVY-DUTY PLASTIC TOILET SEAT, OPEN FRONT, MOLDED IN BUMPERS, SELF-SUSTAINING HINGE, STAINLESS STEEL BOLTS, WITHOUT COVER. COLOR: WHITE. WATER CLOSET CARRIER DESCRIPTION: JAY R. SMITH SERIES 200, COMBINATION CARRIER DESIGNED FOR STANDARD OR ACCESSIBLE MOUNTING HEIGHT OF WALL HUNG WATER CLOSET FIXTURE. SINGLE OR DOUBLE, VERTICAL OR HORIZONTAL, HUBLESS OR HUB AND SPIGOT WASTE FITTING AS REQUIRED FOR PIPING ARRANGEMENT, FACEPLATES, COUPLINGS WITH GASKETS, FEET, FIXTURE BOLTS AND HARDWARE

URINAL DESCRIPTION (UR-1): AMERICAN STANDARD WASHBROOK FLOWISE 0.5 HIGH EFFICIENCY URINAL MODEL 6590.001, WALL HUNG URINAL, WASHOUT, VITREOUS CHINA, 3/4-INCH TOP SPUD, 0.5 GPF, 2-INCH OUTLET (NPTF). COLOR: WHITE. FLUSH VALVE (FLUSHOMETER) DESCRIPTION: SLOAN REGAL 186 SFSM-0.5-XL-TMO, 0.5 GPF, XL SWEAT SOLDER ADAPTER KIT, POLISHED CHROME FINISH 0.75" FLUSH CONNECTION FIXTURE CONNECTION TOP SPUD SINGLE FLUSH 0.75" INLET, 3/4" CONTROL STOP, TRUE MECHANICAL OVERRIDE, BATTERY, INFRARED, EXPOSED SENSOR URINAL FLUSHOMETER. URINAL CARRIER DESCRIPTION: JAY R. SMITH SERIES 600, CARRIER WITH HANGER AND BEARING PLATES FOR WALL HUNG URINAL FIXTURE,

URINAL DESCRIPTION (UR-1A): AMERICAN STANDARD WASHBROOK FLOWISE 0.5 HIGH EFFICIENCY URINAL MODEL 6590.001, WALL HUNG URINAL, WASHOUT, VITREOUS CHINA, 3/4-INCH TOP SPUD, 0.5 GPF, 2-INCH OUTLET (NPTF). COLOR: WHITE. FLUSH VALVE (FLUSHOMETER) DESCRIPTION: SLOAN REGAL 186 SFSM-0.5-XL-TMO, 0.5 GPF, XL SWEAT SOLDER ADAPTER KIT, POLISHED CHROME FINISH, 0.75" FLUSH CONNECTION, FIXTURE CONNECTION TOP SPUD, SINGLE FLUSH, 0.75" INLET, 3/4" CONTROL STOP, TRUE MECHANICAL OVERRIDE, BATTERY, INFRARED, EXPOSED SENSOR URINAL FLUSHOMETER. URINAL CARRIER DESCRIPTION: JAY R. SMITH SERIES 600, CARRIER WITH HANGER AND BEARING PLATES FOR WALL HUNG URINAL FIXTURE,

LAVATORY DESCRIPTION (LAV-1): AMERICAN STANDARD LUCERNE LAVATORY MODEL 0355.012, WALL HUNG LAVATORY, VITREOUS CHINA, FRONT OVERFLOW. FAUCET LEDGE WITH FAUCET HOLES ON 4 INCH CENTERS, SELF-DRAINING DECK AREA, DRAIN LOCATED NEAR BACK OF BOWL, 21-1/2 INCHES BY 18-1/4 INCHES OVERALL DIMENSIONS. COLOR: WHITE. FAUCET DESCRIPTION: CHICAGO FAUCETS 802-665ABCP DECK MOUNTED LAVATORY FAUCET WITH VANDAL RESISTANT INDEXED METAL METERING CARTRIDGE, ALL METAL BODY, INTEGRAL HOT LIMIT SAFETY STOP, CAST BRASS WATERWAY, 0.5 GPM VANDAL RESISTANT SPRAY OUTLET FINISH: POLISHED CHROME LAVATORY CARRIER DESCRIPTION JAY R. SMITH SERIES 700, CARRIER WITH CONCEALED ARMS AND TIE ROD FOR WALL MOUNTING, STEEL UPRIGHTS WITH FFFT CHROME PLATED 17 GAGE BRASS 1-1/4-INCH P-TRAP WITH CLEANOUT, CAST BRASS NUTS, AND ARM WITH ESCUTCHEON. RIGID SUPPLIES: NPS 1/2 INCH SOLDERED OR THREADED COPPER CONNECTION TO SUPPLY, NPS 3/8 INCH CHROME PLATED BRASS ANGLED STOPS WITH QUARTER TURN ON/OFF OPERATION, BLOW OUT PROOF STEM AND CHROME PLATED METAL DIE CAST HANDLE (NO PLASTIC).

CHROME PLATED RIGID COPPER RISERS UPSTREAM OF MIXING VALVE, CHROME PLATED RIGID COPPER RISERS OR STAINLESS STEEL

LAVATORY DESCRIPTION (LAV-1A): AMERICAN STANDARD LUCERNE LAVATORY MODEL 0355.012, WALL HUNG LAVATORY, VITREOUS CHINA, FRONT OVERFLOW, FAUCET LEDGE WITH FAUCET HOLES ON 4 INCH CENTERS, SELF-DRAINING DECK AREA, DRAIN LOCATED NEAR BACK OF BOWL, 21-1/2 INCHES BY 18-1/4 INCHES OVERALL DIMENSIONS. COLOR: WHITE. INSTALL PER BARRIER FREE AND ADA REQUIREMENTS. FAUCET DESCRIPTION: CHICAGO FAUCETS 802-665ABCP DECK MOUNTED LAVATORY FAUCET WITH VANDAL RESISTANT INDEXED METAL METERING CARTRIDGE, ALL METAL BODY, INTEGRAL HOT LIMIT SAFETY STOP, CAST BRASS WATERWAY, 0.5 GPM VANDAL RESISTANT SPRAY OUTLET FINISH: POLISHED CHROME LAVATORY CARRIER DESCRIPTION JAY R. SMITH SERIES 700, CARRIER WITH CONCEALED ARMS AND TIE ROD FOR WALL MOUNTING, STEEL UPRIGHTS WITH FEFT CHROME PLATED 17 GAGE BRASS 1-1/4-INCH P-TRAP WITH CLEANOUT, CAST BRASS NUTS, AND ARM WITH ESCUTCHEON. RIGID SUPPLIES: NPS 1/2 INCH SOLDERED OR THREADED COPPER CONNECTION TO SUPPLY, NPS 3/8 INCH CHROME PLATED BRASS ANGLED STOPS WITH QUARTER TURN ON/OFF OPERATION, BLOW OUT PROOF STEM AND CHROME PLATED METAL DIE CAST HANDLE (NO PLASTIC), CHROME PLATED RIGID COPPER RISERS UPSTREAM OF MIXING VALVE, CHROME PLATED RIGID COPPER RISERS OR STAINLESS STEEL

SINK DESCRIPTION (S-1): ELKAY DEPENDABILT SERIES MODEL 2C18X18-0X DOUBLE COMPARTMENT SCULLERY SINK, 14 GAUGE TYPE 304 STAINLESS STEEL, OVERALL DIMENSIONS OF 43 INCHES BY 23-13/16 INCHES BY 12 " DEEP, WELDED 1/4 INCH RADIUS COVED CORNER COMPARTMENTS WITH DIMENSIONS OF 27 INCHES BY 24 INCHES BY 14 INCHES DEEP AND DRAIN CENTERED IN COMPARTMENT, SINK COMPARTMENT SLOPED TO DRAINS, FULL LENGTH 10-3/4 INCH HIGH BACKSPLASH WITH 45 DEGREE SLOPED TOP, 1-1/2 INCH WIDE INWARD SLOPING TOP CHANNEL RIMS, EXPOSED SURFACES POLISHED TO A SATIN FINISH, NSF CERTIFIED. FAUCETS DESCRIPTION: T&S BRASS B-0231, WALL MOUNTED DUAL HANDLE SINK FAUCET, LEVER HANDLES, 2.2 GPM FINISH: POLISHED ACCESSORIES: ELKAY LK251 ADJUSTABLE LENGTH STAINLESS STEEL LEGS. CHROME PLATED 17 GAGE BRASS 1-1/2 INCH P-TRAP WITH CLEANOUT AND ARM WITH ESCUTCHEON. RIGID SUPPLIES: NPS 1/2 INCH SOLDERED OR THREADED COPPER CONNECTION TO SUPPLY, NPS 3/8 INCH CHROME PLATED BRASS ANGLED STOPS WITH QUARTER TURN ON/OFF OPERATION. BLOW OUT PROOF STEM AND CHROME PLATED METAL DIE CAST HANDLE (NO PLASTIC), CHROME PLATED RIGID COPPER RISERS UPSTREAM OF MIXING VALVE, CHROME PLATED RIGID COPPER RISERS OR STAINLESS STEEL FLEXIBLE SUPPLIES DOWNSTREAM OF MIXING VALVE DRAIN. FLKAY LK-99 OR FOLIAL DRAIN FITTING AND TAIL PIECE, TYPE 304 STAINLESS STEEL BODY, REMOVABLE CONICAL BASKET STRAINER WITH METAL BALL BEARING LOCKING STEM AND RUBBER STOPPER. FINISH: ULTRA BRIGHT POLISHED.

VALVE LEFT OR VALVE RIGHT - REFER TO SHOWER STALL CONFIGURATION FOR VALVE LOCATION. ACCESSIBLE RECESSED-MOUNTING STAINLESS STEEL INDIVIDUAL BARRIER FREE WALL SHOWER UNIT. PREASSEMBLED. LESS GRAB BAR. LESS SEAT. AND LESS CURTAIN. FIXE SHOWER HEAD 6-FEET 0-INCHES ABOVE FINISH FLOOR (BRADLEY SEVERE SERVICE SHOWERHEAD, 1.5 GPM FLOW CONTROL), LEVER HANDLE DIVERTER VALVE, 1.5 GPM HAND HELD SHOWER WITH 60-INCH STAINLESS STEEL FLEXIBLE HOSE AND POST STYLE MOUNTING BRACKET TO SHOWER PANEL, ELEVATED IN-LINE BACKFLOW PREVENTER WITH QUICK-DISCONNECT FOR FLEXIBLE HOSE, LESS BARRIER FREE SEAT, LESS CURTAIN, ROD, AND HOOKS, LESS GRAB BAR.

SHOWER DESCRIPTION (SH-1A): BRADLEY RECESS-MOUNTED ADA COMPLIANT WALL SHOWER MODEL NO. HN200-HD-6 '-0"-S15-HS-VL OR VR,

MOP BASIN DESCRIPTION (MSB-1): CRANE/FIAT MSB 3624. FLUSH TO WALL, ONE-PIECE CAST POLYMER MOP SERVICE BASIN WITH STAINLESS STEEL DOME STRAINER. 36 INCHES BY 24 INCHES BY 10-INCH-HIGH OUTSIDE DIMENSIONS. COLOR: WHITE FAUCET DESCRIPTION: CHICAGO FAUCETS FITTING 897-RCF, WALL MOUNTED SERVICE SINK FAUCET WITH INTEGRAL STOPS, LEVER HANDLES VACUUM BREAKER SPOUT, HOSE THREAD OUTLET, WALL BRACE, AND PAIL HOOK. FINISH: ROUGH CHROME.

ACCESSORIES: A. CRANE/FIAT 832-AA HOSE AND HOSE BRACKET. CRANE/FIAT 889-CC MOP HANGER.

FLEXIBLE SUPPLIES DOWNSTREAM OF MIXING VALVE.

FLEXIBLE SUPPLIES DOWNSTREAM OF MIXING VALVE.

CRANE/FIAT E77-AA VINYL BUMPER GUARDS (2 REQUIRED). CRANE/FIAT MSG-3624 STAINLESS STEEL WALL GUARDS; CRANE/FIAT 833-AA SILICONE SEALANT (INSTALL ON ALL EXPOSED

ELECTRIC WATER COOLER DESCRIPTION (EWC-1A): ELKAY EZH20 SYSTEM MODEL LZSTL8WSLP, ACCESSIBLE, BI-LEVEL WALL MOUNTED WATER COOLER WITH BOTTLE FILLING STATION. 8.0 GALLONS PER HOUR OF 50 DEGREE F WATER WITH 80 DEGREE F INLET WATER TEMPERATURE AND 90 DEGREE F AMBIENT ROOM TEMPERATURE, ELKAY "FLEXI-GUARD" BUBBLER, CONTROLS LOCATED ON FRONT, RIGHT, AND LEFT HAND SIDES. STAINLESS STEEL BASIN POLISHED TO BRIGHT FINISH WITH INTEGRAL GRID DRAIN AND NO EXPOSED FASTENERS. CONTOURED UPPER SHROUD WITH NO EXPOSED FASTENERS, AND ONE PIECE REMOVABLE LOWER SHROUD. BOTTLE FILLING STATION WITH ELECTRONIC SENSOR AND AUTOMATIC 20 SECOND SHUT OFF TIMER. LED LIGHT ILLUMINATING DISPENSING AREA. 1.1 GPM LAMINAR FLOW. WATERSENTRY PLUS FILTER CERTIFIED TO NSE/ANSL42 AND 53 FOR LEAD REDUCTION VISUAL MONITOR TO INDICATE WHEN FILTER REPLACEMENT IS NECESSARY, UNIT SHALL AUTOMATICALLY DETECT NEW FILTER AND RESET VISUAL FILTER MONITOR. COLOR: TWO TONE GRAY UPPER SHROUD AND TEXTURED GRAY LOWER SHROUD, 370 WATTS, 120 VAC, 60 HZ, SINGLE PHASE. INSTALL PER BARRIER FREE AND ACCESSORIES:

A. SUPPORT: ELKAY MODEL MLP200 IN WALL CARRIER SYSTEM WITH HANGER BRACKET AND (3) VERTICAL STEEL UPRIGHTS WITH B. DRAIN AND WASTE FITTING: GRID DRAIN WITH TAILPIECE; CHROME PLATED 17 GAGE BRASS 1-1/4-INCH P-TRAP WITH CLEANOUT C. SUPPLY: NPS ½ INCH SOLDERED OR THREADED COPPER CONNECTION TO SUPPLY, NPS 3/8 INCH CHROME PLATED BRASS ANGLED STOP WITH QUARTER TURN ON/OFF OPERATION, BLOW OUT PROOF STEM AND CHROME PLATED METAL DIE CAST HANDLE (NO PLASTIC), CHROME PLATED RIGID COPPER RISER OR STAINLESS STEEL FLEXIBLE SUPPLY. D. FILTER: ELKAY 51300C (3) FILTER REPLACEMENT PACK.

ELECTRIC WATER COOLER DESCRIPTION (EWC-2A): ELKAY EZH20 SYSTEM MODEL LZS8WSLP, ACCESSIBLE, SINGLE WALL MOUNTED WATER COOLER WITH BOTTLE FILLING STATION 8.0 GALLONS PER HOUR OF 50 DEGREE F WATER WITH 80 DEGREE F INLET WATER TEMPERATURE AND 90 DEGREE F AMBIENT ROOM TEMPERATURE FLIKAY "FLEXI-GUARD" BUBBLER CONTROLS LOCATED ON FRONT RIGHT AND LEFT HAND SIDES STAINLESS STEEL BASIN POLISHED TO BRIGHT FINISH WITH INTEGRAL GRID DRAIN AND NO EXPOSED FASTENERS. CONTOURED LIPPER SHROUD WITH NO EXPOSED FASTENERS, AND ONE PIECE REMOVABLE LOWER SHROUD. BOTTLE FILLING STATION WITH ELECTRONIC SENSOR AND AUTOMATIC 20 SECOND SHUT OFF TIMER. LED LIGHT ILLUMINATING DISPENSING AREA. 1.1 GPM LAMINAR FLOW. WATERSENTRY PLUS FILTER CERTIFIED TO NSF/ANSI 42 AND 53 FOR LEAD REDUCTION, VISUAL MONITOR TO INDICATE WHEN FILTER REPLACEMENT IS NECESSARY, UNIT SHALL AUTOMATICALLY DETECT NEW FILTER AND RESET VISUAL FILTER MONITOR. COLOR: TWO TONE GRAY UPPER SHROUD AND FEXTURED GRAY LOWER SHROUD, 370 WATTS, 120 VAC, 60 HZ, SINGLE PHASE. INSTALL PER BARRIER FREE AND ADA REQUIREMENTS.

A. SUPPORT: ELKAY MODEL MLP100 IN WALL CARRIER SYSTEM WITH HANGER BRACKET AND (2) VERTICAL STEEL UPRIGHTS WITH B. DRAIN AND WASTE FITTING: GRID DRAIN WITH TAILPIECE; CHROME PLATED 17 GAGE BRASS 1-1/4-INCH P-TRAP WITH CLEANOUT AND ARM WITH ESCUTCHEON. C. SUPPLY: NPS ½ INCH SOLDERED OR THREADED COPPER CONNECTION TO SUPPLY, NPS 3/8 INCH CHROME PLATED BRASS ANGLED STOP WITH QUARTER TURN ON/OFF OPERATION, BLOW OUT PROOF STEM AND CHROME PLATED METAL DIE CAST HANDLE (NO PLASTIC), CHROME PLATED RIGID COPPER RISER OR STAINLESS STEEL FLEXIBLE SUPPLY. D. FILTER: ELKAY 51300C (3) FILTER REPLACEMENT PACK.

PLUMBING LINE	SERVICE DESIGNATION
AV	ACID VENT PIPING
AW	ACID WASTE PIPING ABOVE GROU
	ACID WASTE DIDING LINDEDGDOL

—AW———	ACID WASTE PIPING ABOVE GROUND
—AW————	ACID WASTE PIPING UNDERGROUND
—-CA	COMPRESSED AIR PIPING
COND	CONDENSATE PIPING
	DOMESTIC COLD WATER PIPING
—-G-—	NATURAL GAS PIPING
—GSAN————	GREASE LADEN SANITARY DRAIN PIP
—HW———	DOMESTIC HOT WATER PIPING
—HWR—	DOMESTIC HOT WATER RETURN PIPIN
OSAN	OIL LADEN SANITARY DRAIN PIPING
—SAN———	SANITARY DRAIN PIPING ABOVE GRO
—SAN-———	SANITARY DRAIN PIPING UNDERGROU
SAN (FM)	SANITARY FORCED MAIN DRAIN PIPIN
scw	SOFTENED DOMESTIC COLD WATER F
—ST——	STORM DRAIN PIPING ABOVE GROUN
—ST-————	STORM DRAIN PIPING UNDERGROUND
ST(O)	OVERFLOW STORM DRAIN PIPING
V	SANITARY VENT PIPING

NOT ALL PIPE SERVICES MAY BE PRESENT IN CONSTRUCTION DOCUMENTS.

→ DIRECTION OF FLOW

MATCHLINE

	PLUMBING ABBREVIATIONS	
AAV	AIR ADMITTANCE VALVE	
\FF	ABOVE FINISH FLOOR	
\HU	AIR HANDING UNIT	
٩V	ACID VENT	
AVTR	ACID VENT THROUGH ROOF	
١	ACID WASTE	
BFP	BACKFLOW PREVENTER	
BT	BATHTUB	
CA	COMPRESSED AIR	
CBV	CALIBRATED BALANCING VALVE	
CLG	CEILING	
COND	CLEANOUT	
COND	CONDENSATE CONNECTION	
CONT	CONTINUATION	
CONTR	CONTRACTOR	
COORD	COORDINATE	
CW	DOMESTIC COLD WATER	
CWFU	COLD WATER FIXTURE UNITS	
OF	DRINKING FOUNTAIN	
DFU	DRAINAGE FIXTURE UNITS	
ON	DOWN	
OPB	DOMESTIC WATER PRESSURE BOOSTER	
OSN	DOWNSPOUT NOZZLE	
OW	DISHWASHER	
OWG	DRAWING	
DWH	DOMESTIC WATER HEATER	
ĒΤ	EXPANSION TANK	
EWC	ELECTRIC WATER COOLER	
EX / EXIST	EXISTING	
-CO	FLOOR CLEANOUT	
-D	FLOOR DRAIN	
FLR FSET	FLOOR	
	FOOD SERVICE EQUIPMENT TRADES NATURAL GAS	
G Gl	GREASE INTERCEPTOR	
SSAN	GREASE LADEN SANITARY	
H&C	DOMESTIC HOT AND DOMESTIC COLD WATER	S
НВ	HOSE BIBB	
HSS	HOLLOW STRUCTURAL SECTION	
HW	DOMESTIC HOT WATER	
HWFU	HOT WATER FIXTURE UNITS	
HWR	DOMESTIC HOT WATER RETURN	
E	INVERT ELEVATION	
OB	ICE MAKER OUTLET BOX	
LOC	LOCATION	
.T	LAUNDRY TUB	
MAU	MAKE-UP AIR UNIT	I I
MAX	MAXIMUM	
MFR	MANUFACTURER MOD SEDVICE BASIN	
MSB MIN	MOP SERVICE BASIN	
VIIN MV	MINIMUM MIXING VALVE	
VIV DA	OUTSIDE AIR	
DC DC	ON CENTER	
DD D	OVERFLOW ROOF DRAIN	\$
OI	OIL INTERCEPTOR	
OSAN	OIL LADEN SANITARY	h
PSI	POUNDS PER SQUARE INCH	
RD	ROOF DRAIN	
RFCBV	RESTRICTED FLOW CALIBRATED BALANCING VALVE	

NOT ALL ABBREVIATIONS MAY BE PRESENT IN CONSTRUCTION DOCUMENTS.

REDUCED PRESSURE ZONE BACKFLOW PREVENTER

SANITARY FORCED MAIN

STORM OVERFLOW

TRENCH DRAIN

UNDERGROUND

SANITARY VENT

WALL CLEANOUT

WALL HYDRANT

VENT THROUGH ROOF

UNLESS NOTED OTHERWISE

UNITED STATES GEOLOGICAL SURVEY

WATER CLOSET OR WATER COLUMN

WASHING MACHINE OUTLET BOX

WATER SUPPLY FIXTURE UNITS

SHOWER

STORM

TYPICAL

SOFTENED DOMESTIC COLD WATER

RPZBFP

SAN(FM)

SCW

ST(O)

USGS

WCO

WMB WSFU

BALL VALVE BALL VALVE GLOBE VALVE CHECK VALVE CALIBRATED BALANCING VALVE RELIEF I SAFETY VALVE BACKFLOW PREVENTER WITH DRIP PAN HOSE BIBB / WALL HYDRANT PLUG VALVE ANGLE VALVE SOLENDID VALVE PIPE RISER UP PIPE RISER UP PIPE RISER DOWN UNION CAP 'Y' STRAINER WIBLOWDOWN FLEXIBLE CONNECTOR CONNECT TO EXISTING CONCENTRIC REDUCER THERMOMETER FE FLOW SWITCH PRESSURE SWITCH PT PRESSURE SWITCH PT PRESSURE SWITCH PT COMB FRITER, REG. & OILER PRESSURE REDUCING VALVE, SELF-CONTAINED EXT. PRESSURE REDUCING VALVE, SELF-CONTAINED EXT. PRESSURE REDUCING VALVE.	PLUMB	BING SYMBOLS LEGEND



	FF	
EXT. PRESSURE REDUCING VALVE		PRESSURE REDUCING VALVE, SELF-CONTAINED
		EXT. PRESSURE REDUCING VALVE

NOT ALL SYMBOLS MAY BE PRESENT IN CONSTRUCTION DOCUMENTS.

GENERAL PLUMBING PIPING INSTALLATION NOTES 1. COORDINATE ROUTING OF PLUMBING PIPING WITH ALL TRADES. ALL SANITARY PIPING TO BE INSTALLED AND VENTED PER PLANS AND ALL APPLICABLE STATE AND LOCAL

2. REFER TO PROJECT SPECIFICATIONS MANUAL FOR ADDITIONAL REQUIREMENTS. 3. DRAWING PLANS, SCHEMATICS, AND DIAGRAMS INDICATE THE GENERAL LOCATION AND ARRANGEMENT OF PIPING SYSTEMS. INDICATED LOCATIONS AND ARRANGEMENTS WERE USED TO SIZE PIPE AND OTHER DESIGN CONSIDERATIONS. INSTALL PIPING AS INDICATED UNLESS DEVIATIONS TO LAYOUT ARE APPROVED ON COORDINATION

4. CONTRACTOR SHALL BE RESPONSIBLE FOR THE COORDINATION OF ALL PIPE SLEEVES THROUGH FOUNDATION WALLS WITH OTHER TRADES.

5 INSTALL CLEANOUTS AT THE BASE OF ALL DRAIN PIPE STACKS WITH THE CENTER OF THE PLUG LOCATED AT A MINIMUM OF 12 INCHES ABOVE THE FINISH FLOOR, UNLESS NOTED OTHERWISE. COORDINATE LOCATIONS WITH OTHER BUILDING ELEMENTS TO ENSURE ACCESS.

6. INSTALL PIPING IN CONCEALED LOCATIONS UNLESS INDICATED OTHERWISE OR WHERE LOCATED IN EQUIPMENT ROOMS AND SERVICE AREAS. INSTALL PIPING INDICATED TO BE EXPOSED AND PIPING IN EQUIPMENT ROOMS AND SERVICE AREAS AT RIGHT ANGLES OR PARALLEL TO BUILDING WALLS. DIAGONAL RUNS ARE PROHIBITED UNLESS SPECIFICALLY INDICATED OTHERWISE.

7. ROUTE PIPING IN WALLS TO FIXTURE AND EQUIPMENT AT PROPER ELEVATION.

8. INSTALL PIPING ABOVE ACCESSIBLE CEILINGS TO ALLOW SUFFICIENT SPACE FOR CEILING TILE REMOVAL. 9. INSTALL PIPING TO PERMIT VALVE SERVICING, FREE OF SAGS AND BENDS, AT

INDICATED SLOPES. INSTALL FITTINGS FOR CHANGES OF DIRECTION AND BRANCH CONNECTIONS, AND TO ALLOW THE APPLICATION OF INSULATION. 10. UNLESS NOTED OTHERWISE ON THE PLUMBING PLANS, INSTALL DRAIN PIPING 2" AND

SMALLER SLOPED AT 1/4" PER FOOT (MINIMUM), AND DRAIN PIPING 3" AND LARGER SLOPED AT 1/8" PER FOOT (MINIMUM). 11. INSTALL SANITARY VENT PIPING SLOPED (GRADED) BACK TO THE DRAINAGE SYSTEM.

12. INSTALL OVERSIZED PIPE HANGERS ON ALL PIPING SYSTEMS WITH A CONTINUOUS

VAPOR BARRIER. REFER TO SPECIFICATION SECTION 22 07 19. 13. PIPE HANGERS SHALL NOT BE ATTACHED TO THE ROOF DECK UNLESS INDICATED

GENERAL PLUMBING FOOD SERVICE INSTALLATION NOTES 1. REFER TO PROJECT SPECIFICATIONS MANUAL FOR ADDITIONAL REQUIREMENTS.

2. COORDINATE PLUMBING ROUGH IN REQUIREMENTS WITH FOOD SERVICE EQUIPMENT RADES DRAWINGS AND SPECIFICATIONS.

3. COORDINATE LOCATIONS OF FILTRATION EQUIPMENT INSTALLED UPSTREAM OF FOOD SERVICE EQUIPMENT. 4. CONTRACTOR SHALL FURNISH AND INSTALL PRESSURE REDUCING VALVES AND

BACKFLOW PREVENTERS WHERE REQUIRED AND NOT FURNISHED BY THE FOOD SERVICE EQUIPMENT TRADES. 5. CONTRACTOR SHALL FURNISH AND INSTALL INDIVIDUAL MIXING VALVES (ASSE 1070) ON WATER SUPPLIES TO ALL SINKS IN FOOD SERVICE AREAS EXCEPT FOR 3 COMPARTMENT

HOT WATER RISK OF SCALDING".

SINKS AND MOP SERVICE BASINS. FURNISH AND INSTALL SIGNAGE ABOVE THE 3

COMPARTMENT SINKS AND MOP SERVICE BASINS THAT READS AS FOLLOWS: "CAUTION -

F	IXTURE UN	IIT VALUES			
	DRAINAGE (NOTE 1)				
FIXTURE	DFU	HWFU	CWFU	TOTAL	
WATER CLOSET (FLUSH VALVE)	4		10	10	
WATER CLOSET (FLUSH TANK)	4		2	2	
URINAL (FLUSH VALVE)	2		5	5	
LAVATORY	1	1.5	1.5	2	
SINK	2	1	1	1.4	
SHOWER	2	3	3	4	
MOP SERVICE BASIN	2	2.25	2.25	3	
WASHING MACHINE OUTLET BOX (WITH STANDPIPE)	2	2.25	2.25	3	
WALL HYDRANT / HOSE BIBB			3	3	
ELECTRIC WATER COOLER / DRINKING FOUNTAIN	0.5		0.25	0.25	
FLOOR DRAIN / FLOOR	2				

1. DRAINAGE FIXTURE UNIT VALUES (DFU) TAKEN FROM THE INDIANA PLUMBING CODE

2. SUPPLY FIXTURE UNIT VALUES TAKEN FROM THE INDIANA PLUMBING CODE. 3. NOT ALL PLUMBING FIXTURES MAY BE PRESENT IN CONSTRUCTION DOCUMENTS.

NOTES:

1. REFER TO SPECIFICATION SECTIONS

2. REFER TO PROJECT SPECIFICATIONS

REQUIREMENTS.

REQUIREMENTS.

FOR HANGERS AND SUPPORTS FOR PLUMBING PIPING SUBMITTALS, PRODUCTS, AND INSTALLATION

FOR PLUMBING PIPING INSULATION SUBMITTALS

(INCLUDING MOCK UPS), PRODUCTS, AND INSTALLATION

GENERAL PLUMBING EQUIPMENT INSTALLATION NOTES

- 1. REFER TO PROJECT SPECIFICATIONS MANUAL FOR ADDITIONAL REQUIREMENTS.
- 2. INSTALL PLUMBING EQUIPMENT, TRIM, FITTINGS, AND OTHER COMPONENTS IN ACCORDANCE WITH THE MANUFACTURER'S WRITTEN INSTRUCTIONS.

3. INSTALL PLUMBING EQUIPMENT ON CONCRETE BASE WHERE INDICATED.

GENERAL PLUMBING FIXTURE INSTALLATION NOTES: 1. REFER TO PROJECT SPECIFICATIONS MANUAL FOR ADDITIONAL REQUIREMENTS. 2. ASSEMBLE PLUMBING FIXTURES, TRIM, FITTINGS, AND OTHER COMPONENTS IN ACCORDANCE WITH THE MANUFACTURER'S WRITTEN INSTRUCTIONS.

FIXTURES. INSTALL BACK OUTLET WALL MOUNTED FIXTURES ONTO WASTE FITTINGS WITH SEALS AND ATTACH TO SUPPORTS. INSTALL WALL MOUNTED FIXTURES WITH TUBULAR WASTE PIPING ATTACHED TO SUPPORTS.

4. INSTALL COUNTER MOUNTED FIXTURES IN AND ATTACHED TO CASEWORK. 5. INSTALL FIXTURES LEVEL AND PLUMB ACCORDING TO ROUGH IN DRAWINGS. 6. INSTALL WATER SUPPLY WITH STOP ON EACH SUPPLY TO EACH FIXTURE TO BE CONNECTED TO WATER DISTRIBUTION PIPING. ATTACH SUPPLIES TO SUPPORTS OR SUBSTRATE WITHIN PIPE SPACES BEHIND FIXTURES. INSTALL STOPS WHERE THEY CAN BE REACHED FOR

3. INSTALL OFF THE FLOOR SUPPORTS AFFIXED TO BUILDING SUBSTRATE FOR WALL MOUNTING

7. INSTALL TRAP AND TUBULAR WASTE PIPING ON DRAIN OUTLET OF EACH FIXTURE TO BE

DIRECTLY OR INDIRECTLY CONNECTED TO DRAINAGE SYSTEM. 8. INSTALL FLUSHOMETER VALVES FOR ACCESSIBLE WATER CLOSETS AND URINALS WITH THE HANDLE MOUNTED ON THE WIDE SIDE OF THE COMPARTMENT.

9. INSTALL TANKS FOR ACCESSIBLE, TANK TYPE WATER CLOSETS WITH LEVER HANDLE MOUNTED ON THE WIDE SIDE OF THE COMPARTMENT.

10. SET BATHTUBS, SHOWERS, AND MOP SERVICE BASINS IN A LEVELING BED OF CEMENT 11. SEAL JOINTS BETWEEN FIXTURES, WALLS, FLOORS, AND COUNTERTOPS USING SANITARY

TYPE, ONE PART, MILDEW RESISTANT SILICONE SEALANT. MATCH SEALANT COLOR TO

GENERAL DEMOLITION NOTES:

1. ALL EXISTING PLUMBING FIXTURES, EQUIPMENT, AND ASSOCIATED PIPING SHOWN AS DASHED (HEAVY/BOLD) SHALL BE REMOVED. PROTECT EXISTING WORK WHICH IS TO REMAIN IN PLACE FOR REUSE WITH TEMPORARY COVERS, SHORING, BRACING, AND SUPPORTS. EXISTING DOMESTIC COLD, HOT, HOT WATER RETURN, AND NATURAL GAS PIPING LOCATED IN TUNNELS SHALL BE CAPPED AND ABANDONED IN PLACE.

2. THE OWNER RESERVES THE RIGHT OF FIRST REFUSAL IN OWNERSHIP OF ANY EQUIPMENT AND MATERIALS TO BE REMOVED FROM THE BUILDING SITE. ALL EQUIPMENT TO BE REMOVED AND NOT REUSED SHALL BECOME THE PROPERTY OF THE CONTRACTOR AND SHALL BE REMOVED FROM THE OWNERS PROPERTY.

3. INVESTIGATION OF EXISTING PLUMBING SYSTEMS WILL BE REQUIRED BY THE CONTRACTOR AS PART OF HIS BID PRICE, SO THAT THE EXACT EXTENT OF DEMOLITION CAN BE ACCURATELY DETERMINED. THE CONTRACTOR'S BID PRICE SHALL ALSO COVER REMOVAL OF SOME PORTIONS OF PLUMBING SYSTEMS NOT EXPLICITLY SHOWN ON THE DEMOLITION DRAWINGS, BUT DISCOVERED DURING THE INVESTIGATION PROCESS. THE CONTRACTOR SHALL WORK WITH THE ARCHITECT/ENGINEER AND THE OWNER TO DETERMINE WHICH PORTIONS OF EXISTING SYSTEMS MUST REMAIN ACTIVE AND WHICH PORTIONS MUST BE DEMOLISHED. REMOVE ALL INACTIVE PIPING TO THE NEAREST ACTIVE MAINS AND CAP. ABANDONED PIPING SYSTEMS BENEATH THE BUILDING SHALL BE CAPPED AT BOTH ENDS.

4. DEMOLITION OF AN ITEM SHALL INCLUDE REMOVAL OF ALL RELATED HANGERS, SUPPORTS, PIPING, AND ACCESSORIES. REMOVAL OF POWER WIRING SHALL BE BY OTHERS UNLESS INDICATED OTHERWISE

5. CONTRACTOR SHALL PROTECT ALL WALLS, CEILINGS, FLOORS, LIGHTS AND OTHER FINISHED SURFACES WHICH ARE NOT SCHEDULED FOR IMMEDIATE REMOVAL. IF SURFACES OR LIGHTS ARE DAMAGED, CONTRACTOR SHALL REPAIR OR REPLACE TO MATCH ORIGINAL CONDITIONS.

6. CONTRACTOR SHALL COORDINATE WITH OTHER TRADES FOR ALL FLOOR, WALL, AND ROOF REPAIR WORK LEFT BY REMOVED ITEMS.

MINIMUM SIZE CONNECTION					
FIXTURE	CW	HW	SAN	VENT	
ATER CLOSET LUSH VALVE)	1 1/4"		4"	2"	
RINAL (FLUSH VALVE)	3/4"		2"	1 1/2"	
VATORY	1/2"	1/2"	1 1/4"	1 1/4"	
NK	1/2"	1/2"	1 1/2"	1 1/2"	
IOWER	1/2"	1/2"	2"	1 1/2"	
OP SERVICE BASIN	3/4"	3/4"	3"	1 1/2"	
ASHING MACHINE OUTLET DX (WITH STANDPIPE)	3/4"	3/4"	3" (TRAP)	1 1/2"	
E MAKER OUTLET BOX	1/2"				
ALL HYDRANT / HOSE BIBB	3/4"				
ECTRIC WATER COOLER	1/2"		1 1/4"	1 1/4"	
RINKING FOUNTAIN	1/2"		1 1/4"	1 1/4"	
OOR DRAIN / FLOOR SINK			3"	1 1/2"	
OOR DRAIN / FLOOR SINK ECHANICAL ROOM)			4"	2"	

NOT ALL PLUMBING FIXTURES MAY BE PRESENT IN CONSTRUCTION DOCUMENTS.

THREADED ROD

PIPE INSULATION

WATER	HAMMER ARRI	ESTOR LEGEND
SYMBOL	PDI RATING	FIXTURE UNIT CAP
A	Α	1-11
B	В	12-32
C	С	33-60
D	D	61-113
E	E	114-154
F	F	155-330
NOTE:	_	

PLUMBING CONTRACTOR SHALL BE RESPONSIBLE FOR THE PROPER PLACEMENT OF WATER HAMMER ARRESTORS. REFER TO SPECIFICATION SECTION 22 11 19 AND MANUFACTURERS RECOMMENDATIONS.

-PROVIDE CHROME-

PLATED ESCUTCHEON

—SCH.40 STEEL PIPE SLEEVE.

-CAULK SEALANT (TYP.)

-SUPPORT PIPE INSIDE &


-PIPE INSULATION

OUTSIDE OF WALL CAVITY

IN FINISHED AREAS

NOTE: SIMILAR FOR INSULATED PIPE. INSULATION

SHALL BE CONTINUOUS THROUGH WALL

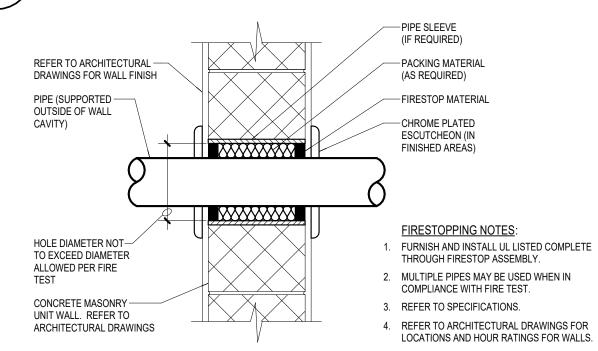

NOTE: SIMILAR FOR INSULATED PIPE. INSULATION SHALL BE CONTINUOUS THROUGH WALL

FIRESTOPPING AT BLOCK WALL PENETRATION DETAIL



---PIPE INSULATION

SINK (2" TRAP)


SINK (3" TRAP)

SINK (4" TRAP)

FLOOR DRAIN / FLOOR

FLOOR DRAIN / FLOOR

FLOOR DRAIN / FLOOR SINK (EMERGENCY)

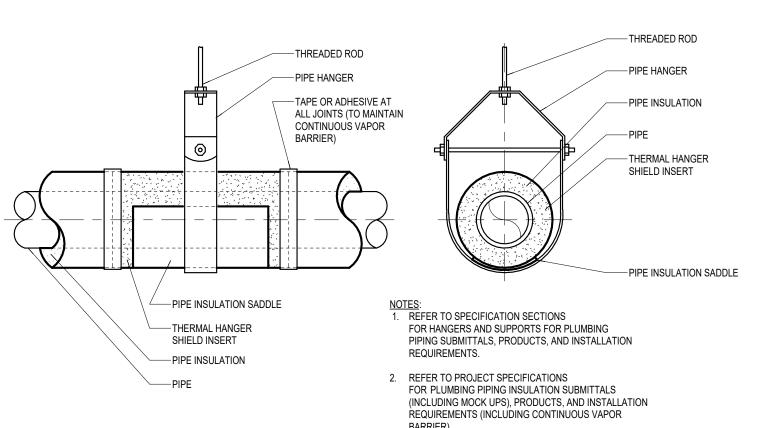

PLUMBING PIPE HANGER WITH INSULATION DETAIL (BELOW AMBIENT) NOT TO SCALE

ISSUANCES 01.06.2025 BIDS & CONSTRUCTION

01.16.2025 ADDENDUM 001

11200232

STATE OF

0

C

DRAWN REVIEWED AJM


PROJECT NO. NO PART OF THIS DRAWING MAY BE USED OR REPRODUCED IN ANY FORM OR BY ANY MEANS, OR STORED IN A DATA BASE OR RETRIEVAL SYSTEM, WITHOUT PRIOR WRITTEN PERMISSION OF

PLUMBING GENERAL INFORMATION

GMB COPYRIGHT © 2025 ALL RIGHTS RESERVED

P0.01

PLUMBING DEMO KEYNOTE LEGEND D01 REMOVE EXISTING PLUMBING FIXTURE, FAUCET, FLUSH VALVE, P-TRAPS, SUPPLIES AND ALL RELATED ACCESSORIES LOCATED IN THIS AREA. CAP WASTE PIPING BELOW FLOOR. REMOVE VENT, HOT WATER AND COLD WATER PIPING BACK TO NEAREST MAIN AND CAP. SAW-CUT AND PATCH CONCRETE FLOOR AS REQUIRED FOR THE REMOVAL AND CAPPING OF PIPING. 2 EXISTING PIPING LOCATED OVERHEAD ABOVE CEILING TO REMAIN. 003 REMOVE EXISTING PIPING LOCATED ABOVE CEILING. D04 REMOVE EXISTING SHOWERS, WALL SHROUD, RELATED PIPING AND THERMOSTATIC MIXING VALVE IN WALL CABINET. Design, Inc. D05 REMOVE EXISTING FLOOR DRAIN AND RELATED PIPING. CAP PIPING BELOV FLOOR. PATCH AND REPAIR EXISTING CONCRETE FLOOR. D06 REMOVE EXISTING SANITARY DRAIN PIPING LOCATED BELOW FLOOR. D07 EXISTING FLOOR DRAIN TO REMAIN. CLEAN AND JET DRAIN BODY AND SANITARY PIPING TO ENSURE PROPER DRAINAGE.

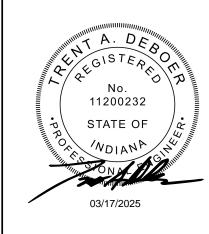

ISSUANCES 01.06.2025 BIDS & CONSTRUCTION

01.16.2025 ADDENDUM 001


DRAWN

REVIEWED AJM PROJECT NO. NO PART OF THIS DRAWING MAY BE USED OR REPRODUCED IN ANY FORM OR BY ANY MEANS, OR STORED IN A DATA BASE OR RETRIEVAL SYSTEM, WITHOUT PRIOR WRITTEN

UNIT 'A' PLUMBING **DEMOLITION PLAN**

GMB COPYRIGHT © 2025 ALL RIGHTS RESERVED

P1.1A

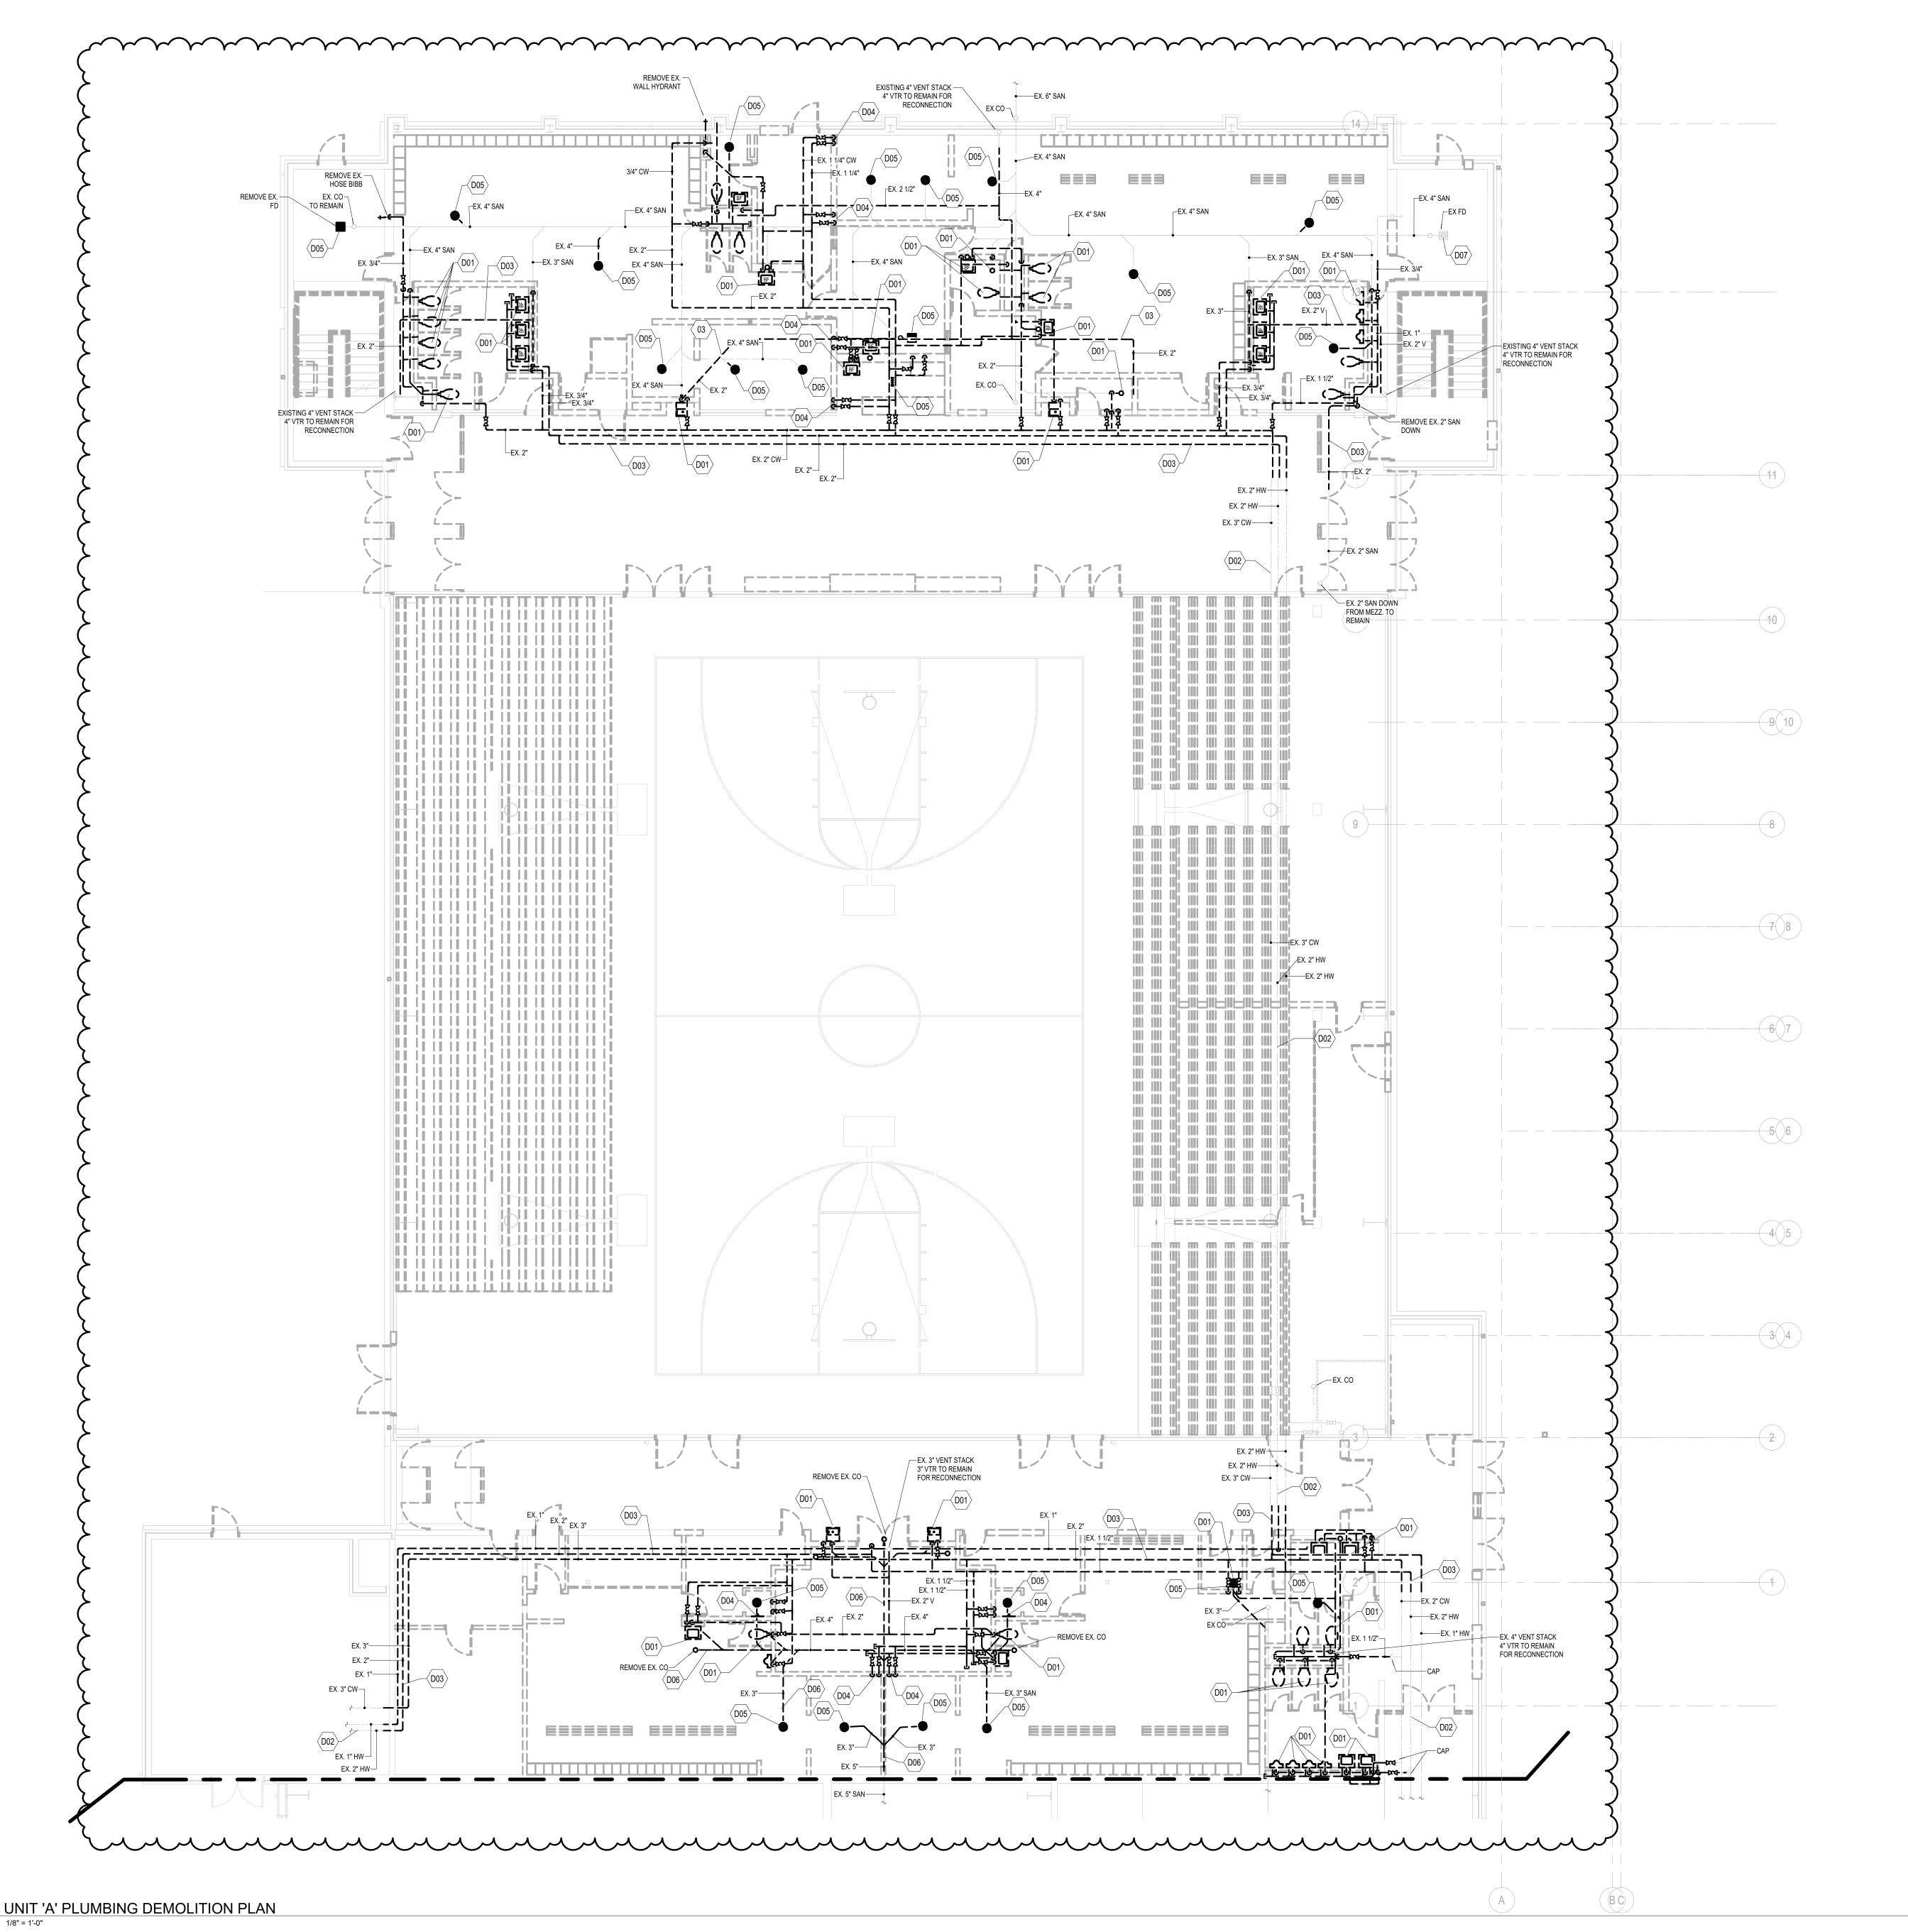



3ID PACKAGE #1

ESTERN WAYNE SCHOO

ISSUANCES
01.06.2025 BIDS & CONSTRUCTION

01.16.2025 ADDENDUM 001

03.13.2025 BULLETIN 001

DRAWN DAL
REVIEWED AJM

PROJECT NO. 5-6394

NO PART OF THIS DRAWING MAY BE


PROJECT NO. 5-6394

NO PART OF THIS DRAWING MAY BE USED OR REPRODUCED IN ANY FORM OR BY ANY MEANS, OR STORED IN A DATA BASE OR RETRIEVAL SYSTEM, WITHOUT PRIOR WRITTEN PERMISSION OF

GMB COPYRIGHT © 2025

UNIT 'A' PLUMBING PLAN

P2.1A

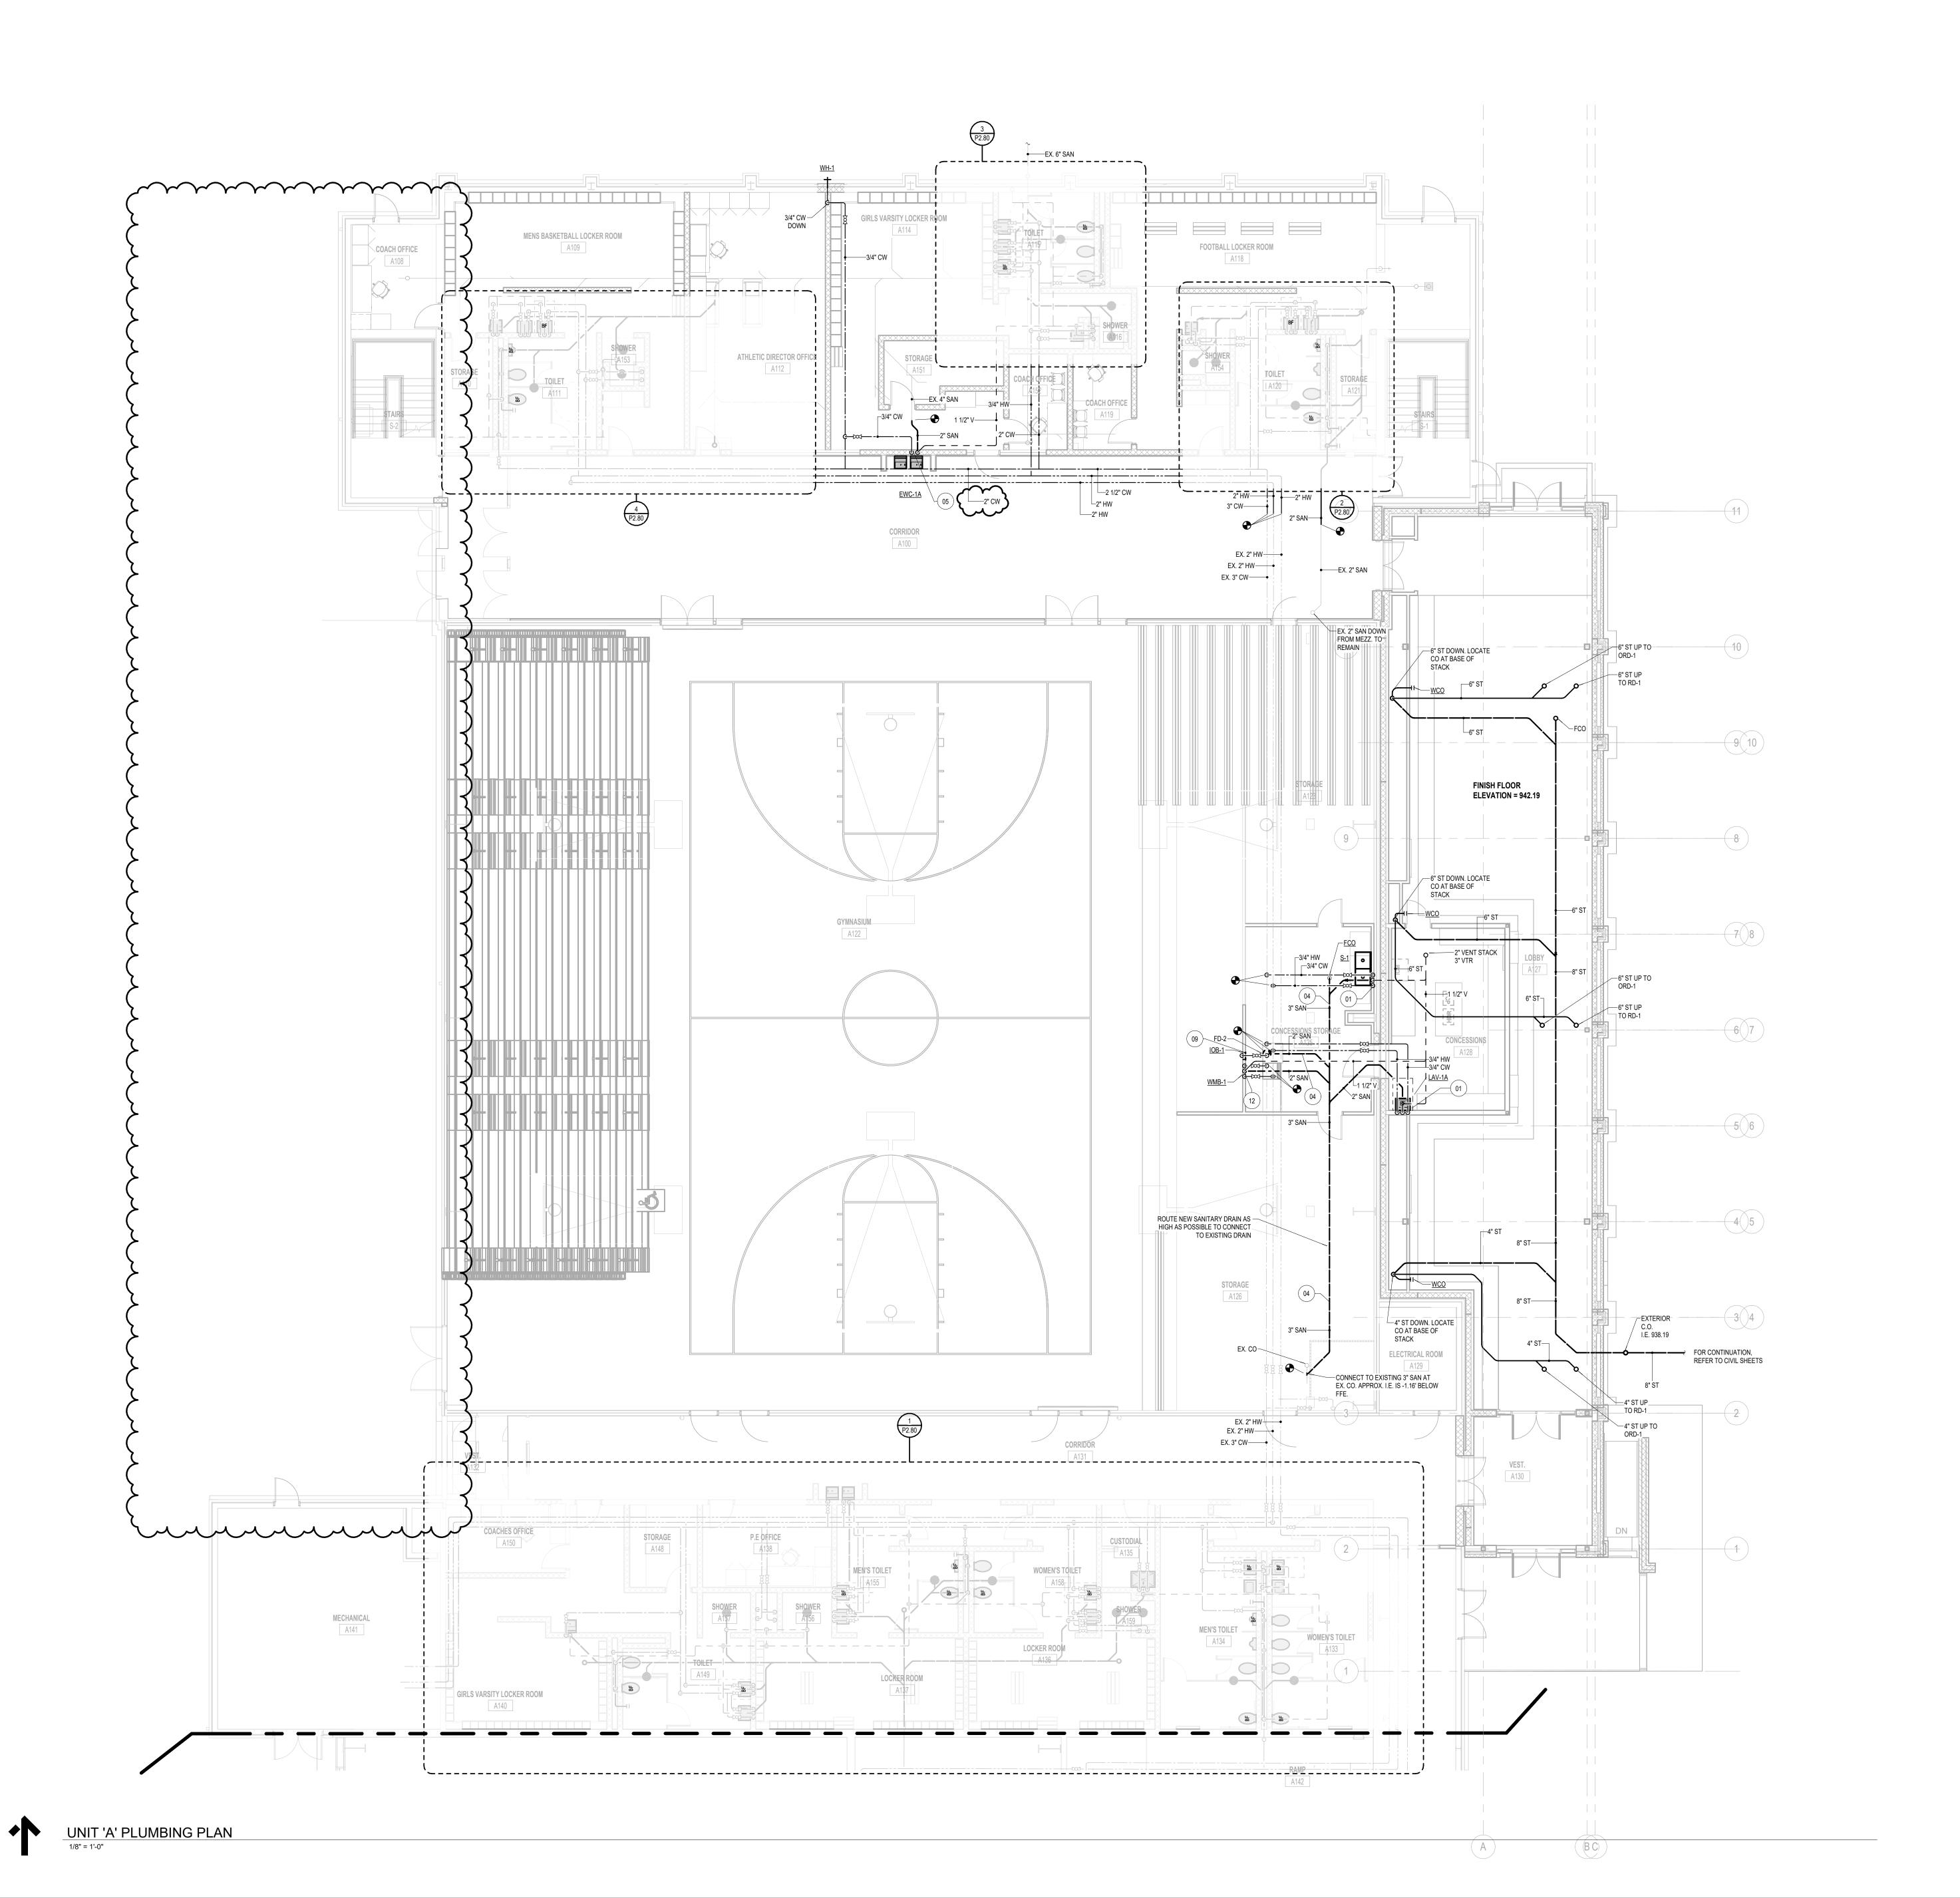

PLUMBING KEYNOTE LEGEND

05 ROUTE 3/4" COLD WATER DOWN, 2" WASTE DOWN AND 1 1/2" VENT UP.

03 ROUTE NEW PIPING ABOVE CEILING.

ON COLD WATER PIPING.

EX. 6" SAN

–EX. CO

EXISTING 4" VENT STACK —

4" VTR TO REMAIN FOR RECONNECTION


01.06.2025 BIDS & CONSTRUCTION 01.16.2025 ADDENDUM 001 03.13.2025 BULLETIN 001

REVIEWED AJM PROJECT NO. NO PART OF THIS DRAWING MAY BE USED OR REPRODUCED IN ANY FORM OR BY ANY MEANS, OR STORED IN A DATA BASE OR RETRIEVAL SYSTEM, WITHOUT PRIOR WRITTEN PERMISSION OF

GMB COPYRIGHT © 2025 ALL RIGHTS RESERVED **ENLARGED PLUMBING PLANS**

ENLARGED VARSITY LOCKER ROOM AND MENS AND WOMENS TOILET PLUMBING PLAN

1/4" = 1'-0" P2.80

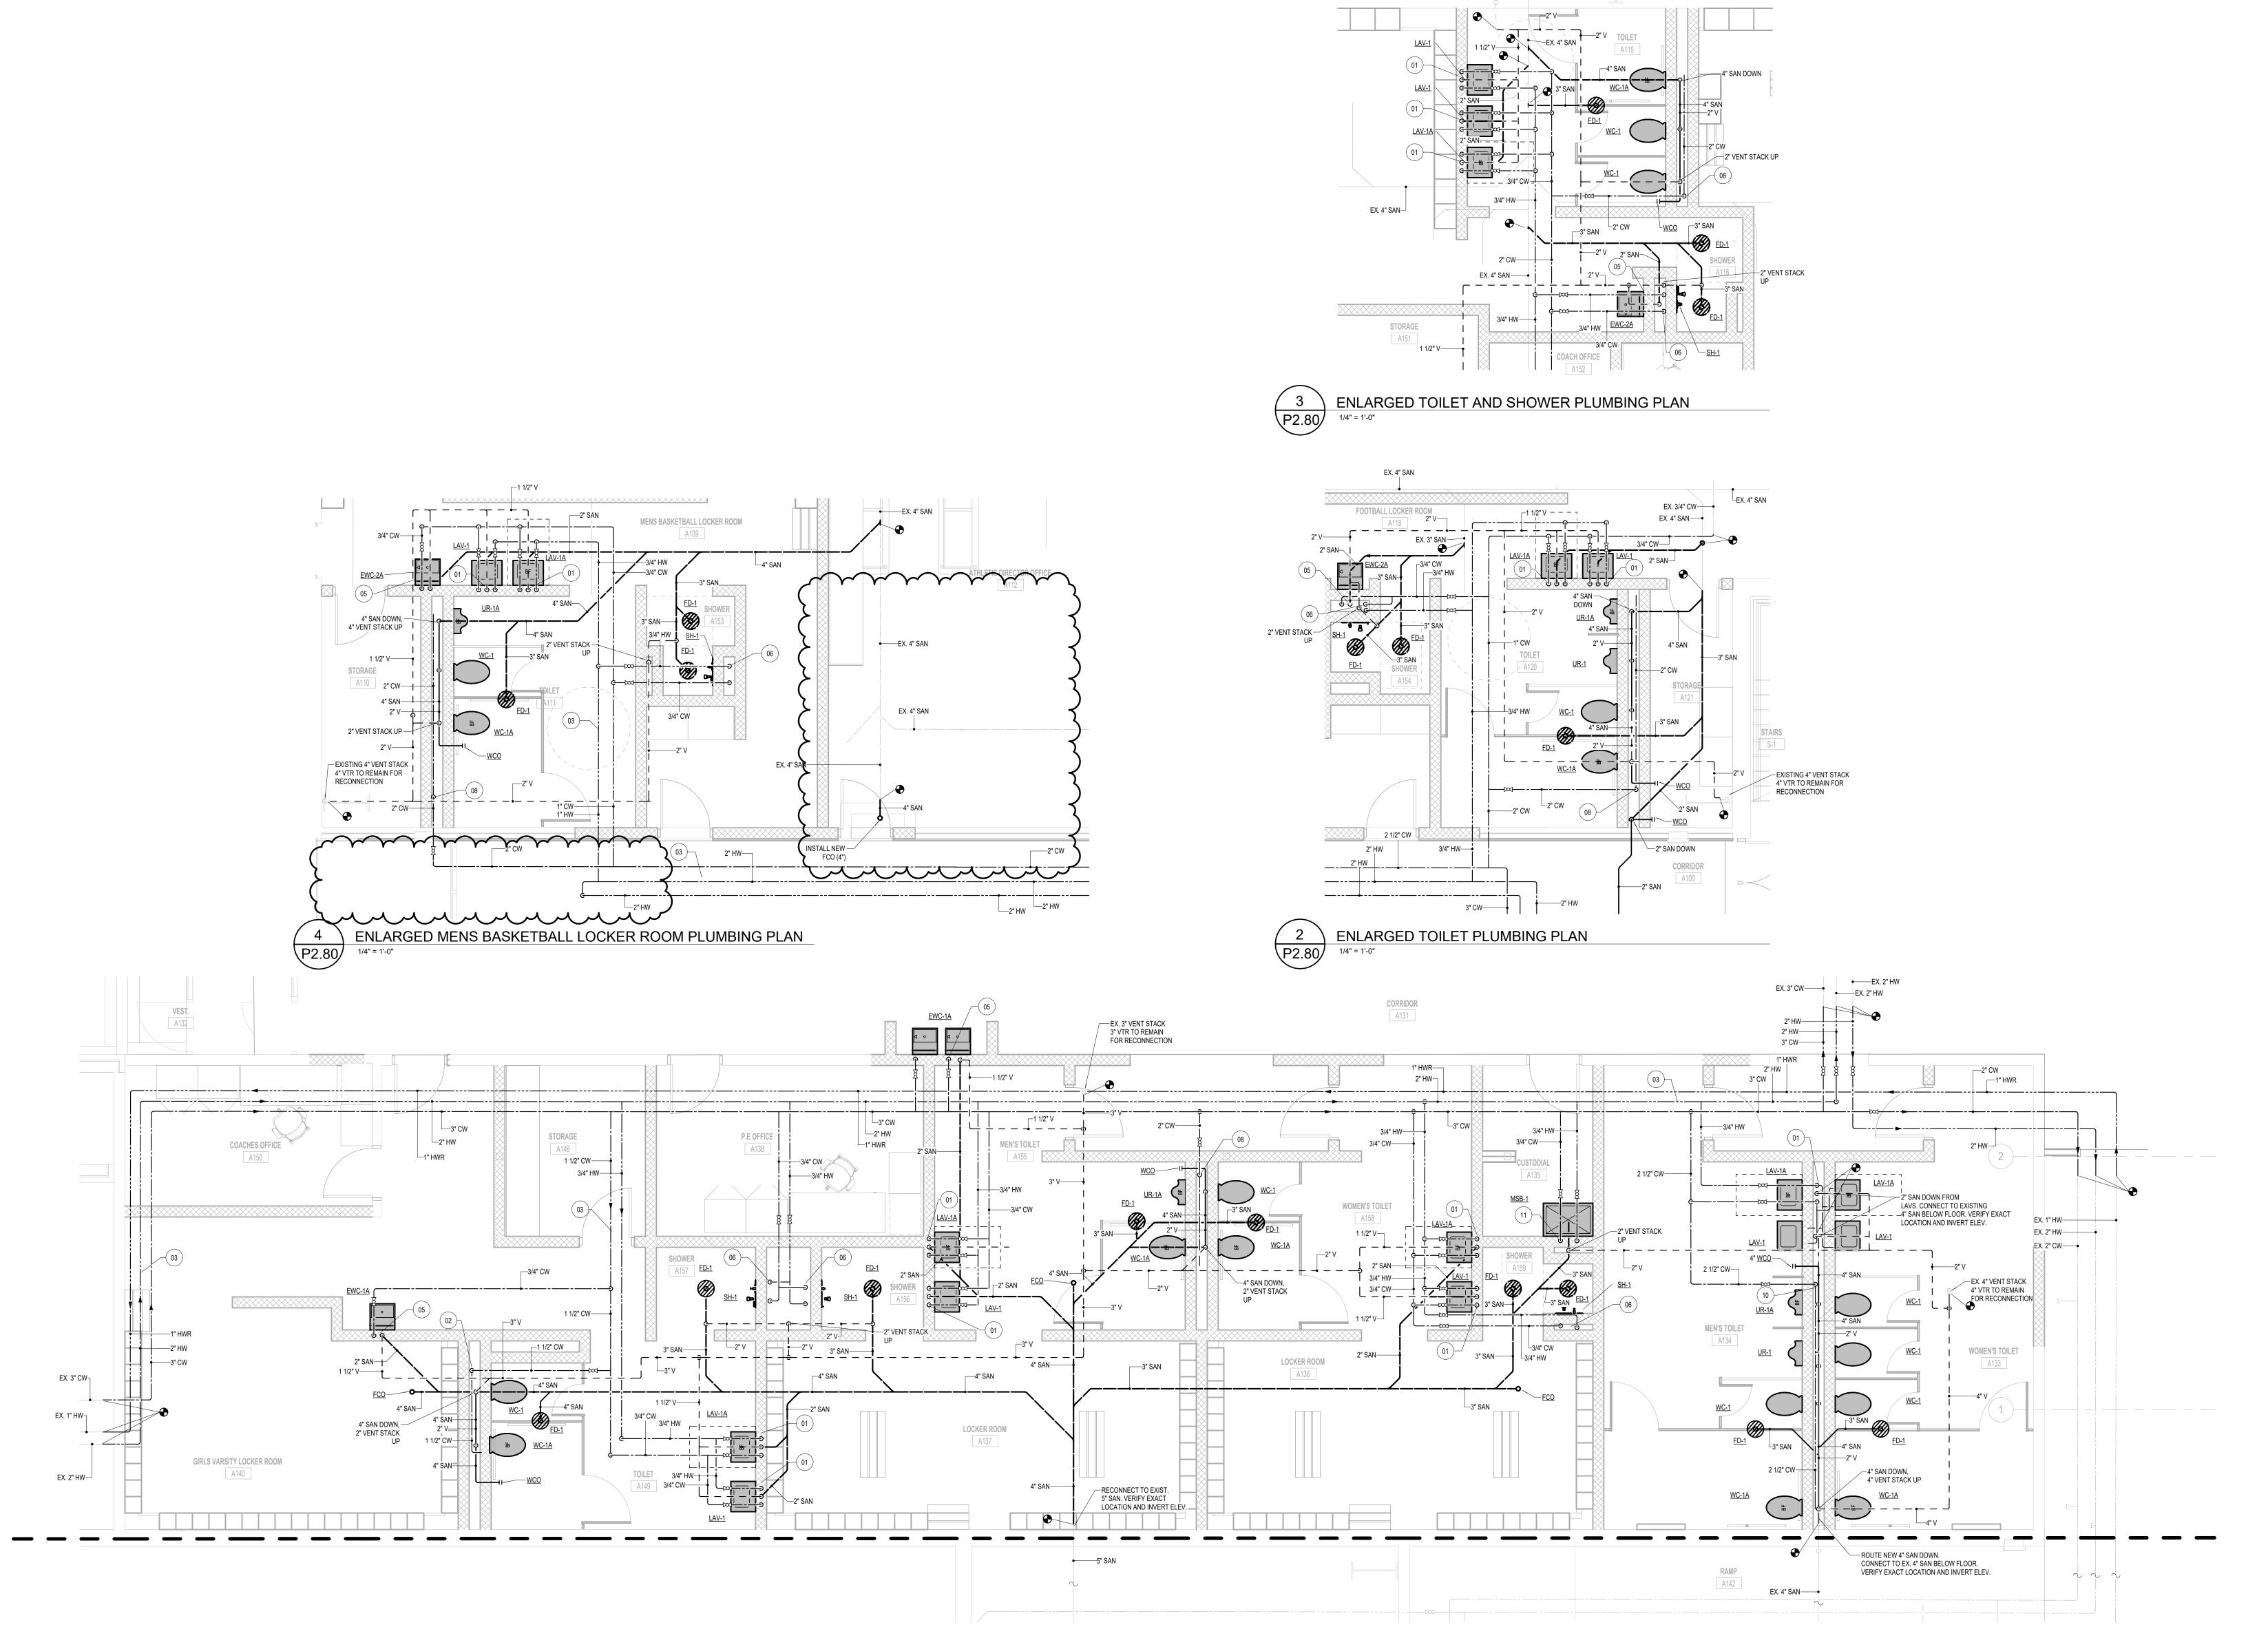

01.06.2025 BIDS & CONSTRUCTION

MECHANICAL GENERAL INFORMATION

ALL RIGHTS RESERVED

GENERAL HYDRONIC PIPING NOTES:

1. ALL DRAWINGS ARE DIAGRAMMATIC IN NATURE, AND ARE INTENDED TO SHOW THE GENERAL LAYOUT OF SYSTEMS AND EQUIPMENT. THE EXACT LOCATIONS OF EQUIPMENT AND THE FINAL PIPING LAYOUTS ARE THE RESPONSIBILITY OF THE CONTRACTOR, AND SHALL BE FIELD-DETERMINED. COORDINATE WITH THE BUILDING ARCHITECTURE AND STRUCTURE, AND WITH NEW AND EXISTING MECHANICAL AND ELECTRICAL SYSTEMS. WHERE THE LAYOUT DIFFERS SIGNIFICANTLY FROM DESIGN, COORDINATE WITH THE ARCHITECT/ENGINEER. RECORD ALL DIFFERENCES ON RECORD DRAWINGS.

2. PIPING PLANS DO NOT NECESSARILY INDICATE ALL VALVES, GAUGES, UNIONS AND OTHER ACCESSORIES. REFER TO SCHEMATIC DIAGRAMS AND DETAILS FOR ADDITIONAL INFORMATION.

3. INSTALL ALL THERMOSTATS/SPACE TEMPERATURE SENSORS AT 48 INCHES ABOVE FINISHED FLOOR (TO TOP OF SENSOR). WHERE APPLICABLE, ALIGN WITH LIGHT

4. ALL THERMOSTATS AND SENSORS LOCATED ON EXTERIOR WALLS SHALL HAVE

INSULATED BACKPLATES. PACK ALL WALL OPENINGS WITH FIBERGLASS INSULATION. 5. THE CONTRACTOR SHALL EXAMINE THE CONDITION OF ALL EQUIPMENT PRIOR TO

INSTALLATION. DO NOT INSTALL DAMAGED EQUIPMENT. 6. INSTALL PIPING IN A MANNER WHICH ENABLES COMPLETE DRAINAGE OF PIPING AND EQUIPMENT, AND COMPLETE ELIMINATION OF AIR POCKETS. MINIMIZE THE NUMBER OF PIPE RISES AND DROPS. FURNISH AND INSTALL DRAIN VALVES WITH CAPS AT ALL LOW POINTS IN PIPING. FURNISH AND INSTALL MANUAL AIR VENTS AT ALL HIGH

7. REFER TO ARCHITECTURAL CODE COMPLIANCE PLANS FOR THE LOCATIONS OF FIRE/SMOKE RATED ASSEMBLIES.

8. REFER TO SPECIFICATION 23 21 13 FOR THE REQUIREMENTS FOR PIPE PENETRATIONS THROUGH BUILDING ASSEMBLIES.

9. WHERE POSSIBLE, INSTALL VALVES, EQUIPMENT AND DEVICES REQUIRING SERVICE OR MAINTENANCE IN ACCESSIBLE LOCATIONS. WHERE NOT POSSIBLE, PROVIDE ACCESS DOORS, SIZED SUITABLY FOR THE REQUIRED PURPOSE. COORDINATE ACCESS DOOR LOCATIONS AND SIZES WITH THE ARCHITECT/ENGINEER.

10. INSTALL VALVES WITH HANDLES ON TOP OR SIDE.

11. PROVIDE MANUFACTURERS' RECOMMENDED CLEARANCES FOR AIR FLOW, ELECTRICAL AND MAINTENANCE AROUND EQUIPMENT. WHERE CLEARANCES ARE ALSO SHOWN ON THE DRAWINGS, PROVIDE THE MORE STRINGENT OF THE REQUIRED

12. PROVIDE OVERSIZED PIPE HANGERS ON ALL INSULATED HOT AND COLD PIPING. REFER TO SPECIFICATION 23 07 19.

GENERAL HVAC NOTES:

1. ALL DRAWINGS ARE DIAGRAMMATIC IN NATURE, AND ARE INTENDED TO SHOW THE GENERAL LAYOUT OF SYSTEMS AND EQUIPMENT. THE EXACT LOCATIONS OF EQUIPMENT AND THE FINAL DUCTWORK LAYOUTS ARE THE RESPONSIBILITY OF THE CONTRACTOR, AND SHALL BE FIELD-DETERMINED COORDINATE WITH THE BUILDING ARCHITECTURE AND STRUCTURE, AND WITH NEW AND EXISTING MECHANICAL AND ELECTRICAL SYSTEMS. WHERE THE LAYOUT DIFFERS SIGNIFICANTLY FROM DESIGN, COORDINATE WITH THE ARCHITECT/ENGINEER. RECORD ALL DIFFERENCES ON RECORD DRAWINGS.

2. COORDINATE LOCATIONS OF REGISTERS, DIFFUSERS AND GRILLES WITH THE REFLECTED CEILING PLANS. COORDINATE ANY DISCREPANCIES WITH THE ARCHITECT/ENGINEER PRIOR TO INSTALLATION.

3. INSTALL ALL THERMOSTATS/SPACE TEMPERATURE SENSORS AT 48 INCHES ABOVE FINISHED FLOOR (TO TOP OF SENSOR). WHERE APPLICABLE, ALIGN

WITH LIGHT SWITCHES. 4. ALL THERMOSTATS AND SENSORS LOCATED ON EXTERIOR WALLS SHALL

HAVE INSULATED BACKPLATES. 5. WHERE INTERNALLY LINED OR DOUBLE-WALL DUCTWORK IS SHOWN, THE DIMENSIONS SHOWN INDICATE THE REQUIRED INSIDE FREE AREA

6. THE CONTRACTOR SHALL EXAMINE THE CONDITION OF ALL EQUIPMENT PRIOR

7. WHERE CONNECTING NEW DUCTWORK TO EXISTING, SEAL JOINTS AIRTIGHT AND REPAIR DAMAGED INSULATION TO MATCH NEW.

8. WHERE DUCTWORK IS EXPOSED, ROUTE AS HIGH AS PRACTICAL IN THE SPACE UNLESS INDICATED OTHERWISE.

TO INSTALLATION. DO NOT INSTALL DAMAGED EQUIPMENT.

9. REFER TO ARCHITECTURAL CODE COMPLIANCE PLANS FOR THE LOCATIONS OF FIRE/SMOKE RATED ASSEMBLIES.

10. PAINT VISIBLE INTERIOR SURFACES OF DUCTS AT REGISTERS, GRILLES, DIFFUSERS AND LOUVERS FLAT BLACK. 11. WHERE POSSIBLE, INSTALL EQUIPMENT AND DEVICES REQUIRING SERVICE

OR MAINTENANCE IN ACCESSIBLE LOCATIONS. WHERE NOT POSSIBLE.

PROVIDE ACCESS DOORS, SIZED SUITABLY FOR THE REQUIRED PURPOSE. COORDINATE ACCESS DOOR LOCATIONS AND SIZES WITH THE ARCHITECT/ENGINEER. 12. PROVIDE MANUFACTURERS' RECOMMENDED CLEARANCES FOR AIR FLOW,

ELECTRICAL AND MAINTENANCE AROUND EQUIPMENT. WHERE CLEARANCES ARE ALSO SHOWN ON THE DRAWINGS, PROVIDE THE MORE STRINGENT OF THE REQUIRED CLEARANCES.

13. FLEXIBLE DUCTWORK CONNECTIONS TO RIGID DUCTWORK, TO AIR TERMINAL UNITS AND TO REGISTERS, GRILLES AND DIFFUSERS SHALL BE CLAMPED AND TAPED. ROUND CONNECTIONS SHALL HAVE VINYL DRAWBANDS AND TAPE. TAPE SHALL MEET THE REQUIREMENTS OF U.L. 181B-FX.

14. FLEXIBLE DUCTWORK SHALL NOT BE USED ON RETURN AIR OR EXHAUST AIR DUCT SYSTEMS EXCEPT WHERE EXPLICITLY SHOWN ON DRAWINGS.

GENERAL MECHANICAL DEMOLITION NOTES: 1. THE OWNER RESERVES THE RIGHT OF FIRST REFUSAL IN OWNERSHIP OF ANY EQUIPMENT ITEMS AND MATERIALS TO BE REMOVED FROM THE BUILDING AND SITE.

2. ALL MATERIALS AND EQUIPMENT REMOVED AND NOT SALVAGED OR RE-USED SHALL BECOME THE PROPERTY OF THE CONTRACTOR, AND SHALL BE REMOVED FROM THE OWNER 'S PROPERTY AND DISPOSED OF PROPERLY.

3. THE DRAWINGS ARE DIAGRAMMATIC IN NATURE, AND ARE BASED ON THE REVIEW OF PREVIOUS DESIGN DRAWINGS (WHERE AVAILABLE) AND ON LIMITED FIELD INVESTIGATION. THE CONTRACTOR IS RESPONSIBLE TO INVESTIGATE THE BUILDING AND SITE TO DETERMINE THE FULL EXTENT OF DEMOLITION WORK REQUIRED. THE CONTRACTOR SHALL FIELD-VERIFY

THE ACTUAL LOCATIONS AND SIZES OF EXISTING DUCTWORK, PIPING AND EQUIPMENT. WHERE DISCREPANCIES BETWEEN THE DRAWINGS AND THE EXISTING CONDITIONS RESULT IN AN UNCLEAR DEMOLITION SCOPE, COORDINATE WITH THE ARCHITECT/ENGINEER. 4. WHERE DEMOLITION OF MATERIALS OR EQUIPMENT IS REQUIRED, REMOVE ALL RELATED SUPPORTS, ACCESSORIES, LOW-VOLTAGE WIRING, PNEUMATIC TUBING AND CONTROLS

(CONCEALED OR EXPOSED). REMOVE WIRING TO THE NEAREST JUNCTION BOX, AND PNEUMATIC TUBING TO THE NEAREST MAIN. WHERE A PNEUMATIC CONTROL SYSTEM IS TO REMAIN ACTIVE, CAP AND SEAL TUBING AT MAINS. 5. ALL PIPING, DUCTWORK AND EQUIPMENT SHOWN CROSS-HATCHED OR BOLD DASHED SHALL

BE REMOVED OR RELOCATED UNLESS OTHERWISE NOTED. 6. VERIFY LOCATION AND PROTECT EXISTING WORK AND UTILITIES WHICH ARE TO REMAIN IN PLACE WITH TEMPORARY COVERS, SHORING, BRACING AND SUPPORTS.

7. ALL MATERIALS AND EQUIPMENT REQUIRING REMOVAL AND REINSTALLATION FOR RE-USE SHALL BE CAREFULLY REMOVED AND STORED TO PREVENT DAMAGE. THE CONTRACTOR IS RESPONSIBLE FOR LOSS OF OR DAMAGE TO STORED MATERIALS AND EQUIPMENT.

8. WHERE ON-SITE STORAGE OF MATERIAL AND EQUIPMENT IS PERMITTED, COORDINATE STORAGE LOCATION(S) WITH THE OWNER.

9. PROTECT THE BUILDING STRUCTURE AND FINISHES AND ALL BUILDING SYSTEMS DURING DEMOLITION. THE CONTRACTOR IS RESPONSIBLE FOR ANY DAMAGES INCURRED AS A RESULT OF DEMOLITION WORK. 10. UNLESS ASSIGNED TO ANOTHER TRADE, PATCH AND REPAIR ALL WALL, FLOOR AND CEILING

OPENINGS DUE TO DEMOLITION WHICH ARE NOT TO BE RE-USED. MATCH EXISTING

SURROUNDING CONSTRUCTION, FINISHES, COLORS AND FIRE/SMOKE RATINGS. 11. UNLESS ASSIGNED TO ANOTHER TRADE, PATCH AND REPAIR ROOF IN A MANNER WHICH WILL MAINTAIN THE WATER-TIGHT INTEGRITY OF THE ROOF. WHERE A ROOF WARRANTY EXISTS, PERFORM THE WORK IN A MANNER WHICH WILL MAINTAIN THE WARRANTY.

12. IF MATERIALS SUSPECTED OF CONTAINING ASBESTOS ARE ENCOUNTERED, NOTIFY THE OWNER IMMEDIATELY. WHERE REMOVAL OR ENCAPSULATION IS REQUIRED, SUCH WORK WILL BE PERFORMED BY THE OWNER UNDER A SEPARATE CONTRACT.

GENERAL INST	RUMENT SYMBOLS
	LOCAL DEVICE
TR	(TR - TREND) BMS CONTROL POINT / FUNCTION (AL - ALARM)
	AVERAGING TEMPERATURE ELEMENT
	AIR FLOW TRANSMITTER
	OPPOSED BLADE DAMPER
	PARALLEL BLADE DAMPER
	BLADE DAMPER
C	AIR COIL
	FAN
	FILTER
	PUMP

LO	CAL DEVICE ABBREVIATIONS
CO2	CARBON DIOXIDE LEVEL TRANSMITTER
CO	CARBON MONOXIDE LEVEL TRANSMITTER
ECM	ELECTRICALLY COMMUTATED MOTOR
FSH	FLOW SWITCH HIGH
FSL	FLOW SWITCH LOW
FT	FLOW TRANSMITTER
GCV	GAS CONTROL VALVE
HS	HAND SWITCH (HAND-OFF-AUTO)
НТ	HUMIDITY TRANSMITTER
HTG	HEATING ELEMENT
IS	ION SENSOR
KC	TIME CLOCK CONTROLLING EQPM SCHEDULE
LSL	LEVEL SWITCH LOW
LSH	LEVEL SWITCH HIGH
LT	LEVEL TRANSMITTER
M	MOTOR
MD	MOTORIZED CONTROL DAMPER
occ	OCCUPANCY SENSOR
PDT	PRESSURE DIFFERENTIAL TRANSMITTER
PDS	PRESSURE DIFFERENTIAL SWITCH
PKG	PACKAGED EQUIPMENT CONTROLLER
PSH	PRESSURE SWITCH HIGH
PSL	PRESSURE SWITCH LOW
PT	PRESSURE TRANSMITTER
SD	SMOKE DETECTOR
SNW	SNOW/ICE SENSOR
TCV	TEMPERATURE CONTROL VALVE
TSL	TEMPERATURE SWITCH LOW (FREEZESTAT)
TSH	TEMPERATURE SWITCH HIGH
TT	TEMPERATURE TRANSMITTER
VCC	VARIABLE CAPACITY COMPRESSOR

VARIABLE FREQUENCY DRIVE

S POINT ABBREVIATION	ONS
GENERAL ALARM / ALARM L	OW LIMIT
ANALOG INPUT	
ANALOG OUTPUT	
EQUIPMENT CAPACITY SIGN	NAL
CARBON DIOXIDE LEVEL	
CARBON MONOXIDE LEVEL	
DIGITAL INPUT	
DIGITAL OUTPUT	
EQUIPMENT ENABLE	
EMERGENCY SWITCH	
FLOW INDICATE	
HUMIDITY INDICATE	
ION INDICATE	
LEVEL INDICATE	
NITROGEN DIOXIDE LEVEL	
OPEN/CLOSE (2-POS DAMPE	ER OR VALVE)
OCCUPIED/UNOCCUPIED IN	DICATE
POSITION CONTROL (MODU OR VALVE)	LATING DAMPER
PRESSURE INDICATE	
SPEED CONTROL	
SMOKE DETECTOR	
STATUS INDICATE	
SNOW/ICE INDICATE	
START/STOP	
SETPOINT SIGNAL	
TEMPERATURE INDICATE	

WATER INDICATE

POSITION INDICATE

MECHANICAL LINE SERVICE DESIGNATI	ONS	MECHA	NICAL ABBREVIATIONS
BFW BOILER FEED WATER CDGR CONDENSER GLYCOL RETURN CDGS CONDENSER GLYCOL SUPPLY CHGR CHILLED GLYCOL RETURN CHGS CHILLED GLYCOL SUPPLY CHWR CHILLED WATER RETURN CHWS CHILLED WATER SUPPLY CTWR COOLING TOWER WATER RETURN CTWS COOLING TOWER WATER SUPPLY G NATURAL GAS GTWR GEOTHERMAL WATER SUPPLY HGR HOT GLYCOL RETURN HGS HOT GLYCOL SUPPLY HPCR HIGH PRESSURE CONDENSATE RETURN HPWR HEAT PUMP WATER SUPPLY HWR HOT WATER SUPPLY (HEATING) HWS HOT WATER SUPPLY (HEATING) LPS LOW PRESSURE STEAM MPCR MEDIUM PRESSURE STEAM MPCR MEDIUM PRESSURE STEAM MPCR MEDIUM PRESSURE STEAM MPCR MEDIUM PRESSURE CONDENSATE RETURN RWS RADIANT WATER RETURN RWS RADIANT WATER SUPPLY SPWR SWIMMING POOL WATER RETURN SPWS SWIMMING POOL WATER SUPPLY SMR SNOWMELT RETURN SMS SNOWMELT SUPPLY		AFF AHU BCU BOD BOG BOP BOS CLG CONV CONT CONV CUH DN DW DWG EA ETT ERU ETT ERU ETT ERU ETT ERU MFR MAU MFR MAX MIN	ABOVE FINISHED FLOOR AIR HANDLING UNIT BLOWER COIL UNIT BOTTOM OF DUCT BOTTOM OF GRILLE BOTTOM OF STRUCTURE CEILING CLEAN-OUT CONNECTION CONTINUATION CONVECTOR CABINET UNIT HEATER DOWN DOUBLE WALL DRAWING EXHAUST AIR ELECTRONICALLY COMMUTATED MOTEXHAUST FAN EXISTING TO REMAIN EXPANSION TANK ENERGY RECOVERY UNIT EXISTING FAN COIL UNIT FLOOR MAKE-UP AIR UNIT MANUFACTURER MAXIMUM MINIMUM
PCR PUMPED CONDENSATE RETURN V VENT		DA RA RTU SA SPECS. FOD FOG FOP FOS FYP JH JNO //TR	OUTSIDE AIR RETURN AIR ROOF TOP UNIT SUPPLY AIR SPECIFICATIONS TOP OF DUCT TOP OF GRILLE TOP OF PIPE TOP OF STRUCTURE TYPICAL UNIT HEATER UNLESS NOTED OTHERWISE VOLUME DAMPER
	1	JNO	UNLESS NOTED OTHERW

	HVAC SYMBOLS
T S	THERMOSTAT / SENSOR
T	RADIANT FLOOR THERMOSTAT
H	HUMIDISTAT
(CO ₂)	CARBON DIOXIDE SENSOR
-\\\\\\	PARALLEL BLADE DAMPER
→	OPPOSED BLADE DAMPER
M	MOTOR OPERATED DAMPER
III	VOLUME DAMPER
-•	FIRE DAMPER (THRU FLOOR)
	FIRE DAMPER (THRU WALL)
→ SD	SMOKE DAMPER (THRU FLOOR)
→ sd	SMOKE DAMPER (THRU WALL)
♦ _{F/S}	COMBINATION FIRE/SMOKE DAMPER (THRU FLOOR)
√ _{F/S}	COMBINATION FIRE/SMOKE DAMPER (THRU WALL)
SD	DUCT SMOKE DETECTOR
	CONNECT TO EXISTING

H\	/AC SHEETMETAL SYMBOLS
	DUCTWORK / DIFFUSER DEMOLITION
OR [min]	MITERED ELBOW (RECTANGULAR, ROUND & OVAL) TURNING VANES REQUIRED PER SPECIFICATIONS
	RECTANGULAR DUCTWORK RISE
	RECTANGULAR DUCTWORK DROP
•	ROUND DUCTWORK RISE
	ROUND DUCTWORK DROP
X"xX" SA	RECTANGULAR DUCTWORK
X"ø SA	ROUND DUCTWORK
X"/X"ø SA	OVAL DUCTWORK
X"xX" DW SA	DOUBLE WALL DUCTWORK
X"xX" LINED SA	LINED DUCTWORK
R	DUCTWORK RISE SYMBOL
D	DUCTWORK DROP SYMBOL
000000000	FLEXIBLE DUCTWORK (SUPPLY)
\boxtimes	SUPPLY DIFFUSER (S-X)
	RETURN GRILLE (R-X)
	EXHAUST GRILLE (E-X)
	LINEAR SLOT DIFFUSER (S-X)
	SIDEWALL DIFFUSER OR GRILLE
	RECTANGULAR OR ROUND MANUAL DAMPER
M	RECTANGULAR OR ROUND MOTORIZED DAMPER
F/S F/S	RECTANGULAR OR ROUND FIRE / SMOKE DAMPER
	RECTANGULAR OR ROUND FIRE DAMPER
	VAV TERMINAL BOX

PIPIN	NG & INSTR. SYMBOLS
	ECCENTRIC REDUCER
\triangleright	CONCENTRIC REDUCER
T	GENERAL / THERMODYNAMIC TRAP
T	INVERTED BUCKET TRAP
SD	SUCTION DIFFUSER
ılı	UNION
 	FLEXIBLE CONNECTOR
	CAP
	BLIND FLANGE
1 7975	"Y" STRAINER W/ BLOWDOWN
Ü	AIR VENT
F	COMPRESSED AIR COMB. FILTER, REG. & OILER
FS	FLOW SWITCH
PS	PRESSURE SWITCH
PT O	PRESSURE TAP
(<u>M</u>)—0	THERMOWELL
<u>a</u> +xx+	PRESSURE GAUGE & SHUT OFF
<u>a</u> otal-	PRESSURE GAUGE W/ SIPHON
Ţ Ţ	THERMOMETER
	EMERGENCY EYE WASH / SHOWER
×	ANCHOR
=	GUIDE
	HIGH CAPACITY AIR VENT
	FLOAT & THERMOSTATIC TRAP

V	ALVE SYMBOLS
\bowtie	GATE VALVE
	BALL VALVE
	GLOBE VALVE
`•	BUTTERFLY VALVE
	CHECK VALVE
	SWING CHECK VALVE
	TRIPLE-DUTY VALVE
ıŢı	PLUG VALVE
	DIAPHRAGM VALVE
>	NEEDLE VALVE
	ANGLE VALVE
	PRESSURE REDUCING VALVE, SELF- CONTAINED
	EXT. PRESSURE REDUCING VALVE
Ţ.	RELIEF / SAFETY VALVE
	HOSE BIBB
S	SOLENOID VALVE
	CALIBRATED BALANCING VALVE
	TEMPERATURE CONTROL VALVE
	CONTROL VALVE, 3-WAY
	BACKFLOW PREVENTER WITH DRIP PAN
ŢŢ	AUTOMATIC FLOW CONTROL VALVE
•	CONNECT TO EXISTING
	INDICATES VALVE IS FLANGED (TYP)

MECHANICAL DEMO KEYNOTE LEGEND

SUPPORTS, FANS COMPLETE. REUSE AND MODIFY EXISTING WALL OPENING FOR NEW EXHAUST FAN INSTALLATION.

DEMOLISH EXISTING CABINET UNIT HEATER AND ASSOCIATE PIPING CONNECTIONS. PREP FOR NEW WORK.

DEMOLISH EXISTING FTR AND BRANCH PIPING TO ABOVE

D05 DEMOLISH EXISTING EF AND ALL ASSOCIATED HVAC AND CONTROLS. PATCH EXTERIOR WALL COMPLETE TO MATCH

DEMOLISH EXISTING EXHAUST AIR DUCT, HANGERS,


CEILING. CAP AND PREP FOR NEW WORK. DO4 EXISTING CABINET UNIT HEATER TO REMAIN.

REVIEWED LDE NO PART OF THIS DRAWING MAY BE USED OR REPRODUCED IN ANY FORM OR BY ANY MEANS, OR STORED IN A DATA BASE OR RETRIEVAL SYSTEM, WITHOUT PRIOR WRITTEN

ALL RIGHTS RESERVED UNIT 'A' FIRST FLOOR MECHANICAL DEMOLITION PLAN

GMB COPYRIGHT © 2025

M1.01A

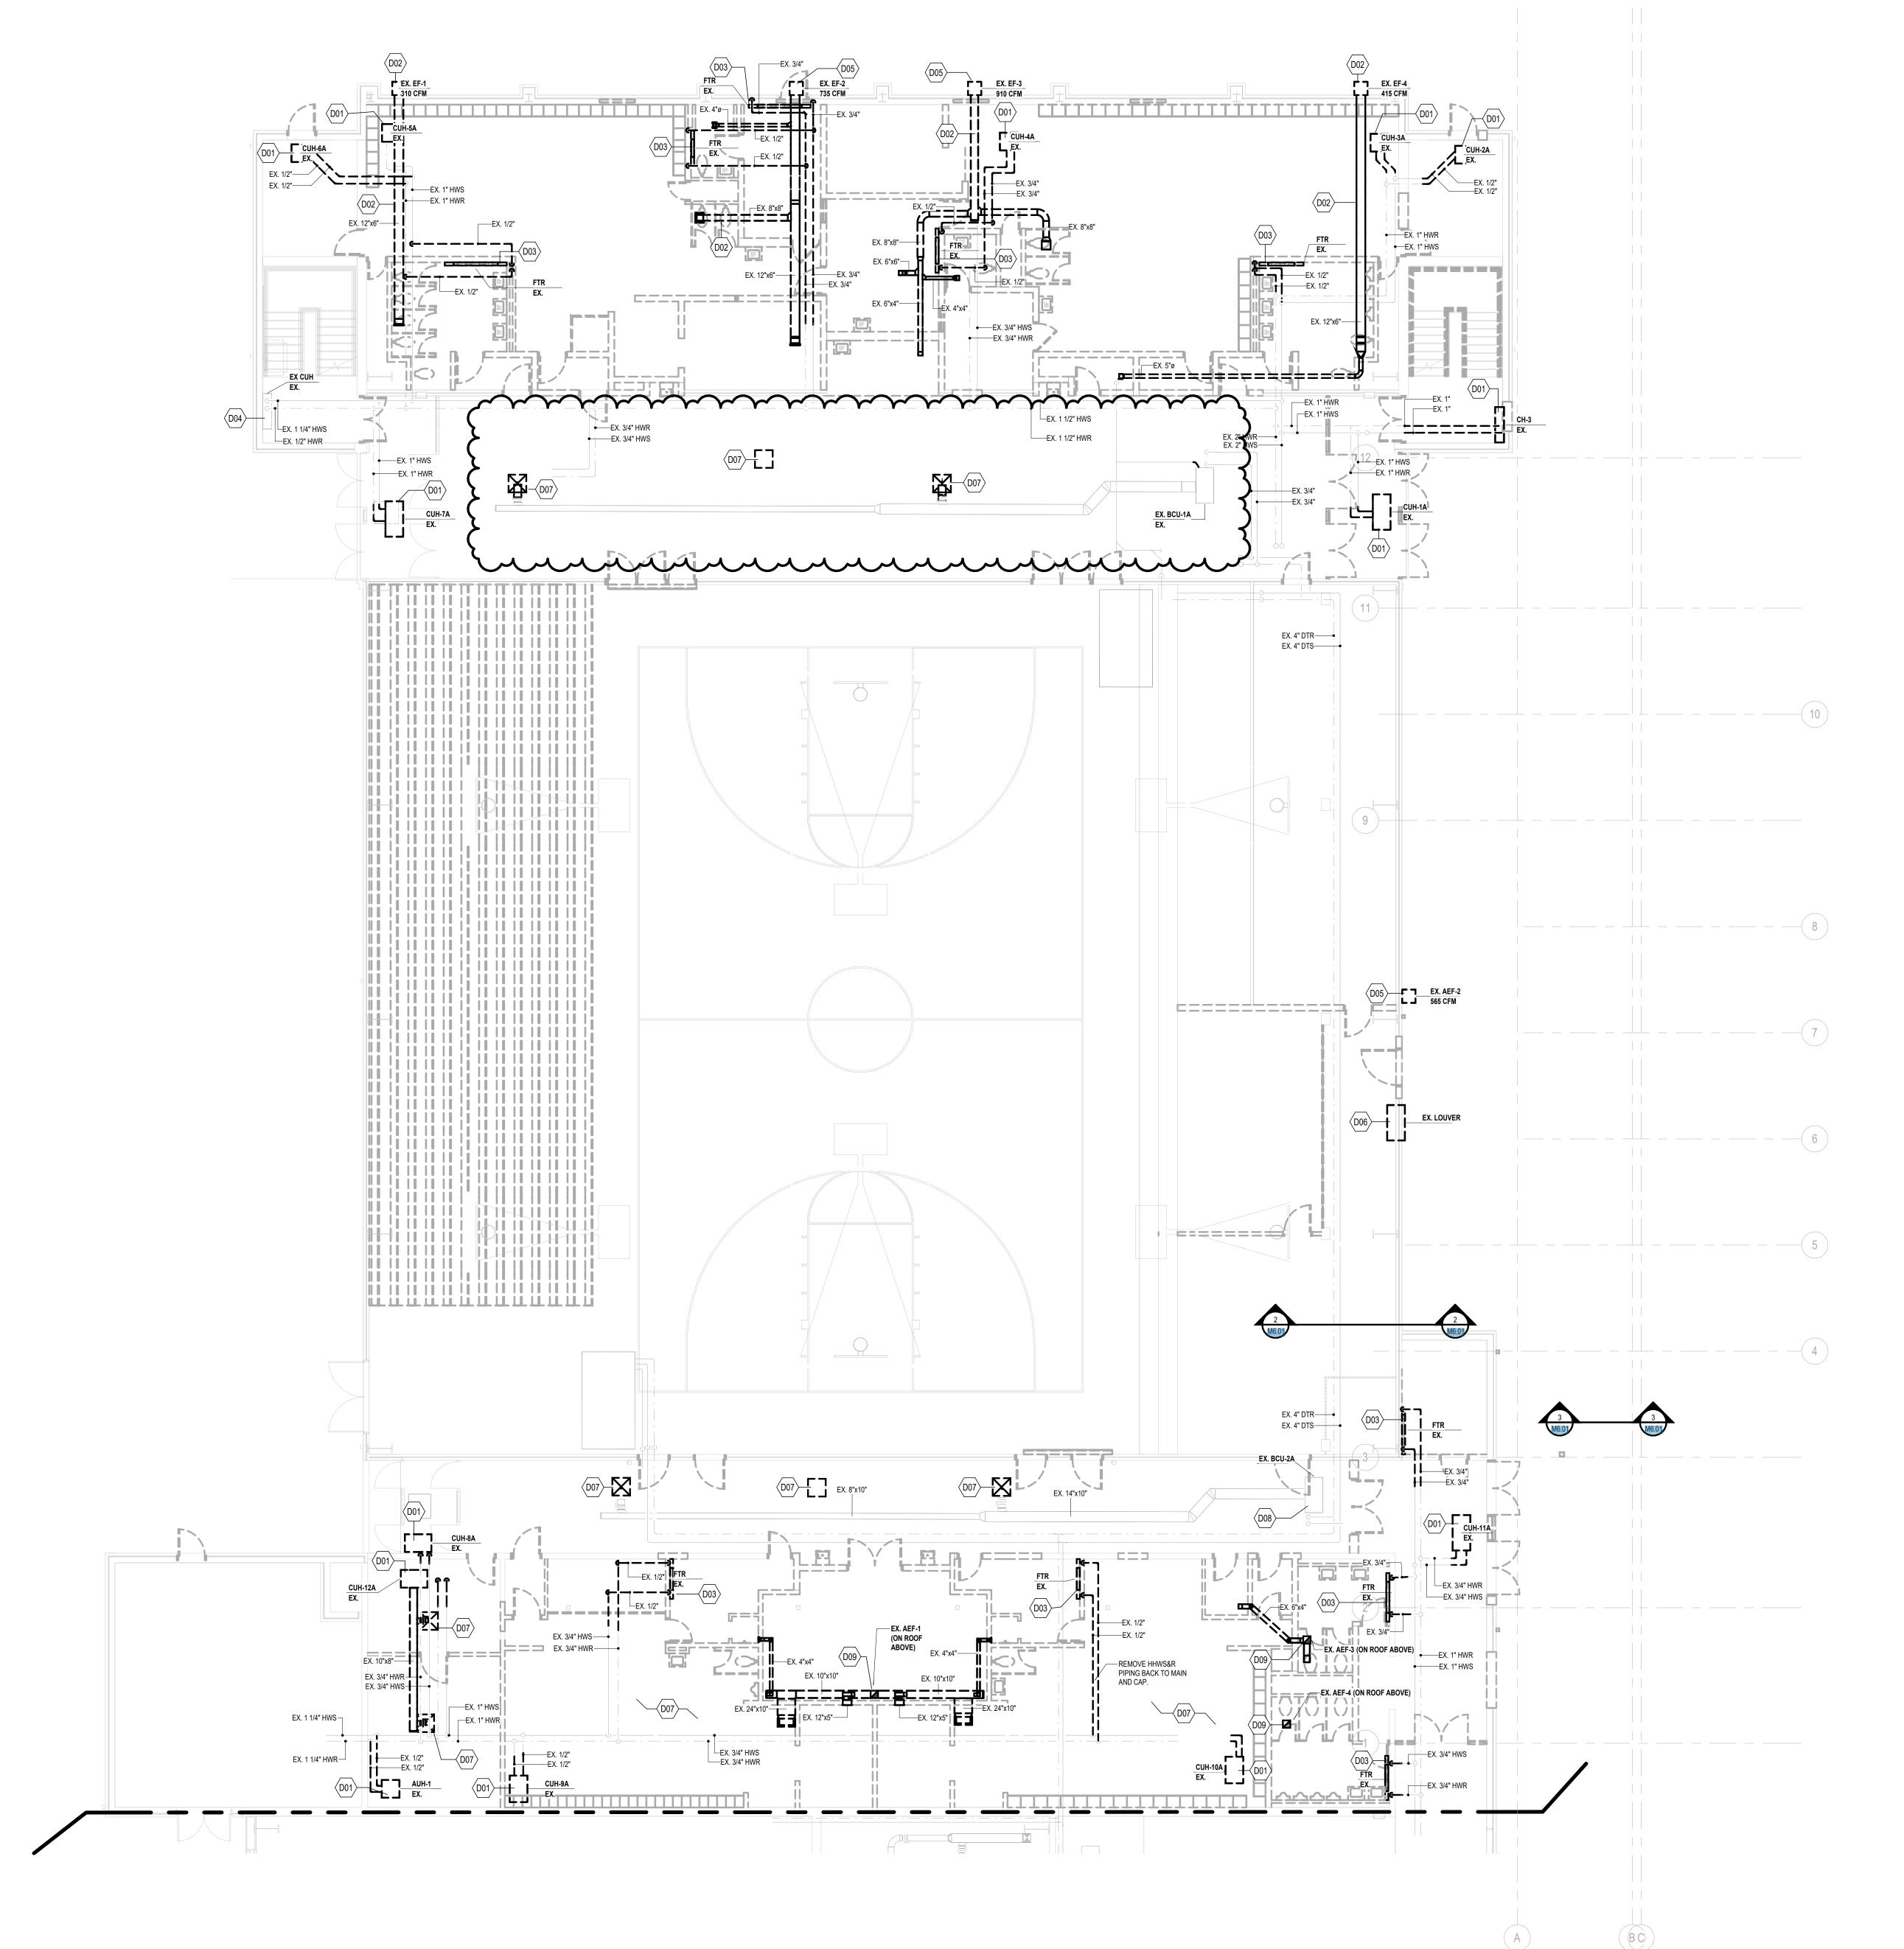

03.24.2025 BULLETIN 002


PROJECT NO. 5-6394

NO PART OF THIS DRAWING MAY BE USED OR REPRODUCED IN ANY FORM OR BY ANY MEANS, OR STORED IN A DATA BASE OR RETRIEVAL SYSTEM, WITHOUT PRIOR WRITTEN PERMISSION OF

GMB COPYRIGHT © 2025
ALL RIGHTS RESERVED


UNIT 'A' FIRST FLOOR HVAC
PLAN

M2.1A

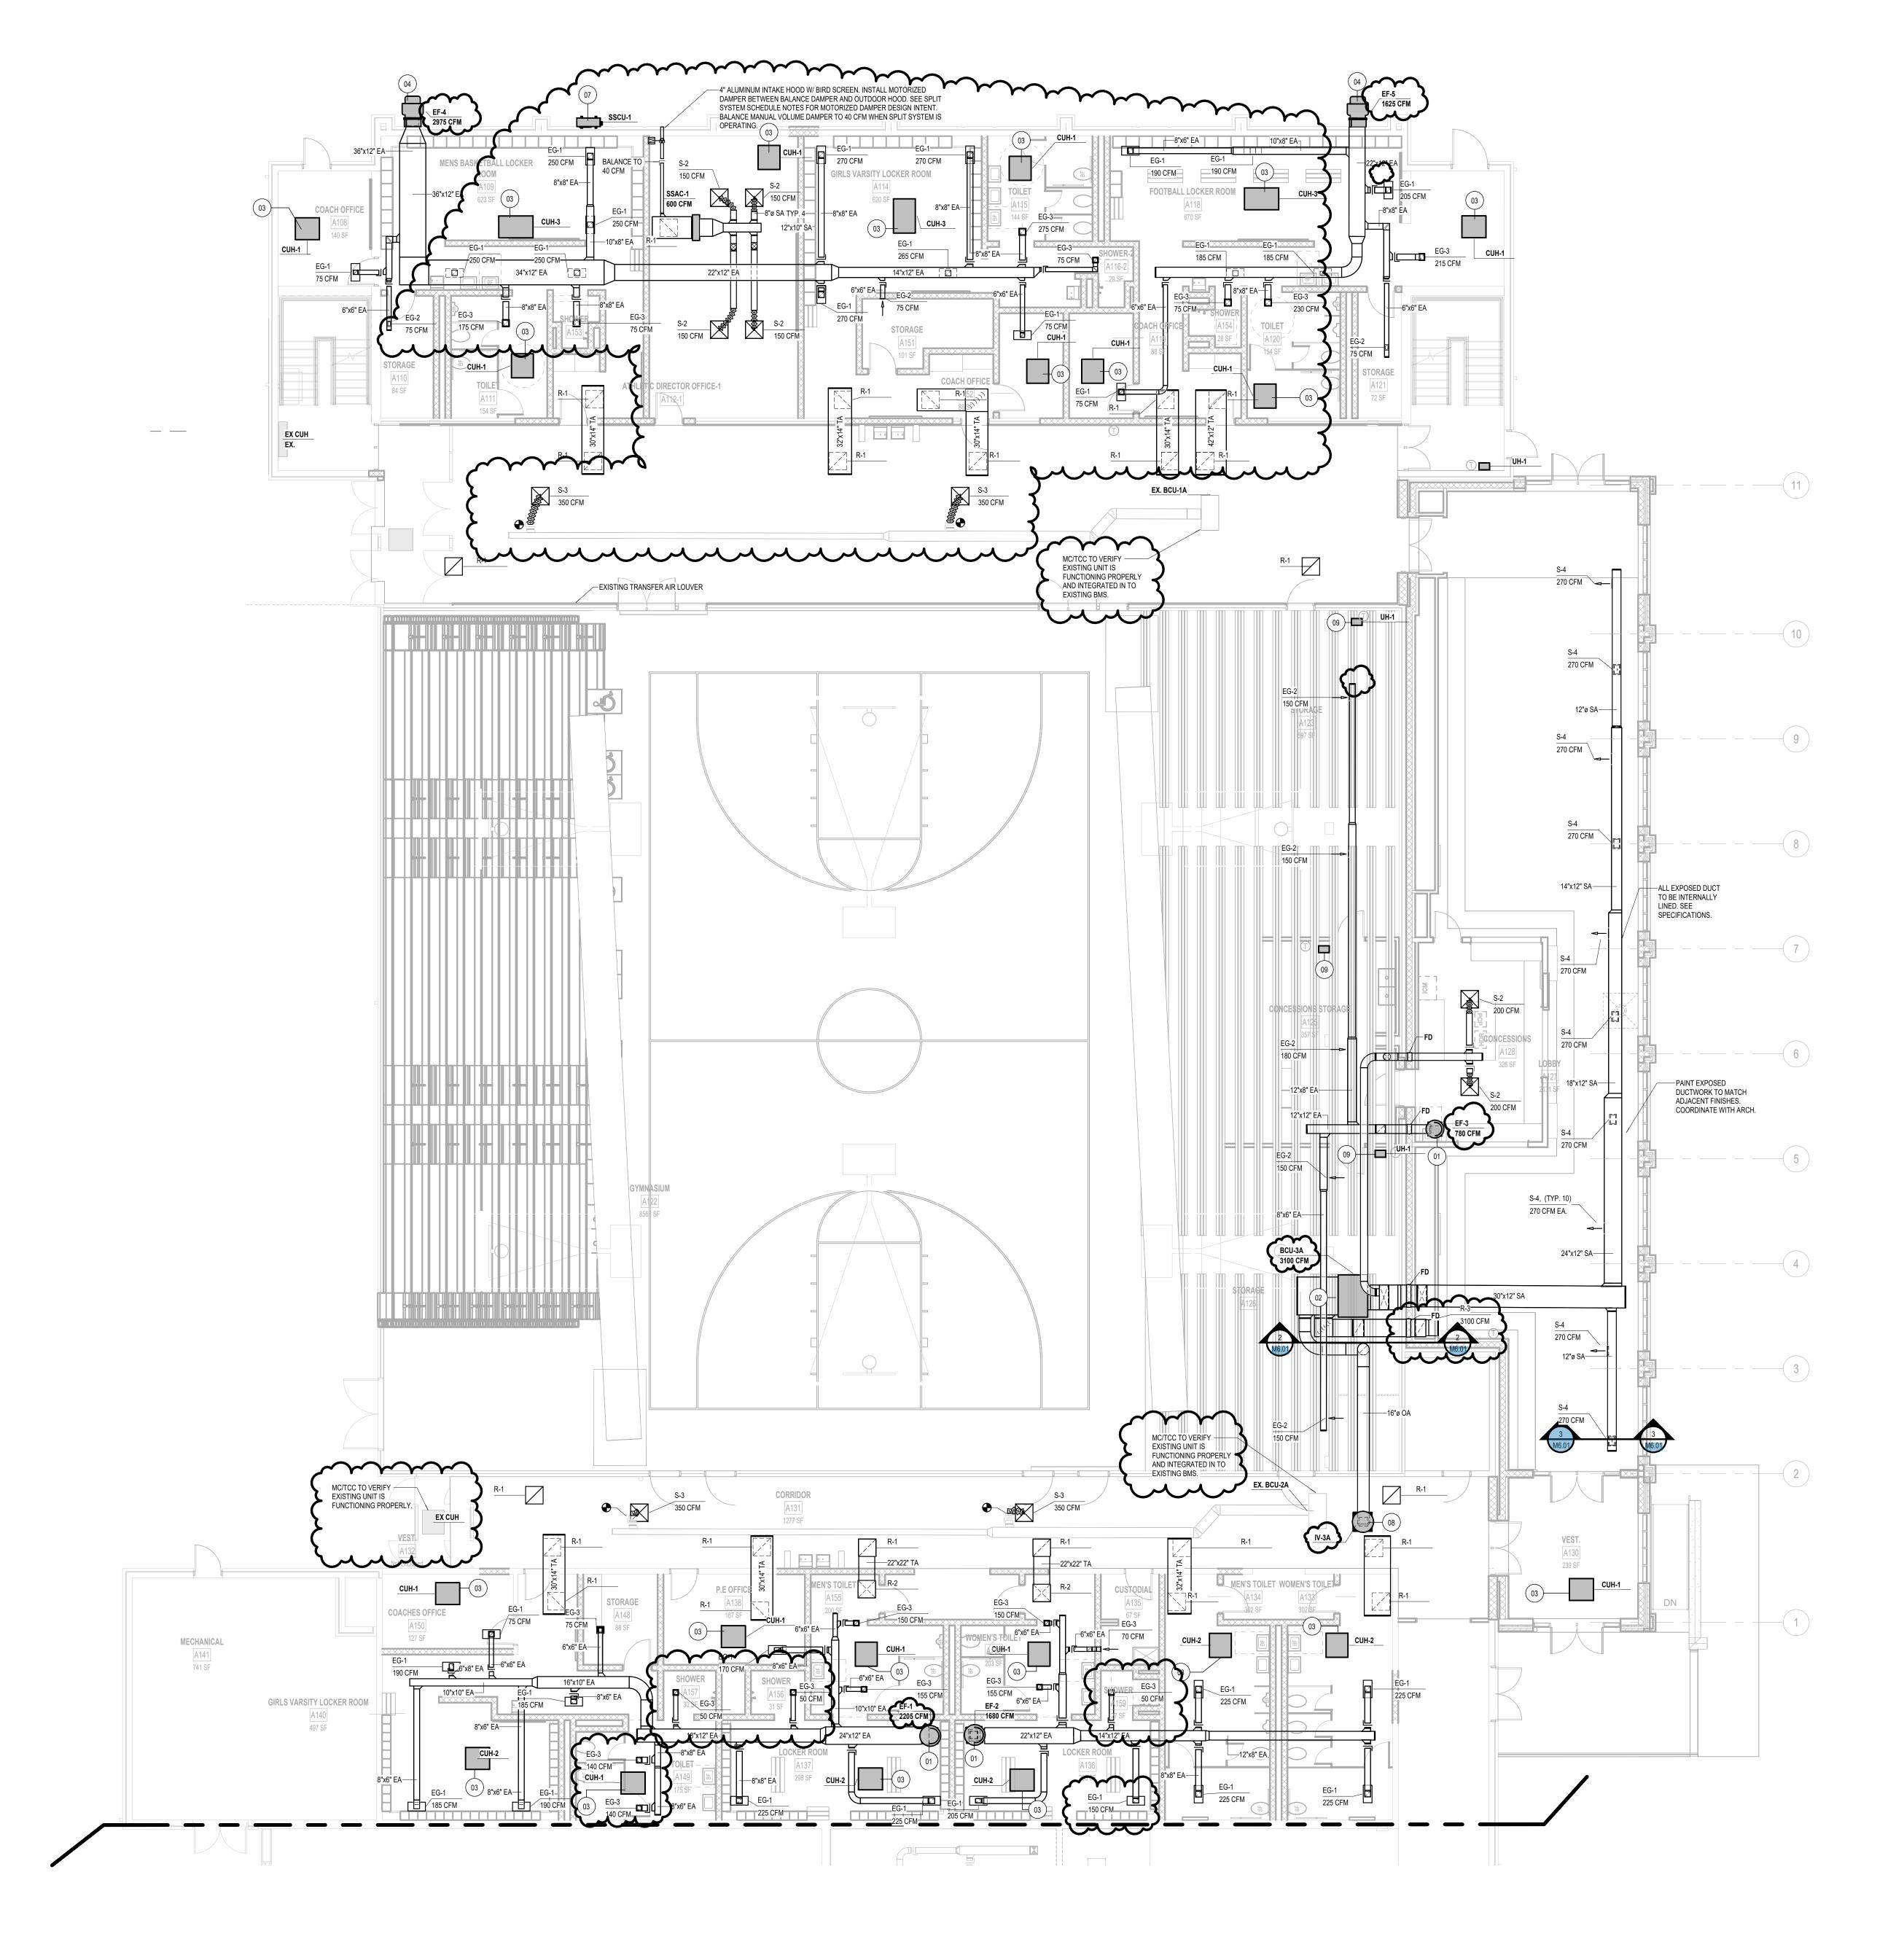

GMB COPYRIGHT © 2025 ALL RIGHTS RESERVED UNIT 'A' FIRST FLOOR HYDRONIC PLAN

M3.1A

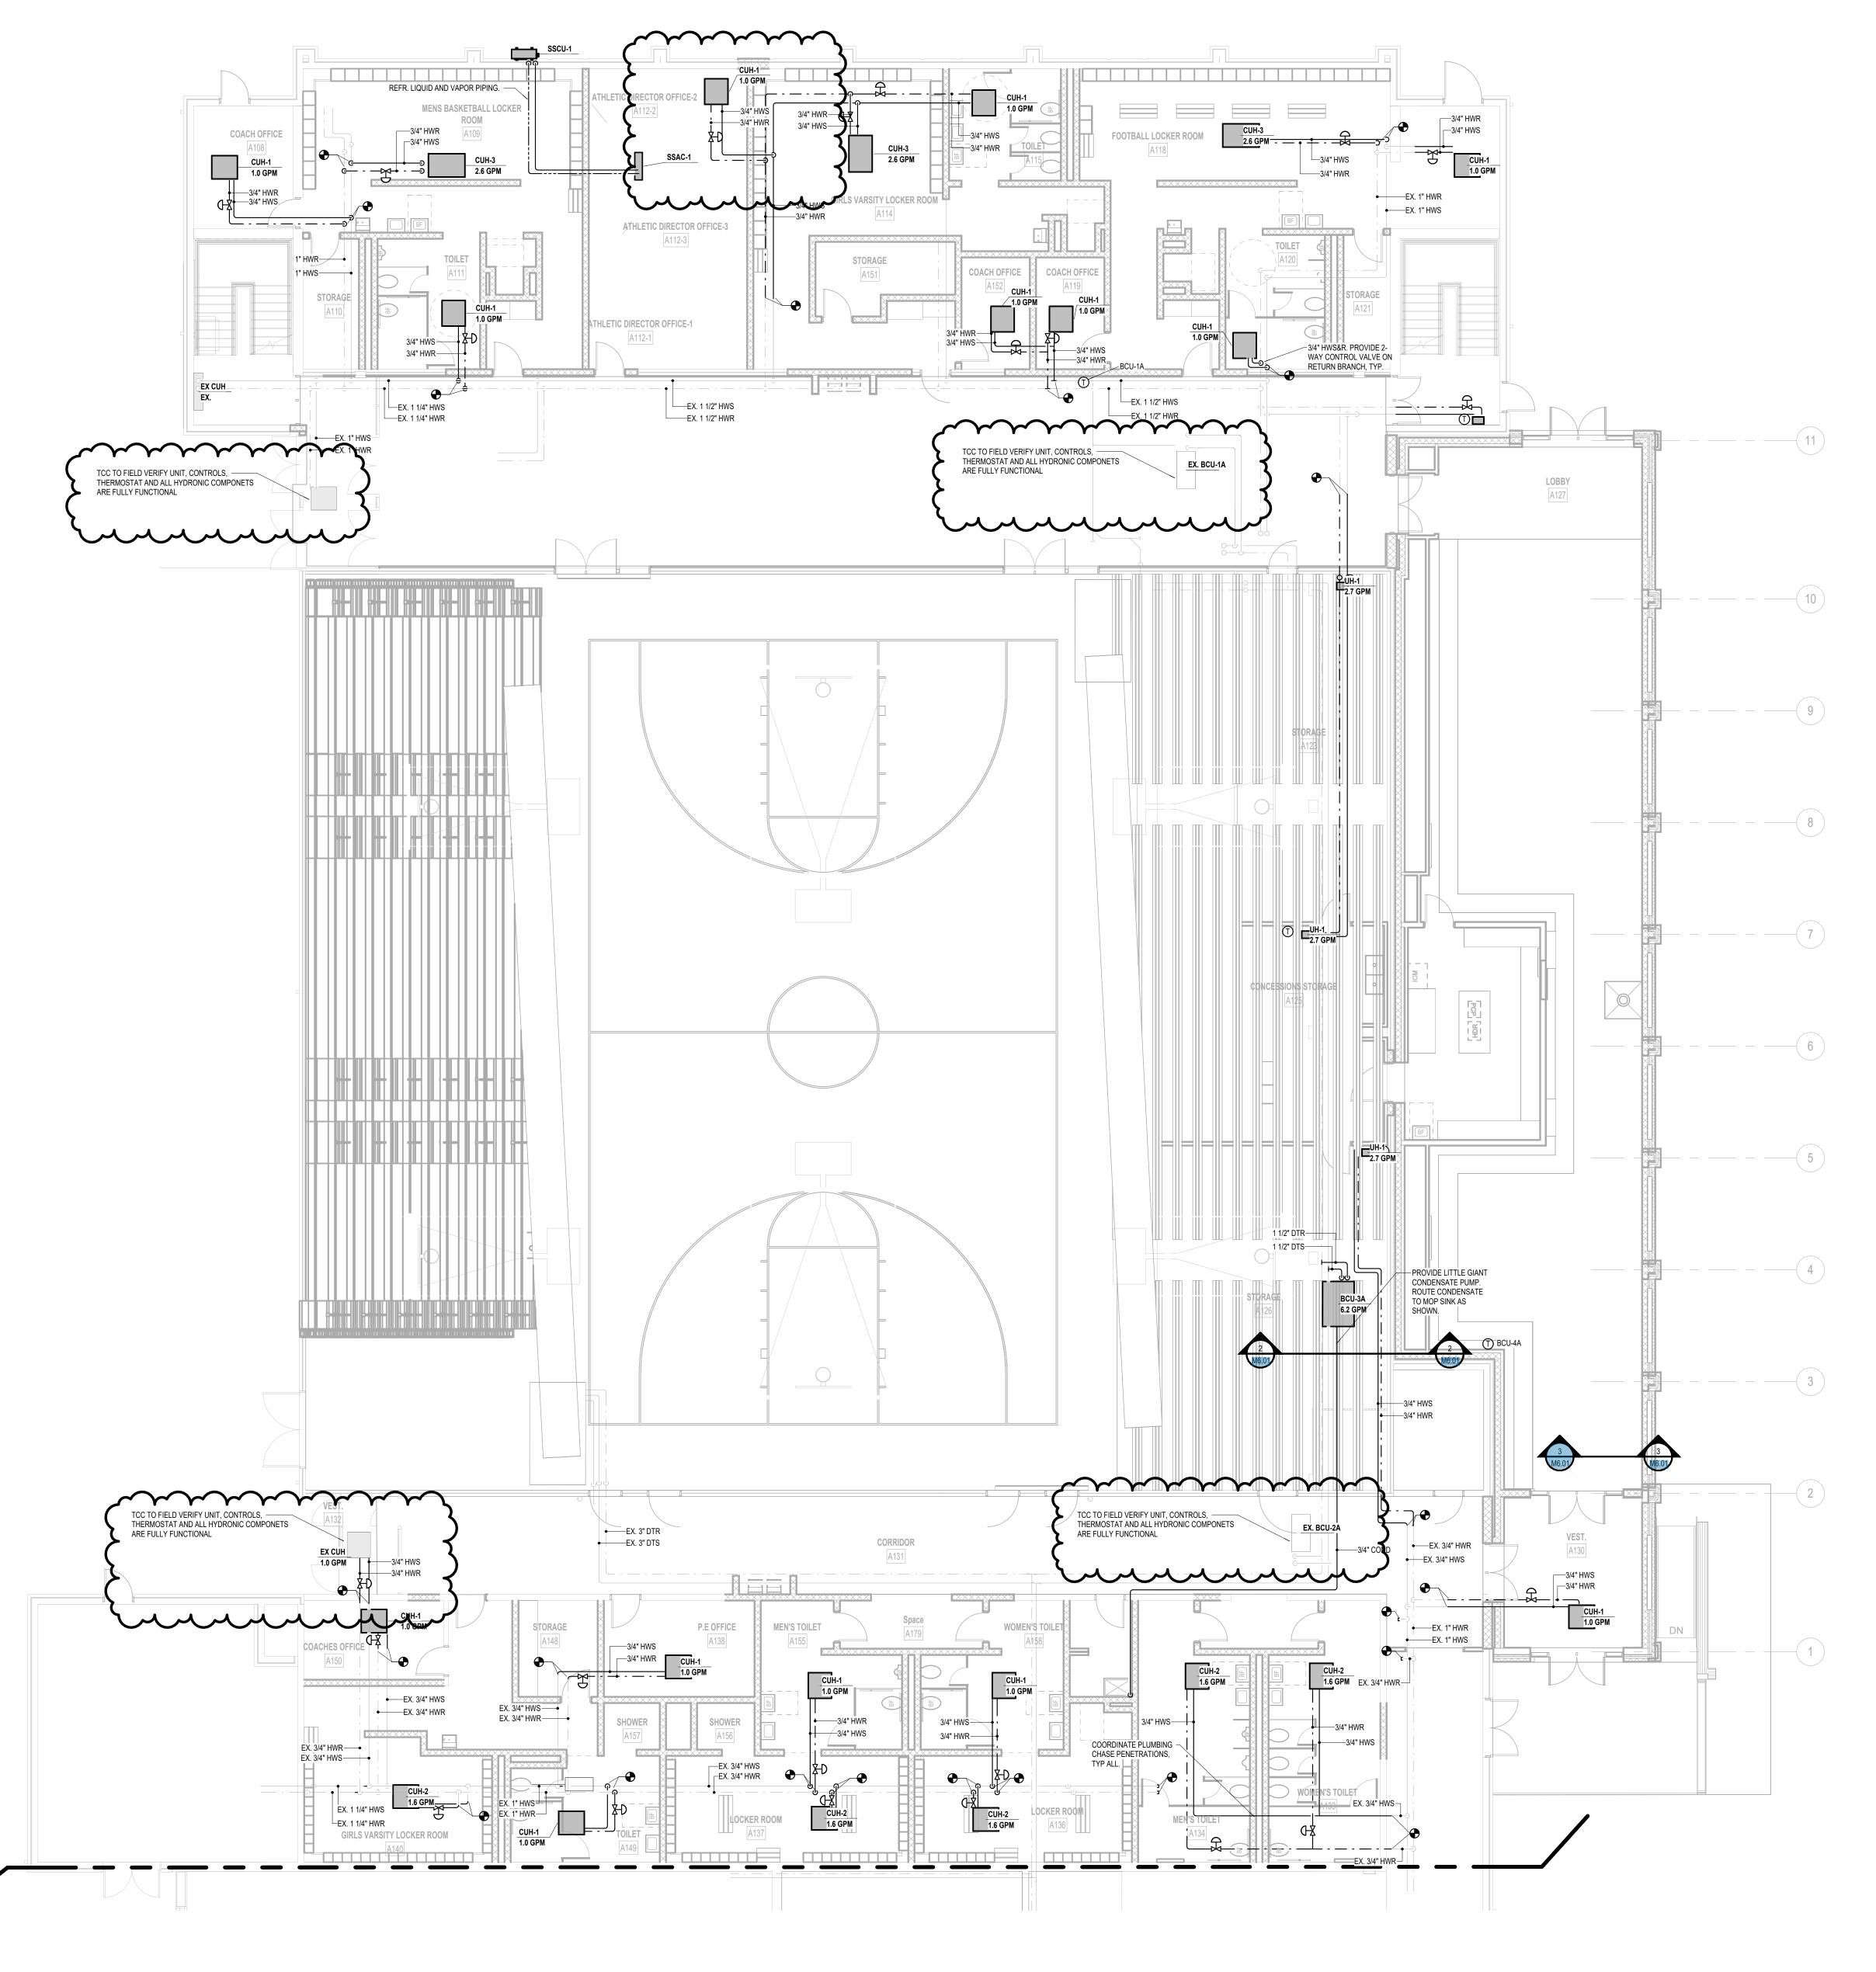


NO PART OF THIS DRAWING MAY BE USED OR REPRODUCED IN ANY FORM OR BY ANY MEANS, OR STORED IN A
DATA BASE OR RETRIEVAL SYSTEM,
WITHOUT PRIOR WRITTEN
PERMISSION OF GMB COPYRIGHT © 2025 ALL RIGHTS RESERVED


MECHANICAL SECTIONS


M6.01


SECURE DUCTWORK AS HIGH AS
POSSIBLE. SUPPORT FROM
STRUCTURE ABOVE. DUCT
MOUNTED DIFFUSERS SHALL BE
INSTALLED IN ORIENTATION
SHOWN.

CANOPY SOUTH
112'-0" MECHANICAL SECTION - LOBBY A127

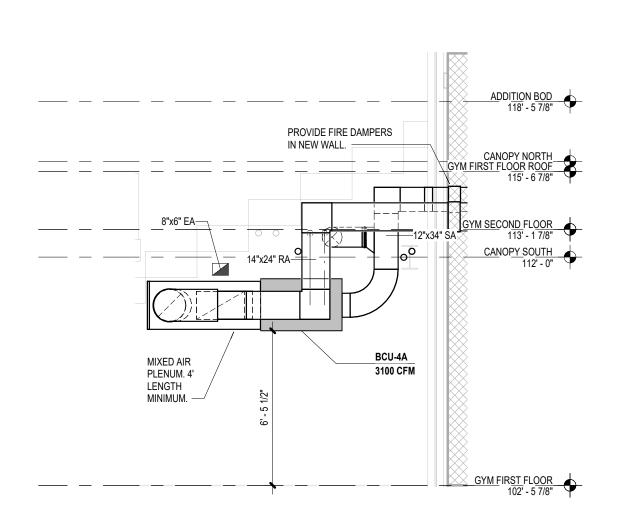

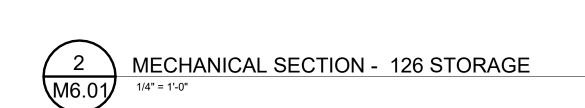

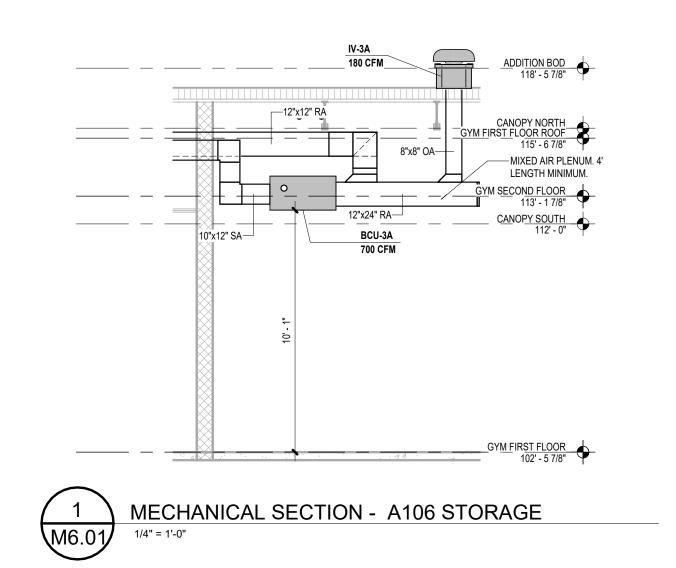

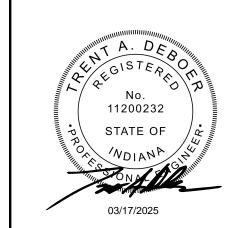

ISSUANCES 01.06.2025 BIDS & CONSTRUCTION


DRAWN GSH REVIEWED LDE

5-6394 PROJECT NO. NO PART OF THIS DRAWING MAY BE USED OR REPRODUCED IN ANY FORM OR BY ANY MEANS, OR STORED IN A DATA BASE OR RETRIEVAL SYSTEM, WITHOUT PRIOR WRITTEN PERMISSION OF GMB COPYRIGHT © 2025 ALL RIGHTS RESERVED


MECHANICAL DETAILS

M7.01


-EXHAUST FAN (REFER TO EQUIPMENT SCHEDULE) ROOF FRAMING BY OTHERS, REFER TO STRUCTURAL PREFAB ROOF CURB BY MECHANICAL CONTRACTOR. DRAWINGS, TYP. FLASH WATERTIGHT INTO ROOF. -PROVIDE SHEET METAL CLOSURE OF GAPS. - DUCT FULL SIZE OF ROOF OPENING. MOTORIZED SHUTTER COUNTER -BALANCED BACKDRAFT DAMPER. MOUNT AT BOTTOM OF ROOF DECK. —ACCESS PANEL TO DAMPER - -SEE PLANS FOR DUCT SIZES & ARRANGEMENTS. PROVIDE ACOUSTICAL SEAL DUCT WITH -LINER WHERE NOTED ON PLANS. SILICONE SEALANT. — FLEXIBLE CONNECTION, TYP. NOTE: INSTALL DRIP PAN BELOW UNDUCTED FANS. 2" TURNUP EDGES, OVERLAP FAN ROOF OPENING 6" ON ALL SIDES. SEAL JOINTS WITH SILICONE SEALANT. ROOF EXHAUST FAN DETAIL

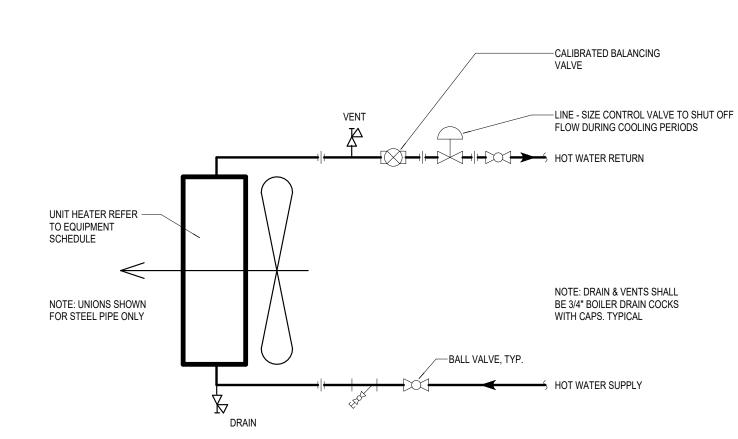

HOT WATER UNIT HEATER DETAIL (WITH CONTROL VALVE)

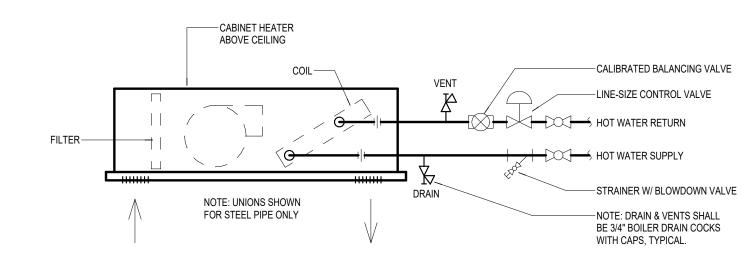


HOT WATER CABINET HEATER PIPING - HORIZONTAL
NOT TO SCALE

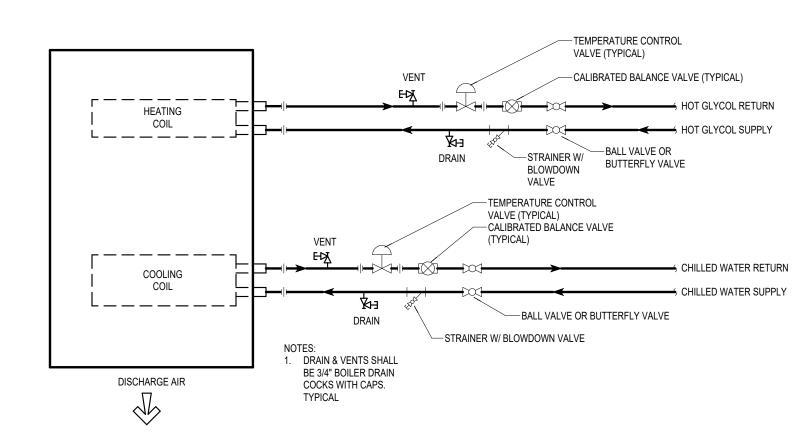



FAN OR BLOWER COIL PIPING DETAIL (2-WAY VALVE)

NOT TO SCALE

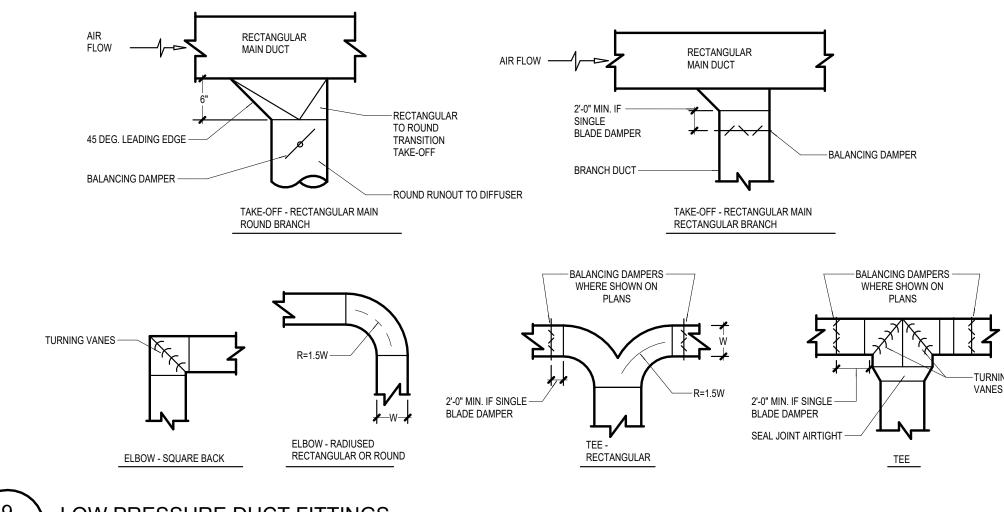




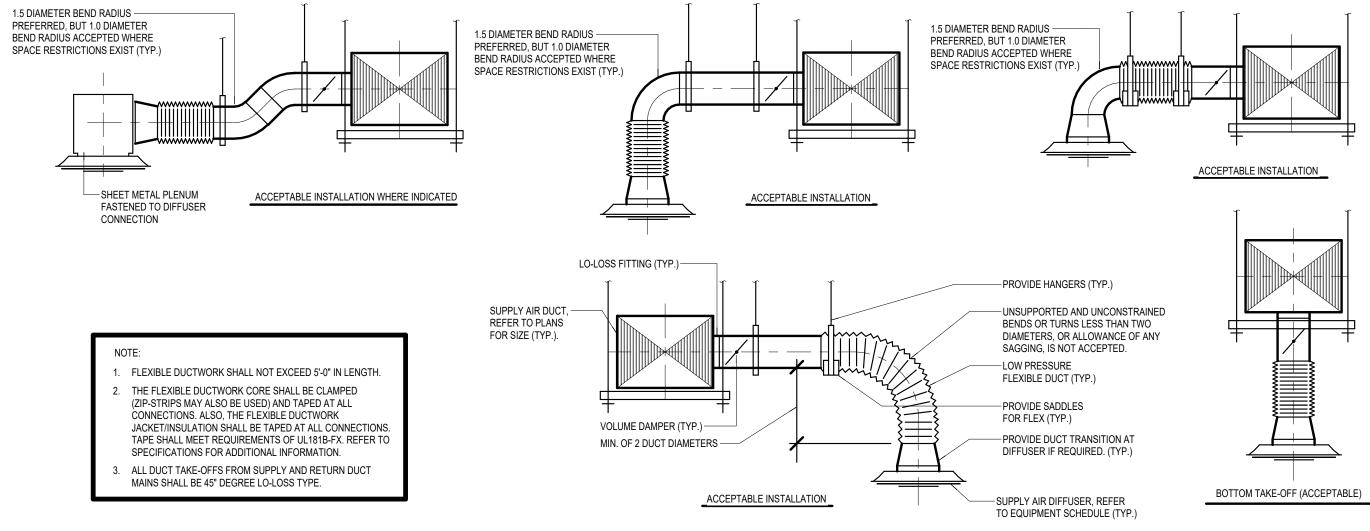

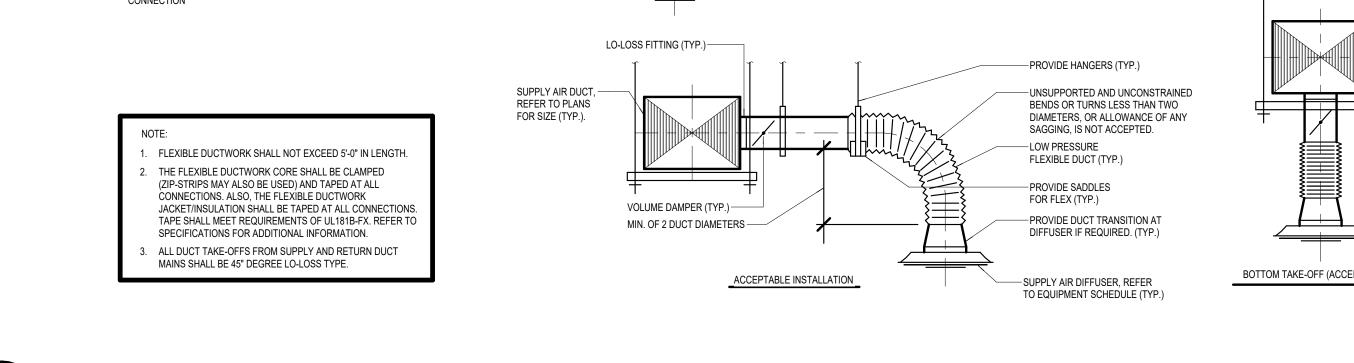






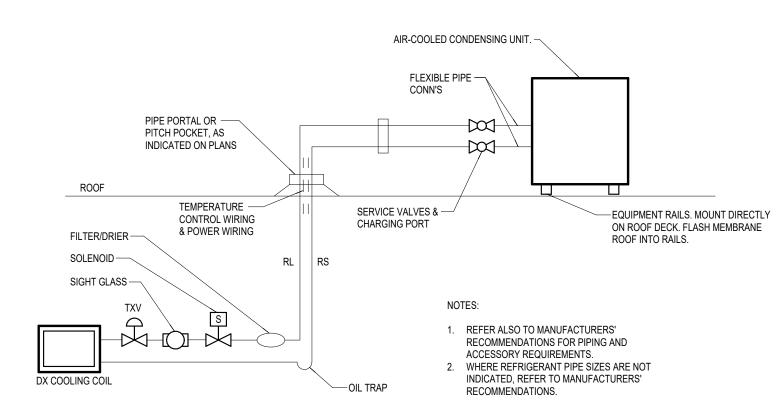



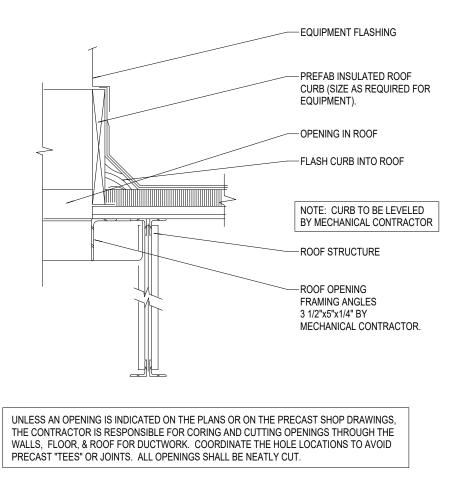


TYPICAL EQUIPMENT ROOF CURB DETAIL


01.06.2025 BIDS & CONSTRUCTION


PROJECT NO. NO PART OF THIS DRAWING MAY BE USED OR REPRODUCED IN ANY FORM OR BY ANY MEANS, OR STORED IN A
DATA BASE OR RETRIEVAL SYSTEM,
WITHOUT PRIOR WRITTEN PERMISSION OF GMB COPYRIGHT © 2025 ALL RIGHTS RESERVED

MECHANICAL & CONTROL DIAGRAMS

M8.01

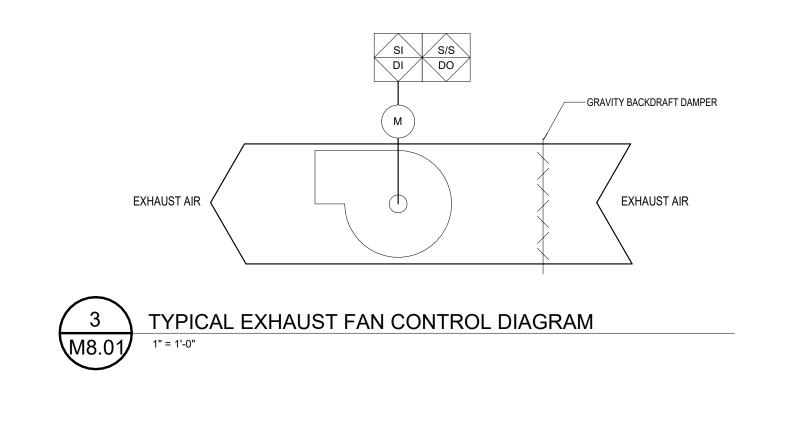

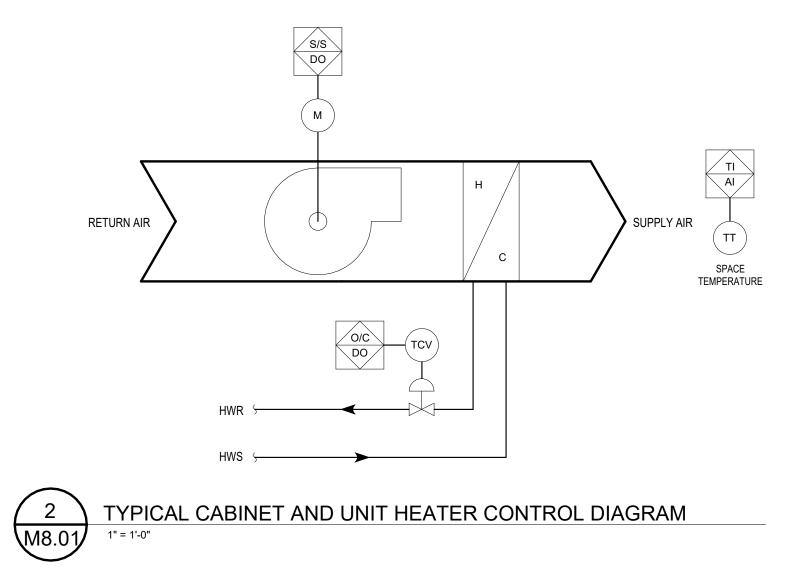

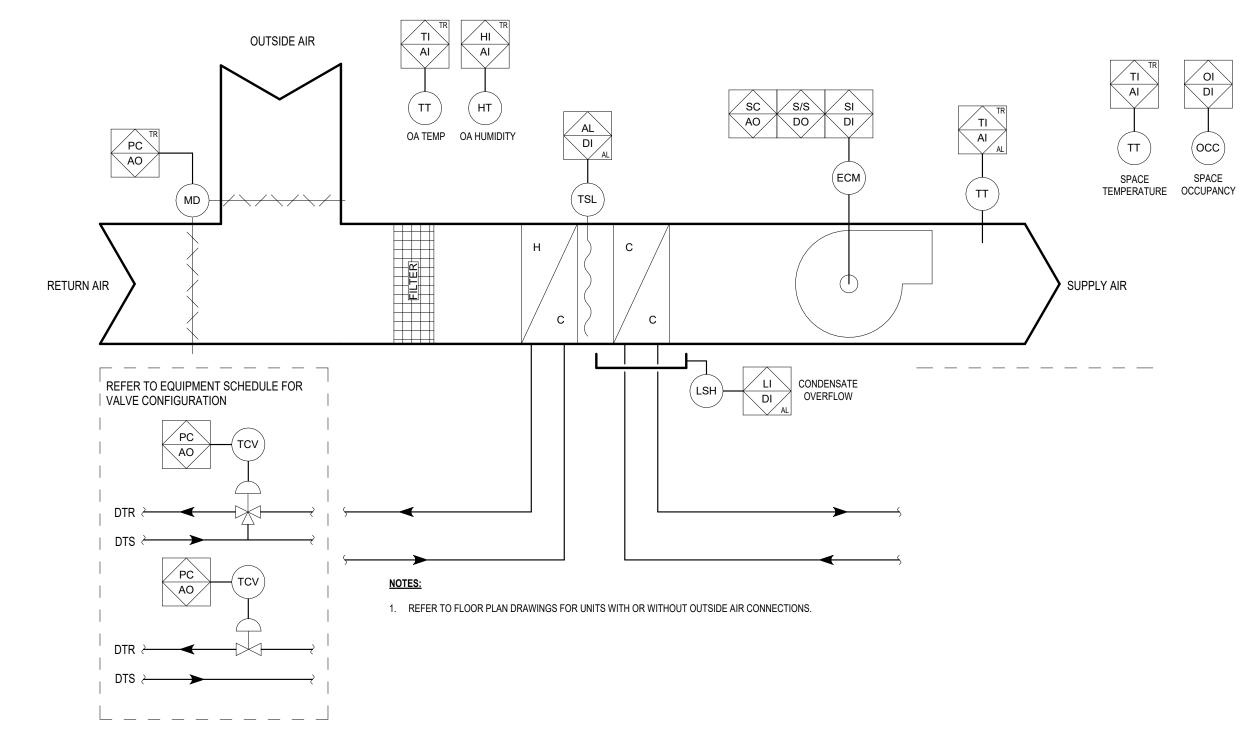

PROJECT NO. NO PART OF THIS DRAWING MAY BE USED OR REPRODUCED IN ANY FORM OR BY ANY MEANS, OR STORED IN A DATA BASE OR RETRIEVAL SYSTEM, WITHOUT PRIOR WRITTEN PERMISSION OF GMB COPYRIGHT © 2025

ALL RIGHTS RESERVED MECHANICAL SCHEDULES

BLOWER COIL UNIT SCHEDULE
 COOLING COIL

 FLUID TYPE
 GPM
 EWT (°F)

 WATER
 18.3 GPM
 44
 INTEGRATE TO EXISTING BMS SYSTEM. TCC TO COORDINATE WITH PERFORMANCE SERVICES TO UNLOCK BAS FOR INTEGRATION. 2. PROVIDE ECM.

					CABINET UI	NIT HE	ATER SCH	IEDULE									
MARK	MANUFACTURER	MODEL	CONFIGURATION	INLET	DISCHARGE	CFM	CAPACITY MBH	FLUID TYPE	ROWS	GPM	EWT (°F)	LWT (°F)	MAX. WPD (FT)	VOLT	ELECTR PH	ICAL HZ	NOTES
CUH-1	TRANE	FFEB020	HORIZONTAL RECESSED	BOTTOM STAMPED	BOTTOM STAMPED	200	9.66	WATER	2	1.0	135.0	115.0	4.45	208	1	60	1, 2, 3
CUH-2	TRANE	FFEB030	HORIZONTAL RECESSED	BOTTOM STAMPED	BOTTOM STAMPED	400	15.42	WATER	2	1.6	135.0	115.0	10.13	208	1	60	1, 2, 3
CUH-3	TRANE	FFEB060	HORIZONTAL RECESSED	BOTTOM STAMPED	BOTTOM STAMPED	600	25.64	WATER	2	2.6	135.0	115.0	7.68	208	1	60	1, 2, 3

NOTES:

- CONTROLLED BY BMS.
- 2. W/ MANUFACTURER PROVIDED 2-WAY CONTROL VALVE.
- 3. W/ UNIT MOUNTED THERMOSTAT.

					UNIT HEATE	R (HY	DRONI	C) SC	HEDULE	1							
						ELECTRICAL											
MARK	SERVICE	MANUFACTURER	MODEL	CFM	CAPACITY (MBH)	GPM	H2O	LAT	MAX.WPD	FLUID TYPE	MOTOR HP	VOLT	PH	HZ	MCA	FLA	NOTES
UH-1	STORAGE HEATING	STERLING	HS-036B	550	26.1	2.7	20	103	0.09	WATER	25 W	115	1	60	2	1	1, 2, 3

NOTES:

- CONTROLLED BY BMS
- 2. INCLUDE 2-WAY MOTORIZED SHUTOFF VALVE
- 3. WALL MOUNTED THERMOSTAT

		DIFFUSER SCH	HEDULE			
MARK	MODEL	DESCRIPTION	BORDER TYPE	MATERIAL	NECK SIZE	NOTES
EG-1	50F	EGGCRATE EXHAUST GRILLE	LAY-IN	Aluminum - Titus - 26 White	8" X 8"	2
EG-2	350RL	DUCT MOUNTED EXHAUST GRILLE	SURFACE MOUNT	Steel - Titus - 26 White	6"x4"	4
EG-3	50F	EGGCRATE EXHAUST GRILLE	SURFACE MOUNT	Aluminum - Titus - 26 White	8" X 8"	1
R-1	45F	SIGHT PROOF EGGCRATE RETURN GRILLE	LAY-IN	Steel - Titus - 26 White	8" X 8"	3
R-2	45F	SIGHT PROOF EGGCRATE RETURN GRILLE	SURFACE MOUNT	Steel - Titus - 26 White	24"x24"	3
R-3	45F	SIGHT PROOF EGGCRATE RETURN GRILLE	SURFACE MOUNT	Steel - Titus - 26 White	22"x46"	5
S-2	OMNI	SQUARE PLAQUE DIFFUSER	LAY-IN	Steel - Titus - 26 White	8"ø	3
S-3	OMNI	SQUARE PLAQUE DIFFUSER	LAY-IN	Steel - Titus - 26 White	10"ø	3
S-4	300RL	DUCT MOUNTED SUPPLY GRILLE	SURFACE MOUNT	Steel - Titus - 26 White	12"x8"	4

GENERAL REQUIREMENTS:

- MODELS BASED ON TITUS.
- 2. COORDINATE ALL BORDERS, CHANNELS, TRIMS AND AIR TERMINAL OPTIONS WITH APPLICABLE CEILING TYPE AND MOUNTING APPLICATION.
- 1. 12" X 12" MODULE SIZE 2. 24" X 12" MODULE SIZE

NOTES:

- 3. 24" X 24" MODULE SIZE
- MOUNT AIR-TIGHT TO DUCT.
- 5. MOUNT 6" AFF. COORDINATE MOUNTING HEIGHT AND LOCATION WITH ANY CASEWORK, TROPHY CASE OR OTHER TRADES. ORIENT 45 DEGREE BLADES DOWN TO CREATE SIGHTPROOF APPEARENCE FROM STANDING HEIGHT.

					FA	N SCHE	DULE											
MARK	SERVICE	MANUFACTURER	MODEL	TYPE	WHEEL DIA. (IN)	CFM	SONES	ESP (in-wg)	OV (FPM)	RPM	DRIVE	ВНР	MOTOR HP	VOLT EL	ECTRIC.	AL HZ	OPER. WEIGHT (LB)	NOTE
EF-1	UNIT A SOUTH LOCKER ROOMS	GREENHECK	G-140-VG	ROOFTOP DOWNBLAST	14 5/8	2205	14.1	0.67	1670	1444	Direct	0.61	1	115	1	60	88	1
EF-2	UNIT A SOUTH LOCKER ROOMS	GREENHECK	G-140-VG	ROOFTOP DOWNBLAST	14 5/8	1680	9.1	0.33	1273	1072	Direct	0.25	1	115	1	60	88	1
EF-3	A123:A126 STORAGE/ 128 CONCESSIONS	GREENHECK	G-100-VG	ROOFTOP DOWNBLAST	11 1/8	780	5.9	0.33	867	1179	Direct	0.09	1/4	115	1	60	54	1
EF-4	UNIT A NORTH LOCKER ROOMS	GREENHECK	CUE-160-VG	SIDEWALL UPBLAST	16 5/8	2975	17	0.8	1730	1308	Direct	0.85	2	208	1	60	141	1
EF-5	UNIT A NORTH LOCKER ROOMS	GREENHECK	CUE-140-VG	SIDEWALL UPBLAST	14 5/8	1625	10.4	0.5	945	1154	Direct	0.29	1/2	115	1	60	94	2

GENERAL REQUIREMENTS:

- PROVIDE FACTORY INSTALLED DISCONNECT
- PROVIDE GRAVITY BACKDRAFT DAMPERS. BIRDSCREEN.
- INTEGRATE TO EXISTING BMS. PROVIDE ECM.

BRACKETS

- 1. FAN TO RUN DURING OPERATING HOURS SET AT THE EXISTING BMS. INTERLOCK WITH OCCUPANCY SENSOR IN LARGEST AREA SERVED BY FAN TO ENABLE FAN WHEN OCCUPANCY IS DETECTED.
- 2. FAN TO RUN CONTINOUS.

MARK SERVICE MANUFACTURER MODEL CONFIGURATION CFM CAPACITY BTUH REFRIGERANT VOLT PH MCA FLA OPER. WEIGHT (IIII) SSAC-1 A112 A.D. OFFICE TRANE TPEADA0181AA80A DUCTED 600 18000 R454B 208 1 2.44 1.95 60 SPLIT SYSTEM - OUTDOOR UNIT SCHEDULE SERVICE MANUFACTURER MODEL NOMINAL TONS COMPRESSOR DATA TYPE EFFICIENCY ELECTRICAL TYPE OPER. WEIGHT (LB) NOTES SSCU-1 A112 A.D. OFFICE TRANE TRUZA0181 KATONA 1.5 TWIN TYPE NUMBER EER SEER HSPF VOLT PH MCA MOP OPER. WEIGHT (LB) NOTES	M	ADV SE	DVICE A	ANUEACTURER	MODEL	CONFICI	LIDATION	FAN DATA	С	OOLING			ELE	CTRICAL		ODED WEIGHT (LB)
SPLIT SYSTEM - OUTDOOR UNIT SCHEDULE SERVICE MANUFACTURER MODEL NOMINAL TONS COMPRESSOR DATA EFFICIENCY ELECTRICAL OPER. WEIGHT (LB) NOTES SSCILL 4112 A.D. OFFICE TRANE TRUZA0181 1.5 TWIN 1 10.8 19.9 10.2 208 1 11 28 100 4.5	IVI	ARK SE	RVICE	ANUFACTURER	MODEL	CONFIG	UKATION	CFM	CAPACITY BTUH	I REFRI	ERANT	VOL.	r PH	MCA	FLA	OPER. WEIGHT (LB)
SERVICE MANUFACTURER MODEL NOMINAL TONS COMPRESSOR DATA EFFICIENCY ELECTRICAL OPER. WEIGHT (LB) NOTES	SS	AC-1 A112 A	D. OFFICE	TRANE	TPEADA0181AA80A	DUC	TED	600	18000	R4	54B	208	1	2.44	1.95	60
TYPE NUMBER EER SEER HSPF VOLT PH MCA MOP		CEDVICE	MANUEACTURE	MODEL							Е	ECTRIC	AL.	ODED	WEIGHT (L	NOTES
SSCILT 4117 ATT DEFICE 1 PANE 1 15 1 1 1 1 1 1 1 1		SERVICE	WANUFACTURE	WIODEL	NOWINAL TONS	TYPE	NUMBER	EER	SEER	HSPF \	OLT P	H MC	A MOI	OPER	. WEIGHT (LE	D) NOIES
		4440 A D. OFFICE	TRANE		1.5		1	10.8	19.9	10.2	08 1	1	28		100	4, 5

1. INDOOR UNIT SHALL BE WALL-HUNG CONFIGURATION WITH MOUNTING

- 2. PROVIDE AN INTEGRAL FACTORY CONDENSATE PUMP
- 3. SPACE TEMPERATURE SENSOR SHALL BE HARD-WIRED
- 4. OUTDOOR UNIT SHALL BE CAPABLE OF HIGH HEATING CAPACITIES AT LOW OA TEMPERATURES, SIMILAR TO TRANE HYPER HEAT MODELS.
- 5. OUTDOOR UNIT SHALL BE MOUNTED 4' ABOVE GRADE ON EXTERIOR WALL.
- 6. PROVIDE 2 POSITION OA DAMPER TO OPEN 100% WHEN SPACE OCCUPANCY SENSOR INDICATES OCCUPANCY. OA DAMPER OPENING TO 100% WHEN SPLIT SYSTEM FAN ENABLES IS ALSO AN ACCEPTABLE SOLUTION. DESIGN INTENT IS FOR THE OA DAMPER TO BE 100% OPEN WHEN THE SPACE/UNIT IS BEING USED. OA DAMPER SHALL BE CLOSED ALL OTHER TIMES.

				VENTIL	_ATOR ((INTAKE) \$	SCHEDULE				
_						THROAT	7	THROAT	APD		
MARK	SERVICE	MANUFACTURER	MODEL	TYPE	CFM	VELOCITY (FPM)	SIZE (IN x IN)	AREA (SQ FT)	(in-wg)	OPER. WEIGHT (LB)	NOTES
IV-3A	BCU-3A VENTILATION AIR	GREENHECK	GRSI-16	GRAVITY	600	414	16	1.5	.026	30	1, 2, 3, 4

GENERAL REQUIREMENTS:

- 1. CONTRACTOR SHALL VERIFY DUCTWORK CONNECTION SIZES AND COORDINATE LOCATION PRIOR TO ORDERING.
- 2. SEAL ROOF PENETRATION WATER-TIGHT.

NOTES:

BIRDSCREEN

menument menument

- 2. 24" PRE-INSULATED ROOF CURB TO MATCH ROOF SLOPE
- BACKDRAFT DAMPER 4. ANTI-CONDENSATE COATING

DISCONNECTS WILL MFGR PROVIDED

GENERAL REQUIREMENTS:

3. PROVIDE STAINLESS STEEL CONDENSATE DRAIN PAN WITH WET SWITCH ALARM.

PROJECT NO. NO PART OF THIS DRAWING MAY BE USED OR REPRODUCED IN ANY FORM OR BY ANY MEANS, OR STORED IN A DATA BASE OR RETRIEVAL SYSTEM, WITHOUT PRIOR WRITTEN PERMISSION OF GMB COPYRIGHT © 2025 ALL RIGHTS RESERVED

ELECTRICAL SYMBOL **LEGENDS & GENERAL NOTES**

E0.01

WALLBOX SCHEDULE DESCRIPTION FSR PWB-CMU8 OR APPROVED EQUAL - PROVIDED WITH: (2) DUPLEX RECEPTACLES "CONDUIT TO ABOVE CEILING FOR COMMUNICATIONS (CABLING BY OWNER) • 1-1/2" CONDUITS TO ABOVE CEILING FOR TECHNOLOGY (CABLING BY OWNER) LEGRAND (WIREMOLD) EFSB4 OR APPROVED EQUAL - PROVIDED WITH: • (2) DUPLEX RECEPTACLES 1" CONDUIT TO ABOVE CEILING FOR COMMUNICATIONS (CABLING BY OWNER) 1-1/2" CONDUITS TO ABOVE CEILING FOR TECHNOLOGY (CABLING BY OWNER)

> FLOORBOX SCHEDULE DESCRIPTION

TYPICAL 6" SQUARE (COVER) FLUSH FLOORBOX - PROVIDE WITH:

• SINGLE-GANG COMPARTMENT WITH 1" CONDUIT TO SOUND SYSTEM RACK LOCATION

TWO-GANG COMPARTMENT WITH 2" CONDUIT TO SOUND SYSTEM RACK LOCATION

TWO DUPLEX RECEPTACLES

INTLK INTERLOCK ABOVE FINISHED FLOOR JUNCTION JUNCTION BOX AUTOMATIC DOOR OPERATOR KW KILOWATT AIR HANDLING UNIT KILOWATT HOUR AUTOMATIC TRANSFER SWITCH KNOCK OUT BOB BOTTOM OF BOX BOTTOM OF DECK LIGHTING CONTROL BOTTOM OF STRUCTURE LIGHTING CONTROL MODULE LIGHTING CONTROL PANEL BLDG LIGHTING LTG MAXIMUM LIGHTING CONTROL INTENT NARRATIVE MAIN BONDING JUMPER MOTOR CONTROL CENTER CKT CIRCUIT MINIMUM CIRCUIT BREAKER MANUAL TRANSFER SWITCH CONDUIT NATIONAL ELECTRICAL CODE COMMUNICATIONS NEGATIVE (-) CONN CONNECTION NORMALLY CLOSED CONSTRUCTION NORMALLY OPEN CONTR CONTRACT (OR) NOT APPLICABLE CONTRACT LIMIT LINE NOT IN CONTRACT CURRENT TRANSFORMER NIGHT LIGHT ELECTRICAL CONTRACTOR OVERCURRENT PROTECTIVE DEVICE OCPD EQUIPMENT GROUNDING CONDUCTOR PHOTOCELL / PHOTOCONTROL ELECTRIC HAND DRYER POSITIVE (+ ELECTRIC (AL) PWR ELECTRIC WATER COOLER POWER & LIGHTING EMERGENCY SURFACE SYSTEM BONDING JUMPER SUPPLIED BY OTHERS **EQUIP** SINGLE POLE SURGE PROTECTION DEVICE **FXHAUST FAN** SPKR SPEAKER ETR EXISTING TO REMAIN SPECIFICATION SUPPLY-SIDE BONDING JUMPER SUBSTITUTE FIRE ALARM SWBD SWITCHBOARI FOOD SERVICE EQUIPMENT TELEPHONE FIRE PROOF / FIRE PROTECTION THERMOSTAT T'STAT FLOOR XFMR TRANSFORMER **FLUOR** FLUORESCENT UNDERGROUND GROUNDING ELECTRODE CONDUCTOR UNDERWRITERS LABORATORIES GEN GENERATOR UNIT HEATER GROUND FAULT CIRCUIT INTERRUPTER UNLESS NOTED OTHERWISE GROUND GRD VERT VERTICAL HORIZ HORIZONTAL WITH HTR **HEATER** WITHOU' HEATING WIRE GUARD HEATING / VENTILATING WET LOCATION HEATING, VENTILATING, AIR CONDITIONING WEATHER PROOF HAND - OFF - AUTOMATIC HOA HEAT PUMP

ELECTRICAL ABBREVIATIONS

MAXIMUM CONDUCTOR LENGTHS FOR TYPICAL BRANCH CIRCUITS ONE-WAY LENGTH (FEET) BASED ON SINGLE ONE-WAY LENGTH (FEET) BASED ON SINGLE PHASE, 20A CIRCUIT, 75% LOAD, 100% P.F., IN PHASE, 30A CIRCUIT, 75% LOAD, 100% P.F., IN STEEL CONDUIT, 3% VOLTAGE DROP STEEL CONDUIT, 3% VOLTAGE DROP CONDUCTOR SIZE CONDUCTOR SIZE VOLTAGE | #12 AWG | #10 AWG | #8 AWG | #6 AWG | #4 AWG | VOLTAGE | #10 AWG | #8 AWG | #6 AWG | #4 AWG | 120 60 100 150 245 385 120 60 100 150 245 208 100 170 265 425 670 208 100 170 265 425 277 | 135 | 230 | 355 | 565 277 135 230 355 565 890 480 240 400 615 980 480 | 240 | 400 | 615 | 980 ONE-WAY LENGTH (FEET) BASED ON THREE ONE-WAY LENGTH (FEET) BASED ON THREE PHASE, 20A CIRCUIT, 75% LOAD, 100% P.F., IN PHASE, 30A CIRCUIT, 75% LOAD, 100% P.F., IN STEEL CONDUIT, 3% VOLTAGE DROP STEEL CONDUIT, 3% VOLTAGE DROP CONDUCTOR SIZE CONDUCTOR SIZE | VOLTAGE | #12 AWG | #10 AWG | #8 AWG | #6 AWG | #4 AWG | VOLTAGE | #10 AWG | #8 AWG | #6 AWG | #4 AWG | 208 | 120 | 200 | 305 | 490 | 775 208 | 120 | 200 | 305 | 490 480 275 460 710 1,130 480 275 460 710 1,130

COMMUNICATIONS SYMBOL LEGEND COMMUNICATIONS OUTLET ROUGH-IN COMMUNICATIONS OUTLET, CEILING-MOUNTED COMMUNICATIONS OUTLET, FLOOR-MOUNTED CEILING-MOUNTED VIDEO PROJECTOR COMMUNICATIONS EQUIPMENT RACK, FLOOR-MOUNTED 2-POST COMMUNICATIONS EQUIPMENT RACK, FLOOR-MOUNTED 4-POST COMMUNICATIONS EQUIPMENT RACK, WALL-MOUNTED CONDUIT SLEEVE FOR COMMUNICATIONS CABLING, 2" DIA. OR EQUIV. FREE AREA TYP. UNLESS NOTED OTHERWISE. IN FIRE-RATED AND/OR SMOKE BARRIER WALLS, REFER TO SPECIFICATIONS FOR ACCEPTABLE FIRESTOP AND SMOKE SEAL PRODUCTS. LOUDSPEAKER, CEILING-MOUNTED, TYPE 1 LOUDSPEAKER, WALL-MOUNTED, TYPE 1 INTERCOM SYSTEM CALL STATION BUTTON VOLUME CONTROL FOR AUDIO SYSTEM, PAGING, OR INTERCOM LOUDSPEAKERS SECONDARY CLOCK, CEILING-MOUNTED, TYPE 1 SECONDARY CLOCK, WALL-MOUNTED, TYPE 1 SIGNALING BELL NOTE: NOT ALL SYMBOLS ARE NECESSARILY USED

COMBINATION MOTOR STARTER AND FUSIBLE DISCONNECTING MEANS VARIABLE FREQUENCY DRIVE WITH INTEGRAL DISCONNECTING MEANS MOTOR STARTER BOX-COVER FUSIBLE DISCONNECT SWITCH MANUAL MOTOR CONTROLLER POWER SWITCH, REFER TO LIGHTING SYMBOL LEGEND FOR SIMILAR SWITCH TYPES DIRECT ELECTRICAL CONNECTION SINGLE NEMA 5-20R RECEPTACLE SINGLE NEMA 5-20R RECEPTACLE, CEILING-MOUNTED SINGLE NEMA 5-20R RECEPTACLE, FLOOR-MOUNTED DUPLEX NEMA 5-20R RECEPTACLE "E" NOTATION: REPLACE EXISTING WIRING DEVICE USING EXISTING OUTLET BOX **P**GFCI "GFCI" NOTATION: GROUND FAULT CIRCUIT INTERRUPTER TYPE RECEPTACLE "S" NOTATION: SURFACE-MOUNTED "WL" NOTATION: PROVIDE WEATHER RESISTANT (WR) GFCI RECEPTACLE WITH EXTRA-DUTY WHILE-IN-USE WET LOCATION COVER DUPLEX NEMA 5-20R RECEPTACLE, CEILING-MOUNTED DUPLEX NEMA 5-20R RECEPTACLE, FLOOR-MOUNTED DUPLEX NEMA 5-20R RECEPTACLE, CONNECTED TO STANDBY POWER BRANCH CIRCUIT DUPLEX NEMA 5-20R RECEPTACLE, SPLIT-WIRED QUADRUPLEX (DOUBLE DUPLEX) NEMA 5-20R RECEPTACLE QUADRUPLEX (DOUBLE DUPLEX) NEMA 5-20R RECEPTACLE, CEILING-MOUNTED QUADRUPLEX (DOUBLE DUPLEX) NEMA 5-20R RECEPTACLE, FLOOR-MOUNTED RECEPTACLE OTHER THAN NEMA 5-20R (MAY BE MULTI-POLE OR MULTI-PHASE). RECEPTACLE OTHER THAN NEMA 5-20R (MAY BE MULTI-POLE OR MULTI-PHASE), SEE PLAN FOR TYPE, FLOOR-MOUNTED VERT. HORIZ.

SURFACE RACEWAY SYSTEM AUTOMATIC TRANSFER SWITCH NON-AUTOMATIC TRANSFER SWITCH MANUAL TRANSFER SWITCH SWITCHBOARD / SWITCHGEAR TRANSFORMER MOTOR CONTROL CENTER EMERGENCY STOP STATION, REFER TO DETAIL FOR REQUIREMENTS. AUTOMATIC DOOR OPERATOR PUSH BUTTON ON/OFF PUSH BUTTON THREE-FUNCTION PUSH BUTTON FLOORBOX, TYPE 1 JUNCTION BOX METER THERMOSTAT ROUGH-IN RELAY ENCLOSED CONTROL CONTACTOR NOTE: NOT ALL SYMBOLS ARE NECESSARILY USED

POWER SYMBOL LEGEND

THREE PHASE MOTOR CONNECTION, 5 HORSEPOWER (EXAMPLE)

SINGLE PHASE MOTOR CONNECTION, 1/2 HORSEPOWER (EXAMPLE)

HVAC CONTROL DAMPER ACTUATOR CONNECTION

D F/S HVAC COMBINATION FIRE/SMOKE DAMPER ACTUATOR CONNECTION

SAFETY SWITCH DISCONNECTING MEANS, NOT FUSIBLE

SAFETY SWITCH DISCONNECTING MEANS, FUSIBLE

D SD HVAC SMOKE DAMPER ACTUATOR CONNECTION

SINGLE POLE TOGGLE SWITCH DOUBLE POLE TOGGLE SWITCH THREE-WAY TOGGLE SWITCH FOUR-WAY TOGGLE SWITCH SINGLE POLE SWITCH WITH INTEGRAL OCCUPANCY SENSOR SINGLE POLE SWITCH WITH INTEGRAL OCCUPANCY SENSOR AND DIMMER WALL-BOX DIMMER SWITCH THREE-WAY WALL-BOX DIMMER SWITCH ELECTRONIC INTERVAL TIMER SWITCH LIGHT SWITCH WITH PILOT LIGHT LIGHTING CONTROL SWITCH, REFER TO LIGHTING CONTROL SWITCH SCHEDULE AND SPECIFICATIONS FOR DETAILS. DOUBLE-THROW (MAINTAINED) LIGHT SWITCH (SUFFIX DESIGNATION -- NONE: SINGLE POLE. 2: DOUBLE-POLE. 3: THREE-WAY. 4: FOUR-WAY) (SUFFIX DESIGNATION -- NONE: SINGLE-POLE, 2: DOUBLE-POLE, 3: THREE-WAY, 4: FOUR-WAY) TOUCHSCREEN PANEL CIRCUIT NUMBER FOR LIGHT FIXTURES WITHIN INDICATED SPACE WALL-MOUNTED LIGHTING FIXTURE. TYPE 'A' RECESSED LIGHTING FIXTURE, TYPE 'A' SURFACE-MOUNTED LIGHTING FIXTURE, TYPE 'A' TRACK LIGHTING SINGLE FACE EXIT SIGN, TYPE "X1" IN SCHEDULE UNLESS OTHERWISE NOTED, SHADING INDICATES FACE ORIENTATION DOUBLE FACE EXIT SIGN, TYPE "X2" IN SCHEDULE UNLESS OTHERWISE NOTED, SHADING INDICATES FACE ORIENTATION WALL-MOUNTED EXIT SIGN, SHADING INDICATES FACE ORIENTATION EMERGENCY LIGHT FIXTURE DESIGNATION EMERGENCY LIGHTING AUTOMATIC LOAD CONTROL RELAY LIGHTING CONTROL RELAY LIGHTING CONTROL ENCLOSED CONTACTOR TIME SWITCH LIGHTING CONTROL MODULE LIGHTING CONTROL PANEL EMERGENCY LIGHTING INVERTER, TYPE 1 WALL-MOUNTED OCCUPANCY SENSOR CEILING-MOUNTED OCCUPANCY SENSOR WALL-MOUNTED PHOTOCELL FOR ON/OFF CONTROL CEILING-MOUNTED PHOTOCELL FOR ON/OFF CONTROL WALL-MOUNTED PHOTOSENSOR FOR DAYLIGHT HARVESTING DIMMING CONTROL CEILING-MOUNTED PHOTOSENSOR FOR DAYLIGHT HARVESTING DIMMING CONTROL POLE-MOUNTED SITE/AREA FIXTURE SELF-CONTAINED EMERGENCY LIGHTING UNIT NOTE: NOT ALL SYMBOLS ARE NECESSARILY USED

LIGHTING SYMBOL LEGEND

FIRE DETECTION & ALARM SYMBOL LEGEND AUDIBLE NOTIFICATION APPLIANCE, WALL-MOUNTED VISUAL NOTIFICATION APPLIANCE, WALL-MOUNTED AUDIBLE/VISUAL NOTIFICATION APPLIANCE, WALL-MOUNTED AUDIBLE NOTIFICATION APPLIANCE, CEILING-MOUNTED VISUAL NOTIFICATION APPLIANCE, CEILING-MOUNTED AUDIBLE/VISUAL NOTIFICATION APPLIANCE, CEILING-MOUNTED FIRE PROTECTION OR ALARM BELL MANUAL PULL STATION SMOKE DETECTOR HEAT DETECTOR DUCT SMOKE DETECTOR CARBON MONOXIDE DETECTOR KEYED TEST SWITCH AND REMOTE INDICATOR FOR DUCT SMOKE DETECTOR FIRE PROTECTION FLOW SWITCH; PROVIDE SUPERVISED INPUT TO FIRE ALARM SYSTEM PRESSURE SWITCH; PROVIDE SUPERVISED INPUT TO FIRE ALARM SYSTEM FIRE PROTECTION TAMPER SWITCH; PROVIDE SUPERVISED INPUT TO FIRE ALARM SYSTEM ELECTROMAGNETIC DOOR HOLD-OPEN DEVICE ADDRESSABLE RELAY FOR FIRE ALARM CONTROL NOTIFICATION APPLIANCE CIRCUIT POWER SUPPLY FIRE ALARM REMOTE ANNUNCIATOR FIRE ALARM CONTROL PANEL WHERE "WG/PC" IS NOTED, PROVIDE LISTED WIRE GUARD OR PROTECTIVE POLYCARBONATE COVER FOR DAMAGE RESISTANCE OF ASSOCIATED DEVICE WHERE "WL" IS NOTED, PROVIDE LISTED WET-LOCATION VERSION OF ASSOCIATED DEVICE, SUITABLE FOR INDOOR OR OUTDOOR USE NOTE: NOT ALL SYMBOLS ARE NECESSARILY USED ELECTRONIC SAFETY / SECURITY SYMBOL LEGEND DOOR CONTACT ELECTRONIC LATCH

ELECTRONIC STRIKE INTRUSION DETECTION KEYPAD INTERCOM STATION WALL-MOUNTED SURVEILLANCE CAMERA COMMUNICATIONS ROUGH-IN CEILING-MOUNTED SURVEILLANCE CAMERA COMMUNICATIONS ROUGH IN WALL-MOUNTED SURVEILLANCE CAMERA, TYPE 1 CEILING-MOUNTED SURVEILLANCE CAMERA, TYPE 1 WALL-MOUNTED INFRARED MOTION DETECTOR CEILING-MOUNTED INFRARED MOTION DETECTOR WALL-MOUNTED ULTRASONIC MOTION DETECTOR CEILING-MOUNTED ULTRASONIC MOTION DETECTOR CARD READER CARD READER, MULLION-MOUNTED ACCESS CONTROL DOOR TAG, REFER TO HARDWARE SCHEDULE(S) IN SECTION 08 71 00 AND/OR SECTION 28 10 00 FOR FURTHER DETAILED REQUIREMENTS ACCESS CONTROL SYSTEM EQUIPMENT INTRUSION DETECTION SYSTEM EQUIPMENT

NOTE: NOT ALL SYMBOLS ARE NECESSARILY USED

ALL WORK SHALL COMPLY WITH THE NATIONAL ELECTRICAL CODE AS AMENDED AND ADOPTED BY THE LOCAL AUTHORITY HAVING JURISDICTION WHERE THE WORK IS PERFORMED. ALL "LOW-VOLTAGE" CONTROLS, COMMUNICATIONS, AND SAFETY/SECURITY CABLING MAY BE INSTALLED WITHOUT CONDUIT, RACEWAY, OR CABLE TRAY ONLY WHERE CONCEALED ABOVE A SUSPENDED CEILING SYSTEM AND ACCESSIBLE FOR FUTURE MAINTENANCE. OTHERWISE, ALL CABLING (INCLUDING BUT NOT LIMITED TO CABLES ASSOCIATED WITH SYSTEMS SUCH AS ARCHITECTURAL EQUIPMENT, BUILDING ENERGY MANAGEMENT, TEMPERATURE CONTROLS, LIGHTING CONTROLS, COMMUNICATIONS NETWORKS, TELEPHONE, AUDIO-VIDEO, INTERCOM, PAGING, CLOCK, SURVEILLANCE, ACCESS CONTROL, FIRE ALARM, ETC.) SHALL BE INSTALLED IN AN APPROVED CONDUIT, RACEWAY SYSTEM, AND/OR CABLE TRAY UNLESS OTHÉRWISE NOTED. IN EXPOSED STRUCTURE CEILING AREAS, CONCEALED INSTALLATION OF CABLES IN RACEWAYS SHALL BE REQUIRED FOR AESTHETIC REASONS: REFER TO REFLECTED CEILING PLANS FOR LOCATION(S) THIS APPLIES TO ALL TRADES AND WORK CATEGORIES. EXCEPTIONS: A. DEDICATED MECHANICAL AND/OR ELECTRICAL ROOMS ABOVE 8'-0" AFF B. DEDICATED TELECOMMUNICATIONS ROOMS ALL DEVICES SHOWN TO BE INSTALLED ON EXISTING WALLS SHALL BE INSTALLED FLUSH; CUT IN BOXES AND FISH WALLS WITH FLEXIBLE CONDUIT AS REQUIRED. DOCUMENT AND COORDINATE EXCEPTIONS WITH ARCHITECT/ENGINEER IN WRITING FOR REVIEW IN FIELD. IF WALL IS PROVEN NOT ABLE TO BE FISHED, PROVIDE SURFACE RACEWAY SYSTEMS PER SECTION 26 05 33.23, SHALL BE PROVIDED BY THE CONTRACTOR; SUCH COSTS SHALL BE INCLUDED IN BID. SURFACE-MOUNTED CONDUIT IS NOT ACCEPTABLE WHERE EXPOSED TO VIEW IN SPACES OTHER THAN DEDICATED MECHANICAL/ELECTRICAL "LOW-VOLTAGE" CONTROLS, COMMUNICATIONS, AND SAFETY/SECURITY CABLING SHALL NOT BE PAINTED. CONTRACTORS INSTALLING CABLING WHERE APPROVED FOR EXPOSED INSTALLATION SHALL INSTALL CABLES AFTER PAINTING HAS BEEN COMPLETED OR PROVIDE TEMPORARY PROTECTION OF CABLES 2025.03.18 UNTIL PAINTING HAS BEEN COMPLETED. PROVIDE TEMPORARY PROTECTION OF ANY EXISTING CABLING PRIOR TO PAINTING EXISTING AREAS. PAINTED CABLES SHALL BE REPLACED AT THE EXPENSE OF THE NEGLIGENT CONTRACTOR. METAL CLAD CABLE MAY BE USED FOR FIXTURE WHIPS IN LENGTHS OF 6 FEET OR LESS ABOVE AN ACCESSIBI E SUSPENDED CEILING SYSTEM ONLY OTHERWISE METAL CLAD OR OTHER FLEXIBLE CABLE TYPES SHALL NOT BE USED UNLESS SPECIFICALLY AUTHORIZED BY THE ENGINEER. IT IS THE INTENT OF THESE CONTRACT DOCUMENTS THAT ALL INSTALLED BRANCH CIRCUITS CONSIST OF SEPARATE RACEWAY AND CONDUCTORS ALLOWING REMOVAL AND REPLACEMENT OF WIRING AS REQUIRED FOR FUTURE UPGRADES. REFER TO SPECIFICATIONS FOR EXCEPTIONS. CIRCUIT WIRING FOR ARTICLE 700 EMERGENCY SYSTEMS AND ARTICLE 708 CRITICAL OPERATIONS POWER SYSTEMS SHALL BE INSTALLED IN SEPARATE CONDUITS/RACEWAYS AND BE KEPT ENTIRELY INDEPENDENT OF ALL OTHER WIRING AND EQUIPMENT PER NEC REQUIREMENTS.

CONSIDERED AN ACCEPTABLE GROUND. CONDUITS AND CABLING SHALL NOT BE INSTALLED WITHIN 4" OF ROOF DECK, EXCEPT AS NECESSARY TO SERVE ROOF-MOUNTED ITEMS AND ONLY WHEN THE CONDUIT OR CABLE IS ROUTED VERTICALLY TO SUCH EQUIPMENT FROM BELOW. CLEARANCE SHALL BE PERMITTED TO BE REDUCED TO 1 1/2" WHERE SUPPLEMENTAL METAL FRAMING MEMBERS PROVIDE AN EFFECTIVE BARRIER BETWEEN THE ROOF DECK SUPPLEMENTAL METAL FRAMING SHALL BE PROVIDED FOR SUSPENSION POINTS OF ALL ITEMS LOCATED BETWEEN STRUCTURAL MEMBERS (JOISTS, TRUSSES, BEAMS, ETC.) IN OPEN/VISIBLE STRUCTURE CEILING OR SUPPORT COLUMN AREAS. METAL FRAMING SHALL SPAN ACROSS THE TOP CHORD OR FLANGE OF OVERHEAD STRUCTURAL MEMBERS FOR BOTH STRUCTURAL AND AESTHETIC PURPOSES. SPECIFIC EXCEPTIONS SHALL BE COORDINATED IN WRITING WITH THE ARCHITECT/ENGINEER.

ALL FEEDERS AND BRANCH CIRCUITS SHALL CONTAIN AN EQUIPMENT GROUNDING CONDUCTOR SIZED

ACCORDING TO THE NEC RACEWAYS INCLUDING CONDUITS, BOXES, WIREWAYS, ETC. SHALL NOT BE

10. CONDUIT INSTALLED WITHIN INACCESSIBLE CONSTRUCTION SHALL BE 3/4" MINIMUM SIZE. I. FEEDERS SHOWN ON DRAWINGS ARE SCHEMATIC ONLY. CONDUIT RUNS SHALL COMPLY WITH CONDUIT SPECIFICATIONS AND CONTAIN BENDS THAT ARE NO GREATER THAN 90 DEGREES. CONDUITS INSTALLED ABOVE GRADE SHALL BE RUN PARALLEL TO, OR PERPENDICULAR WITH, BUILDING STEEL AND/OR

ARCHITECTURAL LINES. 2. CONTRACTOR(S) SHALL VERIFY COLOR/FINISH OF WIRING DEVICES, DEVICE FACEPLATES, SURFACE RACEWAY SYSTEMS, AND/OR MULTI-OUTLET ASSEMBLIES WITH ARCHITECT/ENGINEER IF NOT EXPLICITLY

3. ELECTRICAL CONTRACTOR SHALL REFER TO ARCHITECTURAL REFLECTED CEILING PLANS FOR ADDITIONAL INFORMATION REGARDING LIGHTING FIXTURE MOUNTING LOCATIONS, ARRANGEMENTS, AND

14. ELECTRICAL CONTRACTOR SHALL ADJUST LIGHTING FIXTURE LOCATIONS IN MECHANICAL ROOMS TO ACCOMMODATE MECHANICAL EQUIPMENT, DUCTWORK, AND RELATED FIELD CONDITIONS. 5. CONTRACTOR(S) SHALL BE RESPONSIBLE TO REVIEW INTERIOR ELEVATION SHEETS FOR PLACEMENT OF DEVICE BOXES. COORDINATE LOCATIONS SO THAT NO DEVICES ARE INSTALLED BEHIND CASEWORK, MILLWORK, VISUAL DISPLAY BOARDS, MIRRORS, CUSTOM GRAPHICS, SIGNAGE, ETC. 16. ELECTRICAL CONTRACTOR SHALL REVIEW TOILET EQUIPMENT SHOP DRAWINGS AND ARCHITECTURAL

DETAILS/ELEVATIONS FOR CORRECT DEVICE BOX ROUGH-IN LOCATION OF HAND DRYERS.

17. ELECTRICAL CONTRACTOR SHALL COORDINATE WITH PLUMBING CONTRACTOR AND THE ELECTRIC OF PLUMBING EQUIPMENT POWER CONNECTIONS. READILY ACCESSIBLE GFCI PROTECTION SHALL BE PROVIDED FOR THE BRANCH CIRCUIT(S) SUPPLYING ALL SUCH UNITS PER NEC REQUIREMENTS. 18. REFER TO MECHANICAL EQUIPMENT SCHEDULE FOR DETAILED INFORMATION REGARDING EQUIPMENT AND CONTROL. ELECTRICAL CONTRACTOR SHALL BE RESPONSIBLE FOR REVIEWING AND PROVIDING

ITEMS AS SPECIFICALLY LISTED AND ASSIGNED ON MECHANICAL EQUIPMENT SCHEDULE SUCH AS DISCONNECT SWITCHES, VARIABLE FREQUENCY DRIVES, STARTERS, TIMERS, SWITCHES, ETC. 19. ELECTRICAL CONTRACTOR SHALL CONFIRM THE LOCATION OF THE EXHAUST FANS LISTED IN THE MECHANICAL EQUIPMENT SCHEDULES BY REFERRING TO MECHANICAL/HVAC PLANS.

20. REFER TO ROOF PLANS FOR EXACT LOCATIONS OF ROOF-TOP MECHANICAL EQUIPMENT. I. PROVIDE FLUSH SINGLE-GANG BOXES IN WALLS FOR HVAC / TEMPERATURE CONTROL DEVICES, AT LEAST ONE PER OCCUPIABLE ROOM OR SPACE. INSTALL 3/4" CONDUIT RACEWAY FROM BOX TO CORRESPONDING TEMPERATURE CONTROL SYSTEM DEVICE OR CONTROLLED UNIT. REFER TO MECHANICAL DRAWINGS FOR PROPOSED LOCATIONS AND COORDINATE WITH MECHANICAL / TEMPERATURE CONTROLS CONTRACTOR'S SHOP DRAWINGS.

2. CABINET UNIT HEATERS MAY HAVE LINE-VOLTAGE THERMOSTATS SUPPLIED BY MECHANICAL CONTRACTOR AND INSTALLED BY THE ELECTRICAL CONTRACTOR. REFER TO MECHANICAL EQUIPMENT


23. DIVISION 26 CONTRACTOR SHALL PROVIDE CONDUIT SLEEVES WITH APPROPRIATE BUSHINGS FOR CONTROLS AND ELECTRONIC SAFETY/SECURITY CABLING THROUGH WALLS AND FLOORS. SLEEVE SIZES SHALL BE COORDINATED WITH CABLING REQUIREMENTS.

24. SECTION 27 05 28 CONTRACTOR SHALL PROVIDE DEDICATED CONDUIT SLEEVES WITH APPROPRIATE BUSHINGS THROUGH WALLS AND FLOORS FOR DIV. 27 COMMUNICATIONS AND DIV. 28 SAFETY/SECURITY CABLING. SLEEVE SIZE SHALL BE MINIMUM 2" DIA. OR EQUIVALENT FREE AREA UNLESS NOTED OTHERWISE. SPECIFIED CABLE PATHWAY PENETRATION DEVICES SHALL BE SUBSTITUTED FOR CONDUIT SLEEVES WHERE THERE IS A REQUIRED RATING IN THE CONSTRUCTED ASSEMBLY. 25. BUILDING SYSTEMS CABLING SHALL BE SLEEVED WHERE CABLES PASS THROUGH WALLS. NO CABLING

SHALL PASS THROUGH OR OVER THE TOP OF WALL CONSTRUCTION WITHOUT THE USE OF A SLEEVE. DIVISION 26 CONTRACTOR SHALL PROVIDE SLEEVES (UNLESS OTHERWISE ASSIGNED) AND COORDINATE WITH ARCHITECTURAL TRADES DURING THE WALL CONSTRUCTION PROCESS. THIS REQUIREMENT APPLIES TO EXISTING CABLING IN FOOTPRINT OF ANY NEW WALLS: PROVIDE SPLIT SLEEVES IF CABLING CANNOT BE DISCONNECTED. FIELD-VERIFY QUANTITIES AND LOCATIONS, OR COORDINATE USE OF ALLOWANCES FOR SLEEVES WITH PROJECT ADMINISTRATIVE REQUIREMENTS.

26. PROVIDE DIRECT CONNECTIONS FROM DEDICATED LOCAL BRANCH CIRCUIT(S) TO ACCESS CONTROL SYSTEM AND DOOR HARDWARE POWER SUPPLIES WHERE REQUIRED FOR DOOR LOCK DEVICES, CONTROLLERS, ETC. REFER TO DOOR HARDWARE SCHEDULE AND ACCESS CONTROL SYSTEM SCHEDULE IN RESPECTIVE SPECIFICATIONS FOR QUANTITIES AND LOCATIONS.

7. ALL CONTROLS, COMMUNICATIONS, AND ELECTRONIC SAFETY/SECURITY CABLING SHALL BE PLENUM

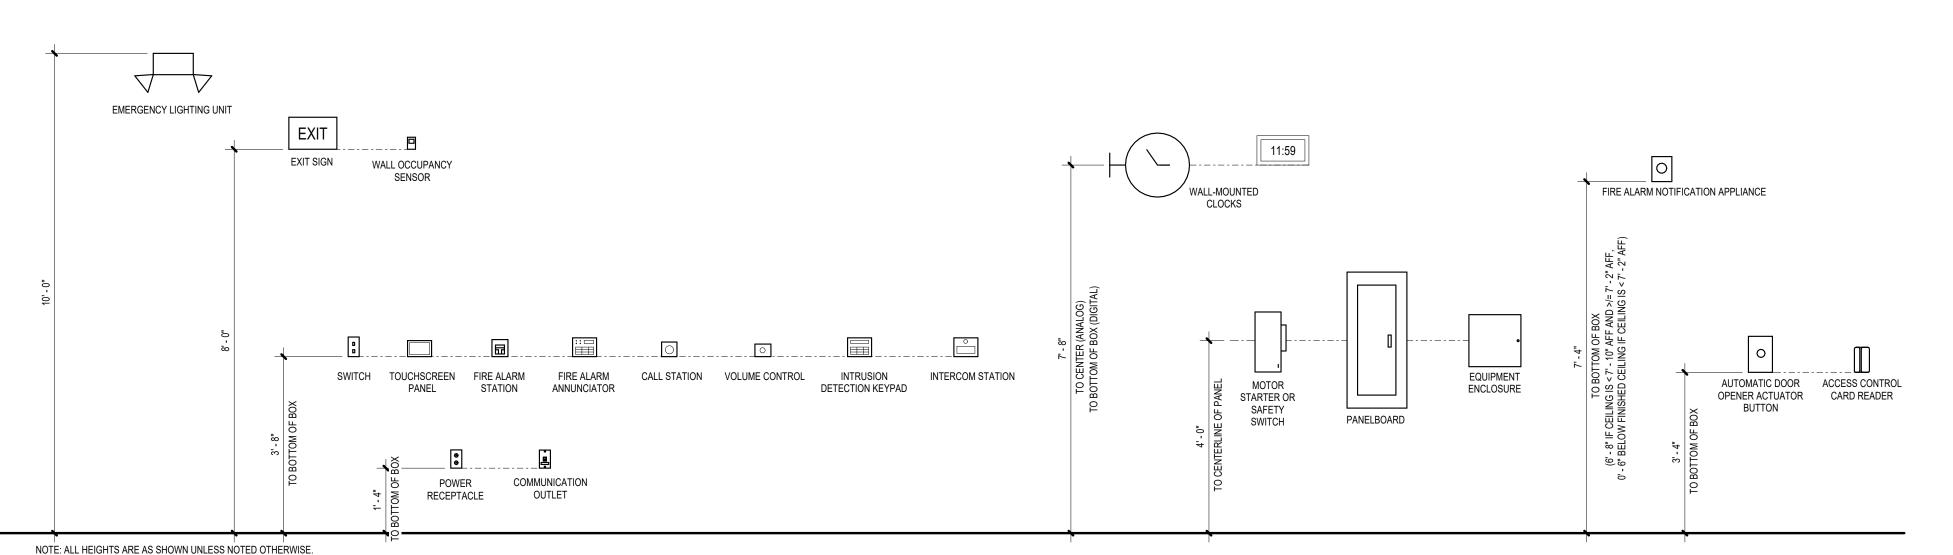

POWER SUPPLY UNIT

TYPICAL MOUNTING HEIGHTS FOR WALL DEVICES, EQUIPMENT, & FIXTURES

STATE OF

2025.03.18

01.06.2025 BIDS & CONSTRUCTION

REVIEWED SMS


PROJECT NO. 5-6394

NO PART OF THIS DRAWING MAY BE USED OR REPRODUCED IN ANY FORM OR BY ANY MEANS, OR STORED IN A DATA BASE OR RETRIEVAL SYSTEM, WITHOUT PRIOR WRITTEN

GMB COPYRIGHT © 2025
ALL RIGHTS RESERVED

UNIT 'A' FIRST FLOOR
ELECTRICAL DEMOLITION

E1.1A

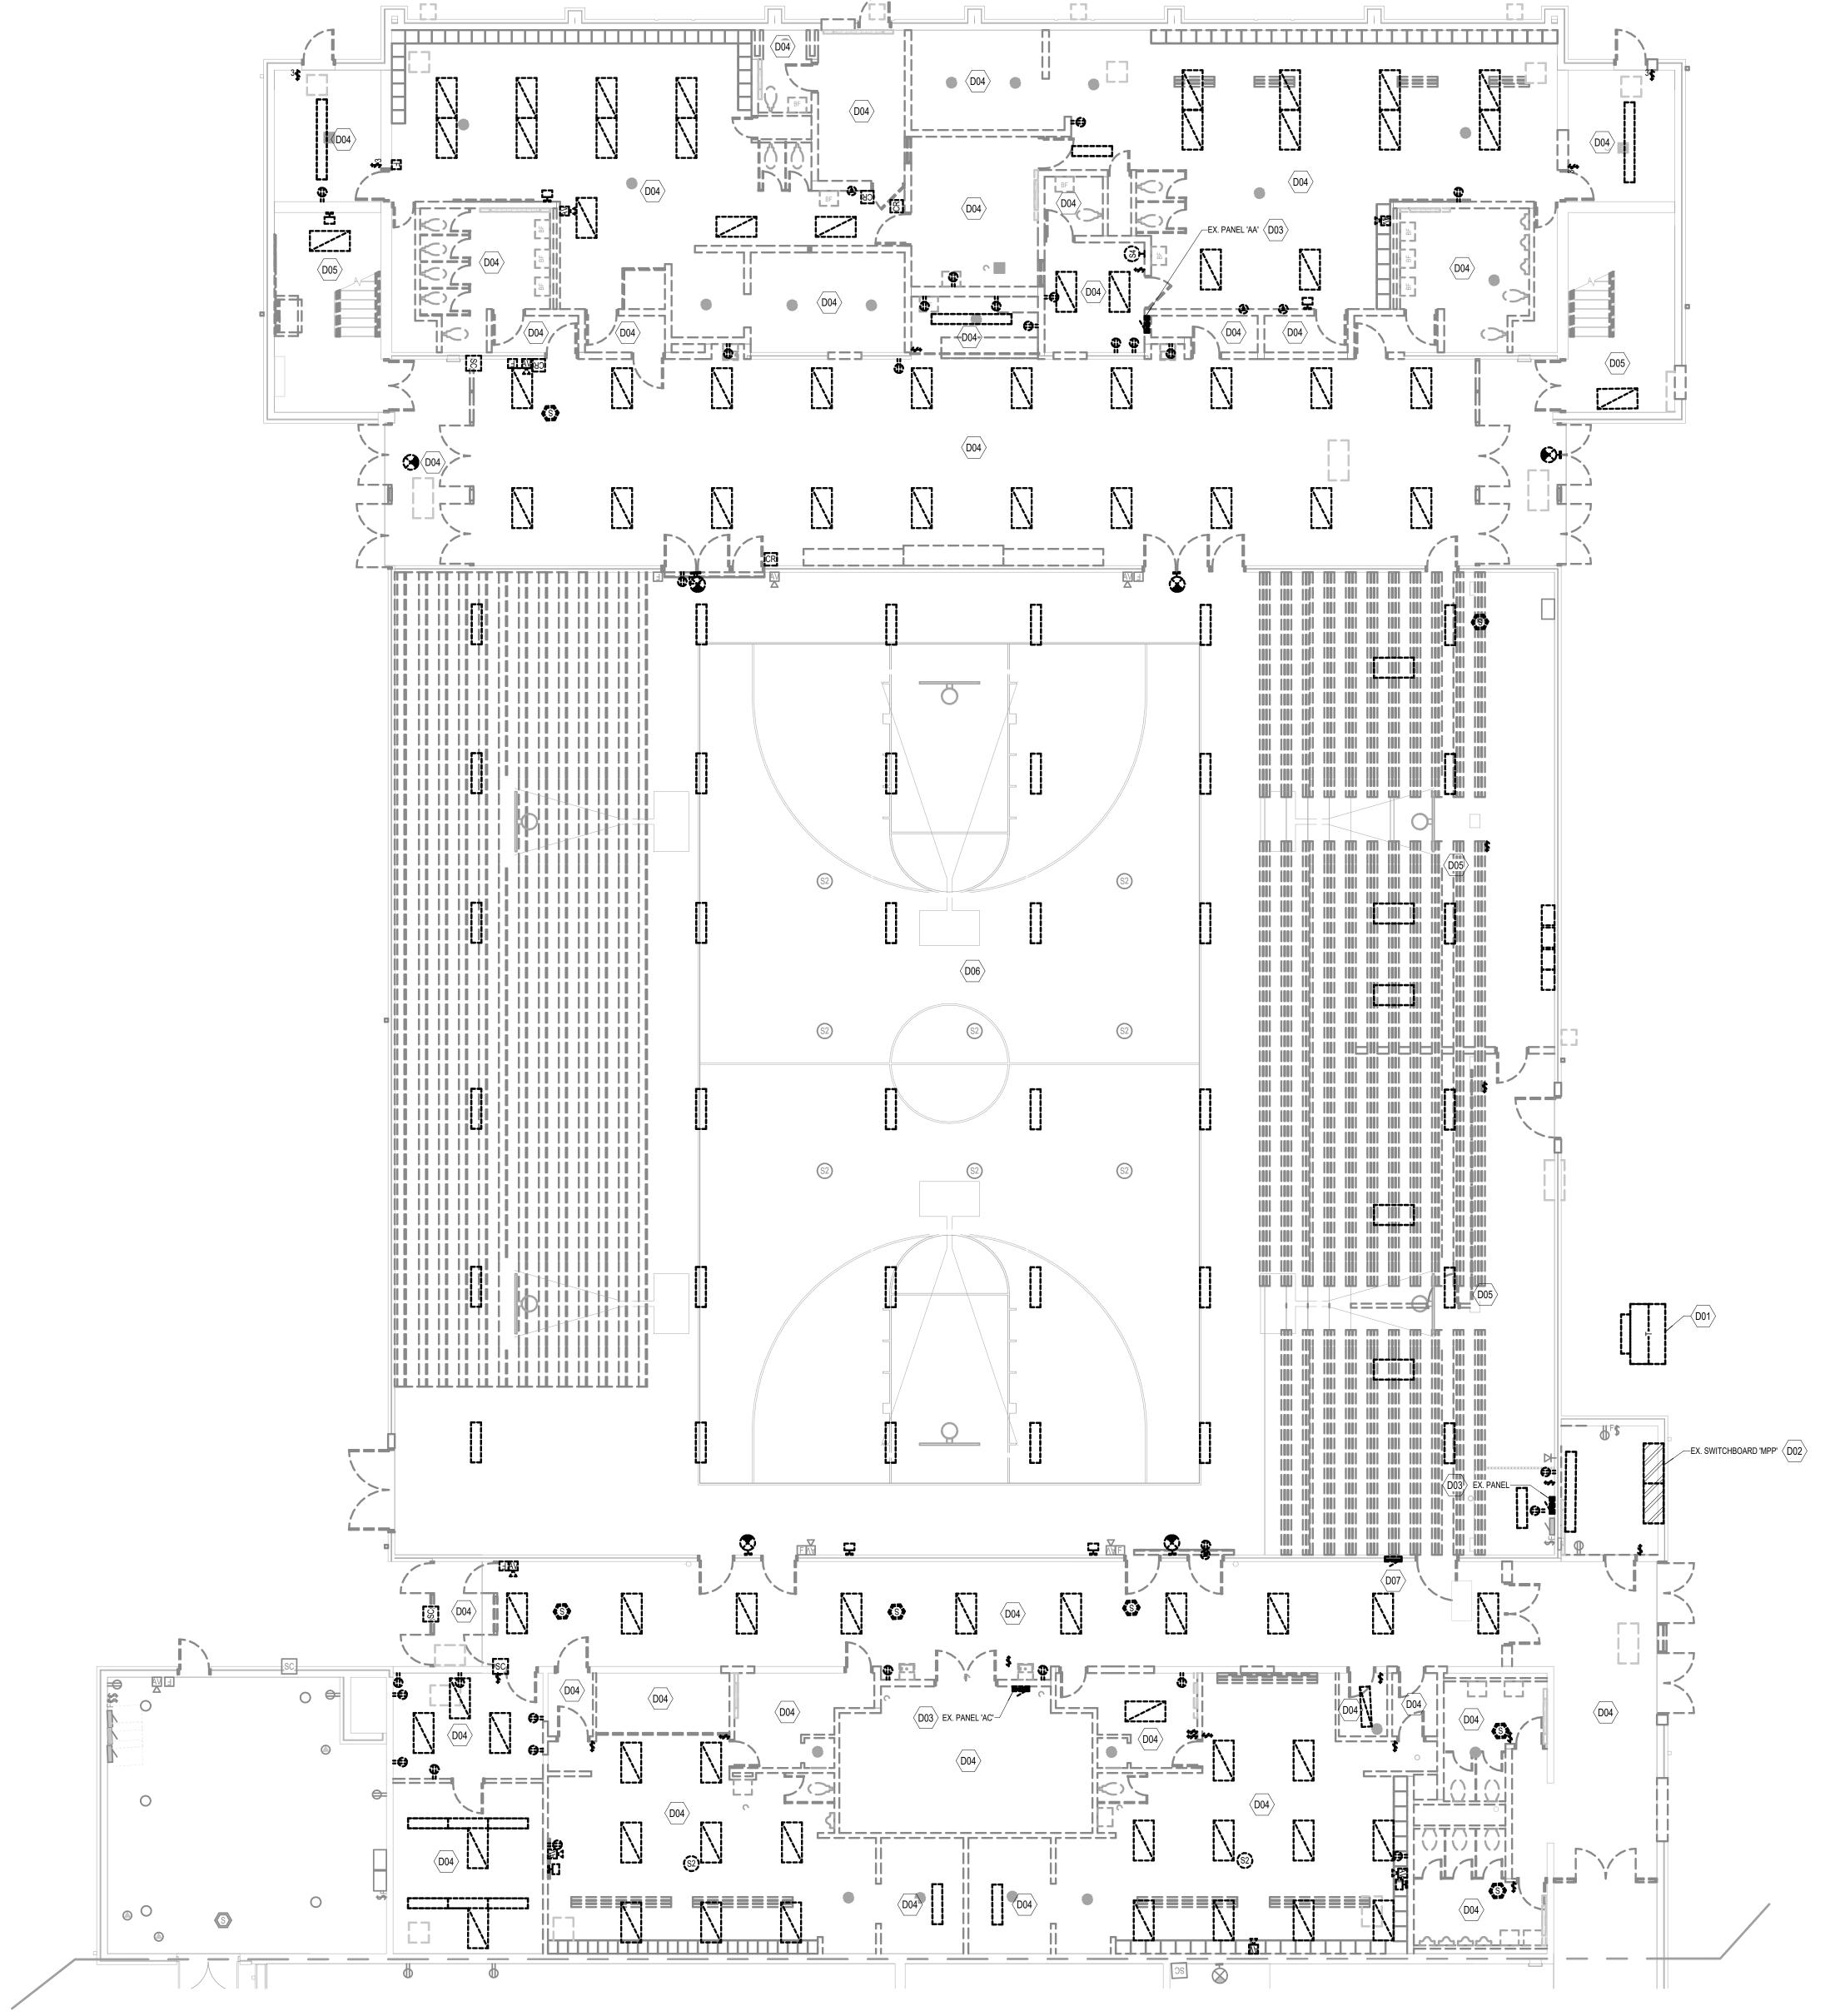

ELECTRICAL DEMOLITION GENERAL NOTES

- REMOVE ALL ITEMS SHOWN ON DEMO PLAN, UNLESS OTHERWISE NOTED. REMOVE
 ALL UNUSED CONDUIT, RACEWAYS, WIRE, CABLE, CONTROLS, JUNCTION BOXES,
 DISCONNECTS, MOUNTS, AND RELATED ELECTRICAL ACCESSORIES COMPLETELY
 BACK TO SOURCE. REFER TO DEMOLITION SPECIFICATION.
- MAKE PROVISIONS TO BACKFEED OR RE-CIRCUIT ANY ITEMS THAT ARE EXISTING TO REMAIN WHICH ARE AFFECTED BY THE DEMOLITIONS.
- 3. THE OWNER RESERVES THE RIGHT TO SALVAGE, WHOLE OR IN PART, ANY EQUIPMENT, SYSTEMS, AND/OR MATERIALS THAT ARE SCHEDULED FOR DEMOLITION PRIOR TO REMOVAL FROM THE BUILDING/SITE. THE CONTRACTOR SHALL BE RESPONSIBLE FOR DISCONNECTION AND GATHERING OF SUCH ITEMS TO A CENTRAL LOCATION AGREED UPON BY THE OWNER AND CONTRACTOR. ALL REMAINING EQUIPMENT AND/OR MATERIALS REMOVED AND NOT REUSED ON THE PROJECT SHALL BECOME THE PROPERTY OF THE CONTRACTOR AND SHALL BE REMOVED FROM THE BUILDING/SITE.
- 4. ALL EQUIPMENT AND/OR MATERIALS SLATED FOR REUSE SHALL BE CAREFULLY REMOVED AND STORED TO PREVENT DAMAGE AND REINSTALLED AS WORK PROGRESSES.
- 5. ALL DEMOLITION SHOWN IS GATHERED FROM FIELD OBSERVATION AND/OR RECORD DRAWINGS. INVESTIGATION OF EXISTING SYSTEMS WILL BE REQUIRED BY THE CONTRACTOR AS PART OF THE BID PRICE, SO THAT THE EXACT EXTENT OF DEMOLITION CAN BE ACCURATELY DETERMINED. THE CONTRACTOR'S BID PRICE SHALL ALSO INCLUDE REMOVAL OF SOME PORTIONS OF SYSTEMS NOT EXPLICITLY SHOWN ON THIS DRAWING, BUT DISCOVERED DURING THE INVESTIGATION PROCESS. WHERE THE EXTENT OF DEMOLITION IS UNCLEAR, THE CONTRACTOR SHALL CONSULT WITH THE ARCHITECT/ENGINEER AND OWNER TO DETERMINE WHICH PORTIONS OF EXISTING SYSTEMS MUST REMAIN ACTIVE AND WHICH PORTIONS MUST BE DEMOLISHED.
- 6. CONTRACTOR SHALL FIELD VERIFY ACTUAL LOCATION AND SIZES OF EXISTING CONDUIT, WIRING, AND EQUIPMENT.
- 7. IF ASBESTOS OR PCB MATERIAL IS ENCOUNTERED IT WILL BE REMOVED BY THE OWNER.
- 8. LAMPS CONTAINING MERCURY (FLUORESCENT, METAL HALIDE, SODIUM VAPOR, MERCURY VAPOR, ETC.) SHALL BE DISPOSED OF IN A PROPER HAZARDOUS WASTE
- 9. PATCH AND REPAIR ALL FLOOR, WALL AND CEILING OPENINGS DUE TO DEMOLITION WHICH ARE NOT TO BE RE-USED TO MATCH EXISTING CONSTRUCTION.
- 10. CONTRACTOR SHALL PROTECT ALL WALLS, CEILINGS, FLOORS, LIGHTS, AND OTHER FINISHED SURFACES THAT ARE NOT TO BE REMOVED. IF DAMAGED, CONTRACTOR SHALL REPAIR TO MATCH EXISTING CONDITIONS AT NO ADDITIONAL COST TO THE
- 11. BACKFILLING SHALL PROMPTLY FOLLOW UNDERGROUND DEMOLITION OR REMOVAL WORK AND SHALL CONTINUE AS THE DEMOLITION PROGRESSES.
- 12. EXISTING CONDUIT SYSTEMS MAY BE REUSED FOR THE INSTALLATION OF NEW CONDUCTORS IF THEY ARE DEEMED TO BE IN GOOD CONDITION AND OF ADEQUATE SIZE FOR CODE-COMPLIANT INSTALLATION OF THE NEW CONDUCTORS. REVISE / REROUTE CONDUIT AS NECESSARY TO PROVIDE FEEDS PER POWER AND/OR LIGHTING PLANS
- PROVIDE BLANK COVER OVER ANY ABANDONED AND REMAINING ROUGH-INS OR JUNCTION BOXES TO MATCH EXISTING.
- MAINTAIN ACCESS CONTROL DEVICES AT EVERY DOOR AND REINSTALL IN NEW DOOR.
 THIS APPLIES TO EVERY DOOR WITH ACCESS CONTROL THROUGHOUT BUILDING.
- 15. DEMOLISH FIRE ALARM SYSTEMS IN ENTIRETY INCLUDING ALL EQUIPMENT, DEVICES, AND WIRING. EXISTING PATHWAYS FOUND IN GOOD CONDITION MAY BE REUSED.

ELECTRICAL KEYNOTES

- D01 COORDINATE WITH THE LOCAL UTILITY TO RELOCATE THE EXISTING UTILIT TRANSFORMER. DEMOLISH THE EXISTING SERVICE FEEDERS TO EXISTING SWITCHBOARD 'MPP'.

 D02 DEMOLISH EXISTING SWITCHBOARD 'MPP'. MAINTAIN EXISTING FEEDERS A
- EXTEND TO NEW SWITCHBOARD 'SB1' LOCATION.

 D03 DEMOLISH EXISTING PANELBOARD AND FEEDER BACK TO SOURCE. MAINTAIL EXISTING BRANCH CIRCUITS AND EXTEND TO NEW PANELBOARD LOCATION.

 D04 DEMOLISH ALL LIGHTING FIXTURES, LIGHTING CONTROLS, RECEPTACLES,
- DEMOLISH COMMUNICATIONS CABLING FOR OUTLETS AND SECURITY
 CAMERAS BACK TO SOURCE. DEMOLISH ALL SPEAKER CABLING. DEMOLISH
 ALL FIRE ALARM CABLING. MAINTAIN AND REUSE ACCESS CONTROL CABLING
 WHERE POSSIBLE.

 DEMOLISH ALL LIGHTING FIXTURES AND LIGHTING CONTROLS WITHIN SPACE

COMMUNICATIONS OUTLETS, PUBLIC ADDRESS SPEAKERS, AND FIRE ALARM

DEVICES WITHIN SPACE. SALVAGE ALL ACCESS CONTROL DEVICES AND SECURITY CAMERAS. DEMOLISH BRANCH CIRCUITS BACK TO SOURCE.

DEMOLISH LIGHTING BRANCH CIRCUITS BACK TO SOURCE. ALL OTHER
CEILING MOUNTED DEVICES SHALL BE MAINTAINED AND REINSTALLED IN TH
NEW CEILING UNLESS NOTED OTHERWISE.

DEMOLISH ALL LIGHTING FIXTURES AND LIGHTING CONTROLS WITHIN

GYMNASIUM. DEMOLISH LIGHTING BRANCH CIRCUITS BACK TO SOURCE.

DEMOLISH PANEL AND ASSOCIATED FEEDER BACK TO SOURCE.

♦ KEYPLAN

PE10910251

STATE OF

2025.03.18

1. REFER TO ELECTRICAL GENERAL NOTES ON SHEET E0.01.

2. REFER TO CODE COMPLIANCE PLAN FOR LOCATIONS AND RATINGS OF VERTICAL AND HORIZONTAL BUILDING ASSEMBLIES. PROVIDE APPROPRIATE FIRESTOPPING SYSTEMS PER SPECIFICATIONS TO MEET ALL APPLICABLE

3. ALL GENERAL-USE 15- AND 20-AMPERE, 125- AND 250-VOLT NON-LOCKING RECEPTACLES SHALL BE TAMPER-RESISTANT TYPE; REFER TO NEC 406.12 AND SPECIFICATION SECTION 26 27 26.

4. PROVIDE 120VAC POWER FOR ALL SMOKE DAMPERS AND COMBINATION FIRE/SMOKE DAMPERS. A. REFER TO MECHANICAL/HVAC DRAWINGS FOR LOCATIONS AND QUANTITIES B. CONNECT TO DEDICATED 20A BRANCH CIRCUIT (WITH BREAKER LOCK-ON ACCESSORY) IN LOCAL PANELBOARD FOR DAMPER(S) IN EACH AREA (DAMPERS MAY BE GROUPED ON EACH CIRCUIT).

C. TERMINATE W/ BOX-COVER FUSIBLE DISCONNECT SWITCH AT EACH

D. PROVIDE FIRE ALARM DUCT SMOKE DETECTOR WITHIN 5 FEET OF EACH DAMPER (UNLESS COVERED BY ANOTHER DUCT DETECTOR WITHIN 5 FEET). E. PROVIDE FIRE ALARM ADDRESSABLE RELAY(S) FOR INTERLOCKING DAMPER W/ CORRESPONDING HVAC UNIT(S) PER CODE REQUIREMENTS.

5. PROVIDE BOX-COVER FUSIBLE DISCONNECT SWITCH (ON BUILDING INTERIOR IN ACCESSIBLE LOCATION) FOR EACH SMALL (< 1/2 HP) MECHANICAL AND/OR PLUMBING EQUIPMENT MOTOR LOAD WHERE MORE THAN ONE UNIT IS CONNECTED TO A COMMON BRANCH CIRCUIT. TYPICAL EQUIPMENT TYPES INCLUDE BUT ARE NOT LIMITED TO CABINET HEATERS, DAMPERS, EXHAUST FANS, FAN COIL UNITS, PUMPS, UNIT HEATERS, VAV BOXES, ETC.

6. DESIGNATED CABLING PATHWAYS (CONDUITS, CABLE TRAYS, PENETRATION SLEEVES, ETC.) SHALL BE RESERVED FOR DIV. 27 COMMUNICATIONS CABLING AND DIV. 28 SAFETY/SECURITY CABLING ONLY. OTHER CABLING TYPES, SUCH AS DIV. 23 CONTROLS, DIV. 26 CONTROLS, AND ARCHITECTURAL EQUIPMENT CABLING SHALL BE SUPPORTED AND SLEEVED BY OTHER INDEPENDENT PATHWAYS, HANGERS, AND SUPPORTS.

7. PROVIDE INFRASTRUCTURE ONLY FOR COMMUNICATIONS, ACCESS CONTROL, AND FIRE ALARM SYSTEMS. DEVICES SHOWN TO PROVIDE QUANTITIES ONLY. COORDINATE FINAL LOCATIONS OF ALL DEVICES WITH INSTALLER PRIOR TO

ELECTRICAL KEYNOTES

P01 COORDINATE WITH THE LOCAL UTILITY TO INSTALL THE RELOCATED EXIS UTILITY TRANSFORMER. PROVIDE NEW SECONDARY FEEDERS FROM TRANSFORMER TO SWITCHBOARD 'SB1'. P02 PROVIDE NEW SWITCHBOARD TO REPLACE THE EXISTING SWITCHBOARD 'MPP'. EXTEND EXISTING FEEDERS AS NECESSARY TO TERMINATE AT NEW SWITCHBOARD.

DEVICES.

P05 MOUNT RECEPTACLES BEHIND EX. TELECOMMUNICATIONS RACK WHERE DIRECTED BY THE OWNER.


P03 MOUNT RECEPTACLES IN CASEWORK.
P04 REPLACE ALL RECEPTACLES AND FACEPLATES IN GYMNASIUM WITH NEW

P08 POWER SUPPLY FOR BLEACHERS. CONFIRM POWER REQUIREMENTS WITH SHOP DRAWINGS PRIOR TO ROUGH-IN. P09 POWER SUPPLY AND COMMUNICATIONS ROUGH-IN FOR SCOREBOARD. CONFIRM POWER REQUIREMENTS WITH SHOP DRAWINGS PRIOR TO

P10 POWER FOR MOTORIZED BASKETBALL BACKBOARD. CONFIRM POWER REQUIREMENTS WITH SHOP DRAWINGS PRIOR TO ROUGH. MOUNT DISCONNECT TO STRUCTURE ADJACENT TO MOTOR. CIRCUIT HOMERUN THROUGH WALL CONTROLS. INSTALL CONTROLS WHERE DIRECTED BY P11 MOUNT RECEPTACLE ON PLATFORM ABOVE BLEACHERS.

P12 PROVIDE BOX-COVER FUSIBLE DISCONNECT SWITCH ABOVE CEILING WERE ACCESSIBLE FOR ALL CABINET UNIT HEATERS. INSTALL SWITCH ADJACENT TO EQUIPMENT WHERE POSSIBLE. PROVIDE 5A FUSE. CONFIRM FUSE SIZE WITH FINAL APPROVED MANUFACTURER. P14 MOUNT DISCONNECT SWITCH ON WALL ADJACENT TO EQUIPMENT. SOUND SYSTEM RACK LOCATION. CONFIRM WITH OWNER PRIOR TO

♦ KEYPLAN

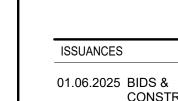

01.06.2025 BIDS & CONSTRUCTION 01.16.2025 ADDENDUM 001 01.22.2025 ADDENDUM 002 03.13.2025 BULLETIN 001

DRAWN JDM REVIEWED SMS


PROJECT NO. NO PART OF THIS DRAWING MAY BE USED OR REPRODUCED IN ANY FORM OR BY ANY MEANS, OR STORED IN A DATA BASE OR RETRIEVAL SYSTEM, WITHOUT PRIOR WRITTEN

UNIT 'A' FIRST FLOOR POWER & COMMUNICATIONS PLAN

GMB COPYRIGHT © 2025

ALL RIGHTS RESERVED

E2.1A

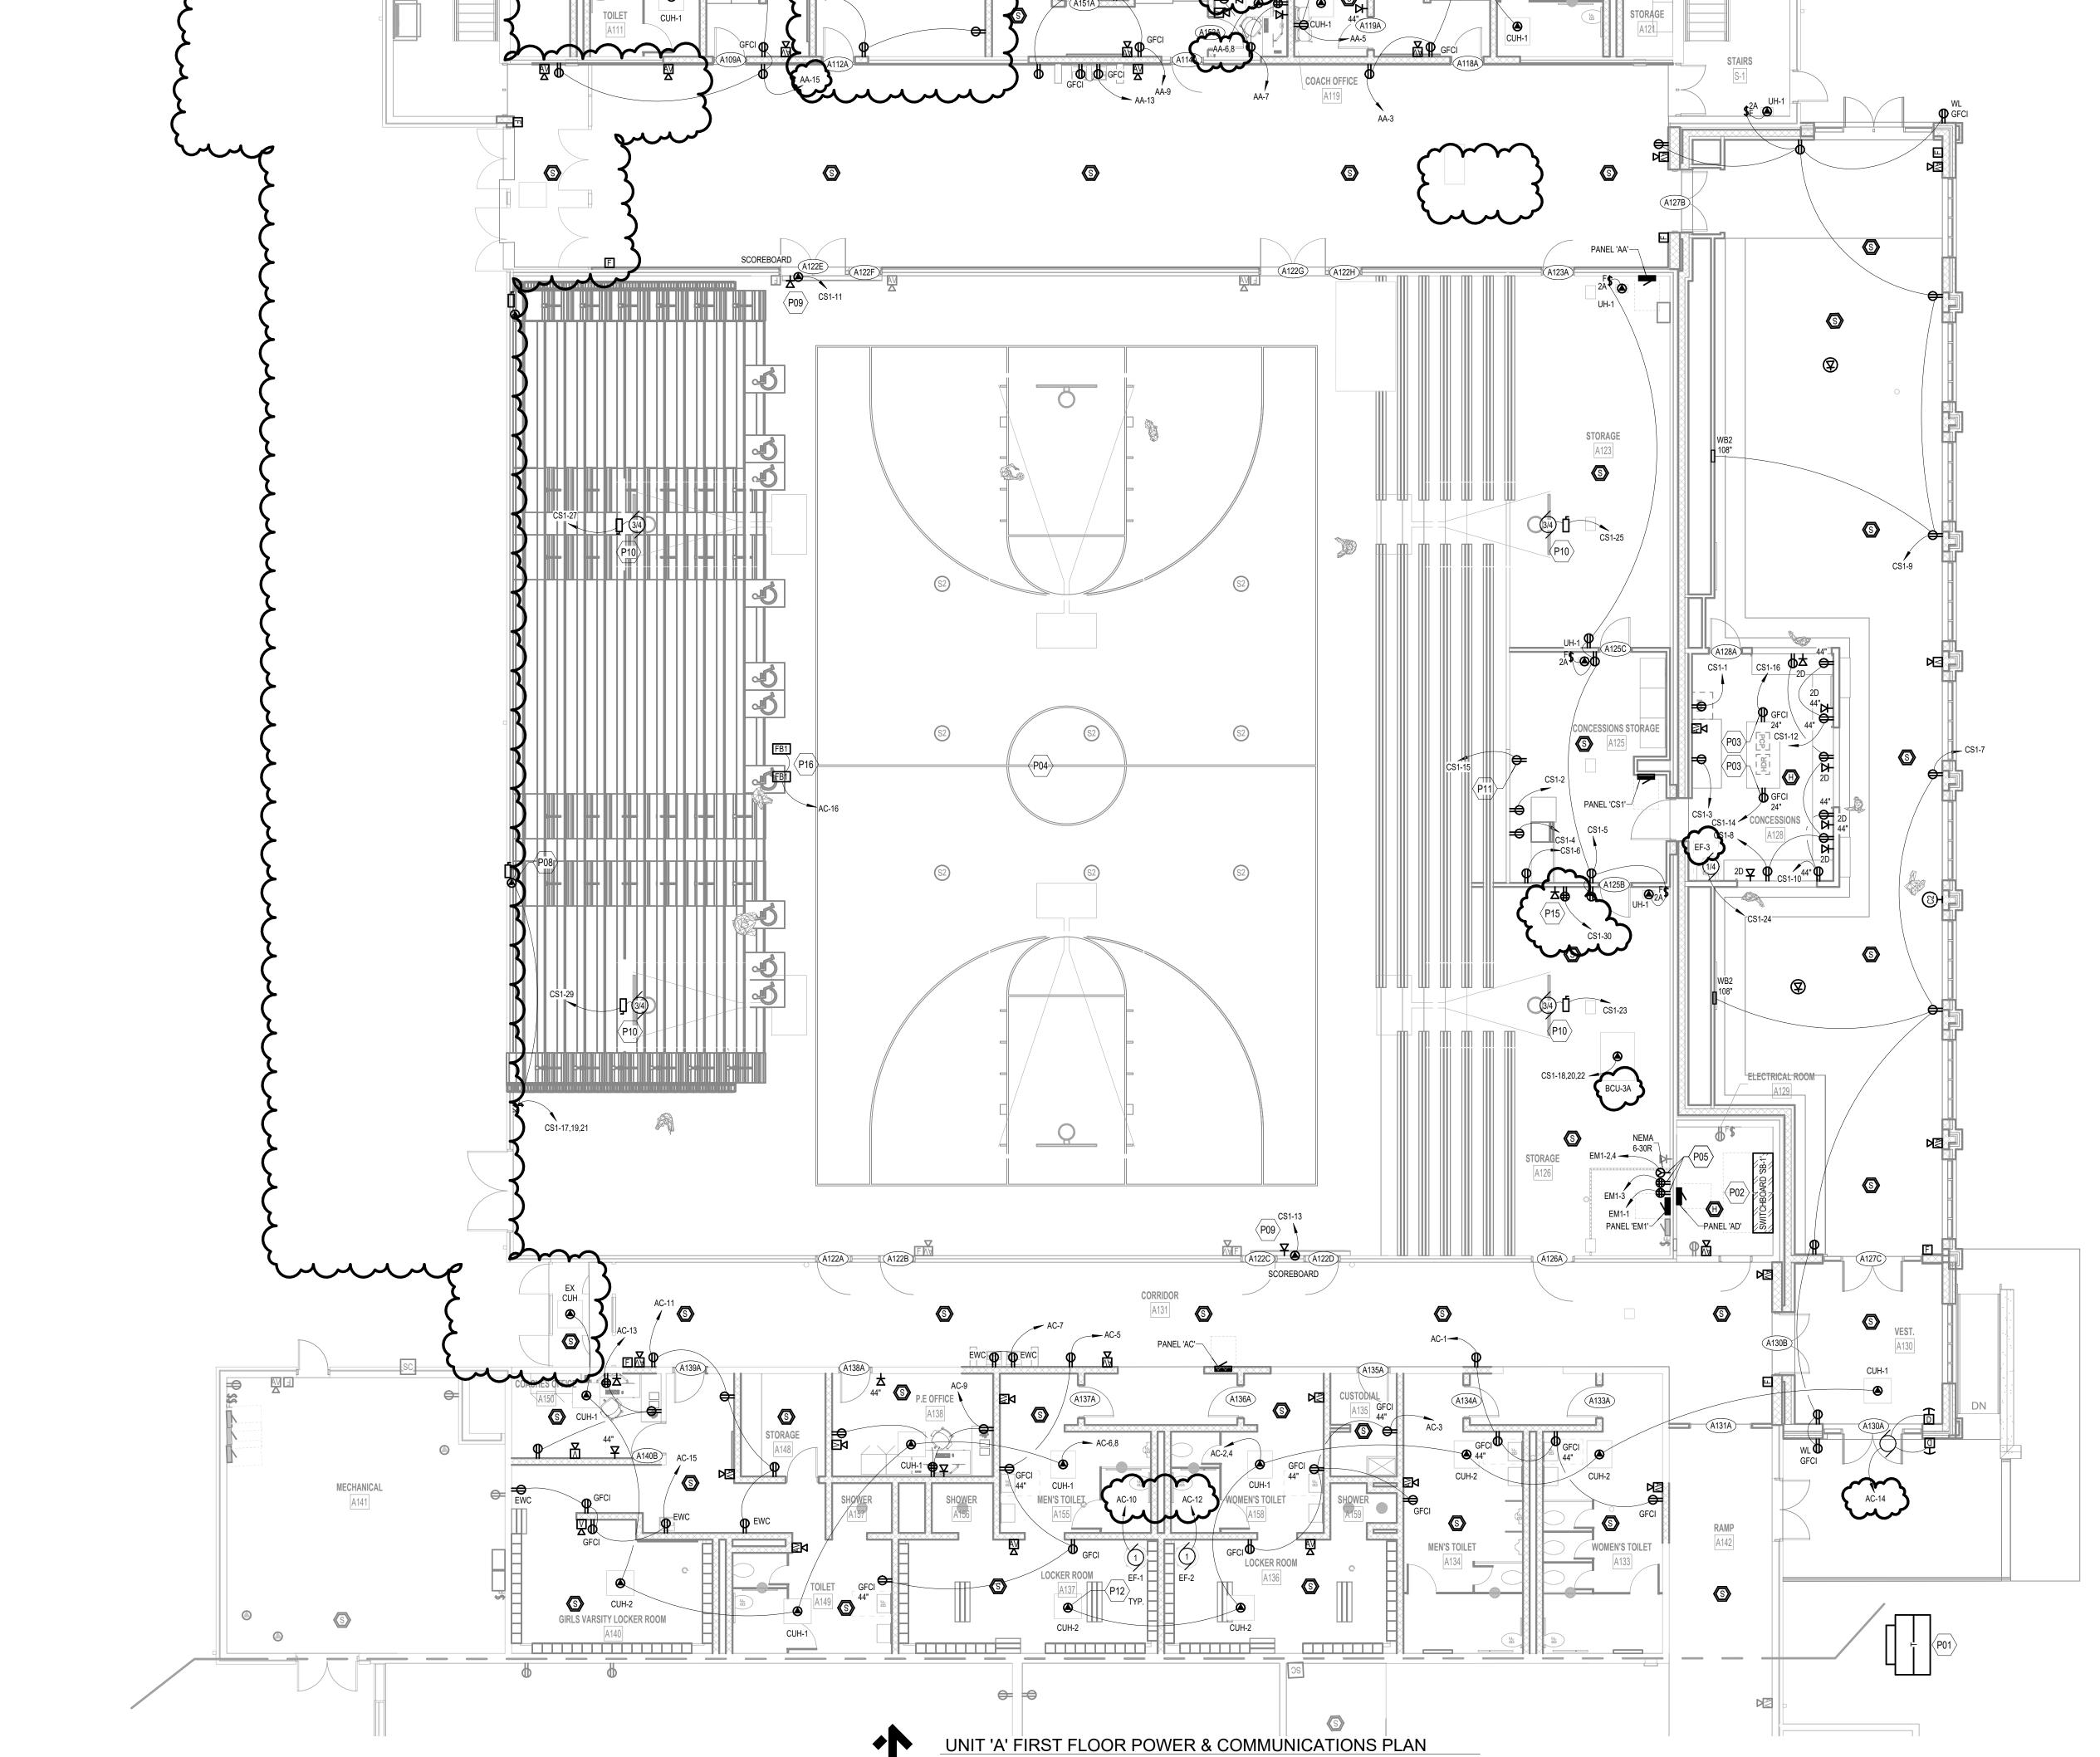

FOOTBALL LOCKER ROOM

MENS BASKETBALL LOCKER ROOM

ATHLETIC DIRECTOR OFFICE

PE10910251

STATE OF

2025.03.18


01.06.2025 BIDS & CONSTRUCTION 03.13.2025 BULLETIN 001

DRAWN JDM REVIEWED SMS NO PART OF THIS DRAWING MAY BE USED OR REPRODUCED IN ANY FORM OR BY ANY MEANS, OR STORED IN A
DATA BASE OR RETRIEVAL SYSTEM,
WITHOUT PRIOR WRITTEN
PERMISSION OF

UNIT 'A' FIRST FLOOR LIGHTING PLAN

GMB COPYRIGHT © 2025 ALL RIGHTS RESERVED

E3.1A

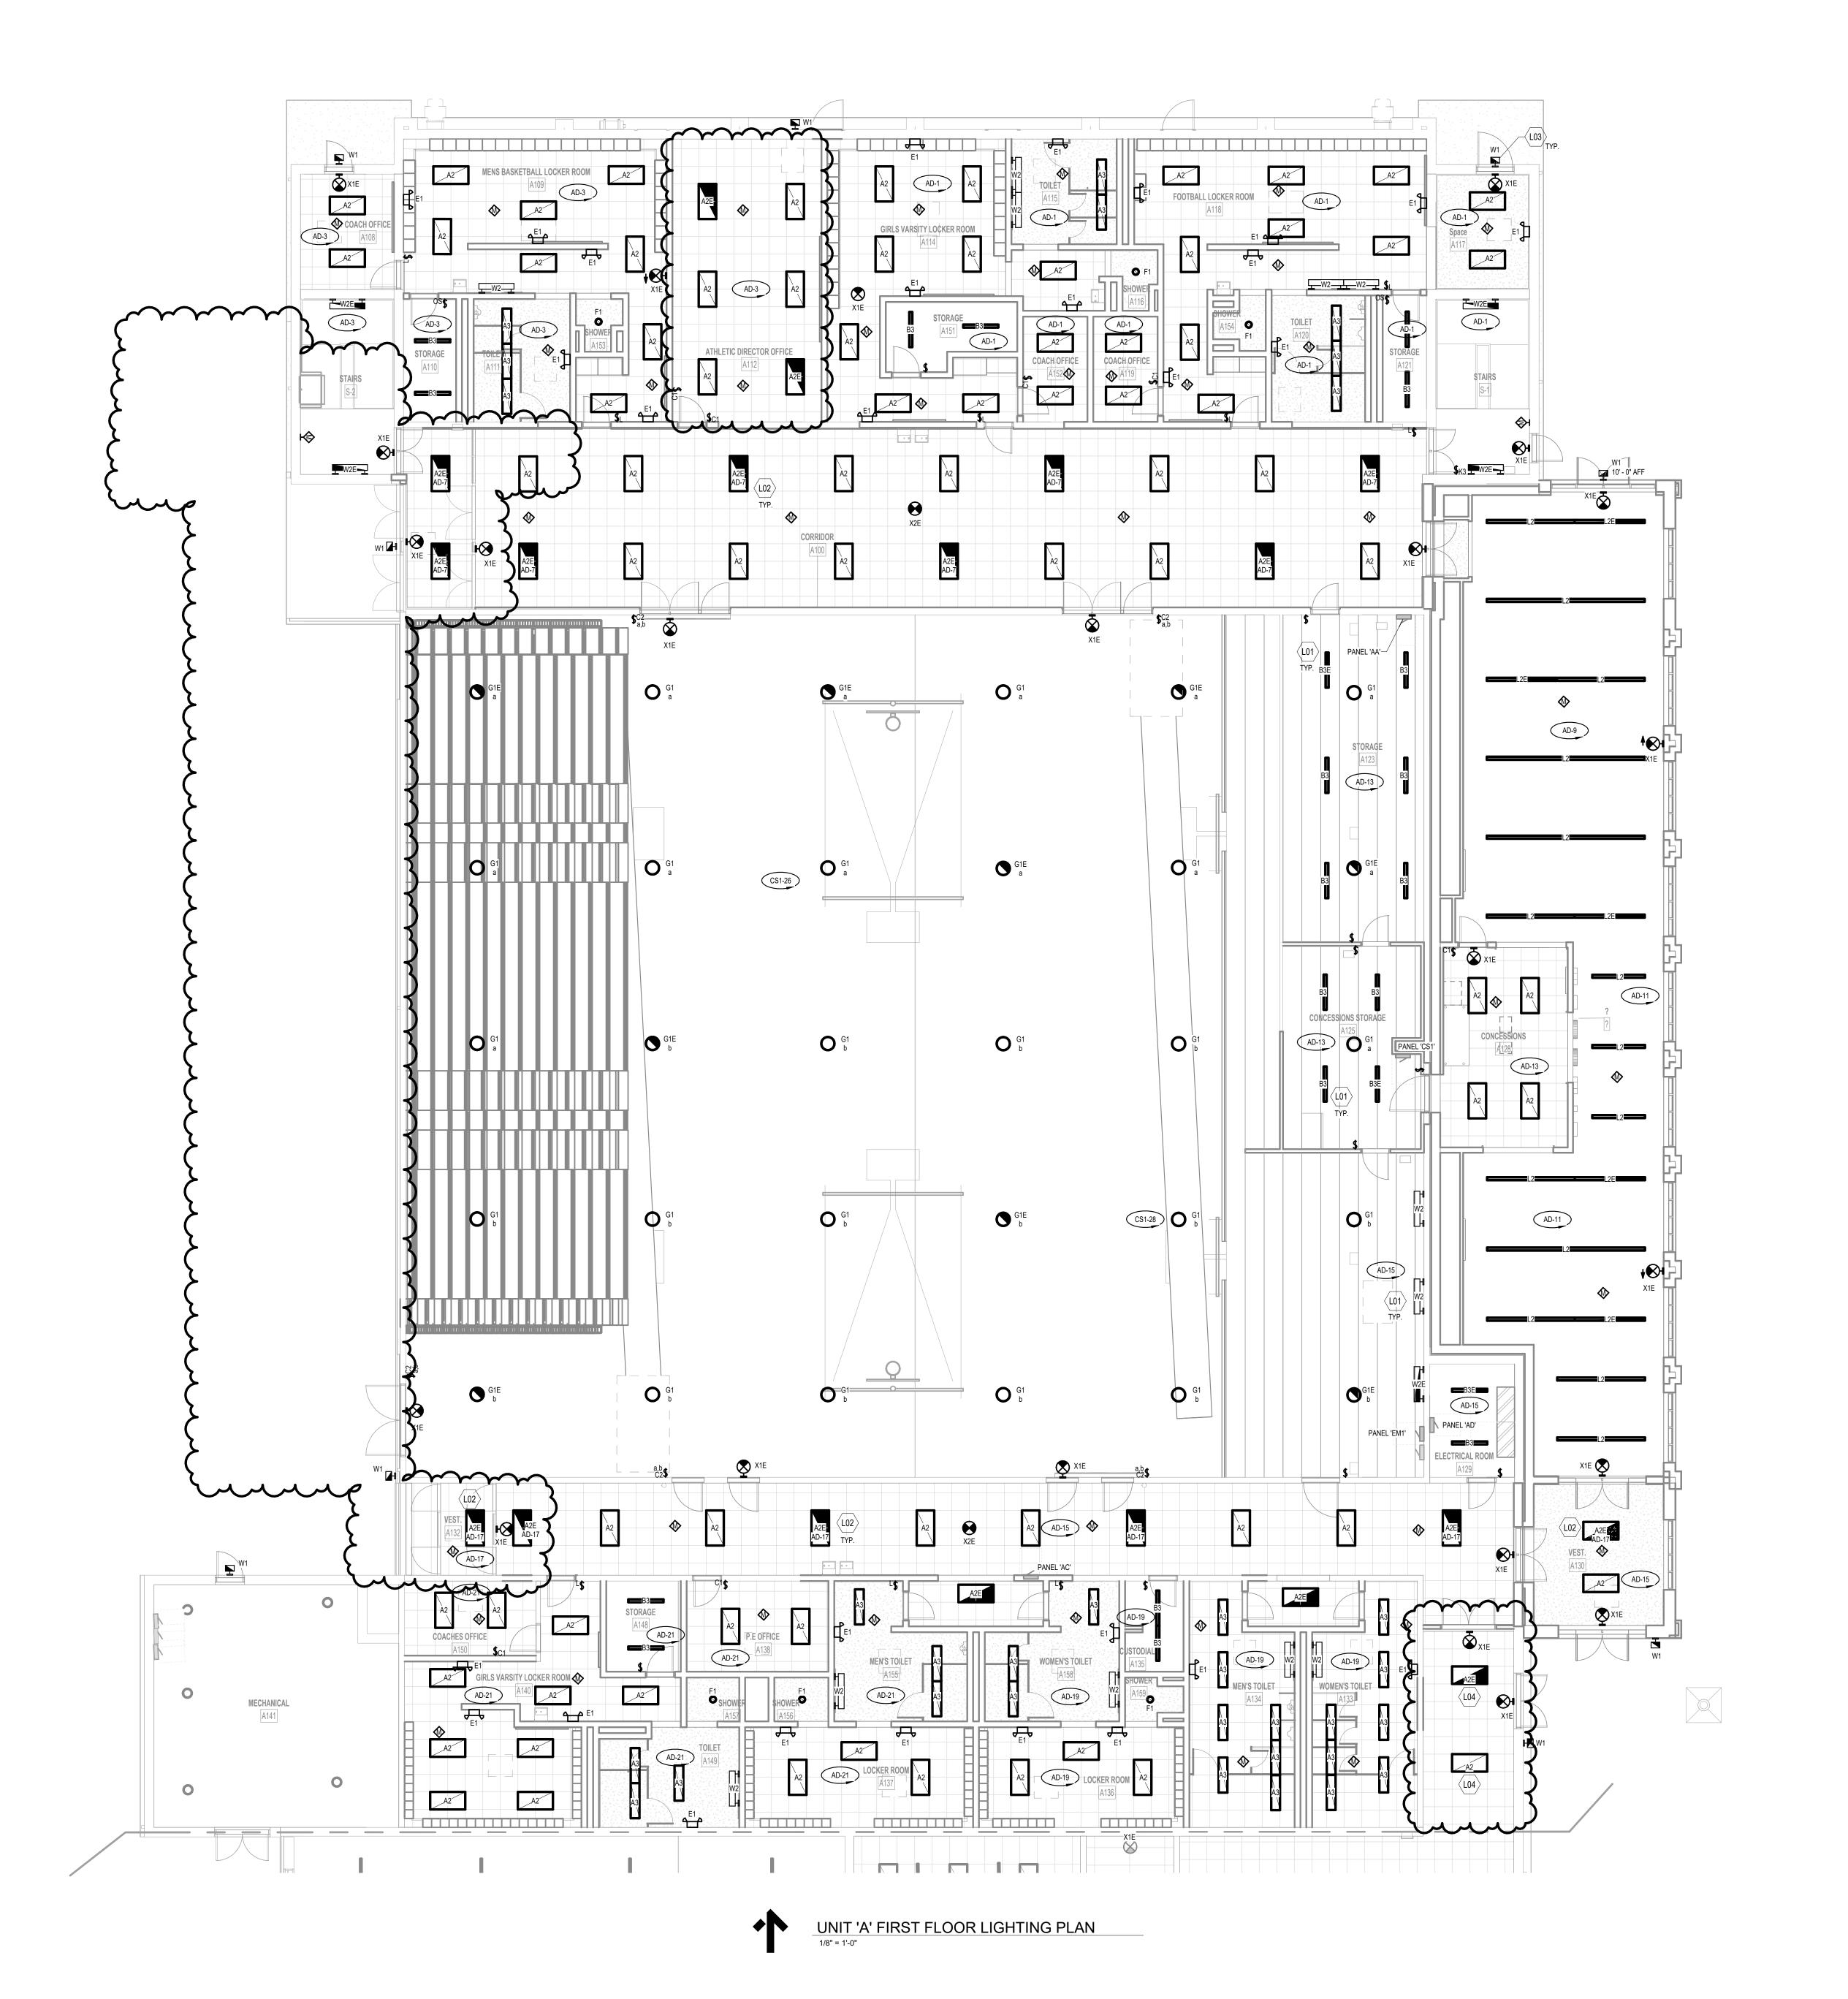


LIGHTING GENERAL NOTES

----- DAYLIGHTING AREA - PRIMARY

———— DAYLIGHTING AREA - SECONDARY LIGHTING TAG - TYPICAL LIGHTING TAG - WITH SPACE I.D. C4 — FIXTURE SPACE I.D. A101.a1 TYPE SPACE I.D. DAYLIGHTING SWITCHING ZONE AREA SWITCHING ZONE CONTROL CHANNEL AREA CONTROL CHANNEL AREA

- EACH CONTROL TAG (a, a1, b1, A101.a1, ETC.) REPRESENTS BOTH THE
 SWITCHING ZONES AND DAYLIGHTING REQUIREMENTS OF THE SPACE AND
 SHALL BE TREATED AS ONE CONTROL CHANNEL RELATIVE TO THE CONTROL
- 2. DAYLIGHTING CONTROLS ARE NOT REQUIRED BY APPLICABLE ENERGY CODE IN SPACES WHERE DAYLIGHTING AREAS ARE NOT SHOWN.
- 3. LIGHTING CONTROL INTENT NARRATIVE TAGS (CIN-__) ARE PLACED WITHIN SPACES FOR REFERENCE TO LIGHTING CONTROL SCHEDULES.
- 4. ALL DIMMING CAPABLE LIGHTING FIXTURES (AS NOTED ON LIGHTING FIXTURE SCHEDULE) SHALL BE WIRED AS SUCH WITH 0-10VDC CONTROL WIRING BACK TO CONTROL DEVICE WALL BOX OR LIGHTING CONTROL PANEL WHETHER OR NOT DIMMING CONTROL DEVICE IS REQUIRED.
- 5. ALL MODULAR LIGHTING CONTROL DEVICES SHALL BE LOCATED WITHIN THE SAME ROOM AS THE CONTROLLED LIGHTING AND IN A CONSISTENT MANNER FROM ROOM-TO-ROOM. PREFERRED LOCATION IS ABOVE ACCESSIBLE CEILING NEAR THE PRIMARY ENTRY DOOR TO THE SPACE IF NO OTHER LOCATION IS
- 6. LIGHTING CONTROL SWITCH AND CONTROL MODULE / POWER PACK SYMBOLS ARE INDICATED FOR REPRESENTATIVE PLACEMENT PURPOSES ONLY AND MAY NOT REFLECT EXACT QUANTITY, SIZE, OR ARRANGEMENT OF BOX(ES) OR DEVICE(S) REQUIRED. A. LIGHTING CONTROLS MANUFACTURER SHALL DETERMINE AND FURNISH PRODUCT LAYOUT/APPLICATION DETAIL AS NECESSARY TO ACHIEVE REQUIRED FUNCTIONALITY AS IDENTIFIED IN SPECIFICATIONS AND ON LIGHTING CONTROL SCHEDULES.

 B. CONTRACTOR SHALL COORDINATE AND DETERMINE EXACT DEVICE INSTALLATION CONFIGURATION WITH MANUFACTURER'S DOCUMENTATION PRIOR TO ROUGH WIRING STAGES OF CONSTRUCTION.
- 7. ALL AC-ONLY (NON-BATTERY) EXIT SIGNS SHALL BE CONNECTED TO LOCAL EMERGENCY LIGHTING BRANCH CIRCUIT AHEAD OF ANY CONTROLS. 8. ALL EXIT SIGNS WITH EMERGENCY BATTERY SHALL BE CONNECTED TO LOCAL LIGHTING BRANCH CIRCUIT AHEAD OF ANY CONTROLS.
- 9. REFER TO ELECTRICAL GENERAL NOTES, LIGHTING CONTROL GENERAL NOTES, AND LIGHTING CONTROL SCHEDULES.

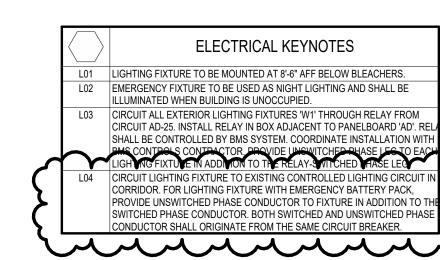

M Sch 2025.03.18

01.06.2025 BIDS &

01.16.2025 ADDENDUM 001

CONSTRUCTION

POWER DISTRIBUTION ONE-LINE DIAGRAMS

GMB COPYRIGHT © 2025 ALL RIGHTS RESERVED


E4.01


METAL FRAME OF BUILDING OR STRUCTURE TRANSFORMER ENCLOSURE /- DISTRIBUTION EQUIPMENT ENCLOSURE WATER PIPE (WITH JUMPER ACROSS BOTH SIDES OF -CONDUIT BUSHING CONDUIT BUSHING --CONDUIT BUSHING WATER METER IF PRESENT) PRIMARY CONDUIT -(FMC OR LFMC) (FMC OR LFM OTHER METAL UNDERGROUND SYSTEMS OR STRUCTURES CONCRETE-ENCASED ELECTRODE: (PIPING, UNDERGROUND AT LEAST 20'-0" OF #4 (1/2" DIA.) MIN. TANKS, WELL CASINGS, ETC.) NEUTRAL BAR/LUG STEEL REINFORCING BARS (ELECTRICALLY-CONTINUOUS) IN G GROUND BAR/LUG 03 G GROUND BAR BUILDING FOOTINGS 1. REFER TO NEC AND SPECIFICATION SECTION 26 05 26 FOR DETAILED GROUNDING ELECTRODE CONDUCTOR REQUIREMENTS. TO GROUNDING ELECTRODE SYSTEM (SIZED PER NEC 250.66) 2. ALL GROUNDING ELECTRODES THAT ARE PRESENT AT EACH BUILDING OR STRUCTURE SERVED SHALL BE BONDED KEYNOTES TOGETHER PER NEC REQUIREMENTS. GROUND BAR/LUG IN DISTRIBUTION B. WHERE NONE OF THESE GROUNDING EQUIPMENT WHERE SYSTEM 01 EQUIPMENT GROUNDING CONDUCTOR (SIZED PER NEC 250.122) 03 SYSTEM BONDING JUMPER ELECTRODES EXIST, ONE OR MORE OF THE BONDING JUMPER IS LOCATED (SIZED PER NEC 250.102) GROUNDING ELECTRODES SPECIFIED IN 02 SUPPLY-SIDE BONDING JUMPER (SIZED PER NEC 250.102) 04 GROUNDING ELECTRODE CONDUCTOR NEC 250.52(A)(4) THROUGH (A)(8) SHALL BE (SIZED PER NEC 250.66) INSTALLED AND USED. SEPARATELY DERIVED SYSTEM GROUNDING/BONDING SCHEMATIC (SYSTEM BONDING AT FIRST DISCONNECTING MEANS OR OVERCURRENT DEVICE)

NOTES:

1 PHASE, 3 WIRE WITH GROUND -OR- 3 PHASE, 3 WIRE WITH GROUND 3 PHASE, 4 WIRE WITH GROUND A100G (3) #1 AWG + (1) #6 AWG GRD IN 1 1/4" CONDUIT A100NG (4) #1 AWG + (1) #6 AWG GRD IN 1 1/4" CONDUIT A120NG (4) #1/0 AWG + (1) #4 AWG GRD IN 1 1/2" CONDUIT A120G | (3) #1/0 AWG + (1) #4 AWG GRD IN 1 1/4" CONDUIT A135NG (4) #2/0 AWG + (1) #4 AWG GRD IN 2" CONDUIT A135G (3) #2/0 AWG + (1) #4 AWG GRD IN 1 1/2" CONDUIT A155G (3) #3/0 AWG + (1) #4 AWG GRD IN 1 1/2" CONDUIT A155NG (4) #3/0 AWG + (1) #4 AWG GRD IN 2" CONDUIT A180G (3) #4/0 AWG + (1) #4 AWG GRD IN 2" CONDUIT A180NG (4) #4/0 AWG + (1) #4 AWG GRD IN 2" CONDUIT A205G (3) 250 KCMIL + (1) #2 AWG GRD IN 2" CONDUIT A205NG (4) 250 KCMIL + (1) #2 AWG GRD IN 2 1/2" CONDUIT A230NG (4) 300 KCMIL + (1) #2 AWG GRD IN 2 1/2" CONDUIT A230G (3) 300 KCMIL + (1) #2 AWG GRD IN 2 1/2" CONDUIT A250G (3) 350 KCMIL + (1) #2 AWG GRD IN 2 1/2" CONDUIT A250NG (4) 350 KCMIL + (1) #2 AWG GRD IN 3" CONDUIT A270G (3) 400 KCMIL + (1) #2 AWG GRD IN 2 1/2" CONDUIT A270NG (4) 400 KCMIL + (1) #2 AWG GRD IN 3" CONDUIT A310G (3) 500 KCMIL + (1) #1 AWG GRD IN 3" CONDUIT A310NG (4) 500 KCMIL + (1) #1 AWG GRD IN 3" CONDUIT A340G (3) 600 KCMIL + (1) #1 AWG GRD IN 3" CONDUIT A340NG (4) 600 KCMIL + (1) #1 AWG GRD IN 3 1/2" CONDUIT A400NG TWO PARALLEL [(4) 250 KCMIL + (1) #1 AWG GRD IN 2 1/2" CONDUIT] A400G TWO PARALLEL [(3) 250 KCMIL + (1) #1 AWG GRD IN 2" CONDUIT] A500G TWO PARALLEL [(3) 350 KCMIL + (1) #1/0 AWG GRD IN 2 1/2" CONDUIT] A500NG TWO PARALLEL [(4) 350 KCMIL + (1) #1/0 AWG GRD IN 3" CONDUIT] A600NG TWO PARALLEL [(4) 500 KCMIL + (1) #2/0 AWG GRD IN 3" CONDUIT] A600G TWO PARALLEL [(3) 500 KCMIL + (1) #2/0 AWG GRD IN 3" CONDUIT] A800NG THREE PARALLEL [(4) 500 KCMIL + (1) #3/0 AWG GRD IN 3" CONDUIT] A800G THREE PARALLEL [(3) 500 KCMIL + (1) #3/0 AWG GRD IN 3" CONDUIT] A1000G FOUR PARALLEL [(3) 350 KCMIL + (1) #4/0 AWG GRD IN 2 1/2" CONDUIT] A1000NG FOUR PARALLEL [(4) 350 KCMIL + (1) #4/0 AWG GRD IN 3" CONDUIT] A1200G FOUR PARALLEL [(3) 500 KCMIL + (1) 250 KCMIL GRD IN 3" CONDUIT] A1200NG FOUR PARALLEL [(4) 500 KCMIL + (1) 250 KCMIL GRD IN 3" CONDUIT] A1600G SIX PARALLEL [(3) 500 KCMIL + (1) 350 KCMIL GRD IN 3" CONDUIT] A1600NG | SIX PARALLEL [(4) 500 KCMIL + (1) 350 KCMIL GRD IN 3 1/2" CONDUIT] A2000G | SEVEN PARALLEL [(3) 500 KCMIL + (1) 500 KCMIL GRD IN 3 1/2" CONDUIT] | A2000NG | SEVEN PARALLEL [(4) 500 KCMIL + (1) 500 KCMIL GRD IN 3 1/2" CONDUIT] A2500G | EIGHT PARALLEL [(3) 600 KCMIL + (1) 600 KCMIL GRD IN 3 1/2" CONDUIT] | A2500NG | EIGHT PARALLEL [(4) 600 KCMIL + (1) 600 KCMIL GRD IN 3 1/2" CONDUIT] A3000G NINE PARALLEL [(3) 600 KCMIL + (1) 600 KCMIL GRD IN 3 1/2" CONDUIT] A3000NG NINE PARALLEL [(4) 600 KCMIL + (1) 600 KCMIL GRD IN 3 1/2" CONDUIT] NOTE: DESIGNATIONS WITH "NN" (E.G. "A230NNG") SHALL BE SIMILAR TO THE REQUIRED "N" FEEDER EXCEPT WITH DOUBLE (200%) NEUTRAL CONDUCTOR.

LOW-VOLTAGE FEEDER SCHEDULE LOW-VOLTAGE FEEDER SCHEDULE BASED ON NEC TABLE 310.15(B)(16) FOR COMPACT ALUMINUM CONDUCTORS APPLIED AT 75°C RATING BASED ON NEC TABLE 310.15(B)(16) FOR COPPER CONDUCTORS APPLIED AT 75°C RATING 1 PHASE, 3 WIRE WITH GROUND -OR- 3 PHASE, 3 WIRE WITH GROUND 3 PHASE, 4 WIRE WITH GROUND 20G (3) #12 AWG + (1) #12 AWG GRD IN 3/4" CONDUIT 20NG (4) #12 AWG + (1) #12 AWG GRD IN 3/4" CONDUIT 30G (3) #10 AWG + (1) #10 AWG GRD IN 3/4" CONDUIT 30NG (4) #10 AWG + (1) #10 AWG GRD IN 3/4" CONDUIT 50G (3) #8 AWG + (1) #10 AWG GRD IN 3/4" CONDUIT 50NG (4) #8 AWG + (1) #10 AWG GRD IN 1" CONDUIT 65G (3) #6 AWG + (1) #8 AWG GRD IN 1" CONDUIT 65NG (4) #6 AWG + (1) #8 AWG GRD IN 1" CONDUIT 85G (3) #4 AWG + (1) #8 AWG GRD IN 1" CONDUIT 85NG (4) #4 AWG + (1) #8 AWG GRD IN 1 1/4" CONDUIT 100G (3) #3 AWG + (1) #8 AWG GRD IN 1 1/4" CONDUIT 100NG (4) #3 AWG + (1) #8 AWG GRD IN 1 1/4" CONDUIT 115G (3) #2 AWG + (1) #6 AWG GRD IN 1 1/4" CONDUIT 115NG | (4) #2 AWG + (1) #6 AWG GRD IN 1 1/2" CONDUIT 130G (3) #1 AWG + (1) #6 AWG GRD IN 1 1/2" CONDUIT 130NG (4) #1 AWG + (1) #6 AWG GRD IN 2" CONDUIT 150G (3) #1/0 AWG + (1) #6 AWG GRD IN 1 1/2" CONDUIT 150NG (4) #1/0 AWG + (1) #6 AWG GRD IN 2" CONDUIT 175G (3) #2/0 AWG + (1) #6 AWG GRD IN 2" CONDUIT 175NG (4) #2/0 AWG + (1) #6 AWG GRD IN 2" CONDUIT 200G (3) #3/0 AWG + (1) #6 AWG GRD IN 2" CONDUIT 200NG (4) #3/0 AWG + (1) #6 AWG GRD IN 2 1/2" CONDUIT 230G (3) #4/0 AWG + (1) #4 AWG GRD IN 2 1/2" CONDUIT 230NG (4) #4/0 AWG + (1) #4 AWG GRD IN 2 1/2" CONDUIT 255G (3) 250 KCMIL + (1) #4 AWG GRD IN 2 1/2" CONDUIT 255NG (4) 250 KCMIL + (1) #4 AWG GRD IN 3" CONDUIT 285G (3) 300 KCMIL + (1) #4 AWG GRD IN 2 1/2" CONDUIT 285NG (4) 300 KCMIL + (1) #4 AWG GRD IN 3" CONDUIT 310G (3) 350 KCMIL + (1) #3 AWG GRD IN 3" CONDUIT 310NG (4) 350 KCMIL + (1) #3 AWG GRD IN 3" CONDUIT 335G (3) 400 KCMIL + (1) #3 AWG GRD IN 3" CONDUIT 335NG (4) 400 KCMIL + (1) #3 AWG GRD IN 3 1/2" CONDUIT 380G | (3) 500 KCMIL + (1) #3 AWG GRD IN 3" CONDUIT 380NG (4) 500 KCMIL + (1) #3 AWG GRD IN 3 1/2" CONDUIT 420G (3) 600 KCMIL + (1) #2 AWG GRD IN 3 1/2" CONDUIT 420NG (4) 600 KCMIL + (1) #2 AWG GRD IN 3 1/2" CONDUIT 500G TWO PARALLEL [(3) 250 KCMIL + (1) #2 AWG GRD IN 2 1/2" CONDUIT] 500NG TWO PARALLEL [(4) 250 KCMIL + (1) #2 AWG GRD IN 3" CONDUIT] 600G TWO PARALLEL [(3) 350 KCMIL + (1) #1 AWG GRD IN 3" CONDUIT] 600NG TWO PARALLEL [(4) 350 KCMIL + (1) #1 AWG GRD IN 3" CONDUIT] 800G TWO PARALLEL [(3) 600 KCMIL + (1) #1/0 AWG GRD IN 3 1/2" CONDUIT] 800NG TWO PARALLEL [(4) 600 KCMIL + (1) #1/0 AWG GRD IN 3 1/2" CONDUIT] 1000G THREE PARALLEL [(3) 500 KCMIL + (1) #2/0 AWG GRD IN 3" CONDUIT] 1000NG THREE PARALLEL [(4) 500 KCMIL + (1) #2/0 AWG GRD IN 3 1/2" CONDUI 1200G FOUR PARALLEL [(3) 350 KCMIL + (1) #3/0 AWG GRD IN 3" CONDUIT] 1200NG | FOUR PARALLEL [(4) 350 KCMIL + (1) #3/0 AWG GRD IN 3" CONDUIT] 1600NG | FIVE PARALLEL [(4) 500 KCMIL + (1) #4/0 AWG GRD IN 3 1/2" CONDUIT] 1600G | FIVE PARALLEL [(3) 500 KCMIL + (1) #4/0 AWG GRD IN 3" CONDUIT] 2000G | SIX PARALLEL [(3) 500 KCMIL + (1) 250 KCMIL GRD IN 3 1/2" CONDUIT] 2000NG | SIX PARALLEL [(4) 500 KCMIL + (1) 250 KCMIL GRD IN 3 1/2" CONDUIT] 2500G SEVEN PARALLEL [(3) 500 KCMIL + (1) 350 KCMIL GRD IN 3 1/2" CONDUIT] 2500NG SEVEN PARALLEL [(4) 500 KCMIL + (1) 350 KCMIL GRD IN 3 1/2" CONDUIT 3000G | EIGHT PARALLEL [(3) 500 KCMIL + (1) 500 KCMIL GRD IN 3 1/2" CONDUIT| | 3000NG | EIGHT PARALLEL [(4) 500 KCMIL + (1) 500 KCMIL GRD IN 3 1/2" CONDUIT NOTE: DESIGNATIONS WITH "NN" (E.G. "230NNG") SHALL BE SIMILAR TO THE REQUIRED "N" FEEDER EXCEPT WITH DOUBLE (200%) NEUTRAL CONDUCTOR.

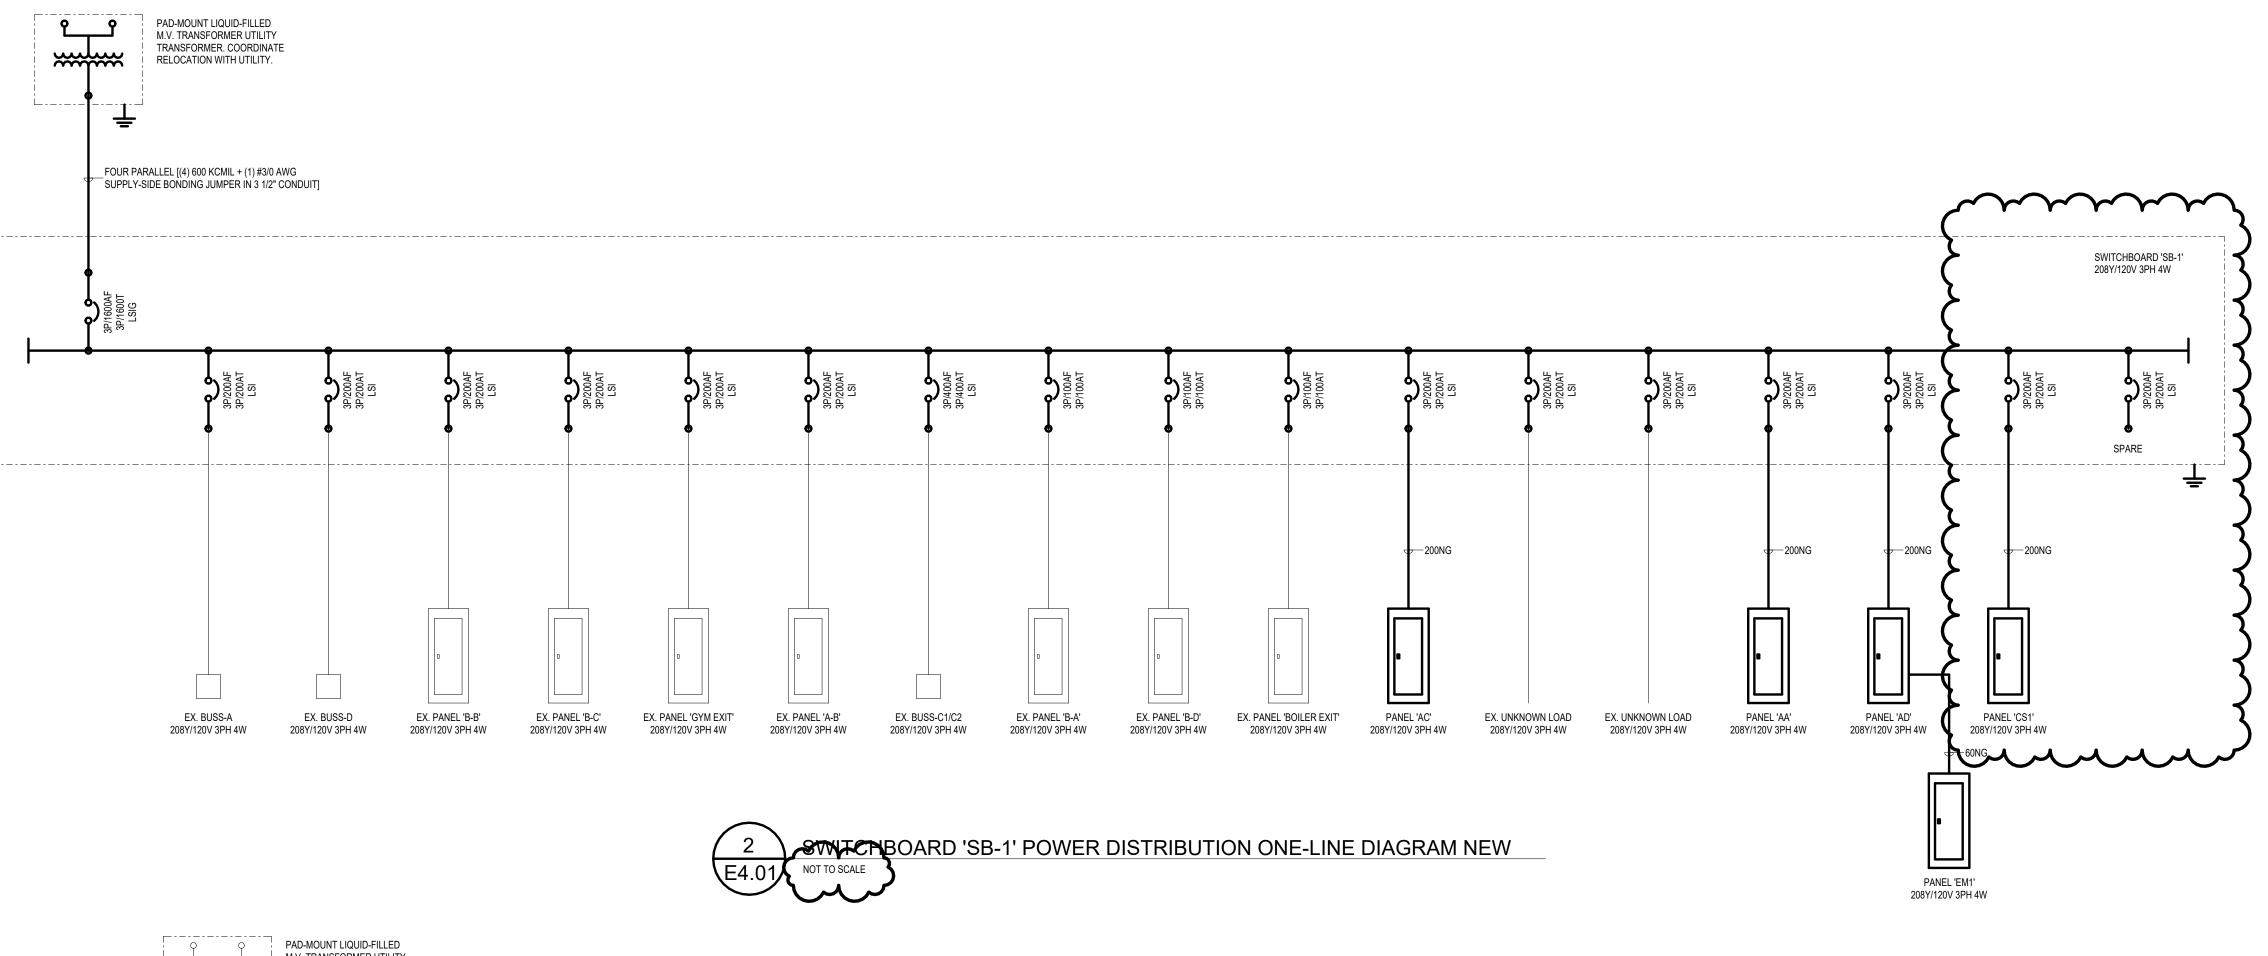

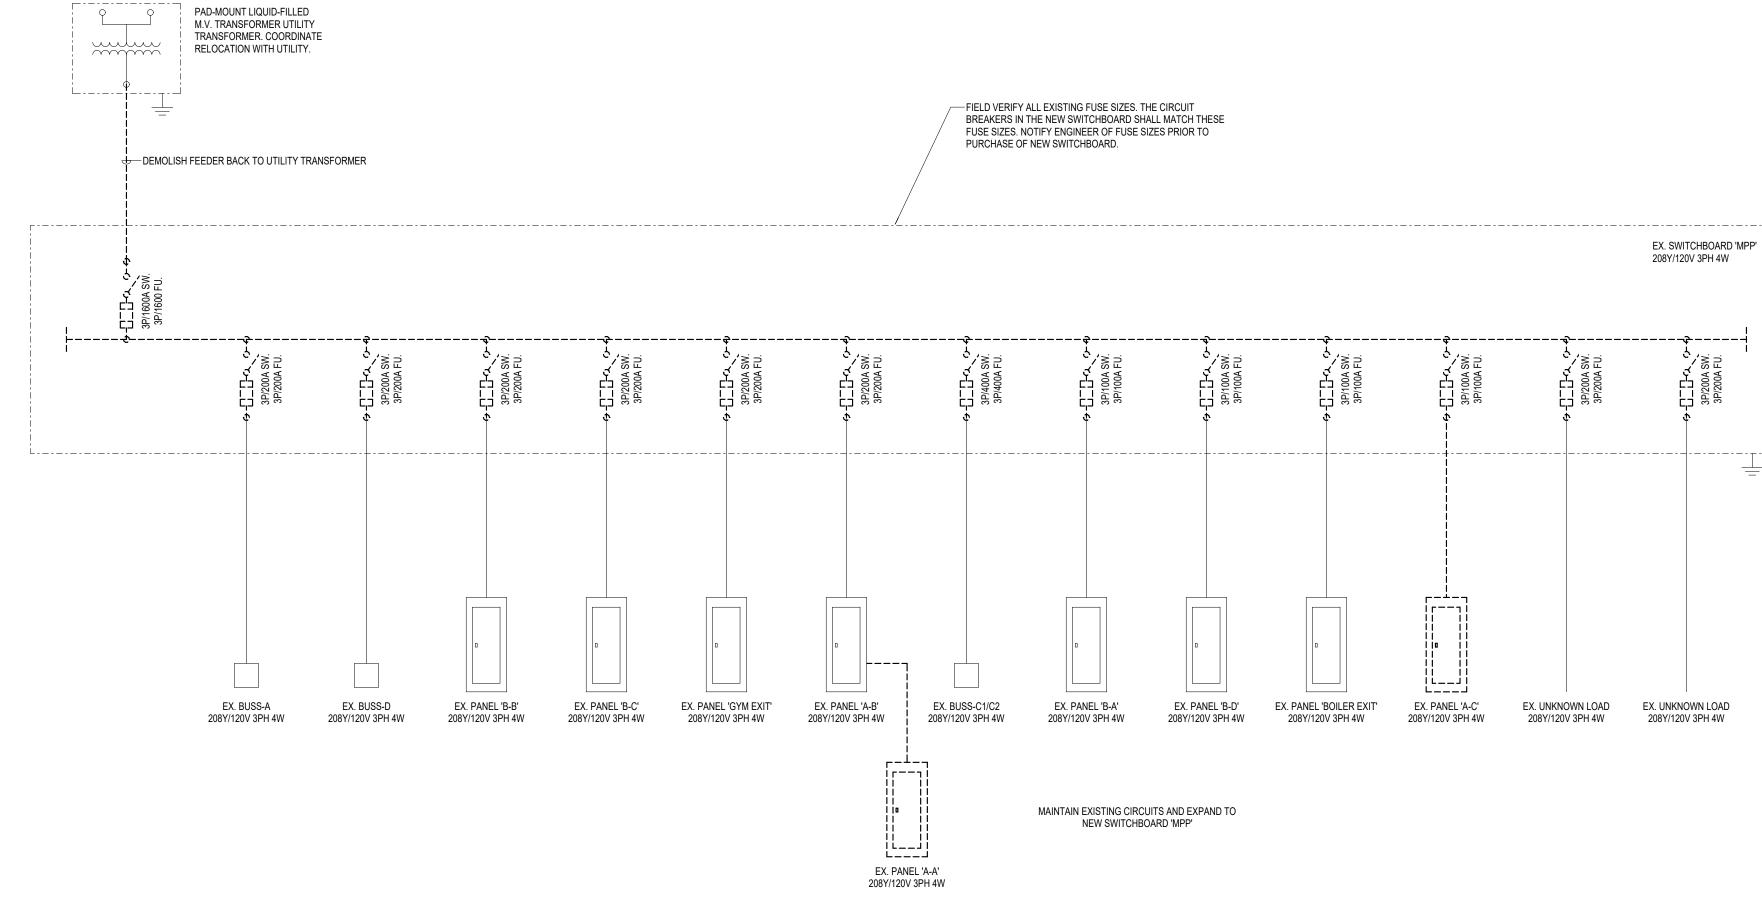

P	ANELBOARD: PAN	IEL '	'EM1	•						•			
	LOCATION: STORAGE	E A126			DISTRIBUTIO	ON SYSTEM	: 208Y/120V 3	PH 4W			MA	INS TYPE: MAIN LUG	
	MOUNTING: SURFACE					SCCR	: 22KA				MAIN	S RATING: 100 A	ı
	ENCLOSURE: TYPE 1				SUF	PPLY FROM	: PANEL 'AD'						
F	PROVIDE WITH THE FOLLOWING:												
	I												
CIRCUIT	CIRCUIT DESCRIPTION	TRIP	POLES		4		В	(C	POLES	TRIP	CIRCUIT DESCRIPTION	CIRCUIT
EM1-1	RECEPTACLE STORAGE A126	20 A	1	360	1,200					2	30 A	RECEPTACLE STORAGE A126	EM1-2
EM1-3	RECEPTACLE STORAGE A126	20 A	1			360	1,200				30 A	RECEPTAGLE STORAGE A126	EM1-4
EM1-5	SPARE	20 A	1					0	0	1	20 A	SPARE	EM1-6
EM1-7	SPARE	20 A	1	0	0					1	20 A	SPARE	EM1-8
EM1-9	SPARE	20 A	1			0	0			1	20 A	SPARE	EM1-10
EM1-11	SPARE	20 A	1					0	0	1	20 A	SPARE	EM1-12
EM1-13	SPARE	20 A	1	0	0					1	20 A	SPARE	EM1-14
EM1-15	SPARE	20 A	1			0	0			1	20 A	SPARE	EM1-16
EM1-17	SPARE	20 A	1					0	0	1	20 A	SPARE	EM1-18
EM1-19	PREPARED SPACE		1							1		PREPARED SPACE	EM1-20
EM1-21	PREPARED SPACE		1							1		PREPARED SPACE	EM1-22
EM1-23	PREPARED SPACE		1							1		PREPARED SPACE	EM1-24

PHASE LOAD: 1,560 VA

1							1	 PREPARED SPACE	EM1-28
1							1	 PREPARED SPACE	EM1-30
DAD:	1,56	0 VA	1,56	0 VA	0 '	√A			
								TOTAL CONNECTED LOAD:	3.1 kVA
								TOTAL CONNECTED CURRENT:	9 A

EM1-26

EM1-30

F	LOCATION: STORAGE MOUNTING: SURFACE ENCLOSURE: TYPE 1 PROVIDE WITH THE FOLLOWING:	DISTRIBUTION SYSTEM: 208Y/120V 3PH 4W SCCR: 22KA SUPPLY FROM: SWITCHBOARD 'SB-1' MAINS TYPE: MAIN LUG MAINS RATING: 225 A											
CIRCUIT	CIRCUIT DESCRIPTION	TRIP	POLES	,	A		В		c	POLES	TRIP	CIRCUIT DESCRIPTION	CIRCUIT
AA-1	RECEPTACLE ROOM A121, A118	20 A	1	900	1,040							SSCU-1/SSAC-1	AA-2
AA-3	REC. FOOTBALL LOCKER ROOM A118	20 A	1			1,008	1,040			2	25 A	A112	AA-4
AA-5	RECEPTACLE COACH OFFICE A119	20 A	1					720	1,144				AA-6
AA-7	RECEPTACLE COACH OFFICE A152	20 A	1	720	1,144					2	20 A	CABINET UNIT HEATERS	AA-8
AA-9	REC. GIRLS VARSITY LOCKER ROOM A114	20 A	1			540	1,014						AA-10
AA-11	REC. GIRLS VARSITY LOCKER ROOM A114	20 A	1					540	1,014	2	20 A	CABINET UNIT HEATERS	AA-12
AA-13	EWC RECEPTACLE LOBBY A100	20 A	1	360	957					_			AA-14
AA-15	REC. MENS BASKETBALL LOCKER A109	20 A	1			720	957			2	20 A	EF-4	AA-16
AA-17	RECEPTACLE ROOM A109, A110	20 A	1					1,368	1,176	1	20 A	EF-5	AA-18
AA-19	RECEPTACLE COACH OFFICE A108	20 A	1	720	10					1	20 A	MOTOR DAMPER ATH. DIR. OFF. A112	AA-20
AA-21	REC. ATHLETIC DIRECTOR OFFICE A112	20 A	1			540	0			1	20 A	SPARE	AA-22
AA-23	REC. ATHLETIC DIRECTOR OFFICE A112	20 A	1					720	0	1	20 A	SPARE	AA-24
AA-25	REC. ATHLETIC DIRECTOR OFFICE A112	20 A	1	360	0					1	20 A	SPARE	AA-26
AA-27	SPARE	20 A	1			0	0			1	20 A	SPARE	AA-28
AA-29	SPARE	20 A	1					0	0	1	20 A	SPARE	AA-30
AA-31	SPARE	20 A	1	0	0					1	20 A	SPARE	AA-32
AA-33	SPARE	20 A	1			0	0			1	20 A	SPARE	AA-34
AA-35	SPARE	20 A	1					0	0	1	20 A	SPARE	AA-36
AA-37	SPARE	20 A	1	0	0					1	20 A	SPARE	AA-38
AA-39	SPARE	20 A	1			0	0			1	20 A	SPARE	AA-40
AA-41	SPARE	20 A	1					0	0	1	20 A	SPARE	AA-42
PHASE LOAD:				6.21	0 VA	5.81	9 VA	6.68	2 VA			•	•

TOTAL CONNECTED CURRENT: 52 A

TOTAL CONNECTED CURRENT: 47 A


	LOCATION: CORRIDOR MOUNTING: FLUSH ENCLOSURE: TYPE 1		DISTRIBUTION SYSTEM: 208Y/120V 3PH 4W SCCR: 22KA SUPPLY FROM: SWITCHBOARD 'SB-1'						MAINS TYPE: MAIN LUG MAINS RATING: 225 A				
F	PROVIDE WITH THE FOLLOWING:												
CIRCUIT	CIRCUIT DESCRIPTION	TRIP	POLES		A		В	(C	POLES	TRIP	CIRCUIT DESCRIPTION	CIRC
AC-1	RECEPTACLE ROOM A133, A134, A131	20 A	1	720	1,092					2	20 A	CABINET UNIT HEATERS	AC
AC-3	RECEPTACLE ROOM A158,A134,A135,A136	20 A	1			720	1,092					A134, A133, A130	AC
AC-5	RECEPTACLE ROOM A155,A137,A131,A149		1					720	1,092	2	20 A	CABINET UNIT HEATERS	AC
AC-7	EWC RECEPTACLES CORRIDOR A131	20 A	1	1,296	1,092							A140, A149, A138	AC
AC-9	RECEPTACLE P.E OFFICE A138	20 A	1			720	1,920			1	25 A	EF-1 LOCKER ROOM A137	AC-
AC-11	RECEPTACLE ROOM A131, A148, A140	20 A	1					1,188	1,920	1	25 A	EF-2 LOCKER ROOM A136	AC-
AC-13	RECEPTACLE COACHES OFFICE A150	20 A	1	720	180					1	20 A	ADA POWERED DOOR A130	AC-
AC-15	REC. GIRLS VARSITY LOCKER ROOM A140	20 A	1			1,656	720			1	20 A	RECEPTACLE	AC-
AC-17	SPARE	20 A	1					0	0	1	20 A	SPARE	AC-
AC-19	SPARE	20 A	1	0	0					1	20 A	SPARE	AC-
AC-21	SPARE	20 A	1			0	0			1	20 A	SPARE	AC-
AC-23	SPARE	20 A	1					0	0	1	20 A	SPARE	AC-
AC-25	SPARE	20 A	1	0	0					1	20 A	SPARE	AC-2
AC-27	SPARE	20 A	1			0	0			1	20 A	SPARE	AC-2
AC-29	SPARE	20 A	1					0	0	1	20 A	SPARE	AC-
AC-31	SPARE	20 A	1	0	0					1	20 A	SPARE	AC-
AC-33	SPARE	20 A	1			0	0			1	20 A	SPARE	AC-
AC-35	SPARE	20 A	1					0	0	1	20 A	SPARE	AC-
AC-37	EXISTING UNKNOWN LOAD (NOTE 1)	15 A	1	0	0					1	20 A	SPARE	AC-
AC-39	EXISTING UNKNOWN LOAD (NOTE 1)	100 A	2			0	0			1	20 A	SPARE	AC-
AC-41			-					0	0	1	20 A	SPARE	AC-

NOTES: 1) CONFIRM EXISTING EQUIPMENT IS STILL IN OPERATION. FOR EQUIPMENT STILL IN USE, EXTEND EXISTING BRANCH CIRCUIT TO NEW PANEL LOCATION.

LOCATION: ELECTRICAL ROOM A129 MOUNTING: SURFACE ENCLOSURE: TYPE 1 PROVIDE WITH THE FOLLOWING:				С	DISTRIBUTION SYSTEM: 208Y/120V 3PH 4W SCCR: 22KA SUPPLY FROM: SWITCHBOARD 'SB-1'						MAINS TYPE: MAIN LUG MAINS RATING: 225 A			
CIRCUIT	CIRCUIT DESCRIPTION	TRIP	POLES	A			3		С	POLES	TRIP	CIRCUIT DESCRIPTION	CIRCUI	
AD-1	LTG - GIRLS VARS. & FOOTBALL LOCKERS		1	1,000	0					1	20 A	EX. LOAD - SW OUTSIDE LTG (NOTE 1)	AD-2	
AD-3	LTG - BOYS BASKETBALL & REF LOCKERS	20 A	1			629	0			1	20 A	EX. LOAD - SE OUTSIDE LTG (NOTE 1)	AD-4	
AD-5	LTG - CORRIDOR	20 A	1					112	0	1	20 A	EX. LOAD - SE OUTSIDE LTG (NOTE 1)	AD-6	
AD-7	LTG - CORRIDOR NIGHT LIGHTING	20 A	1	224	0					1	20 A	EX. LOAD - GYM RECEPTACLES (NOTE 1)	AD-8	
AD-9	LTG - LOBBY	20 A	1			972	0			1	20 A	EX. LOAD - VENTILATOR FAN (NOTE 1)	AD-10	
AD-11	LTG - LOBBY	20 A	1					1,512	0	1	20 A	EX. LOAD - SPEAKERS (NOTE 1)	AD-12	
AD-13	LTG	20 A	1	256	0					1	30 A	EX. LOAD - PUMP PIT (NOTE 1)	AD-14	
AD-15	LTG - CORRIDOR A131	20 A	1			242	0						AD-16	
AD-17	LTG - CORRIDOR A131 NIGHT LIGHTING	20 A	1					224	0	2	20 A	EX. LOAD - COMPRESSOR (NOTE 1)	AD-18	
AD-19	LTG - TOILETS A133, A134, WOMENS LCKR	20 A	1	769	0					1	20 A	SPARE	AD-20	
AD-23	LTG - EXTERIOR UNIT 'A'	20 A	1					105	0 7	1	20 A	SPARE	AD-24	
AD-25	SPARE	20 A	1	0	0					1	20 A	SPARE	AD-26	
AD-27	RPADEL JULIAN	-ZA			•		ريار			1	20 A	SPARE	AD-28	
AD-29	SPARE	20 A	1					0	0	1	20 A	SPARE	AD-30	
AD-31	SPARE	20 A	1	0	0					1	20 A	SPARE	AD-32	
AD-33	SPARE	20 A	1			0	0			1	20 A	SPARE	AD-34	
AD-35	SPARE	20 A	1					0	0	1	20 A	SPARE	AD-36	
AD-37				1,560	0					1	20 A	SPARE	AD-38	
AD-39	PANEL 'EM1'	60 A	3			1,560	0			1	20 A	SPARE	AD-4 AD-6 AD-8 AD-10 AD-12 AD-14 AD-18 AD-20 AD-24 AD-24 AD-26 AD-30 AD-32 AD-34 AD-36 AD-36 AD-36 AD-36	
AD-41								0	0	1	20 A	SPARE	AD-42	
		PHAS	SE LOAD:	3,809) VA	4,14	2 VA	1,99	53 VA			TOTAL CONNECTED LOAD: TOTAL CONNECTED CURRENT:		

į	LOCATION: ELECTRICAL MOUNTING: FREE-STAND ENCLOSURE: TYPE 1 PROVIDE WITH THE FOLLOWING: GROUND-FA	DING ON 4" CONC. PAD	N 4" CONC. PAD SCCR: 65KA SUPPLY FROM: EX. XFMR				MAINS RATING: 1,600 A				
CIRCUIT	CIRCUIT DESCRIPTI	ION	POLES	FRAME SIZE	TRIP RATING	Loa	ad.	REMARKS			
SB1-1	EX. BUSS A	ION	3	200 A	200 A	0 V		NOTE 1			
SB1-2	EX. BUSS C		3	200 A	200 A	0 V		NOTE 1			
SB1-3	EX. PANEL 'B-B'		3	200 A	200 A	0 V	'A	NOTE 1			
SB1-4	EX. PANEL 'B-C'		3	200 A	200 A	0 V	'A	NOTE 1			
SB1-5	EX. PANEL 'GYM EXIT'		3	200 A	200 A	0 V		NOTE 1			
SB1-6	EX. PANEL 'A-B'		3	200 A	200 A	0 V	'A	NOTE 1			
SB1-7	EX. BUSS C1/C2		3	400 A	400 A	0 V	Ά	NOTE 1			
SB1-8	EX. PANEL 'B-A'		3	100 A	100 A	0 V	Ά	NOTE 1			
SB1-9	EX. PANEL 'B-D'		3	100 A	100 A	0 V	'A	NOTE 1			
SB1-10	EX. PANEL 'BOILER EXIT'		3	100 A	100 A	0 V	'A	NOTE 1			
SB1-11	PANEL 'AC'		3	200 A	200 A	16,848	3 VA				
SB1-12	EX. UNKNOWN LOAD		3	200 A	200 A	0 V	Ά	NOTE 1			
SB1-13	EX. UNKNOWN LOAD		3	200 A	200 A	0 V	Ά	NOTE 1			
SB1-14	PANEL 'AA'		3	200 A	200 A	18,71	1 VA				
SB1-15	PANEL 'AD'		3	200 A	200 A	9,904	· VA				
SB1-16	PANEL 'CS1'		3	200 A	200 A	31,610	AV C				
SB1-17	SPARE		3	200 A	200 A	0 V	Ά				
SB1-18	PREPARED SPACE		1								
SB1-19	PREPARED SPACE		1								
SB1-20	PREPARED SPACE		1								
SB1-21	PREPARED SPACE		1								
SB1-22	PREPARED SPACE		1								
SB1-23	PREPARED SPACE		1								
SB1-24	PREPARED SPACE		1								
DAD CLASS	SIFICATION	CONNECTED LO	AD	DEMAND FACTOR	ESTIMATE	D DEMAND		SWITCHBOARD TOTALS			
uipment 18,929 V				100.00%	18,92						
	hting - General 10,669 '			100.00%	10,66			TOTAL CONNECTED LOAD: 77.1 kVA			
		14,439 VA		103.32%	14,91			ESTIMATED DEMAND LOAD: 66.0 kVA			
eceptacle		33,036 VA		65.14%	21,51			TAL CONNECTED CURRENT: 214 A			
•		-			,			AL EST. DEMAND CURRENT: 183 A			

NOTES: 1) CONFIRM EXISTING FUSE SIZE AND MATCH NEW CIRCUIT BREAKER TO FUSE SIZE.

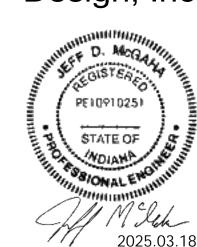

ISSUANCES

01.06.2025 BIDS & CONSTRUCTION 01.16.2025 ADDENDUM 001 01.22.2025 ADDENDUM 002 03.13.2025 BULLETIN 001

DRAWN JDM REVIEWED SMS

PROJECT NO. 5-6394 NO PART OF THIS DRAWING MAY BE USED OR REPRODUCED IN ANY FORM OR BY ANY MEANS, OR STORED IN A DATA BASE OR RETRIEVAL SYSTEM, WITHOUT PRIOR WRITTEN PERMISSION OF GMB COPYRIGHT © 2025

POWER DISTRIBUTION **EQUIPMENT SCHEDULES**

ALL RIGHTS RESERVED

EM1-25 PREPARED SPACE

EM1-29 PREPARED SPACE

					LIGHTING CONTROL INTEN	T NARRATIVE (CIN) SCHEDULE							
				ONTROL FUNCTION DESCRIPTIONS (ASHRAE/IES 90.1-2013 RE	FERENCE)								
NARRATIVE I.D.	DESCRIPTION	LOCAL CONTROL (9.4.1.1[a])	ON MODE (9.4.1.1[b,c])	BI-LEVEL LIGHTING CONTROL (9.4.1.1[d])	DAYLIGHT RESPONSIVE CONTROLS (9.4.1.1[e,f])	OFF MODE (9.4.1.1[g,h,i])				G MANAGEMENT / TEMPERATURE CONTROL FUS OUTPUT, PLUS OTHER FUNCTIONS PER SPECIFICATION)	RESTORE EGRESS LIGHTING UPON FIRE ALARM CONDITION		ADDITIONAL NOTES
							ROOM-BASED	BUILDING-WIDE LOC	AL ROOM INTERFACE (COI SURE)	NTACT CENTRAL GATEWAY PROTOCOL INTERFACE VIA NLCS BACKBONE NETWORK	LOCAL ROOM INTERFACE (CONTA CLOSURE)	CT CENTRAL GATEWAY PROTOCOL INTERFACE VIA NLCS BACKBONE NETWORK	
CIN-01	TYPICAL OCCUPIABLE ROOM	WALL SWITCH(ES) (ON / OFF / DIM UP / DIM DOWN) AT ONE OR MORE LOCATIONS WITHIN SPACE; REFER TO PLAN FOR LOCATION(S)	MANUAL ON VIA LOCAL WALL CONTROL(S)	0-10VDC CONTINUOUS DIMMING OF LIGHTING WITHIN ONE OR MORE CONTROL ZONES; REFER TO PLAN (SINGLE CONTROL ZONE UNLESS OTHERWISE SHOWN)	WHERE INDICATED, OPEN-LOOP PHOTOCONTROL(S) AUTOMATICALLY REDUCE THE ELECTRIC LIGHTING WITHIN EACH PRIMARY/SECONDARY SIDELIGHTING AND/OR ROOF MONITOR DAYLIGHT ZONE VIA 0-10VDC CONTINUOUS DIMMING	AUTOMATIC FULL OFF UPON SPACE VACANCY VIA SENSOR(S), SE FOR 20-MINUTE TIMEOUT PERIOD	T X			х			
CIN-02	PUBLIC TRANSITION SPACE	LINE-VOLTAGE LOCKING TOGGLE SWITCH(ES) (SECTION 26 27 26) AT ONE OR MORE LOCATIONS WITHIN SPACE; REFER TO PLAN FOR LOCATION(S), CONNECT ON LOAD SIDE OF AUTOMATIC LIGHTING CONTROL DEVICES	AUTOMATIC ON VIA OCCUPANCY SENSOR	N/A	N/A	AUTOMATIC FULL OFF UPON SPACE VACANCY VIA SENSOR(S), SE FOR 20-MINUTE TIMEOUT PERIOD	Т	Х		х		х	
CIN-06	ELECTRICAL / MECHANICAL	LINE-VOLTAGE TOGGLE SWITCH(ES) (SECTION 26 27 26) AT ONE OR MORE LOCATIONS WITHIN SPACE; REFER TO PLAN FOR LOCATION(S)	MANUAL VIA SWITCH	N/A	N/A	MANUAL VIA SWITCH	N/A	N/A	N/A	N/A	N/A	N/A	NO AUTOMATIC LIGHTING CONTROLS
CIN-07	RESTROOM, MULTIPLE OCCUPANCY	LINE-VOLTAGE LOCKING TOGGLE SWITCH(ES) (SECTION 26 27 26) AT ONE OR MORE LOCATIONS WITHIN SPACE; REFER TO PLAN FOR LOCATION(S), CONNECT ON LOAD SIDE OF AUTOMATIC LIGHTING CONTROL DEVICES	AUTOMATIC ON VIA OCCUPANCY SENSOR	N/A	N/A	AUTOMATIC FULL OFF UPON SPACE VACANCY VIA SENSOR(S), SE FOR 20-MINUTE TIMEOUT PERIOD	T X			х			
CIN-09	STORAGE, >= 50 SQ. FT.	WALL SWITCH(ES) (ON / OFF) AT ONE OR MORE LOCATIONS WITHIN SPACE; REFER TO PLAN FOR LOCATION(S)	MANUAL ON VIA LOCAL WALL CONTROL(S)	N/A	N/A	AUTOMATIC FULL OFF UPON SPACE VACANCY VIA SENSOR(S), SE FOR 15-MINUTE TIMEOUT PERIOD	т х			Х			
CIN-09A	STORAGE, >= 50 SQ. FT.	LINE-VOLTAGE WALL-BOX OCCUPANCY SENSOR (SECTION 26 09 23), REFER TO PLAN FOR LOCATION(S)	MANUAL ON VIA LOCAL WALL CONTROL(S)	N/A	N/A	AUTOMATIC FULL OFF UPON SPACE VACANCY VIA SENSOR(S), SE FOR 15-MINUTE TIMEOUT PERIOD	Т						
CIN-12	GYMNASIUM, PLAYING AREA	WALL SWITCH(ES) (ON / OFF / DIM UP / DIM DOWN) AT ONE OR MORE LOCATIONS WITHIN SPACE; REFER TO PLAN FOR LOCATION(S)	MANUAL ON VIA LOCAL WALL CONTROL(S)	0-10VDC CONTINUOUS DIMMING OF LIGHTING WITHIN ONE OR MORE CONTROL ZONES; REFER TO PLAN (SINGLE CONTROL ZONE UNLESS OTHERWISE SHOWN)		AUTOMATIC FULL OFF UPON SPACE VACANCY VIA SENSOR(S) (INDEPENDENT SENSOR ZONES FOR NO MORE THAN 5,000 SQ. FT.), SET FOR 20-MINUTE TIMEOUT PERIOD		х		х		Х	AUTOMATIC ON/OFF VIA OCCUPANCY SENSOR FOR DESIGNATE EMERGENCY/EGRESS FIXTURES ONLY TO PROVIDE WALK-THR LIGHTING
	EXTERIOR LIGHTING, SITE POLES												CONTROL VIA BMS ON AT SUNSET WITH ASTRONOMIC TIME SCHEDULE (WITH USE ADJUSTABLE OFFSET +/- 30 MIN.) OFF AT MIDNIGHT ON AT 6:00 A.M. OFF AT SUNRISE WITH ASTRONOMIC TIME SCHEDULE (WITH USE ADJUSTABLE OFFSET +/- 30 MIN.) PROVIDE ABILITY FOR USER TO INITIATE MANUAL OR SCHEDUL OVERRIDE ON PERIOD.
	EXTERIOR LIGHTING, BUILDING-MOUNTEI (AND FLAGPOLE LIGHTING IF PRESENT)												CONTROL VIA BMS ON AT SUNSET WITH ASTRONOMIC TIME SCHEDULE (WITH USE ADJUSTABLE OFFSET +/- 30 MIN.) OFF AT SUNRISE WITH ASTRONOMIC TIME SCHEDULE (WITH USE ADJUSTABLE OFFSET +/- 30 MIN.) PROVIDE ABILITY FOR USER TO INITIATE MANUAL OR SCHEDUL OVERRIDE ON PERIOD.

	SPACE TYPE (ASHRAE/IES 90.1 TABLE 9.6
CIN-01	OFFICE FNOLOGED 250 CF OD LECC
A103 OFFICE	OFFICE - ENCLOSED, 250 SF OR LESS
A105 HOSPITALITY ROOM A108 COACH OFFICE	CONFERENCE/MEETING/MULTIPURPOSE OFFICE - ENCLOSED, 250 SF OR LESS
A112 A.T. ROOM	OFFICE - ENCLOSED, 250 SF OR LESS OFFICE - ENCLOSED, GREATER THAN 250
A113 LAUNDRY	LAUNDRY/WASHING AREA
A119 COACH OFFICE	OFFICE - ENCLOSED, 250 SF OR LESS
A138 P.E OFFICE	OFFICE - ENCLOSED, 250 SF OR LESS
A143 OFFICE	OFFICE - ENCLOSED, 250 SF OR LESS
A150 COACHES OFFICE	OFFICE - ENCLOSED, 250 SF OR LESS
A152 COACH OFFICE	OFFICE - ENCLOSED, 250 SF OR LESS
CINI 02	
CIN-02 A101 VEST.	CORRIDOR
A101 VEST.	CORRIDOR
A117 Space	CORRIDOR
A117 Space A130 VEST.	CORRIDOR
A131 CORRIDOR	CORRIDOR
A132 VEST.	CORRIDOR
A192 Space	CORRIDOR
S-1 STAIRS	STAIRWELL
S-2 STAIRS	STAIRWELL
1	
CIN-06	
A129 ELECTRICAL ROOM	ELECTRICAL/MECHANICAL
CIN-07	
A107 REF LOCKER ROOM	LOCKER ROOM
A109 MENS BASKETBALL LOCKER ROOM	LOCKER ROOM
A111 TOILET	LOCKER ROOM
A114 GIRLS VARSITY LOCKER ROOM	LOCKER ROOM
A115 TOILET	LOCKER ROOM
A118 FOOTBALL LOCKER ROOM	LOCKER ROOM
A120 TOILET	LOCKER ROOM
A133 WOMEN'S TOILET	RESTROOMS
A134 MEN'S TOILET	RESTROOMS
A136 LOCKER ROOM	LOCKER ROOM
A137 LOCKER ROOM	LOCKER ROOM
A149 TOILET	LOCKER ROOM
A153 SHOWER	LOCKER ROOM
A154 SHOWER	LOCKER ROOM
A155 MEN'S TOILET	LOCKER ROOM
A156 SHOWER	LOCKER ROOM
A157 SHOWER	LOCKER ROOM
A158 WOMEN'S TOILET	LOCKER ROOM
A159 SHOWER	LOCKER ROOM
A163 Space	LOCKER ROOM
CIN-09	
A104 ATHLETIC STORAGE	STORAGE - 50 SF TO 1000 SF
A106 STORAGE	STORAGE - 50 SF TO 1000 SF
A123 STORAGE	STORAGE - 50 SF TO 1000 SF
A125 CONCESSIONS STORAGE	STORAGE - 50 SF TO 1000 SF
A126 STORAGE	STORAGE - GREATER THAN 1000 SF
A135 CUSTODIAL A151 STORAGE	STORAGE - 50 SF TO 1000 SF STORAGE - 50 SF TO 1000 SF
	5.5.0.0L 00 01 10 1000 01
CIN-09A A110 STORAGE	STORAGE - 50 SF TO 1000 SF
A110 STORAGE A121 STORAGE	STORAGE - 50 SF TO 1000 SF STORAGE - 50 SF TO 1000 SF
	STORAGE - 50 SF TO 1000 SF
A148 STORAGE	
A148 STORAGE	3.0.1.02 30 0. 10 1000 0.

CDACE LD	FLOOR	ALLOWED LPD	ALLOWED	PROPOSED	PROPOSED	NOTED EXEMPTIONS /
SPACE I.D.	AREA	(TABLE 9.6.1)	LIGHTING POWER	LIGHTING POWER	LPD	ALLOWANCES / ADJUSTMENT
A101 VEST.	230 SF	0.66 W/ft²	152 W	56 W	0.24 W/ft ²	
\102 HALL	167 SF	0.66 W/ft²	110 W	108 W	0.24 VV/ft ²	
A103 OFFICE	195 SF	1.11 W/ft²	216 W	108 W	0.03 W/ft ²	
A104 ATHLETIC STORAGE	143 SF	0.63 W/ft²	90 W	36 W	0.74 W/ft ²	
A105 HOSPITALITY ROOM	462 SF	1.23 W/ft²	568 W	288 W	0.62 W/ft²	
A106 STORAGE	762 SF	0.63 W/ft²	480 W	144 W	0.19 W/ft²	
A107 REF LOCKER ROOM	169 SF	0.75 W/ft²	127 W	86 W	0.51 W/ft²	
A108 COACH OFFICE	140 SF	1.11 W/ft²	156 W	56 W	0.40 W/ft²	
A109 MENS BASKETBALL LOCKER ROOM	623 SF	0.75 W/ft²	467 W	234 W	0.38 W/ft²	
A110 STORAGE	84 SF	0.63 W/ft²	53 W	36 W	0.43 W/ft²	
A111 TOILET	154 SF	0.75 W/ft²	115 W	2 W	0.02 W/ft²	
A112 A.T. ROOM	333 SF	1.11 W/ft²	370 W	140 W	0.42 W/ft²	
A113 LAUNDRY	88 SF	0.60 W/ft²	53 W	72 W	0.82 W/ft²	
A114 GIRLS VARSITY LOCKER ROOM	620 SF	0.75 W/ft²	465 W	237 W	0.38 W/ft²	
A115 TOILET	144 SF	0.75 W/ft²	108 W	74 W	0.52 W/ft²	
A117 Space	140 SF	0.66 W/ft²	93 W	58 W	0.42 W/ft²	
A118 FOOTBALL LOCKER ROOM	670 SF	0.75 W/ft²	503 W	236 W	0.35 W/ft ²	
A119 COACH OFFICE	88 SF	1.11 W/ft²	98 W	56 W	0.64 W/ft ²	
A120 TOILET	154 SF	0.75 W/ft²	115 W	110 W	0.72 W/ft ²	
A121 STORAGE	72 SF	0.63 W/ft ²	45 W	36 W	0.50 W/ft ²	
A122 GYMNASIUM	11,412 SF	1.20 W/ft²	13,695 W	5,550 W	0.49 W/ft ²	
A123 STORAGE	597 SF	0.63 W/ft ²	376 W	90 W	0.15 W/ft ²	
A125 CONCESSIONS STORAGE	357 SF	0.63 W/ft ²	225 W	54 W	0.15 W/ft ²	
A126 STORAGE	1,841 SF	0.63 W/ft ²	1,160 W	28 W	0.02 W/ft ²	
A129 ELECTRICAL ROOM	125 SF	0.42 W/ft ²	52 W	18 W	0.14 W/ft ²	
A130 VEST.	239 SF	0.66 W/ft ²	157 W	56 W	0.23 W/ft ²	
A131 CORRIDOR	1,290 SF	0.66 W/ft ²	851 W	283 W	0.22 W/ft ²	
A132 VEST.	79 SF	0.66 W/ft ²	52 W	28 W	0.36 W/ft ²	
A133 WOMEN'S TOILET	302 SF	0.98 W/ft ²	296 W	254 W	0.84 W/ft ²	
A134 MEN'S TOILET	302 SF	0.98 W/ft ²	296 W	254 W	0.84 W/ft ²	
N135 CUSTODIAL	67 SF	0.63 W/ft ²	43 W	36 W	0.53 W/ft ²	
A136 LOCKER ROOM	268 SF	0.75 W/ft ²	201 W	89 W	0.33 W/ft ²	
A137 LOCKER ROOM	298 SF	0.75 W/ft ²	224 W	89 W	0.30 W/ft ²	
A138 P.E OFFICE	167 SF	1.11 W/ft²	185 W	56 W	0.34 W/ft ²	
A143 OFFICE	100 SF	1.11 W/ft²	111 W	56 W	0.56 W/ft ²	
A148 STORAGE	88 SF	0.63 W/ft ²		36 W	0.41 W/ft²	
A149 TOILET	175 SF	0.75 W/ft ²	-	110 W	0.63 W/ft²	
A150 COACHES OFFICE	127 SF	1.11 W/ft²		56 W	0.44 W/ft²	
A151 STORAGE	101 SF	0.63 W/ft ²		36 W	0.36 W/ft²	
A152 COACH OFFICE	88 SF	1.11 W/ft²		56 W	0.64 W/ft²	
A153 SHOWER	25 SF	0.75 W/ft²		25 W	1.00 W/ft²	
A154 SHOWER	28 SF	0.75 W/ft²	21 W	25 W	0.89 W/ft²	
A155 MEN'S TOILET	200 SF	0.75 W/ft²	150 W	110 W	0.55 W/ft²	
A156 SHOWER	31 SF	0.75 W/ft²		25 W	0.81 W/ft²	
A157 SHOWER	30 SF	0.75 W/ft²		25 W	0.83 W/ft²	
A158 WOMEN'S TOILET	203 SF	0.75 W/ft²		110 W	0.54 W/ft²	
A159 SHOWER	27 SF	0.75 W/ft²	20 W	25 W	0.91 W/ft²	
A163 Space	25 SF	0.75 W/ft²		25 W	1.00 W/ft²	
A192 Space	65 SF	0.66 W/ft²		28 W	0.43 W/ft²	
S-1 STAIRS	213 SF	0.69 W/ft²		56 W	0.26 W/ft²	
S-2 STAIRS	213 SF	0.69 W/ft ²	147 W	56 W	0.26 W/ft ²	

LIGHTING FIXTURE SCHEDULE GENERAL NOTES:

- A. MODEL NUMBERS GIVEN IN THIS SCHEDULE MAY NOT INCLUDE ALL OPTIONS AND ACCESSORIES AS NECESSARY TO MEET THE REQUIREMENTS OF THE DESCRIPTION AND SPECIFICATIONS.
- B. CONTRACTOR SHALL PROVIDE ALL NECESSARY MOUNTING HARDWARE FOR EACH FIXTURE TYPE. COORDINATE WITH CEILING TYPES AND MOUNTING LOCATIONS.
- C. ALL FINISHES SHALL BE CHOSEN FROM THE MANUFACTURER'S
- CATALOGED/STANDARD OPTIONS UNLESS OTHERWISE NOTED. D. ALL INTERIOR LIGHT SOURCES SHALL HAVE COLOR RENDERING INDEX RATING OF 80 OR GREATER. ALL EXTERIOR LIGHT SOURCES SHALL HAVE COLOR RENDERING INDEX RATING OF 70 OR GREATER.
- E. ALL FIXTURES SHALL BE SUPPLIED WITH UNIVERSAL VOLTAGE INPUT
- (120/277V) WHERE AVAILABLE FROM THE MANUFACTURER. VOLTAGE LISTED IN THE SCHEDULE IS INTENDED UTILIZATION VOLTAGE. F. REFER TO THE PLAN DRAWINGS FOR LOCATIONS OF EMERGENCY-DUTY FIXTURES, INCLUDING FIXTURES WITH MULTIPLE CIRCUITS AND/OR EMERGENCY-DUTY SUBSECTIONS. ALL EMERGENCY-DUTY FIXTURES
- SHALL BE WIRED AND CIRCUITED PER NEC ARTICLE 700 RULES. G. TO MAINTAIN A UNIFORM AND COORDINATED APPEARANCE ACROSS THE PROJECT, ONLY ONE APPROVED MANUFACTURER SHALL BE SELECTED FOR MULTIPLE FIXTURE TYPES AMONG WHICH A SIMILAR STYLE OR SERIES IS INTENDED. NON-CONFORMANCE SHALL BE JUDGED AT THE ENGINEER'S DISCRETION AND MAY REQUIRE CONTRACTOR'S RESELECTION OF SOME
- TYPES WITHIN THE LIST OF APPROVED MANUFACTURERS. H. A BREAK-OUT COST SHALL BE MADE AVAILABLE TO THE BIDDING CONTRACTOR(S) FOR ANY FIXTURE TYPES WHICH LIST A SINGLE PRODUCT. THIS PRICING SHALL BE FURNISHED TO THE ARCHITECT/ENGINEER, CONSTRUCTION MANAGER, AND/OR OWNER UPON REQUEST.

LIGHTING FIXTURE SCHEDULE LINE ITEM NOTES:

- EMERGENCY LIGHTING CONTROL DEVICES SHALL BE WIRED WITH SUPPLY FROM EMERGENCY LIGHTING CIRCUIT, AND FROM NORMAL/UTILITY LIGHTING CIRCUIT, BOTH LINE AND LOAD SIDE OF RESPECTIVE CONTROL DEVICE(S) FOR THE LIGHTING CONTROL ZONE. REFER TO MANUFACTURER'S
- INSTALLATION INSTRUCTIONS. 2. EMERGENCY LIGHTING UNIT EQUIPMENT (INCLUDING BATTERY PACKS, EXIT SIGNS, INVERTERS, ETC.) SHALL HAVE 5-YEAR MANUFACTURER WARRANTY, TEST SWITCH AND CHARGE INDICATOR LIGHT. PROVIDE UNSWITCHED HOT CONDUCTOR FROM RESPECTIVE LOCAL LIGHTING CIRCUIT TO THE BATTERY.
- 3. COORDINATE EXACT LOCATIONS OF FIXTURES IN UTILITY ROOMS WITH EQUIPMENT, DUCTWORK, PIPING, ETC. IN FIELD TO ACHIEVE UNIFORM
- 4. PROVIDE FEED POINT ON ENTIRE TRACK SYSTEM ARRANGEMENT WITH 3A
- CURRENT LIMITER DEVICE AS REQUIRED FOR NEC COMPLIANCE. 5. PROVIDE FEED POINT ON ENTIRE TRACK SYSTEM ARRANGEMENT WITH 12A CURRENT LIMITER DEVICE AS REQUIRED FOR NEC COMPLIANCE.

2025.03.18

01.22.2025 ADDENDUM 002

JDM

DRAWN

LIGHTING FIXTURE SCHEDULE

GMB COPYRIGHT © 2025

ALL RIGHTS RESERVED



ISSUANCES

DRAWN

REVIEWED SMS

PROJECT NO.

JDM

NO PART OF THIS DRAWING MAY BE

USED OR REPRODUCED IN ANY FORM

OR BY ANY MEANS, OR STORED IN A DATA BASE OR RETRIEVAL SYSTEM,

WITHOUT PRIOR WRITTEN


PERMISSION OF

GMB COPYRIGHT © 2025

ALL RIGHTS RESERVED


ELECTRICAL DETAILS

01.06.2025 BIDS & CONSTRUCTION

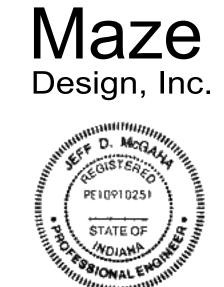

M Sleh 2025.03.18

SCHOOL

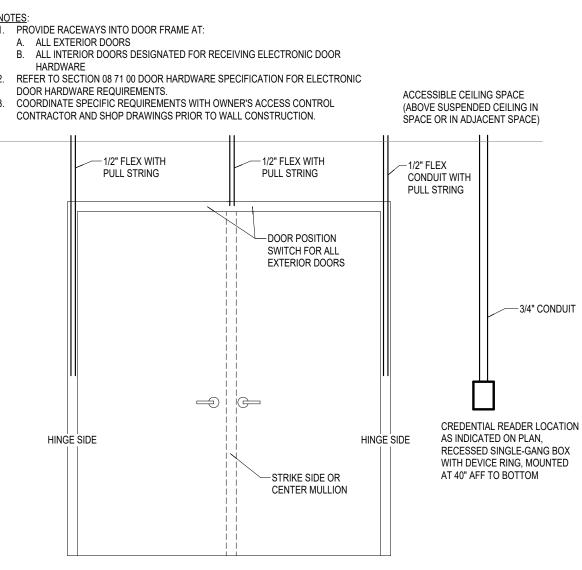

-STAINLESS STEEL COVER

BOLTS W/ WASHERS, (4) TYP.


~2" TO 6" GRADE RINGS AS NECESSARY SUCH THAT TOP OF FRAME/COVER IS FLUSH WITH FINISHED GRADE. RINGS SHALL BE PINNED TOGETHER AND BOLTED TO MANHOLE FRAME. SEAL CONNECTIONS BETWEEN RINGS, MANHOLE FRAME, AND PRECAST MANHOLE WITH ASTM C-990 BUTYL RUBBER FLEXIBLE JOINT SEALANT. FOUR CADMIUM PLATED 5/8" DIA. THREADED STUDS W/ WASHERS & GASKETS; ANCHOR TO TOP CASTING


ASTM C-478 PRECAST CONCRETE MANHOLE W/ 7" THICK WALLS, MODIFIED GROOVE JOINTS W/ ASTM C-990

CAST-IN-PLACE INSERTS FOR CABLE RACKS, COORD.

BUTYL RUBBER FLEXIBLE JOINT SEALANT.

QTY. AND LOCATIONS W/ ELEC. CONT'R.

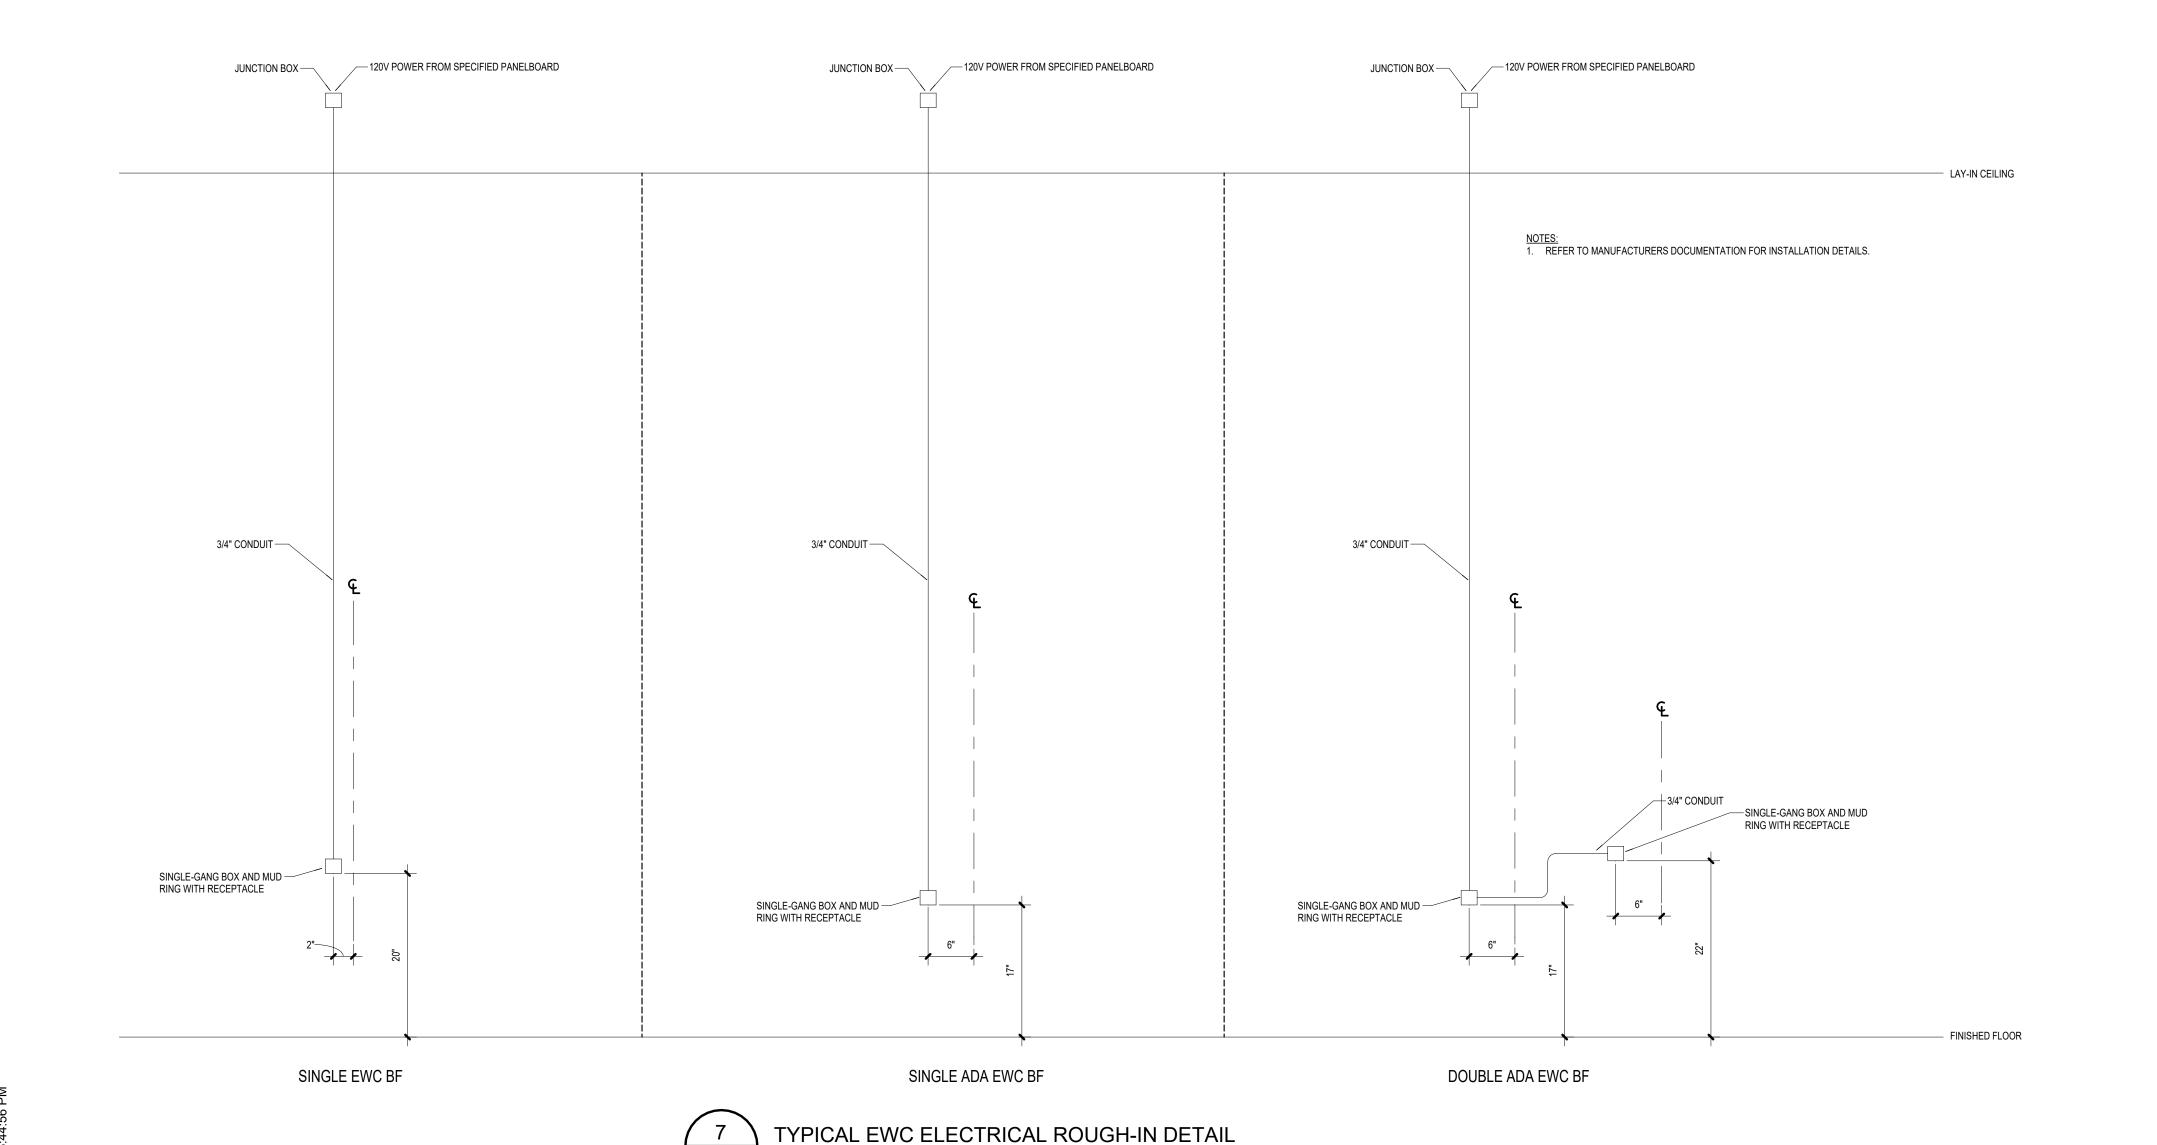


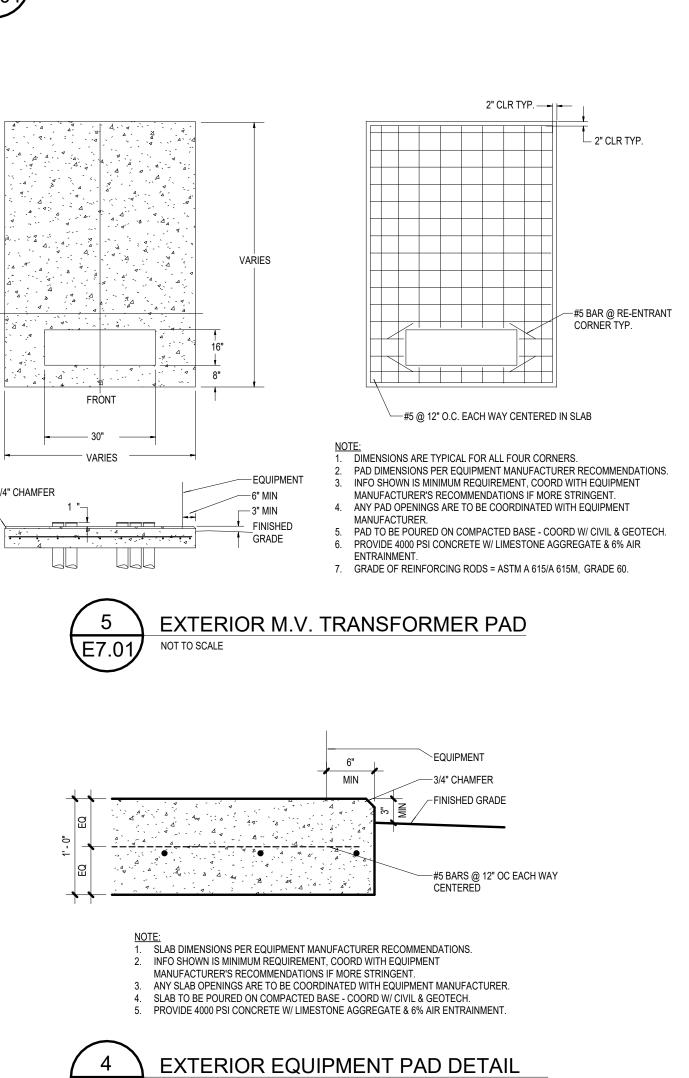

-GROUND RODS-

FRONT

GROUND RODS-

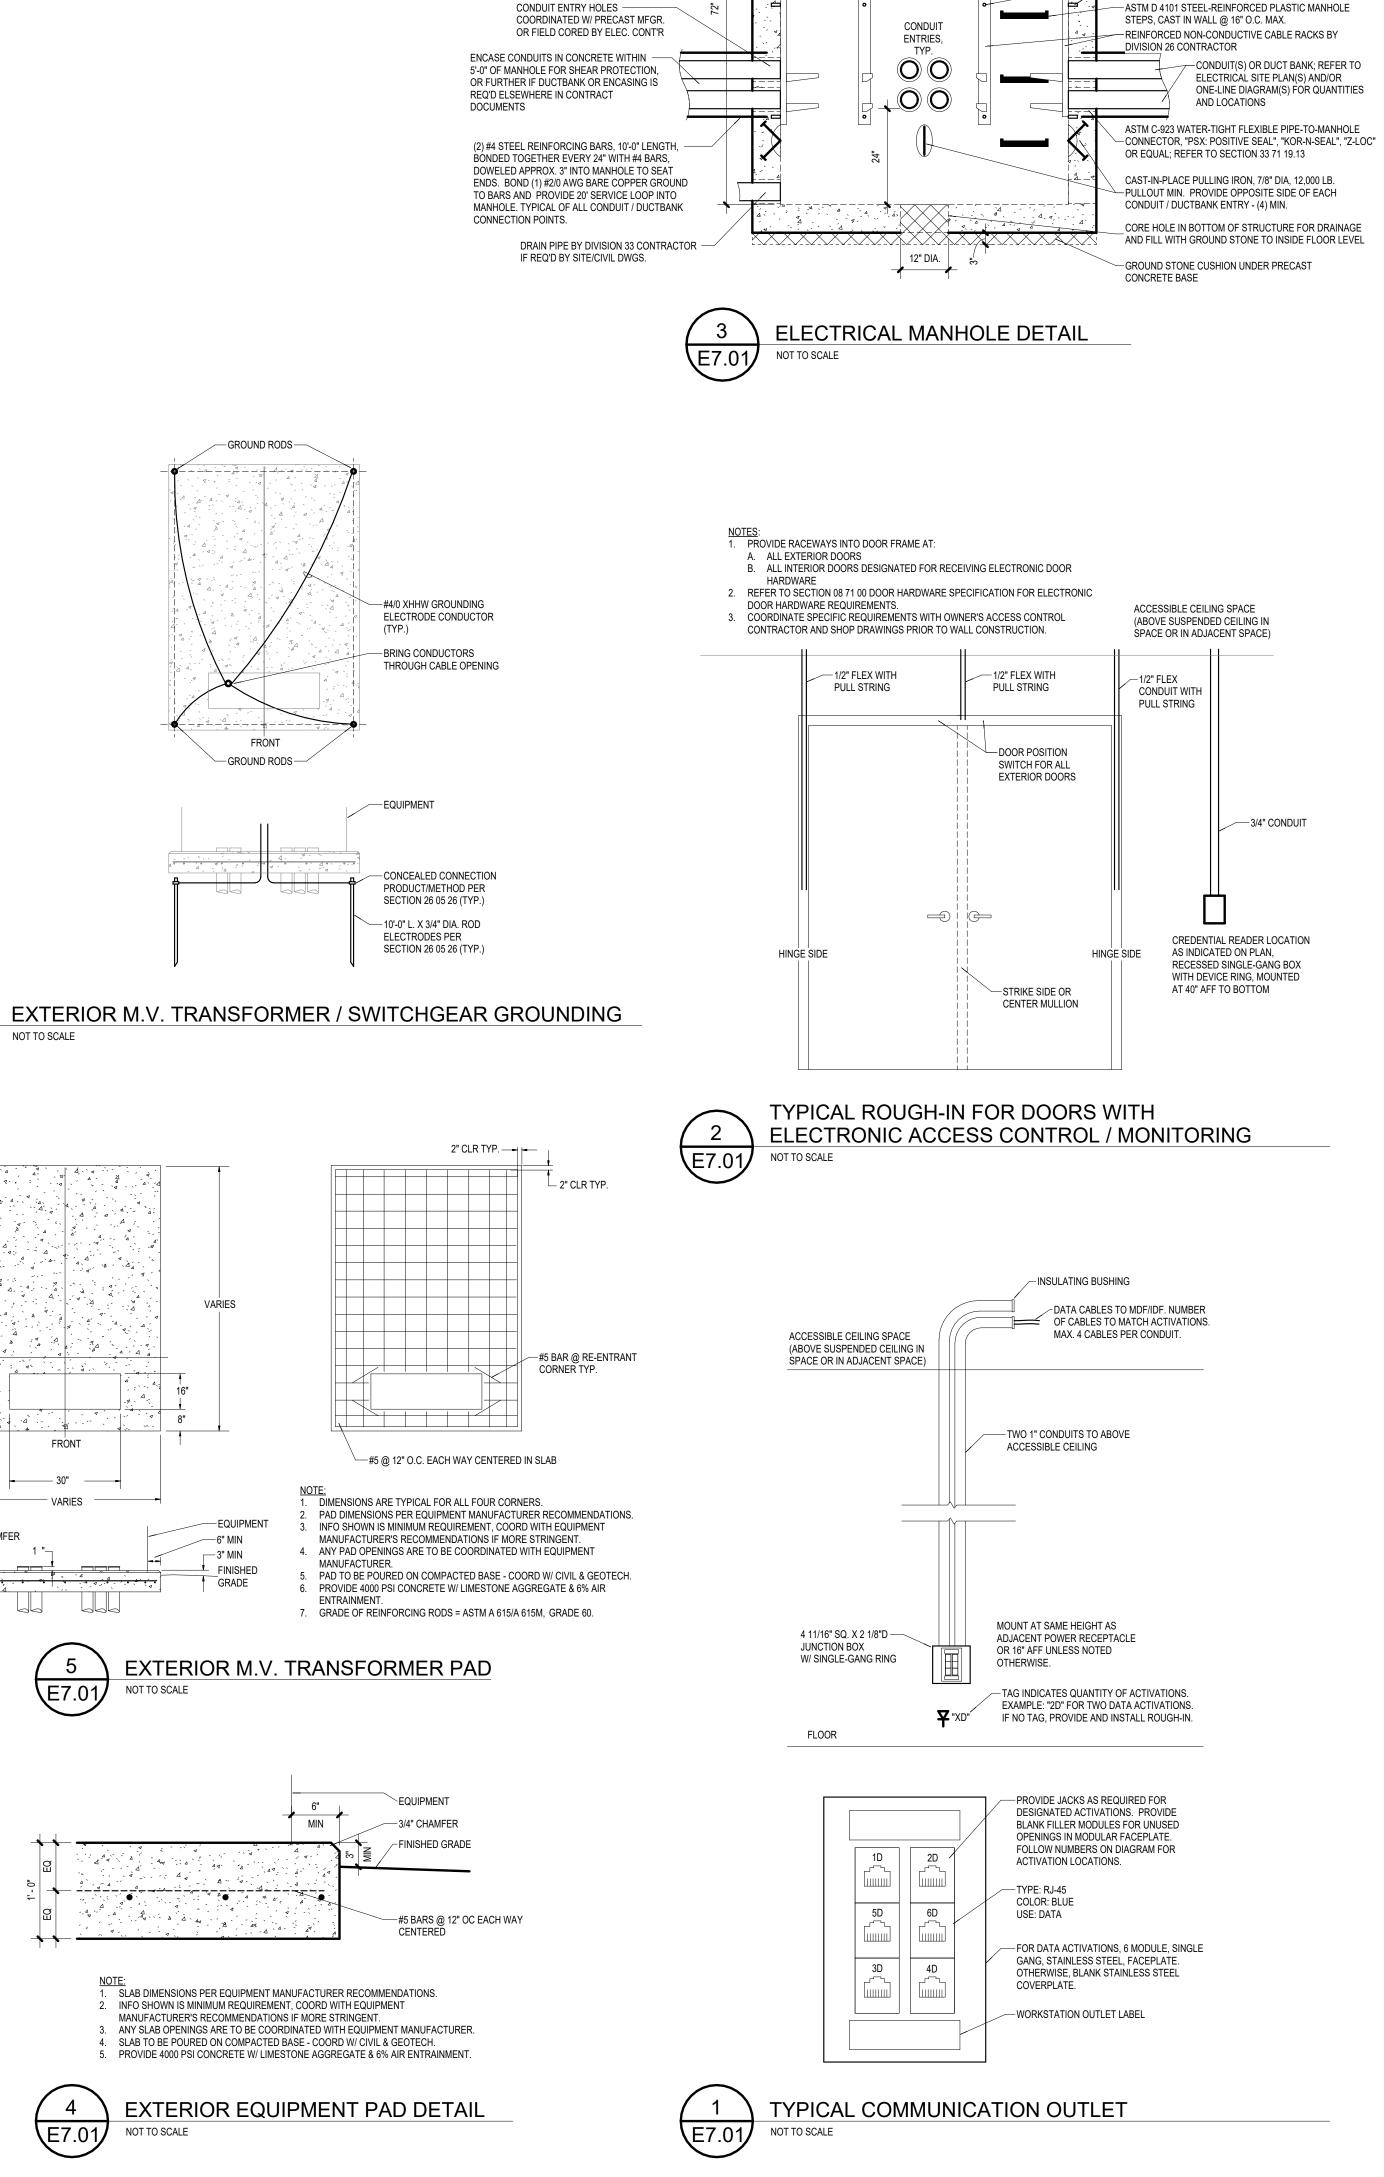

EAST JORDAN IRON WORKS HEAVY-DUTY WATER-TIGHT —

NEOPRENE GASKET SEAL. COVER LOGO SHALL BE 2" HEIGHT TYPEFACE: "ELECTRIC" FOR PRIMARY ELECTRIC MANHOLES, "COMMUNICATIONS" FOR COMMUNICATIONS MANHOLES.

72" DIA.

ASSEMBLY WITH #1322 FRAME, #1480A COVER, AND

ASPHALTIC WATERPROOFING COATING — ON EXTERIOR OF ALL CASTINGS

BACKFILL AND COMPACT AROUND -

MANHOLE PER SECTION 31 20 00


STATE OF

M Sch 2025.03.18

SITE ELECTRICAL PLAN

GMB COPYRIGHT © 2025 ALL RIGHTS RESERVED

ES2.01

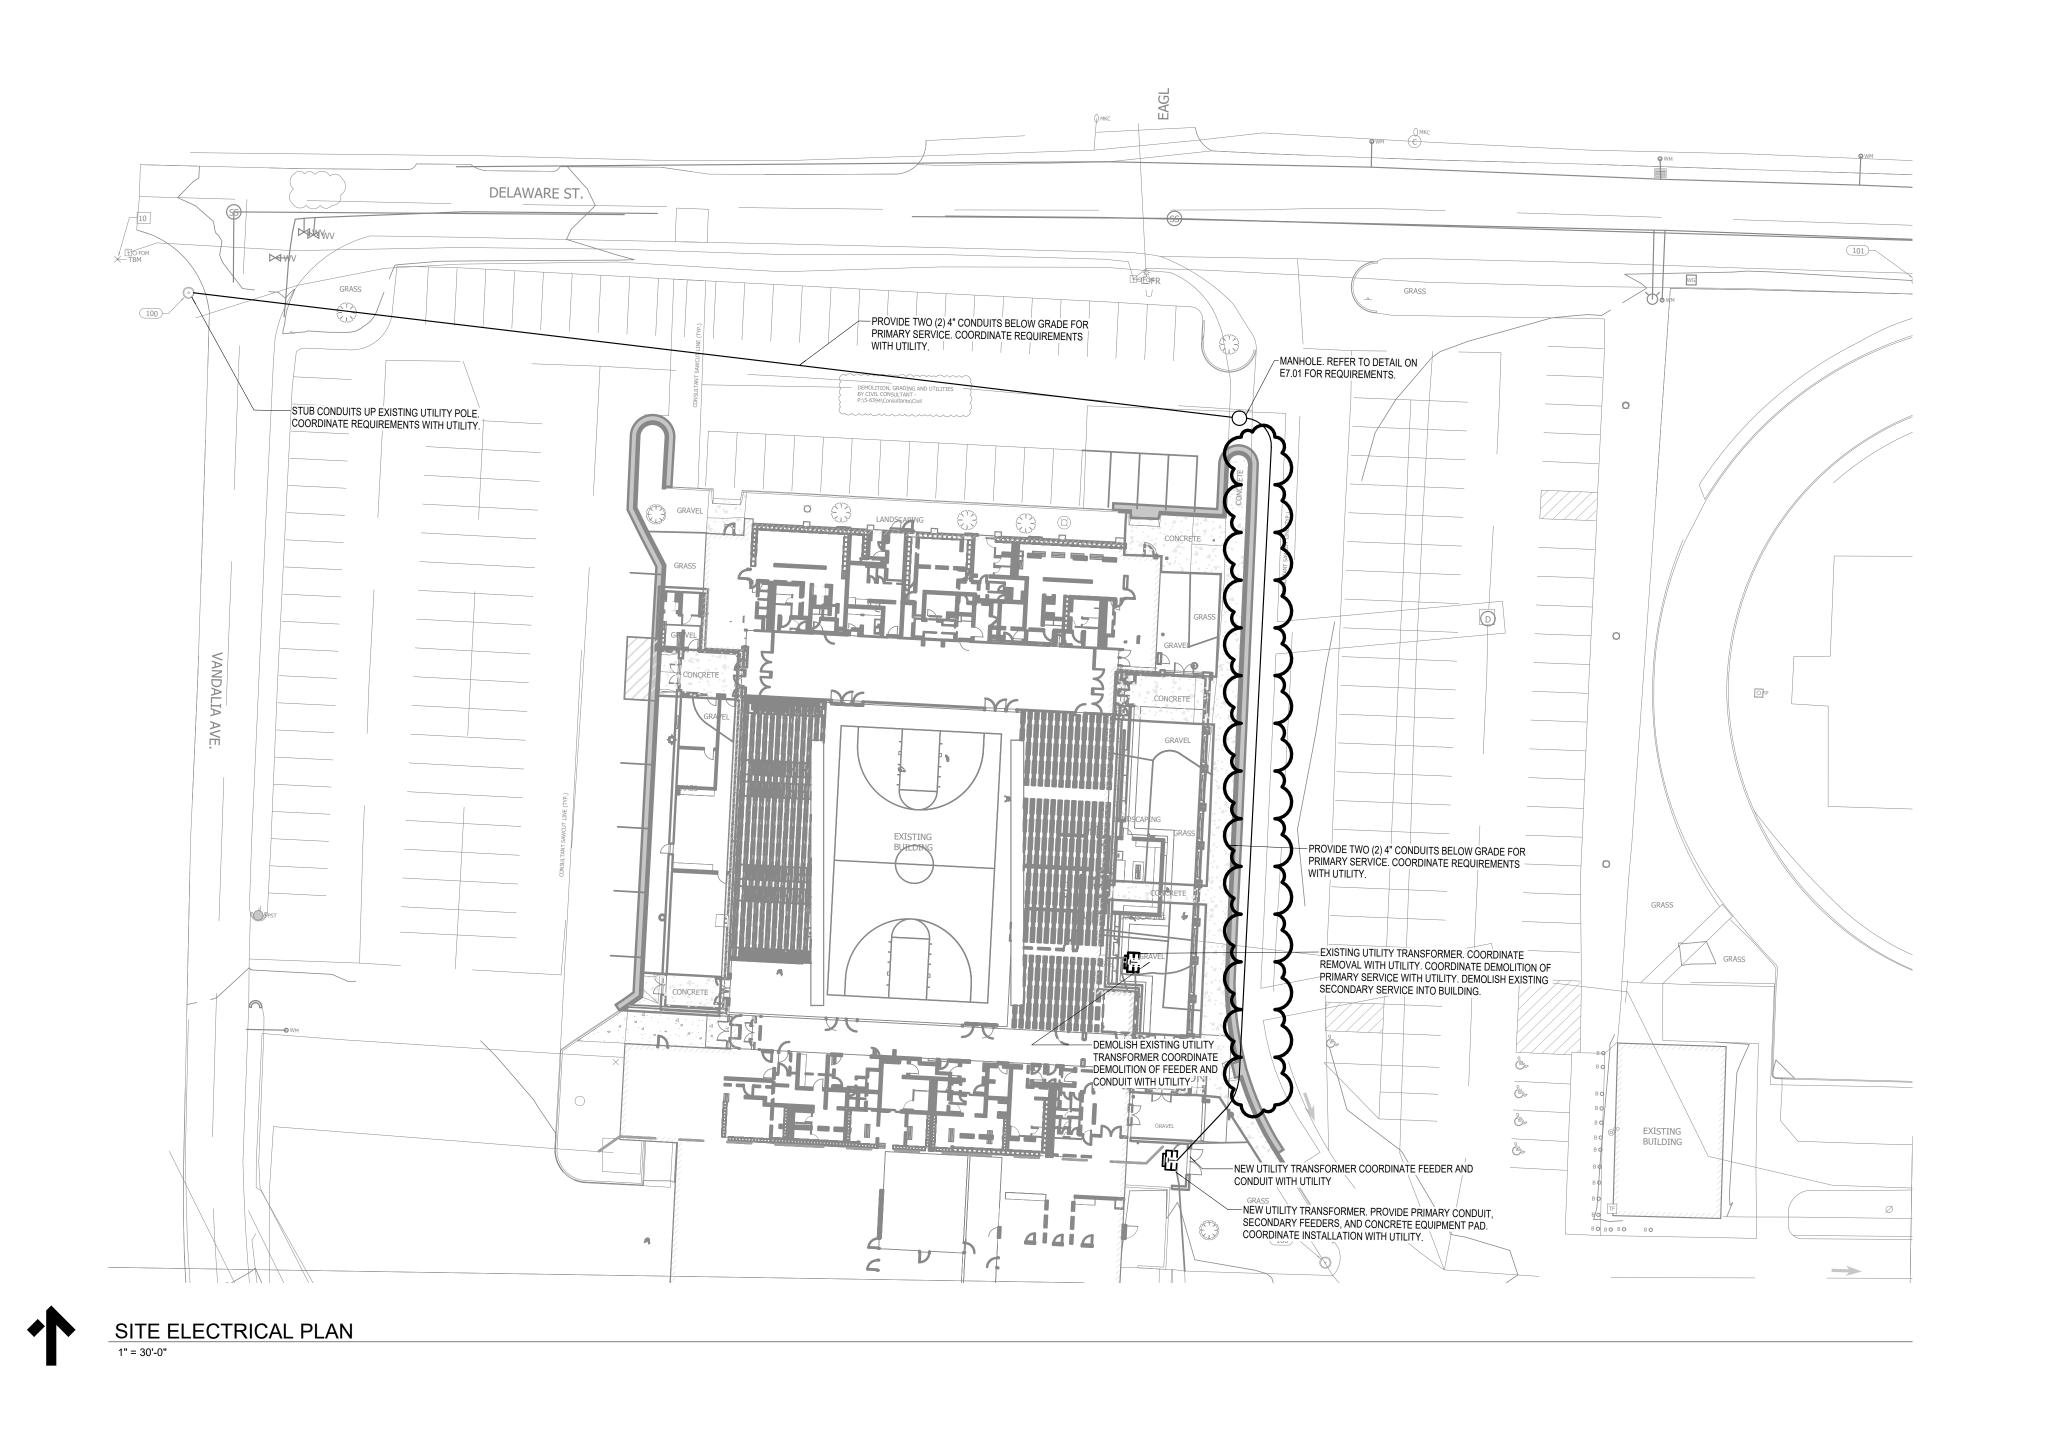

- 1. REFER TO SITE/CIVIL PLANS FOR ADDITIONAL INFORMATION.
- LOCATIONS SHOWN FOR EXISTING UTILITIES (IF ANY) ARE APPROXIMATE AND DERIVED FROM GENERAL OBSERVATION AND/OR AVAILABLE RECORDS. THIS PLAN SHALL NOT BE INTERPRETED AS SHOWING EXACT LOCATIONS OR SHOWING ALL UTILITIES IN THE AREA.
- 3. CONTRACTOR SHALL FIELD-VERIFY LOCATIONS, SIZES, AND TYPES OF ALL EXISTING UNDERGROUND UTILITIES, CONDUITS, AND CABLES PRIOR TO COMMENCEMENT OF WORK. CONTRACTOR SHALL CONTACT UTILITY LOCATING SERVICES TO IDENTIFY PUBLIC UTILITIES. VERIFY ALL PRIVATE UTILITIES WITH OWNER RECORDS AND MAINTENANCE PERSONNEL.
- 4. PROTECT THE SITE, ADJACENT PROPERTY, AND UTILITY SERVICES FROM DAMAGE OR DISRUPTION OF SERVICE/ACCESS. DAMAGE TO EXISTING STRUCTURES, SITE, OR UTILITIES SHALL BE REPAIRED AT THE CONTRACTOR'S
- 5. ALL UNDERGROUND CONDUIT SHALL BE RIGID NONMETALLIC (RNC) TYPE. ALL UNDERGROUND BENDS/ELBOWS SHALL BE GALVANIZED RIGID METALLIC (RMC) TYPE, PROTECTED FROM CORROSION PER CONDUIT SPECIFICATION REQUIREMENTS.
- 6. INSTALL DETECTABLE UNDERGROUND WARNING TAPE ABOVE ALL UNDERGROUND CONDUITS AND CABLES, COLOR PER APWA UNIFORM COLOR CODE (RED FOR ELECTRIC POWER/LIGHTING, ORANGE FOR COMMUNICATIONS/ALARM/SIGNAL). REFER TO SPECIFICATIONS.
- 7. ALL EXISTING TREES TO REMAIN SHALL BE CAREFULLY PROTECTED. DO NOT DRIVE HEAVY EQUIPMENT WITHIN 12 FEET OF TREE TRUNKS. BRANCHES WHICH ARE DAMAGED DURING DEMOLITION OR CONSTRUCTION SHALL BE CUT OUT AS DIRECTED BY THE ARCHITECT/ENGINEER. ANY ROOTS OF EXISTING TREES TO REMAIN WHICH ARE EXPOSED DUE TO DEMOLITION SHALL BE COVERED WITHIN 6 HOURS WITH SOIL. DAMAGED TREES SHALL BE REPLACED AT THE DISCRETION OF THE ARCHITECT/ENGINEER AT THE EXPENSE OF THE CONTRACTOR RESPONSIBLE FOR THE DAMAGE.
- 8. PATCH AND REPAIR GRASS AND/OR OTHER IMPROVED PLANTINGS AS REQUIRED WHERE NEW UNDERGROUND CONDUITS, CABLES, AND/OR DUCTBANKS ARE INSTALLED. CONTRACTOR SHALL BACKFILL TRENCHES, LEVEL OUT SOIL FLUSH WITH GRADE, AND REMOVE ANY EXCESS MATERIAL PRIOR TO SEEDING REPAIR.
- 9. CONTRACTOR SHALL BE RESPONSIBLE TO PATCH AND REPAIR ANY EXISTING SURFACE FINISHES AND OTHER ITEMS THAT ARE DISTURBED DURING THE COURSE OF DEMOLITION AND CONSTRUCTION, INCLUDING GRASS, CONCRETE, ASPHALT, LANDSCAPING, FENCING, STRUCTURES, IRRIGATION, UNDERGROUND UTILITIES, ETC.